

REVISIONS

BY

△

△

BMR

DRAFTING SERVICE

SINCE 1988

23846 SUNNYMEAD BLVD.

SUITE #9

MORENO VALLEY, CA 92553

B: (951) 243-7814

F: (951) 243-7873

GLASS FACTORY

26383 BASE LINE

HIGHLAND, CA 92346

AS-BUILT DRAWINGS

JOB NAME:

AGUA CALIENTE HOTEL ADDITION

ARCHITECT:

VOA

SHEET DESCRIPTION:

COVER SHEET

DATE:

1/3/07

SCALE:

DRAWN:

CTB

JOB NO:

100-06

SHEET NO:

CI

AGUA CALIENTE CASINO

HOTEL ADDITION

32-250 BOB HOPE DRIVE

RANCHO MIRAGE, CALIFORNIA 92270

DOOR SCHEDULE

DR#	QTY.	DOOR OPENING	SYSTEM	STILE	HUNG	SWING	HINGED	HDWR
E0101	6	6'-0" X 9'-11 7/8"	2" X 4 1/2"	MEDIUM	OFFSET	OUT	PAIR	1
E0102	4	6'-0" X 10'-0"	2" X 4 1/2"	MEDIUM	OFFSET	OUT	PAIR	1
E0103	4	6'-0" X 10'-0"	2" X 4 1/2"	MEDIUM	OFFSET	OUT	PAIR	1
E0104	4	6'-0" X 10'-0"	2" X 4 1/2"	MEDIUM	OFFSET	OUT	PAIR	1
E0105	4	6'-0" X 7'-6 3/4"	2" X 7"	MEDIUM	OFFSET	OUT	PAIR	1
E0106	4	6'-0" X 10'-0"	2" X 4 1/2"	MEDIUM	OFFSET	OUT	PAIR	1
E0001	7	6'-0" X 7'-6 3/4"	2" X 7"	MEDIUM	OFFSET	OUT	PAIR	1
E0001	16	6'-0" X 7'-6 3/4"	2" X 7"	MEDIUM	OFFSET	OUT	PAIR	1
T1	15	3'-0" X 7'-7 1/4"	2" X 4 1/2"	MEDIUM	OFFSET	OUT	RIGHT	2
T2	1	3'-0" X 7'-7 1/4"	2" X 4 1/2"	MEDIUM	OFFSET	OUT	LEFT	2
T3	24	6'-0" X 7'-7 1/4"	2" X 4 1/2"	MEDIUM	OFFSET	OUT	RIGHT	2
T4	24	6'-0" X 7'-7 1/4"	2" X 4 1/2"	MEDIUM	OFFSET	OUT	LEFT	2
T5	2	6'-0" X 7'-8 3/8"	2" X 4 1/2"	MEDIUM	OFFSET	OUT	PAIR	2

HARDWARE SCHEDULE

HARDWARE #1

AS REQUIRED ~ FLOOR CLOSER
TOP PIVOT, 3 INTERMEDIATE PIVOTS
ADAMS RITE CONCEALED PANICS
LOCK
LOCK INDICATOR
CYLINDER
CYLINDER GUARD
PUSH / PULL
THRESHOLD

HARDWARE #2

BALCONY DOORS ~ "900 SERIES TERRACE DOORS"
BY U.S. ALUMINUM

GLASS SCHEDULE

1" THICK INSULATED ARTIC BLUE VISION GLAZING UNITS
(OUTBOARD LITE: 1/4" THK. ARTIC BLUE ECLIPSE ADVANTAGE
VISION GLASS WITH A 1/2" AIR SPACE; INBOARD LITE: 1/4" THK.
CLEAR GLASS)

1" THICK INSULATED ARTIC BLUE FROSTED GLAZING UNITS
(OUTBOARD LITE: 1/4" THK. ARTIC BLUE ECLIPSE ADVANTAGE
FROSTED GLASS WITH A 1/2" AIR SPACE; INBOARD LITE: 1/4"
THK. CLEAR GLASS)

1/4" THICK ARTIC BLUE ECLIPSE ADVANTAGE SPANDREL
GLAZING

T

DENOTES TEMPERED GLASS AS REQUIRED

ALUMINUM FRAME FINISH

TYPE: PAINT

COLOR: BONE WHITE

ALUMINUM FRAME SYSTEM

U.S. ALUMINUM

SERIES: FT451
(2" X 4 1/2" OFFSET GLAZED)

SERIES: 3250
(2 1/2" X 7" CURTAIN WALL)

SERIES: 3150
(2 1/2" X 6 1/4" CURTAIN WALL)

ABBREVIATIONS

A.F.F. ~ ABOVE FINISH FLOOR

B.O.M. ~ BOTTOM OF MULLION

CL ~ CENTER LINE

DLO ~ DAYLIGHT OPENING

F.F. ~ FINISH FLOOR

F.O.C. ~ FACE OF CONCRETE

F.O.M. ~ FACE OF MULLION

F.V. ~ FIELD VERIFY

MEZZ. ~ MEZZANINE FLOOR

N.F.D. ~ NET FRAME DIMENSION


R.C.P. ~ RECESSED CONCRETE PANEL

R.O. ~ ROUGH OPENING

S.O.M. ~ SIDE OF MULLION



T.O.M. ~ TOP OF MULLION

W.R.O. ~ WINDOW ROUGH OPENING

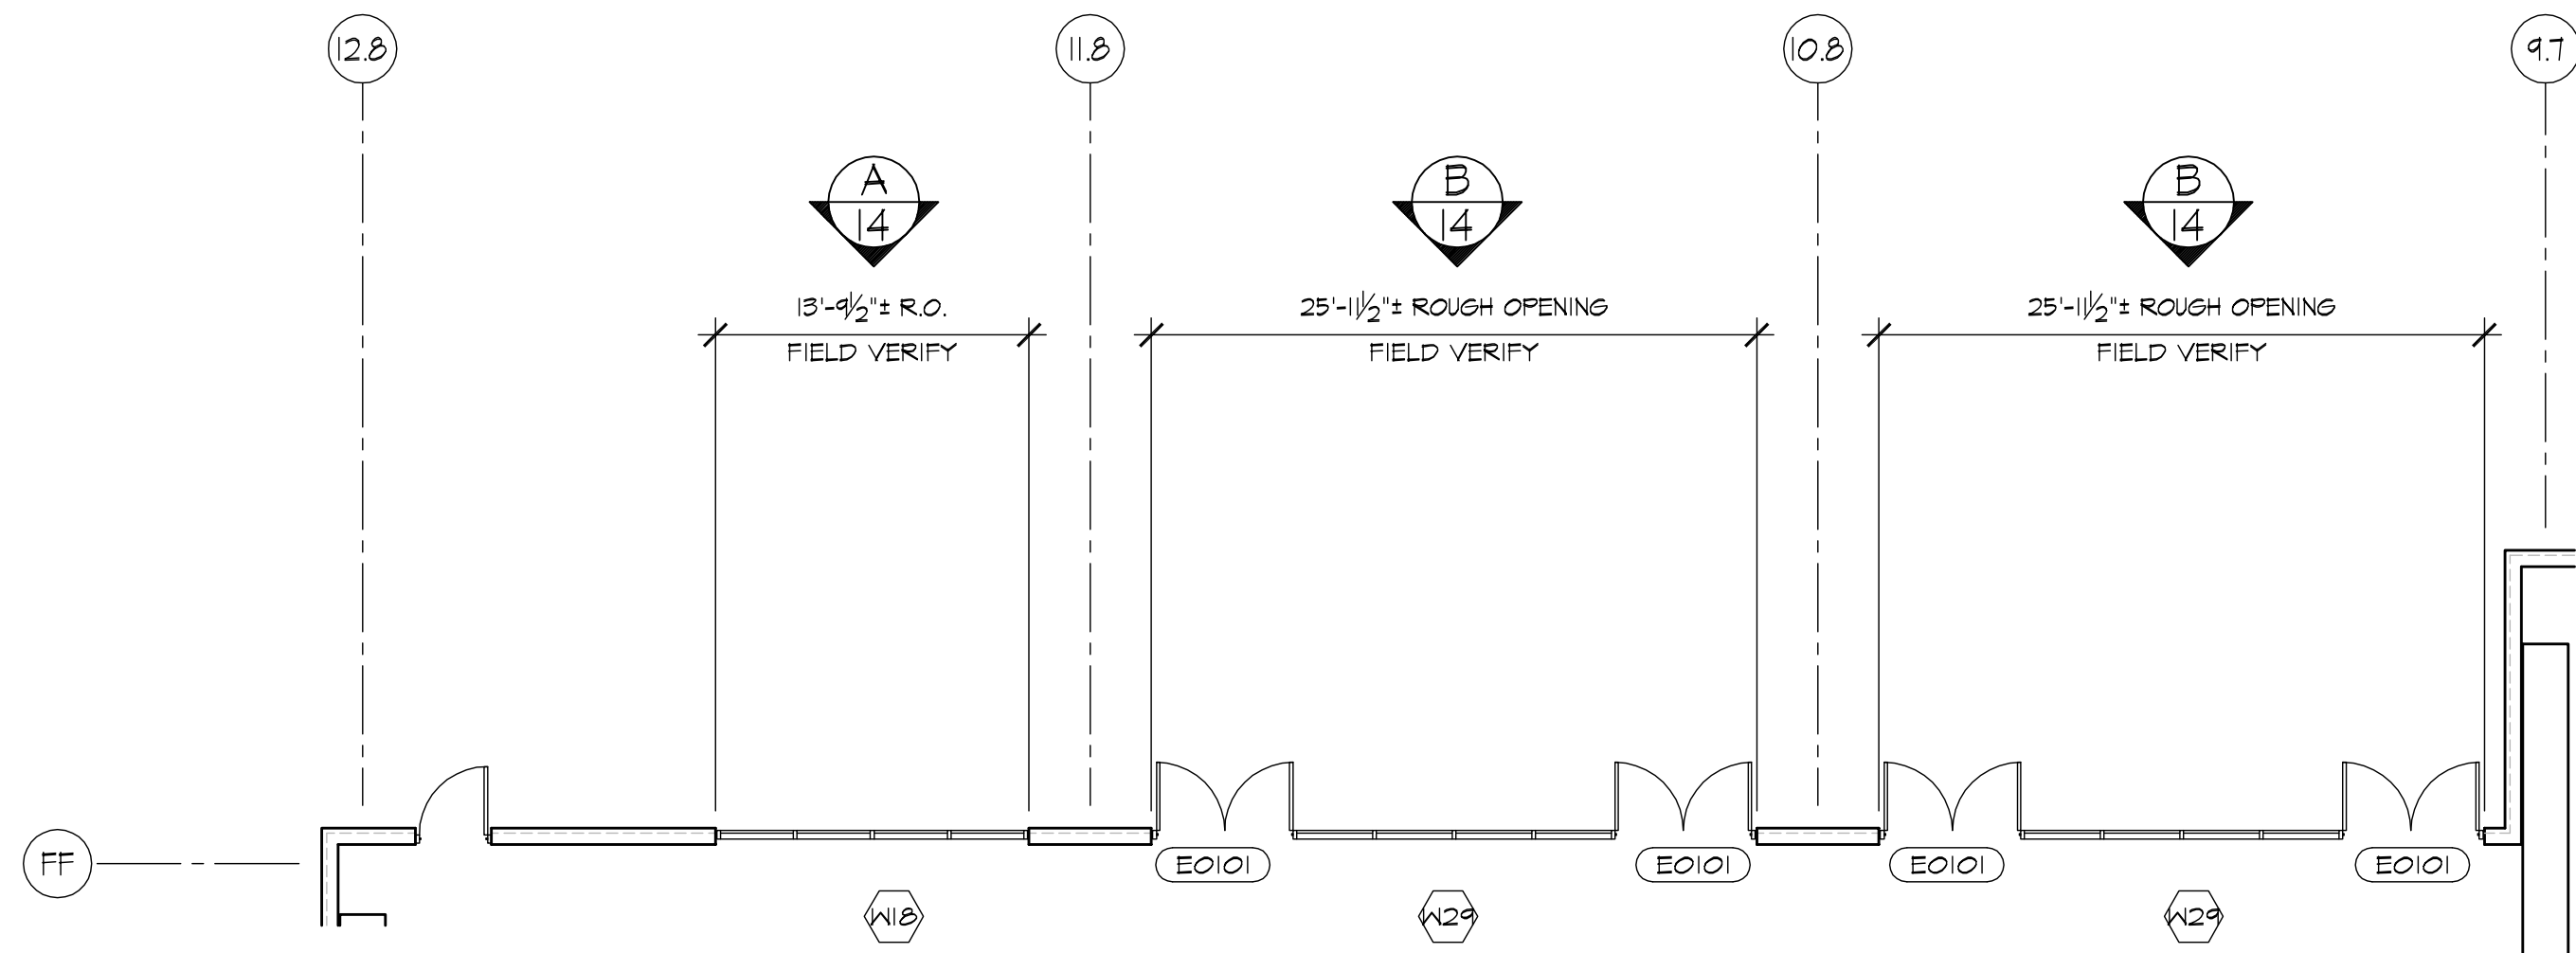



PARTIAL 1ST FLOOR PLAN
REF. ARCH'L - A101A

AREA - A

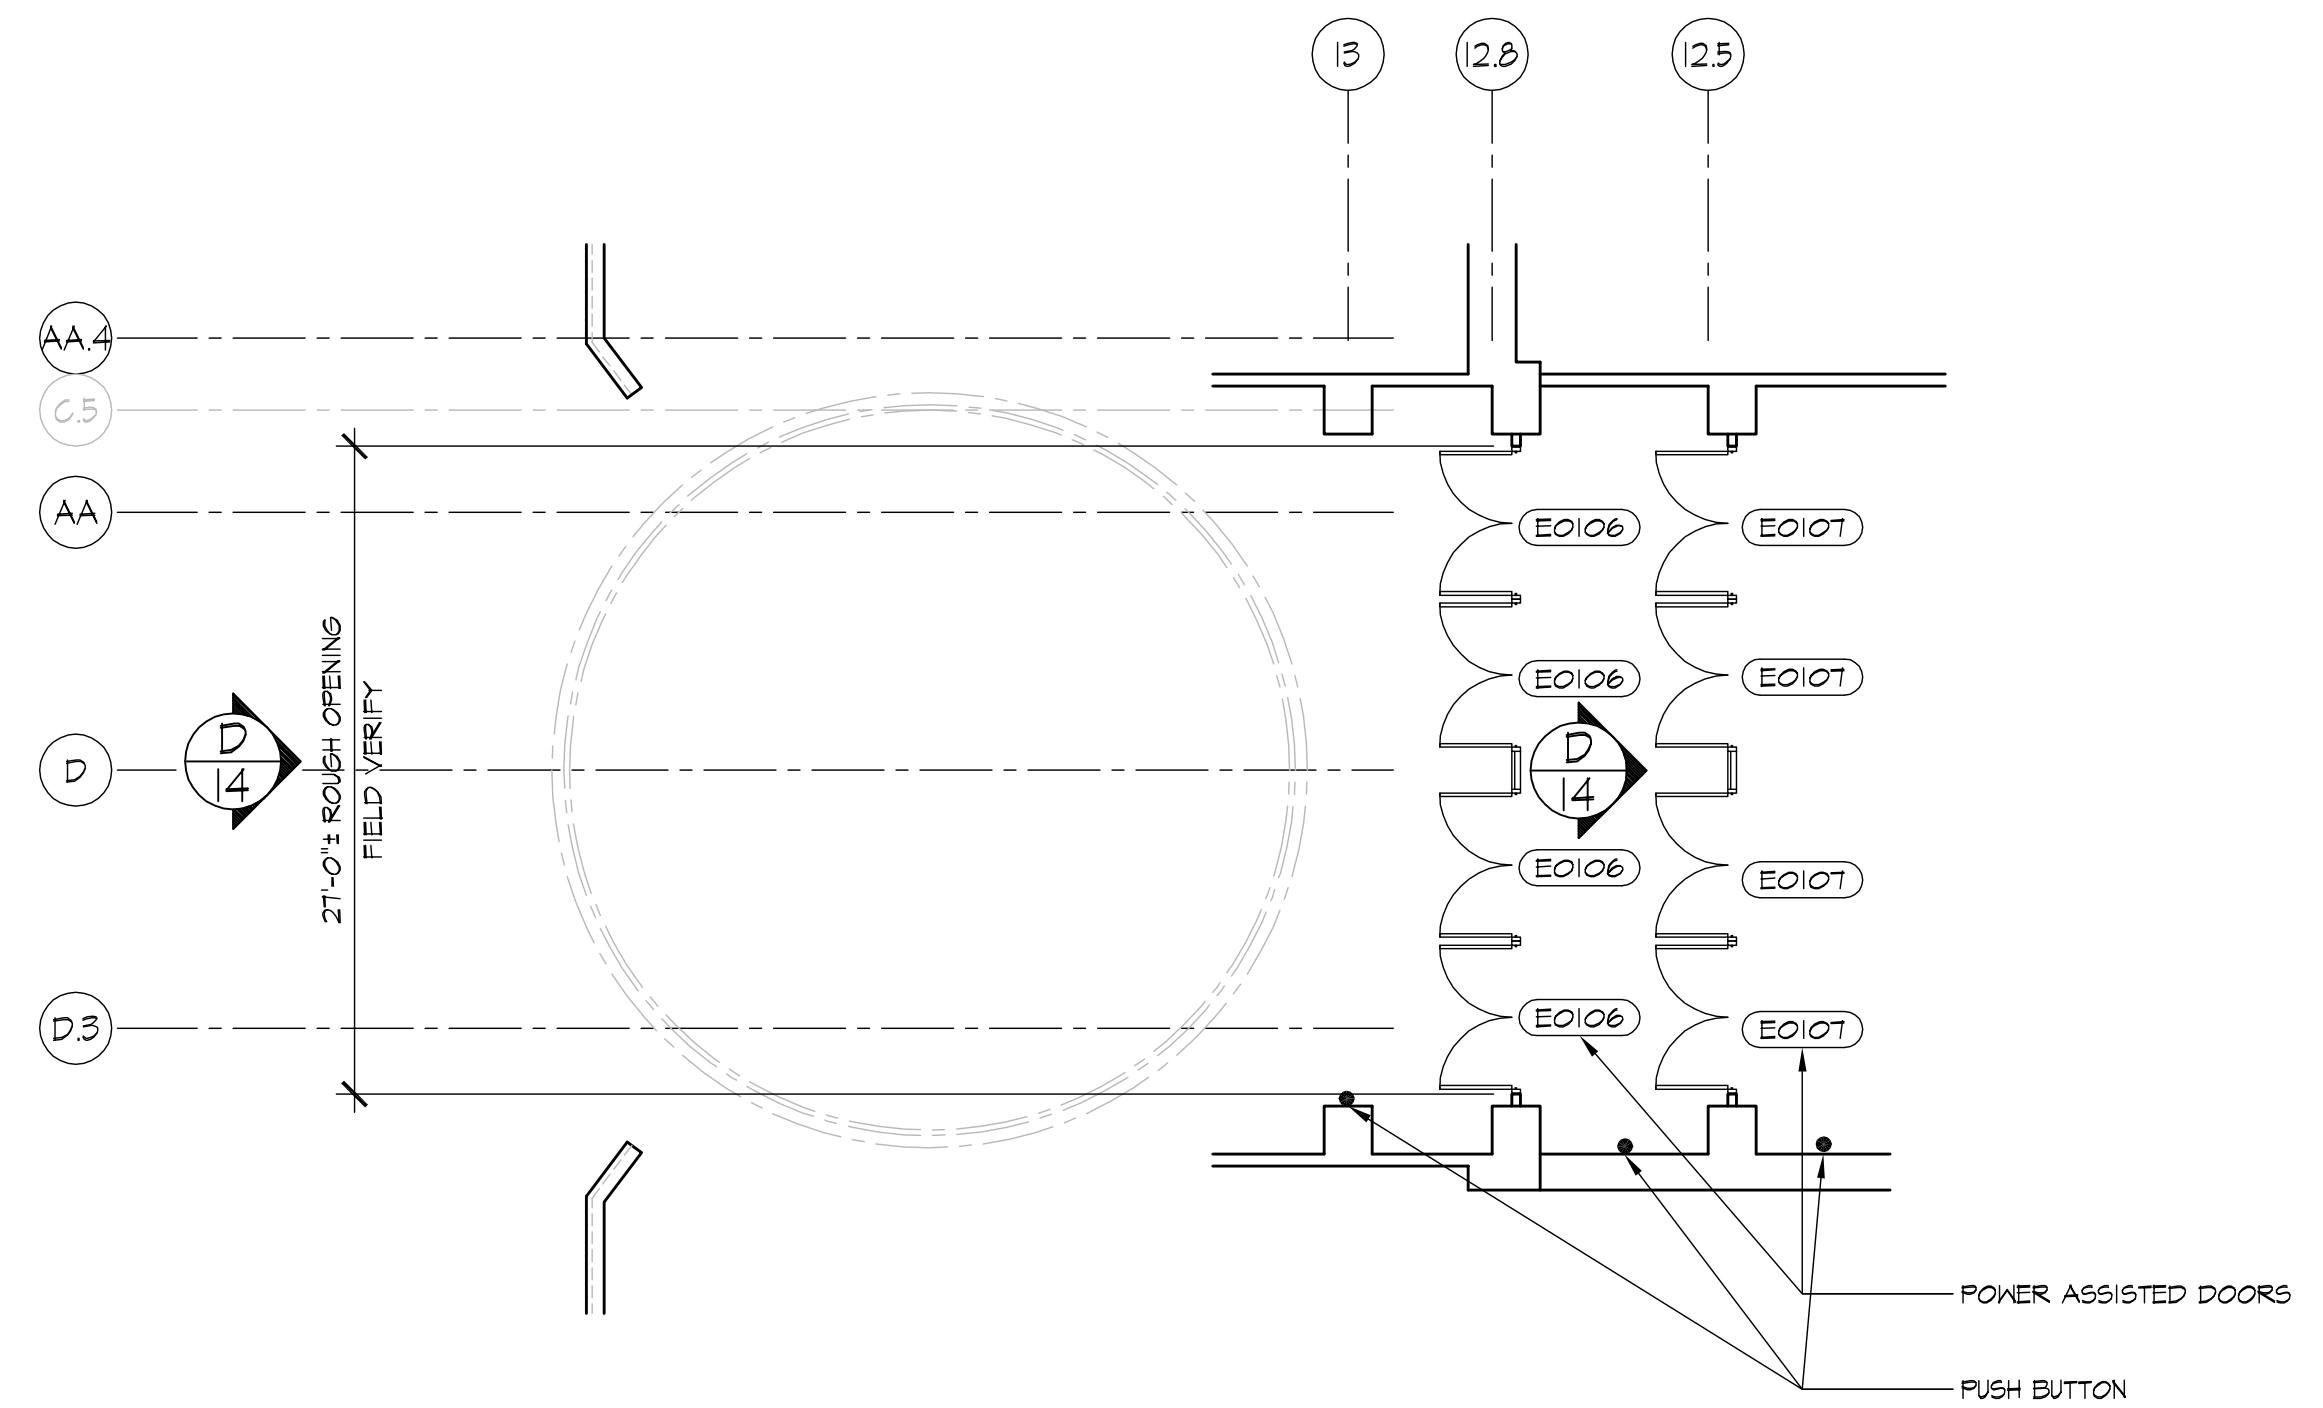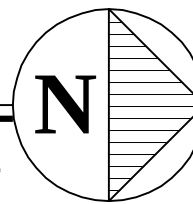


PARTIAL 1ST FLOOR PLAN
REF. ARCH'L - A101C

AREA - C

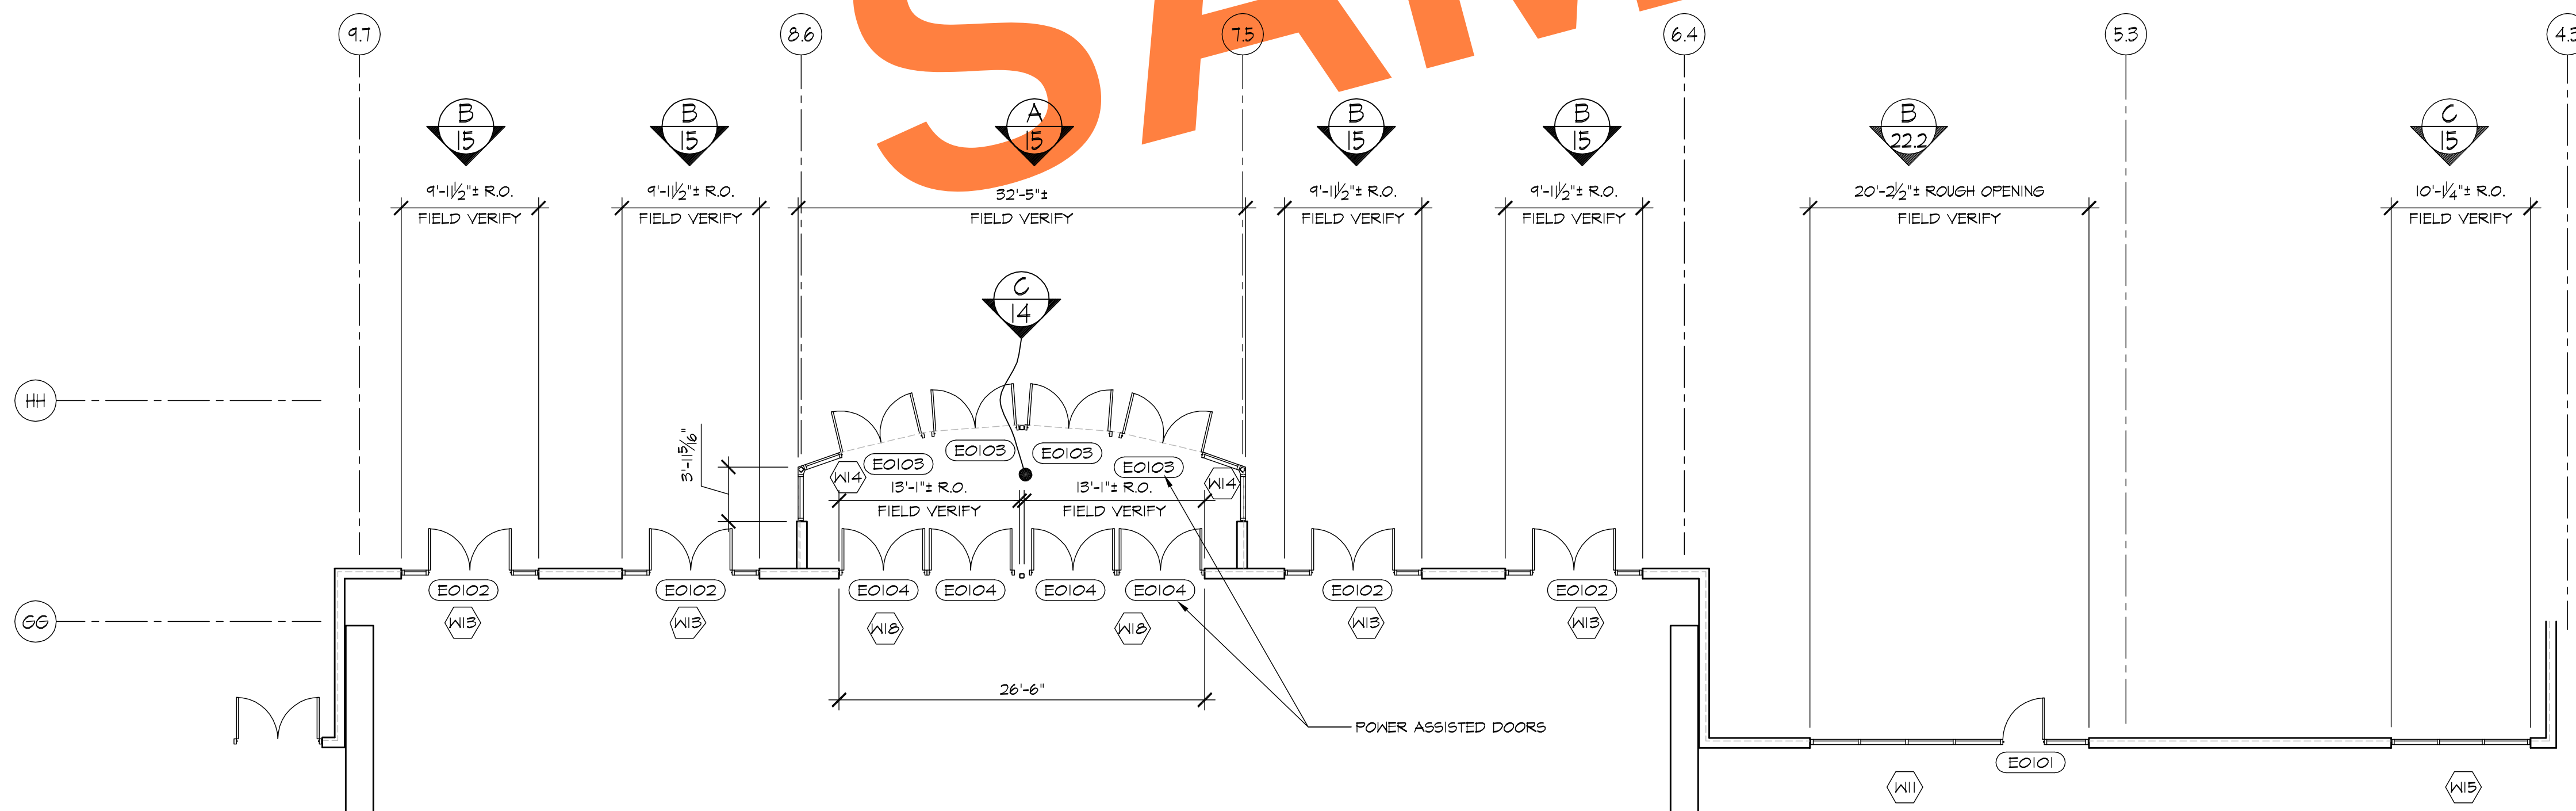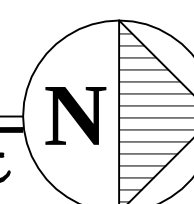

PARTIAL 1ST FLOOR PLAN
REF. ARCH'L - A101B

AREA - B

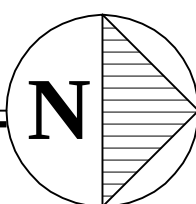


REVISIONS	BY
△	
△	
GLASS FACTORY
26383 BASE LINE
HIGHLAND, CA 92346

AS-BUILT DRAWINGS


JOB NAME:	AGUA CALIENTE HOTEL ADDITION
ARCHITECT:	VOA
SHEET DESCRIPTION:	FLOOR PLAN
DATE:	1/3/07
SCALE:	1/8"=1'-0"
DRAWN:	CTB
JOB NO:	100-06
SHEET NO:	1

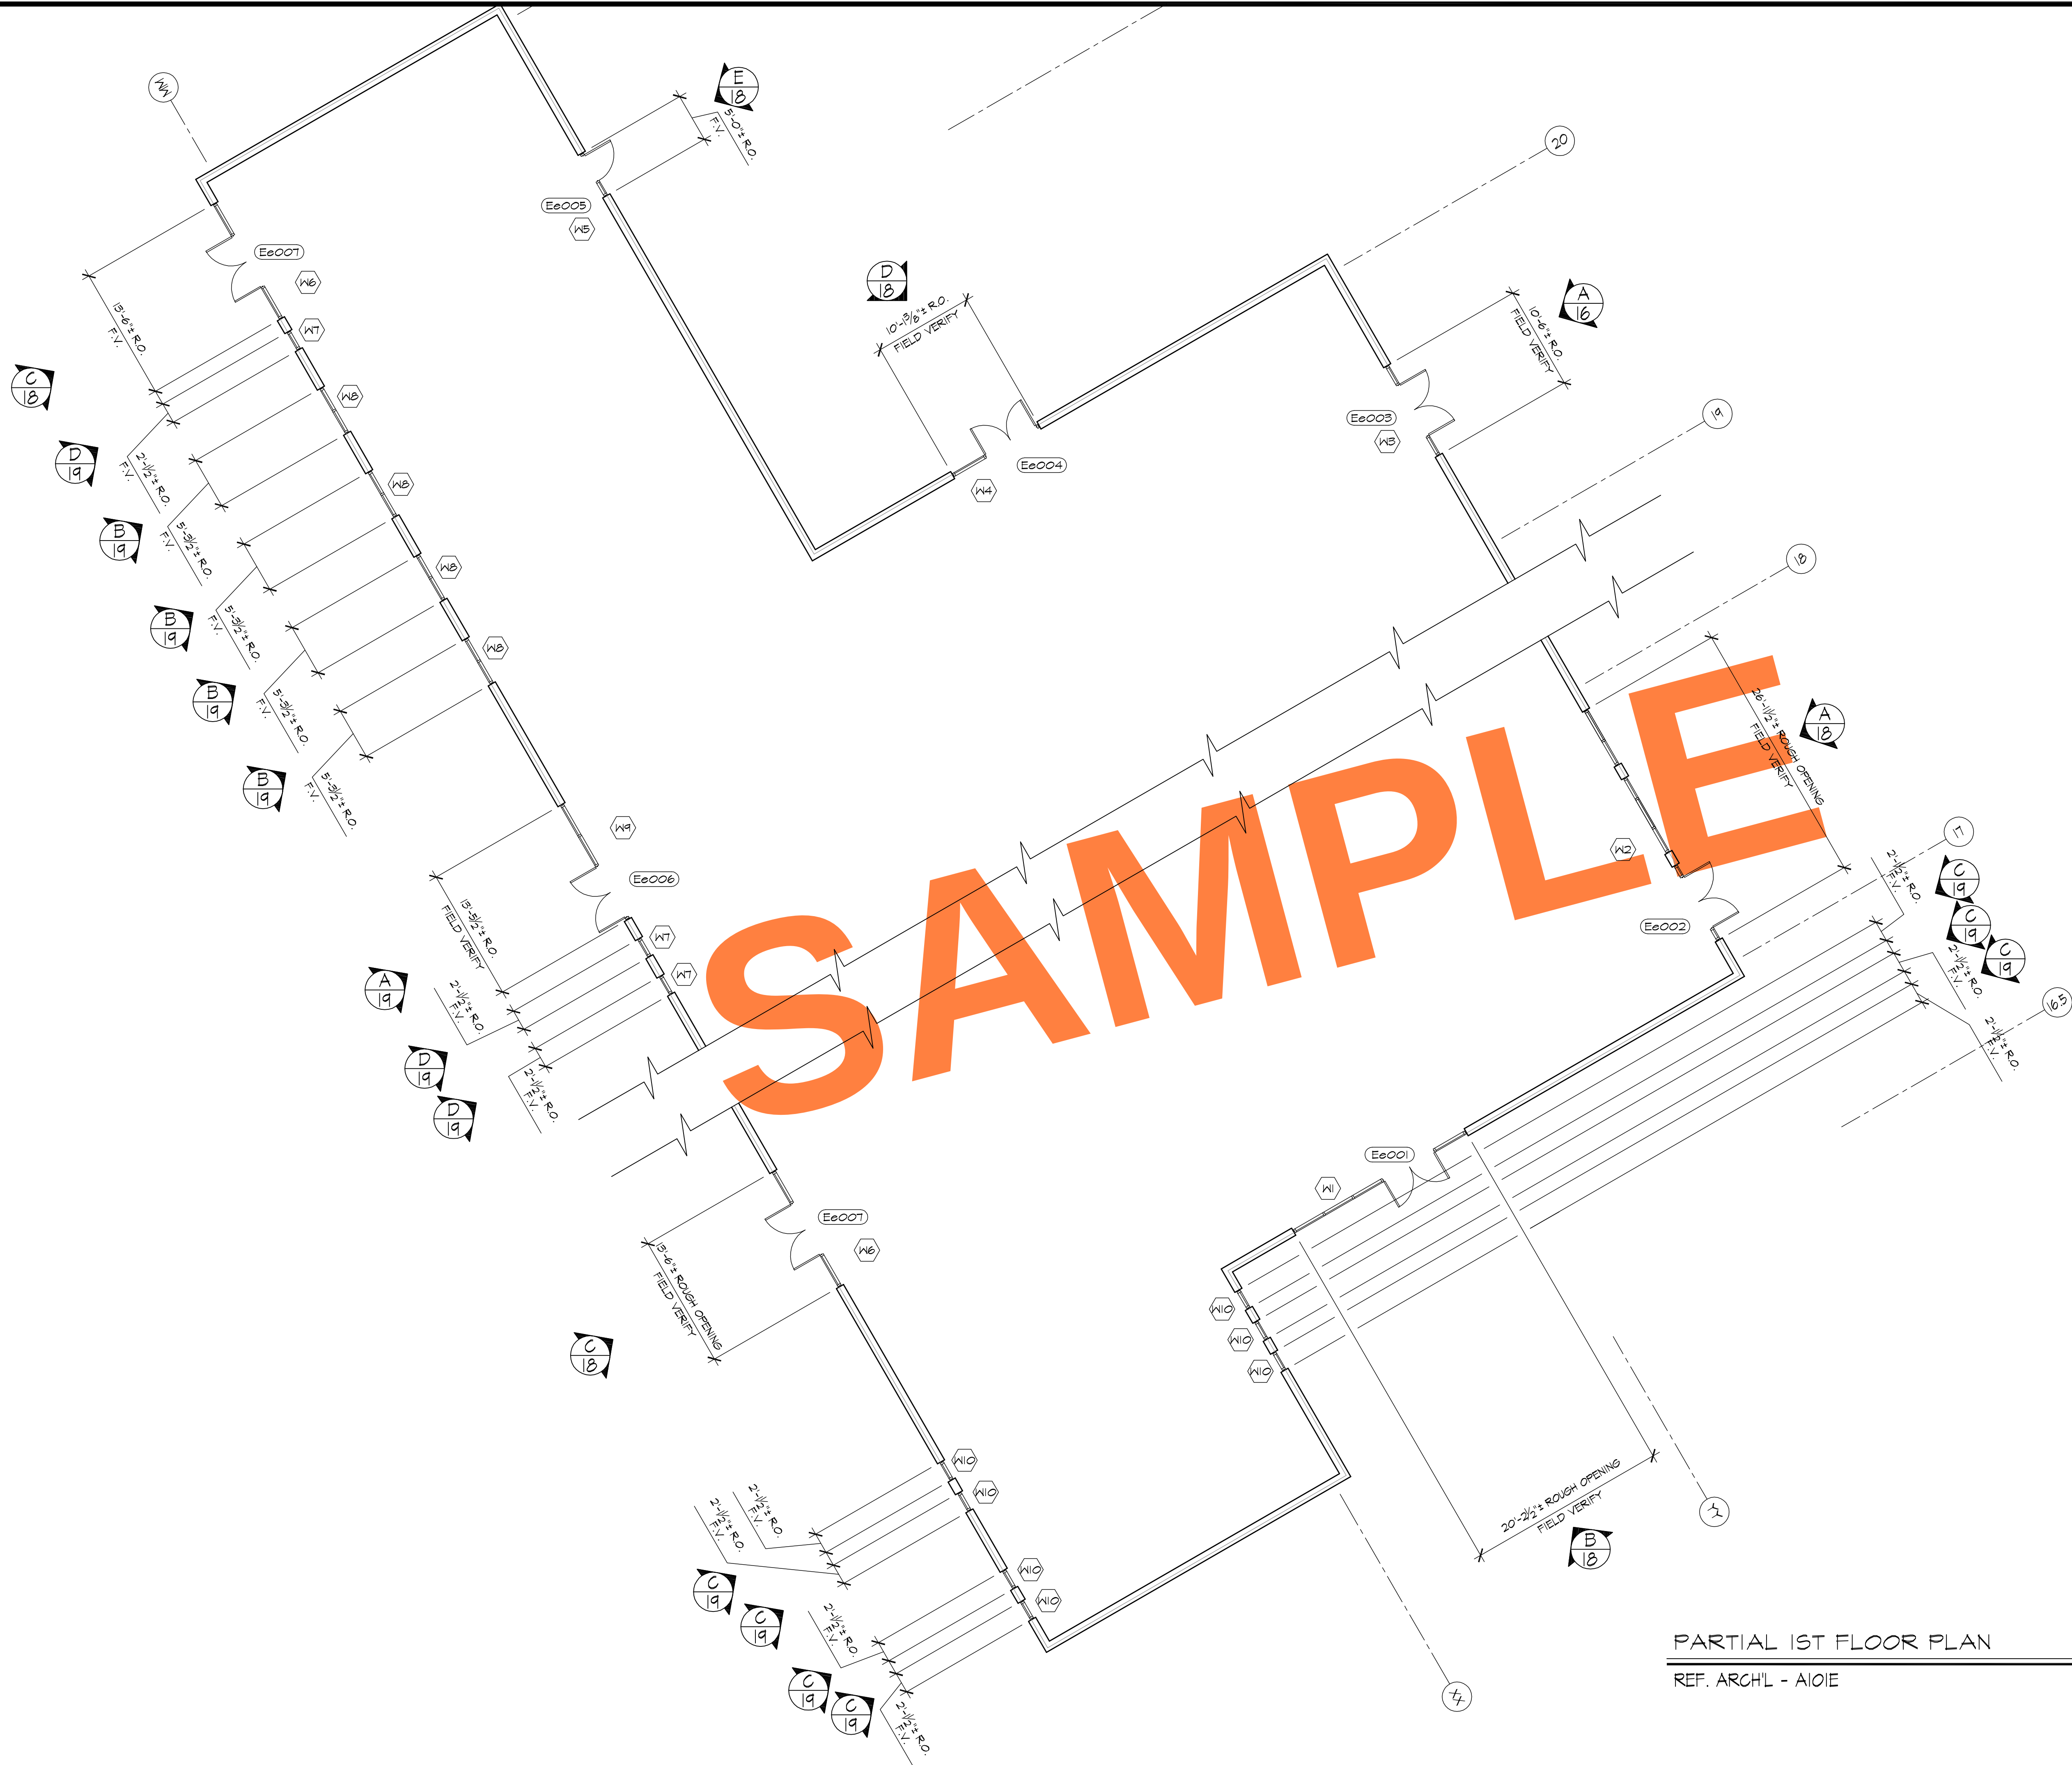


PARTIAL 1ST FLOOR PLAN

REF. ARCH'L - AIOIE

AREA - E

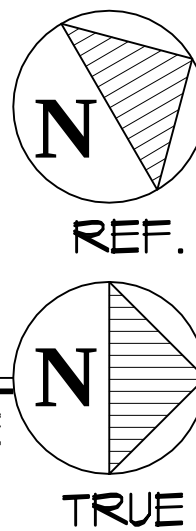



REVISIONS		BY
△		
△		
BMR DRAFTING SERVICE SINCE 1988 23846 SUNNYMEAD BLVD. SUITE #6 MORENO VALLEY, CA 92553 B: (951) 243-7814 F: (951) 243-7873		
GLASS FACTORY 26383 BASE LINE HIGHLAND, CA 92346		
AS-BUILT DRAWINGS		
JOB NAME:	AGUA CALIENTE HOTEL ADDITION	
ARCHITECT:	VOA	
SHEET DESCRIPTION:	FLOOR PLAN	
DATE:	1/3/07	
SCALE:	1/8"=1'-0"	
DRAWN:	CTB	
JOB NO:	100-06	
SHEET NO:	2	


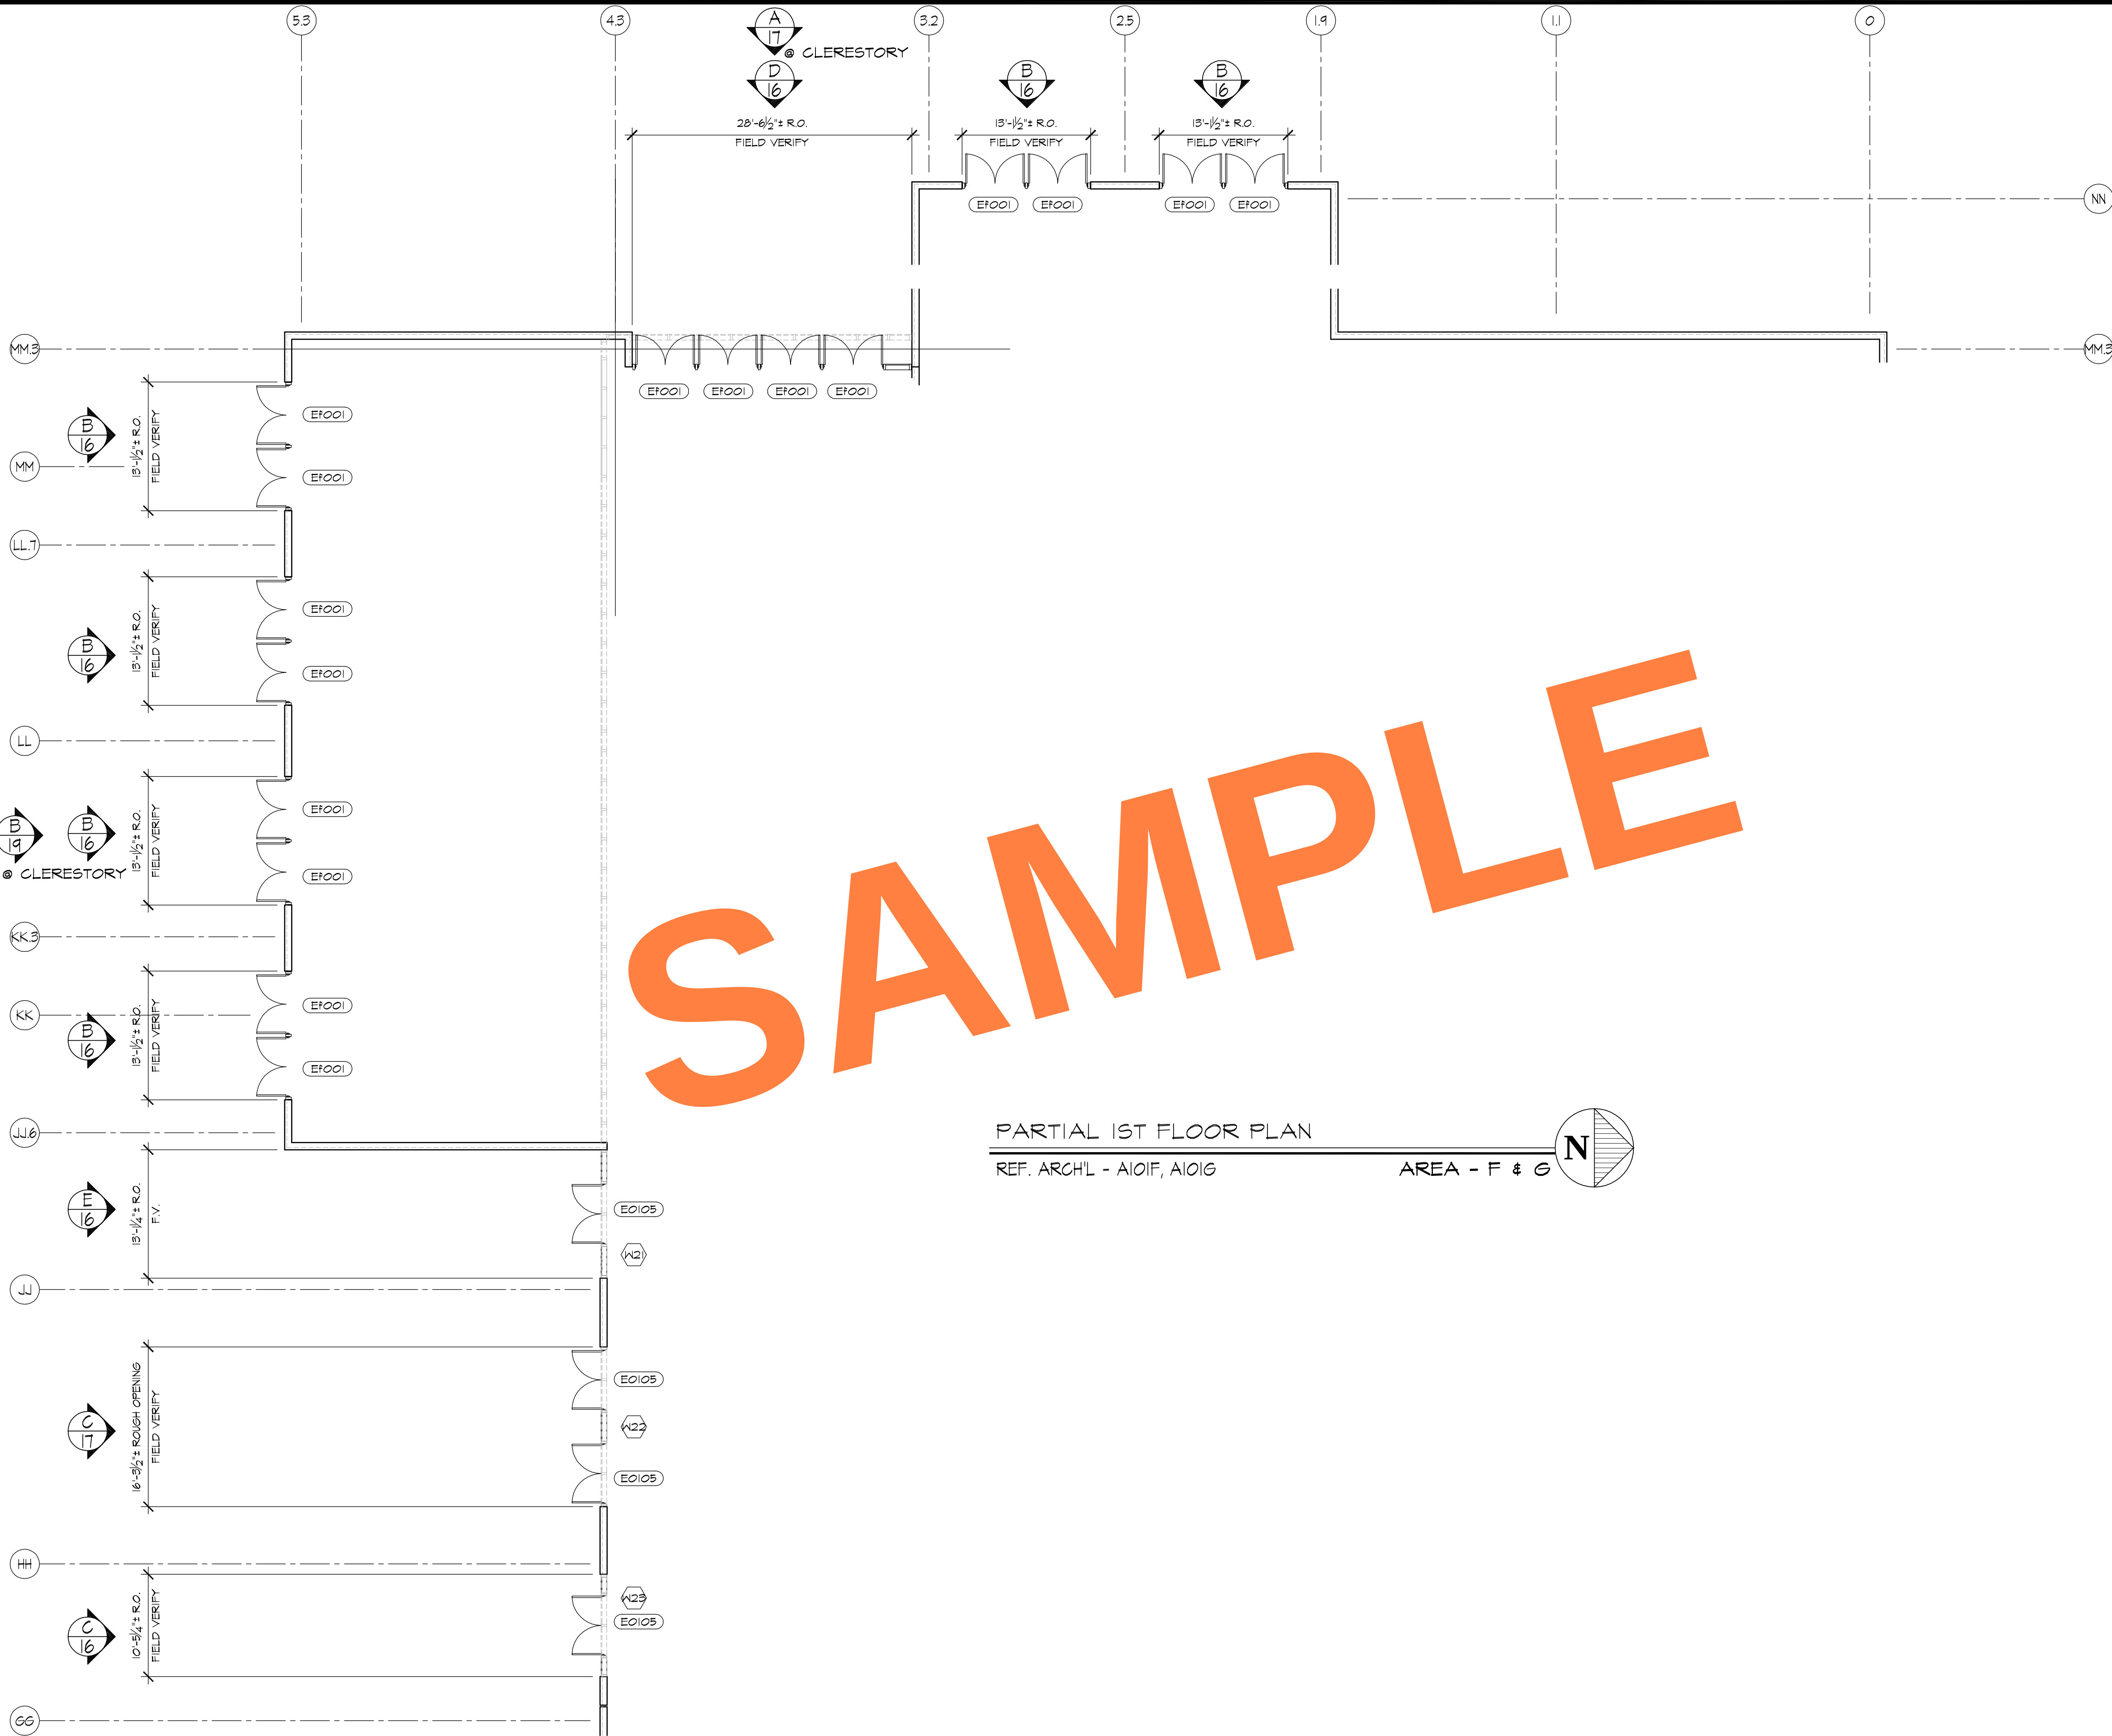


SAMPLE


PARTIAL 1ST FLOOR PLAN
REF. ARCH'L - A101F, A101G
AREA - F & G

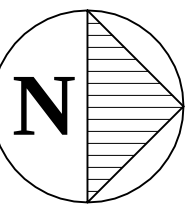

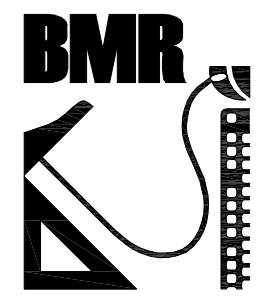REVISIONS		BY
△		
△		
 DRAFTING SERVICE SINCE 1988 23846 SUNNYMEAD BLVD. SUITE #9 MORENO VALLEY, CA 92553 B: (951) 243-7814 F: (951) 243-7873		
GLASS FACTORY 26383 BASE LINE HIGHLAND, CA 92346		
AS-BUILT DRAWINGS		
JOB NAME:	AGUA CALIENTE HOTEL ADDITION	
ARCHITECT:	VOA	
SHEET DESCRIPTION:	FLOOR PLAN	
DATE:	1/3/07	
SCALE:	1/8"=1'-0"	
DRAWN:	CTB	
JOB NO:	100-06	
SHEET NO:	3	

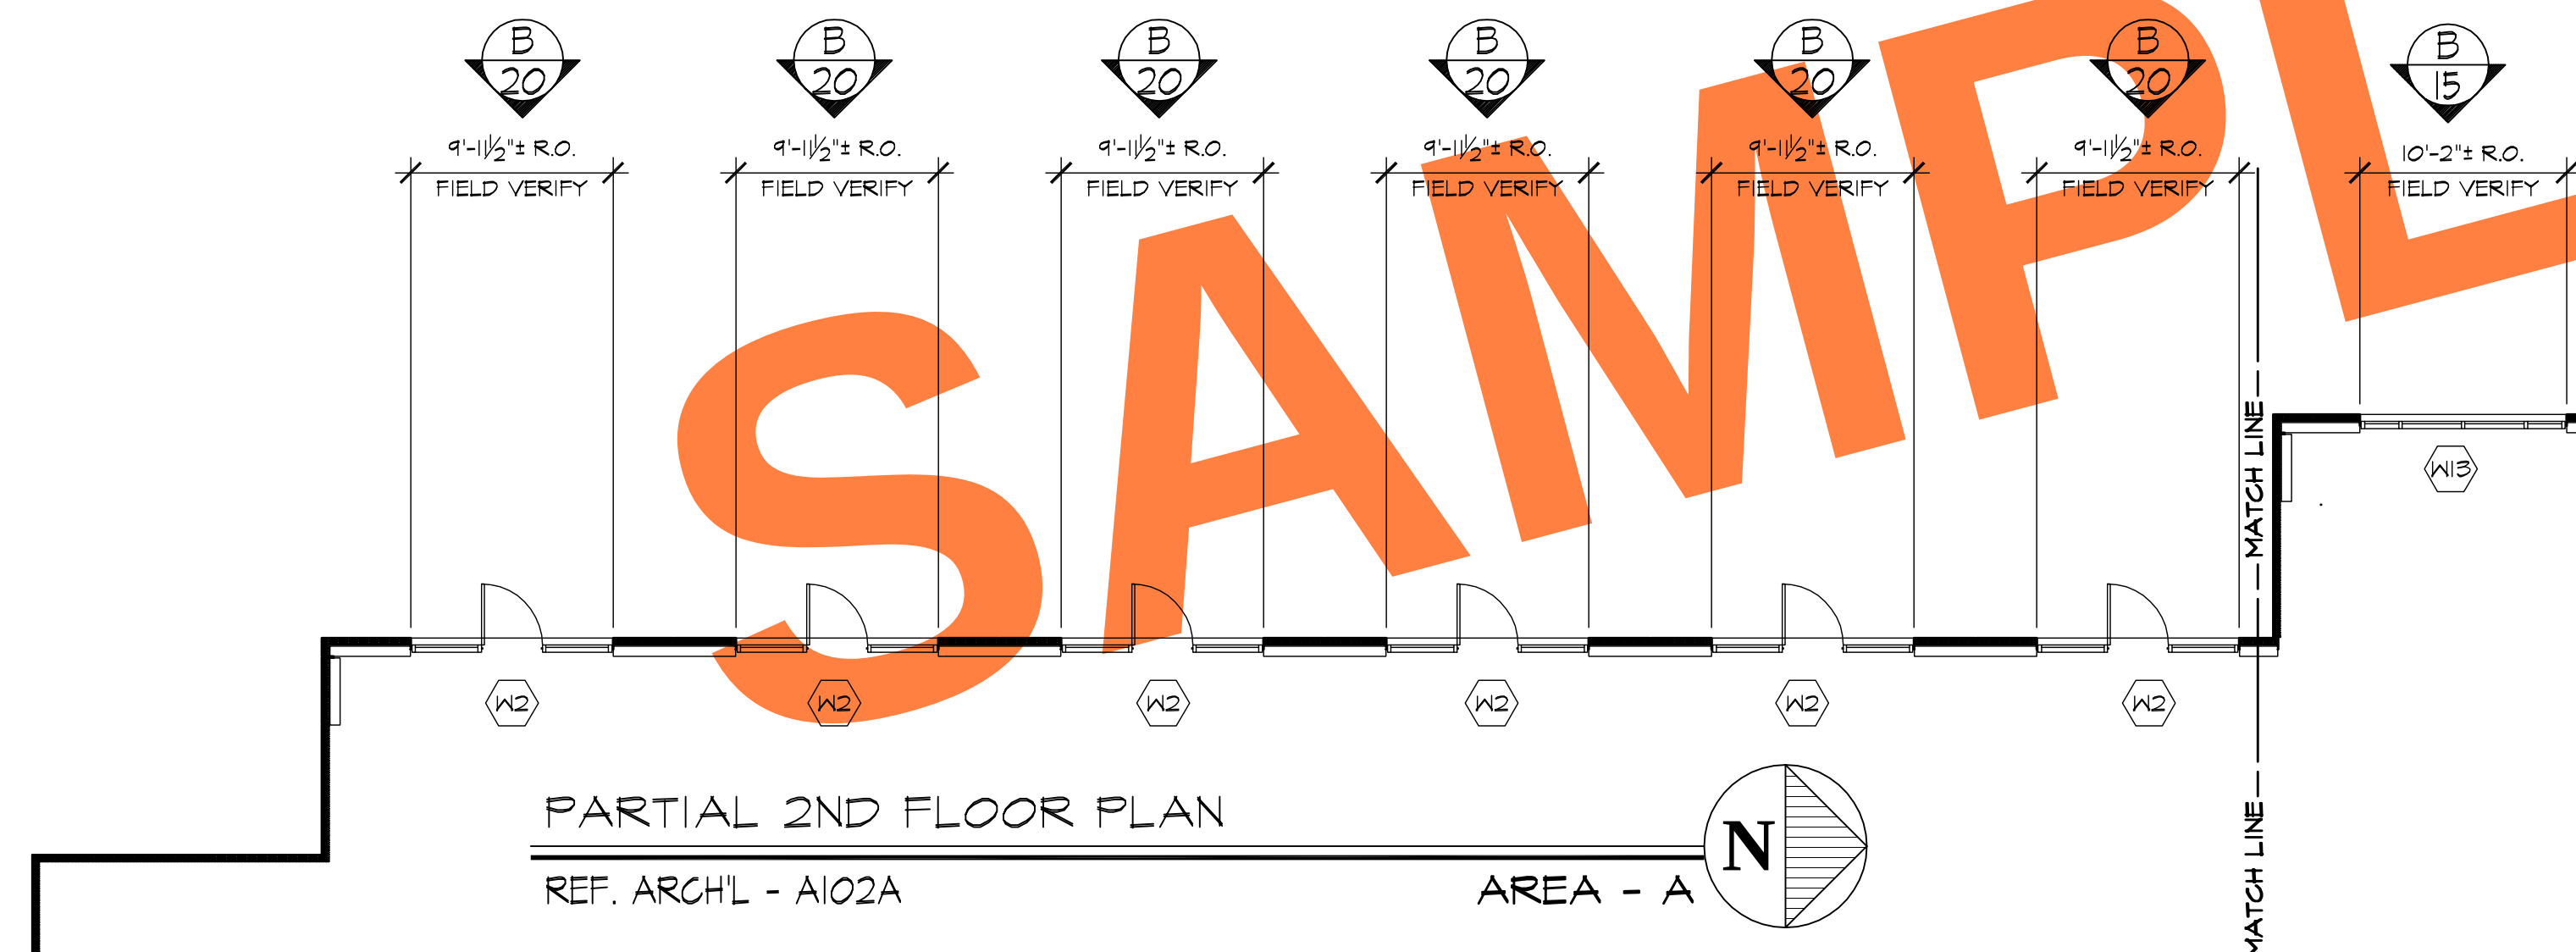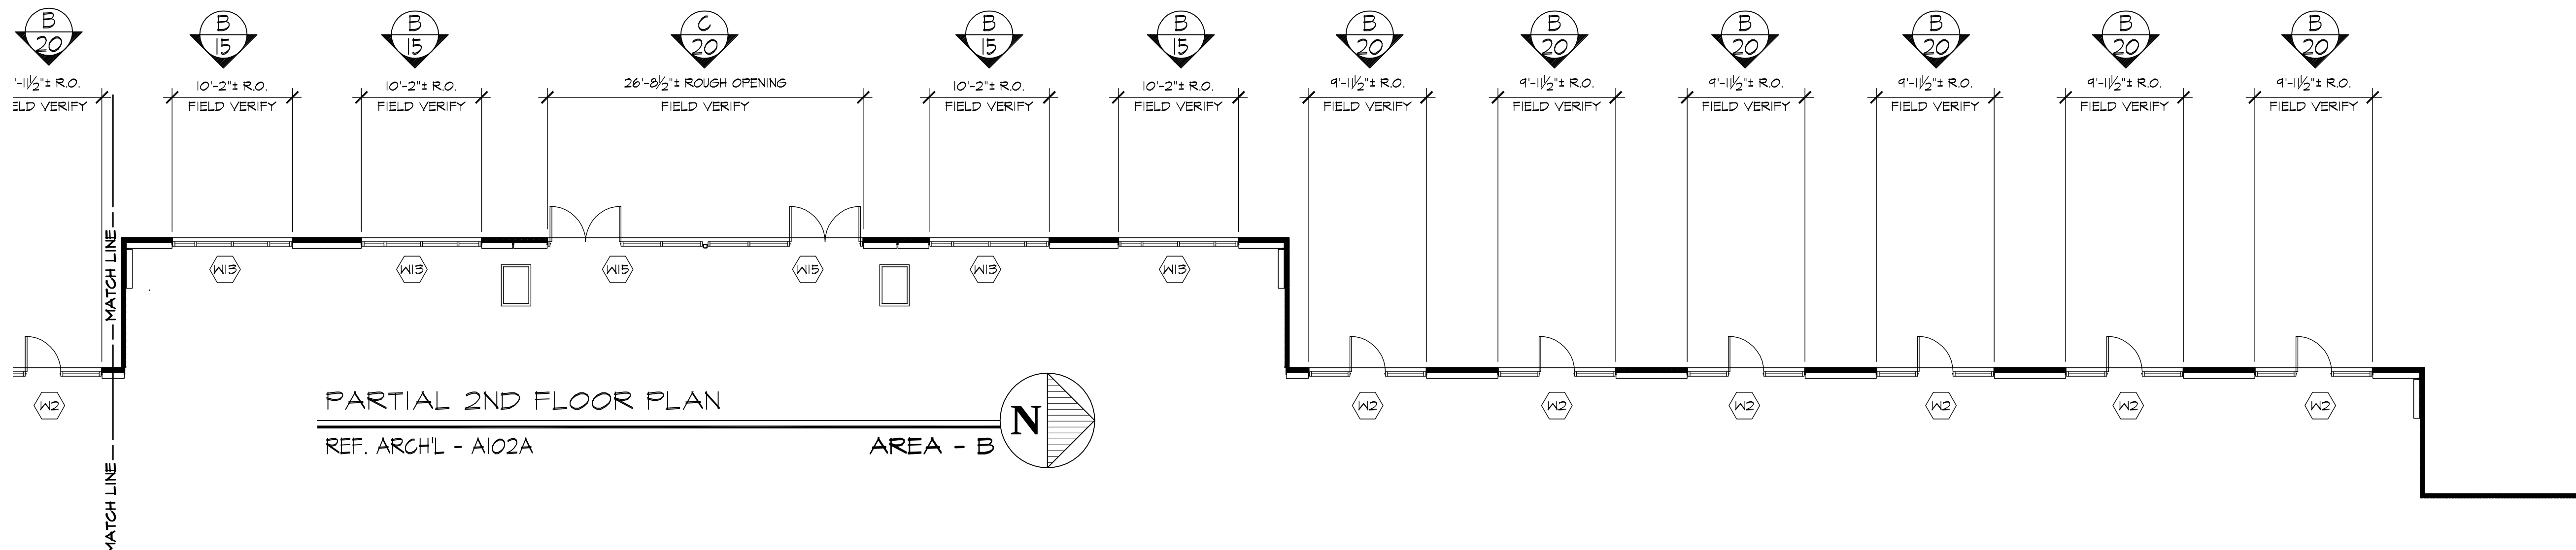


REVISIONS	BY
△	
△	
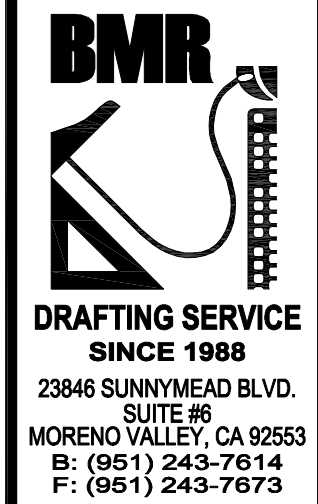

GLASS FACTORY
26383 BASE LINE
HIGHLAND, CA 92346

AS-BUILT DRAWINGS

JOB NAME:	AGUA CALIENTE HOTEL ADDITION
ARCHITECT:	VOA
SHEET DESCRIPTION:	FLOOR PLAN
DATE:	1/3/07
SCALE:	1/8"=1'-0"
DRAWN:	CTB
JOB NO:	100-06
SHEET NO:	4

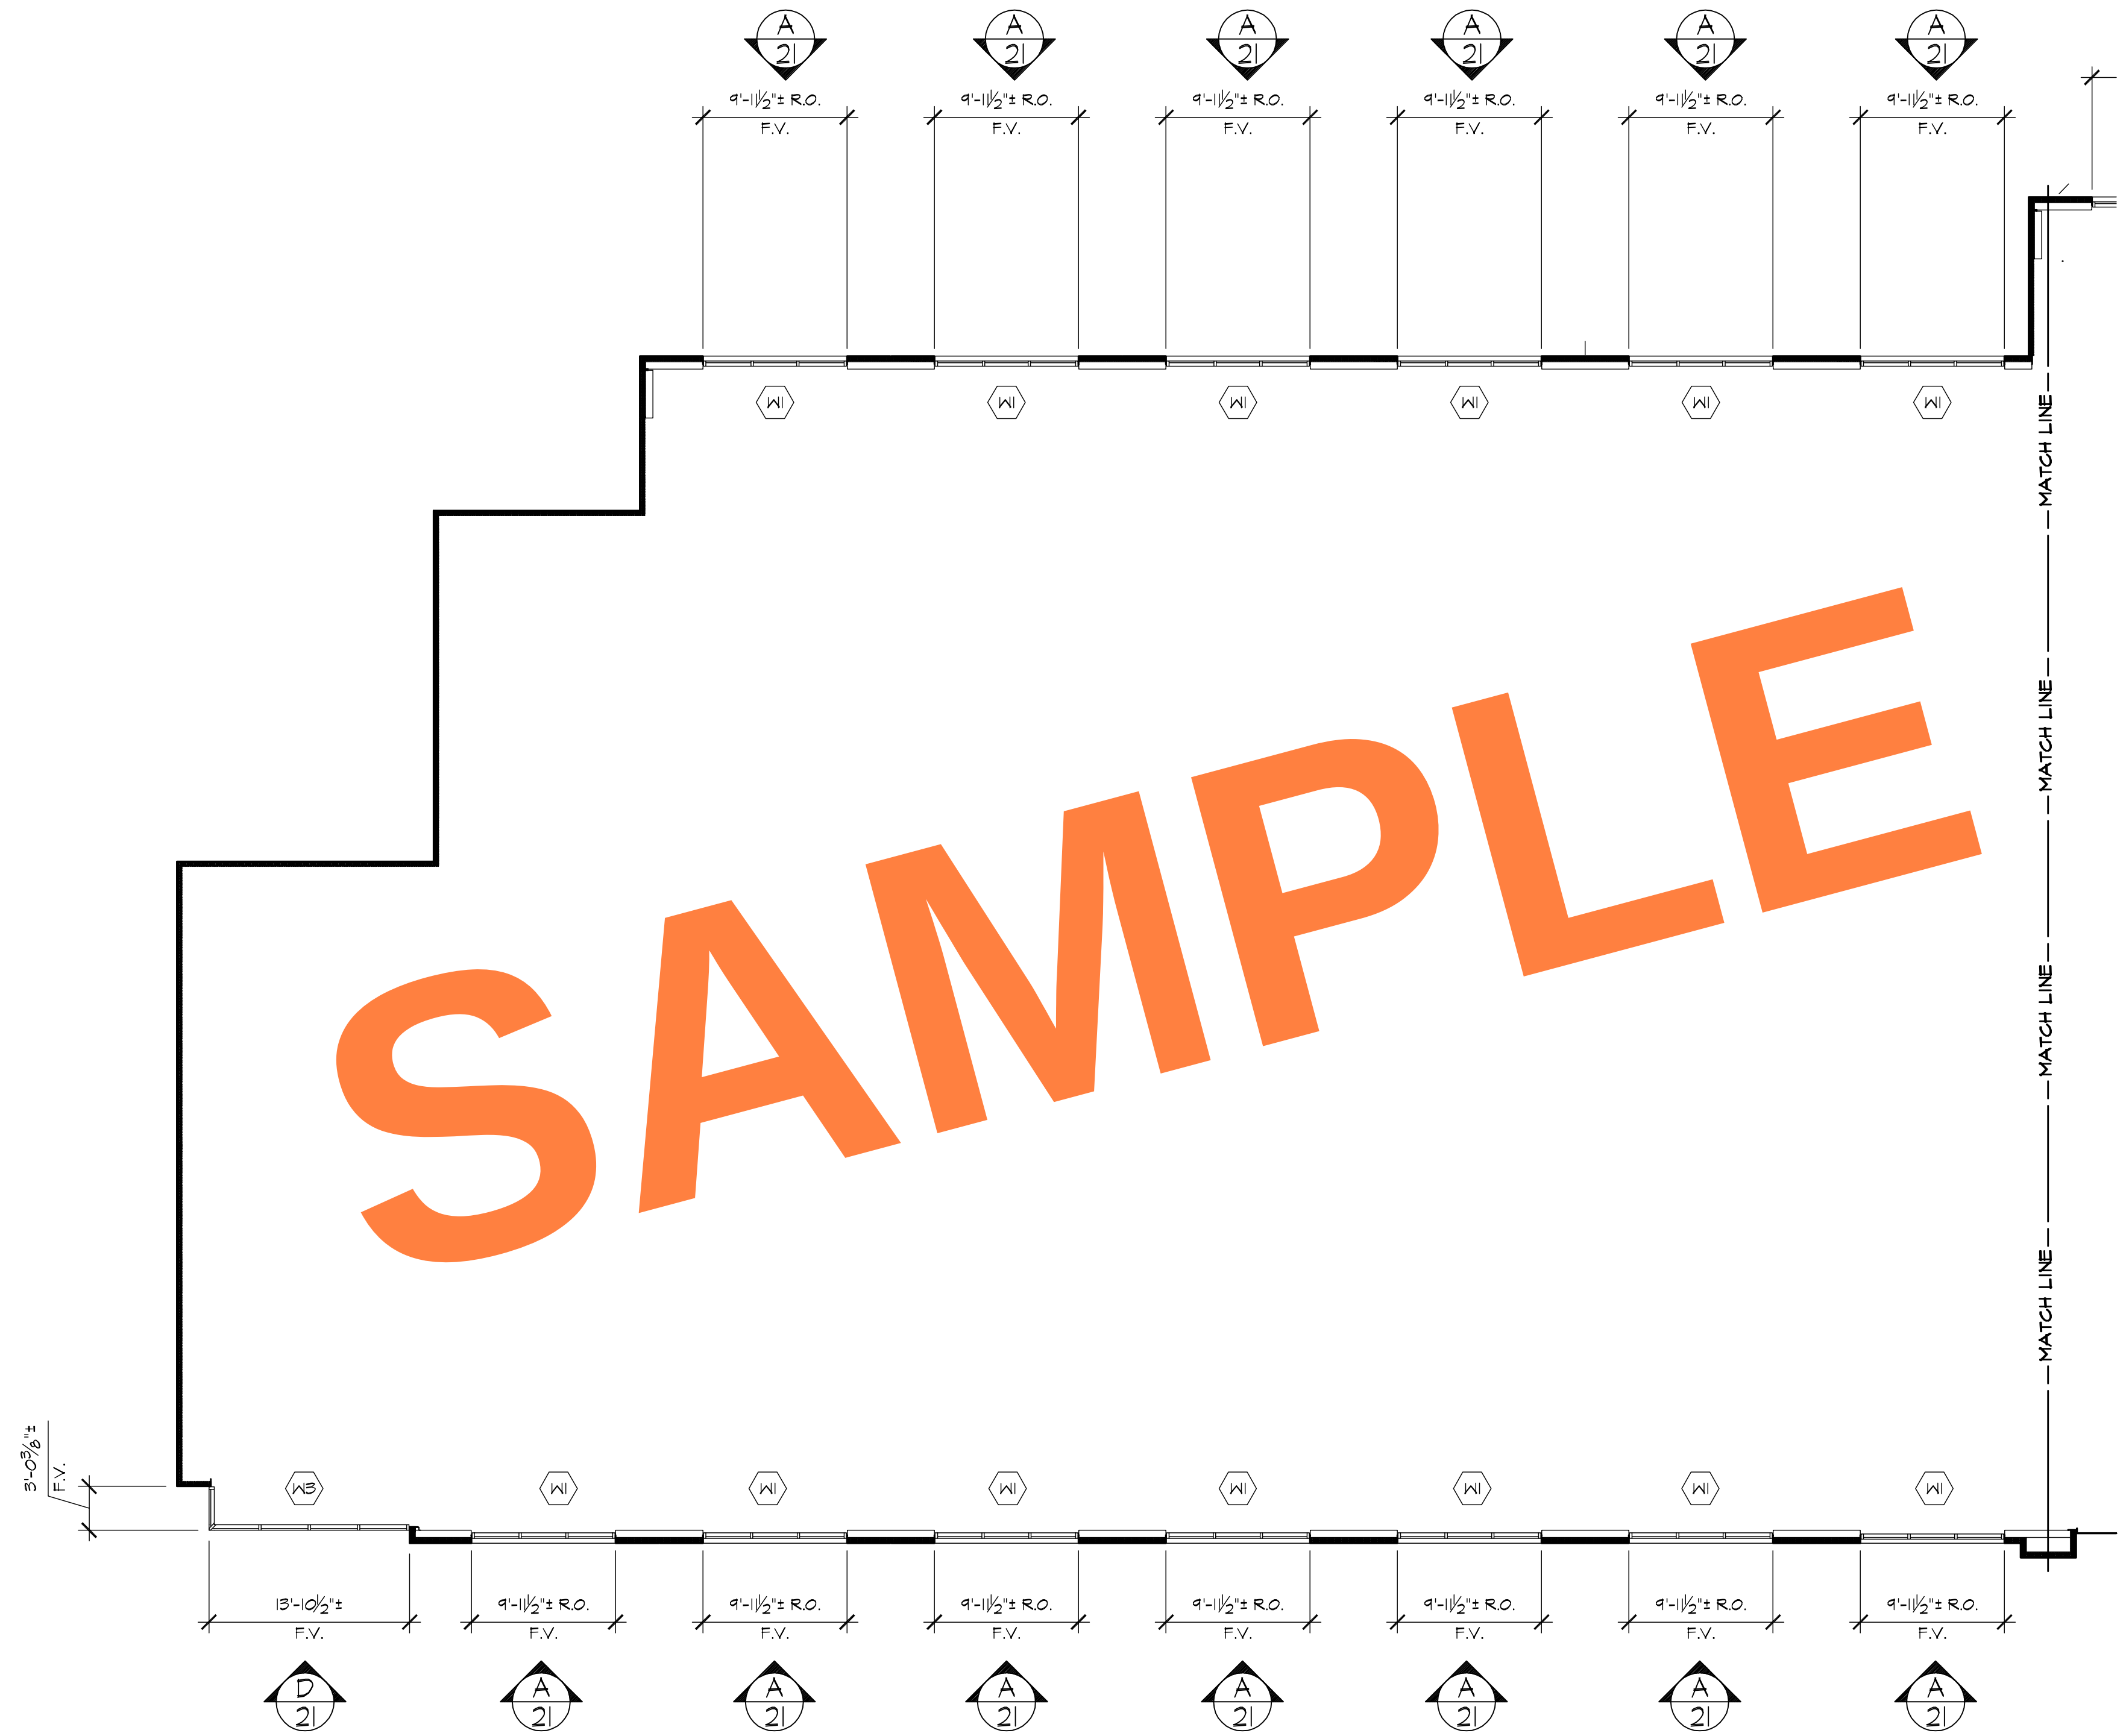

PARTIAL 3RD FLOOR PLAN
REF. ARCH'L - A103A

AREA - A

N


REVISIONS		BY
△		
△		
BMR DRAFTING SERVICE SINCE 1988 23846 SUNNYMEAD BLVD. SUITE #9 MORENO VALLEY, CA 92553 B: (951) 243-7814 F: (951) 243-7873		
GLASS FACTORY 26383 BASE LINE HIGHLAND, CA 92346 AS-BUILT DRAWINGS		
JOB NAME: AGUA CALIENTE HOTEL ADDITION ARCHITECT: VOA SHEET DESCRIPTION: FLOOR PLAN DATE: 1/3/07 SCALE: 1/8"=1'-0" DRAWN: CTB JOB NO: 100-06 SHEET NO: 5		



PARTIAL 3RD FLOOR PLAN

REF. ARCH'L - A103B

AREA - B

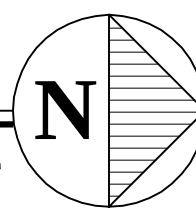

REVISIONS	BY
△	
△	
BMR
DRAFTING SERVICE
SINCE 1988
23846 SUNNYMEAD BLVD.
SUITE #9
MORENO VALLEY, CA 92553
B: (951) 243-7814
F: (951) 243-7873

GLASS FACTORY
26383 BASE LINE
HIGHLAND, CA 92346


AS-BUILT DRAWINGS


JOB NAME:	AGUA CALIENTE HOTEL ADDITION
ARCHITECT:	VOA
SHEET DESCRIPTION:	FLOOR PLAN

DATE:	1/3/07
SCALE:	1/8"=1'-0"
DRAWN:	CTB
JOB NO:	100-06
SHEET NO:	6

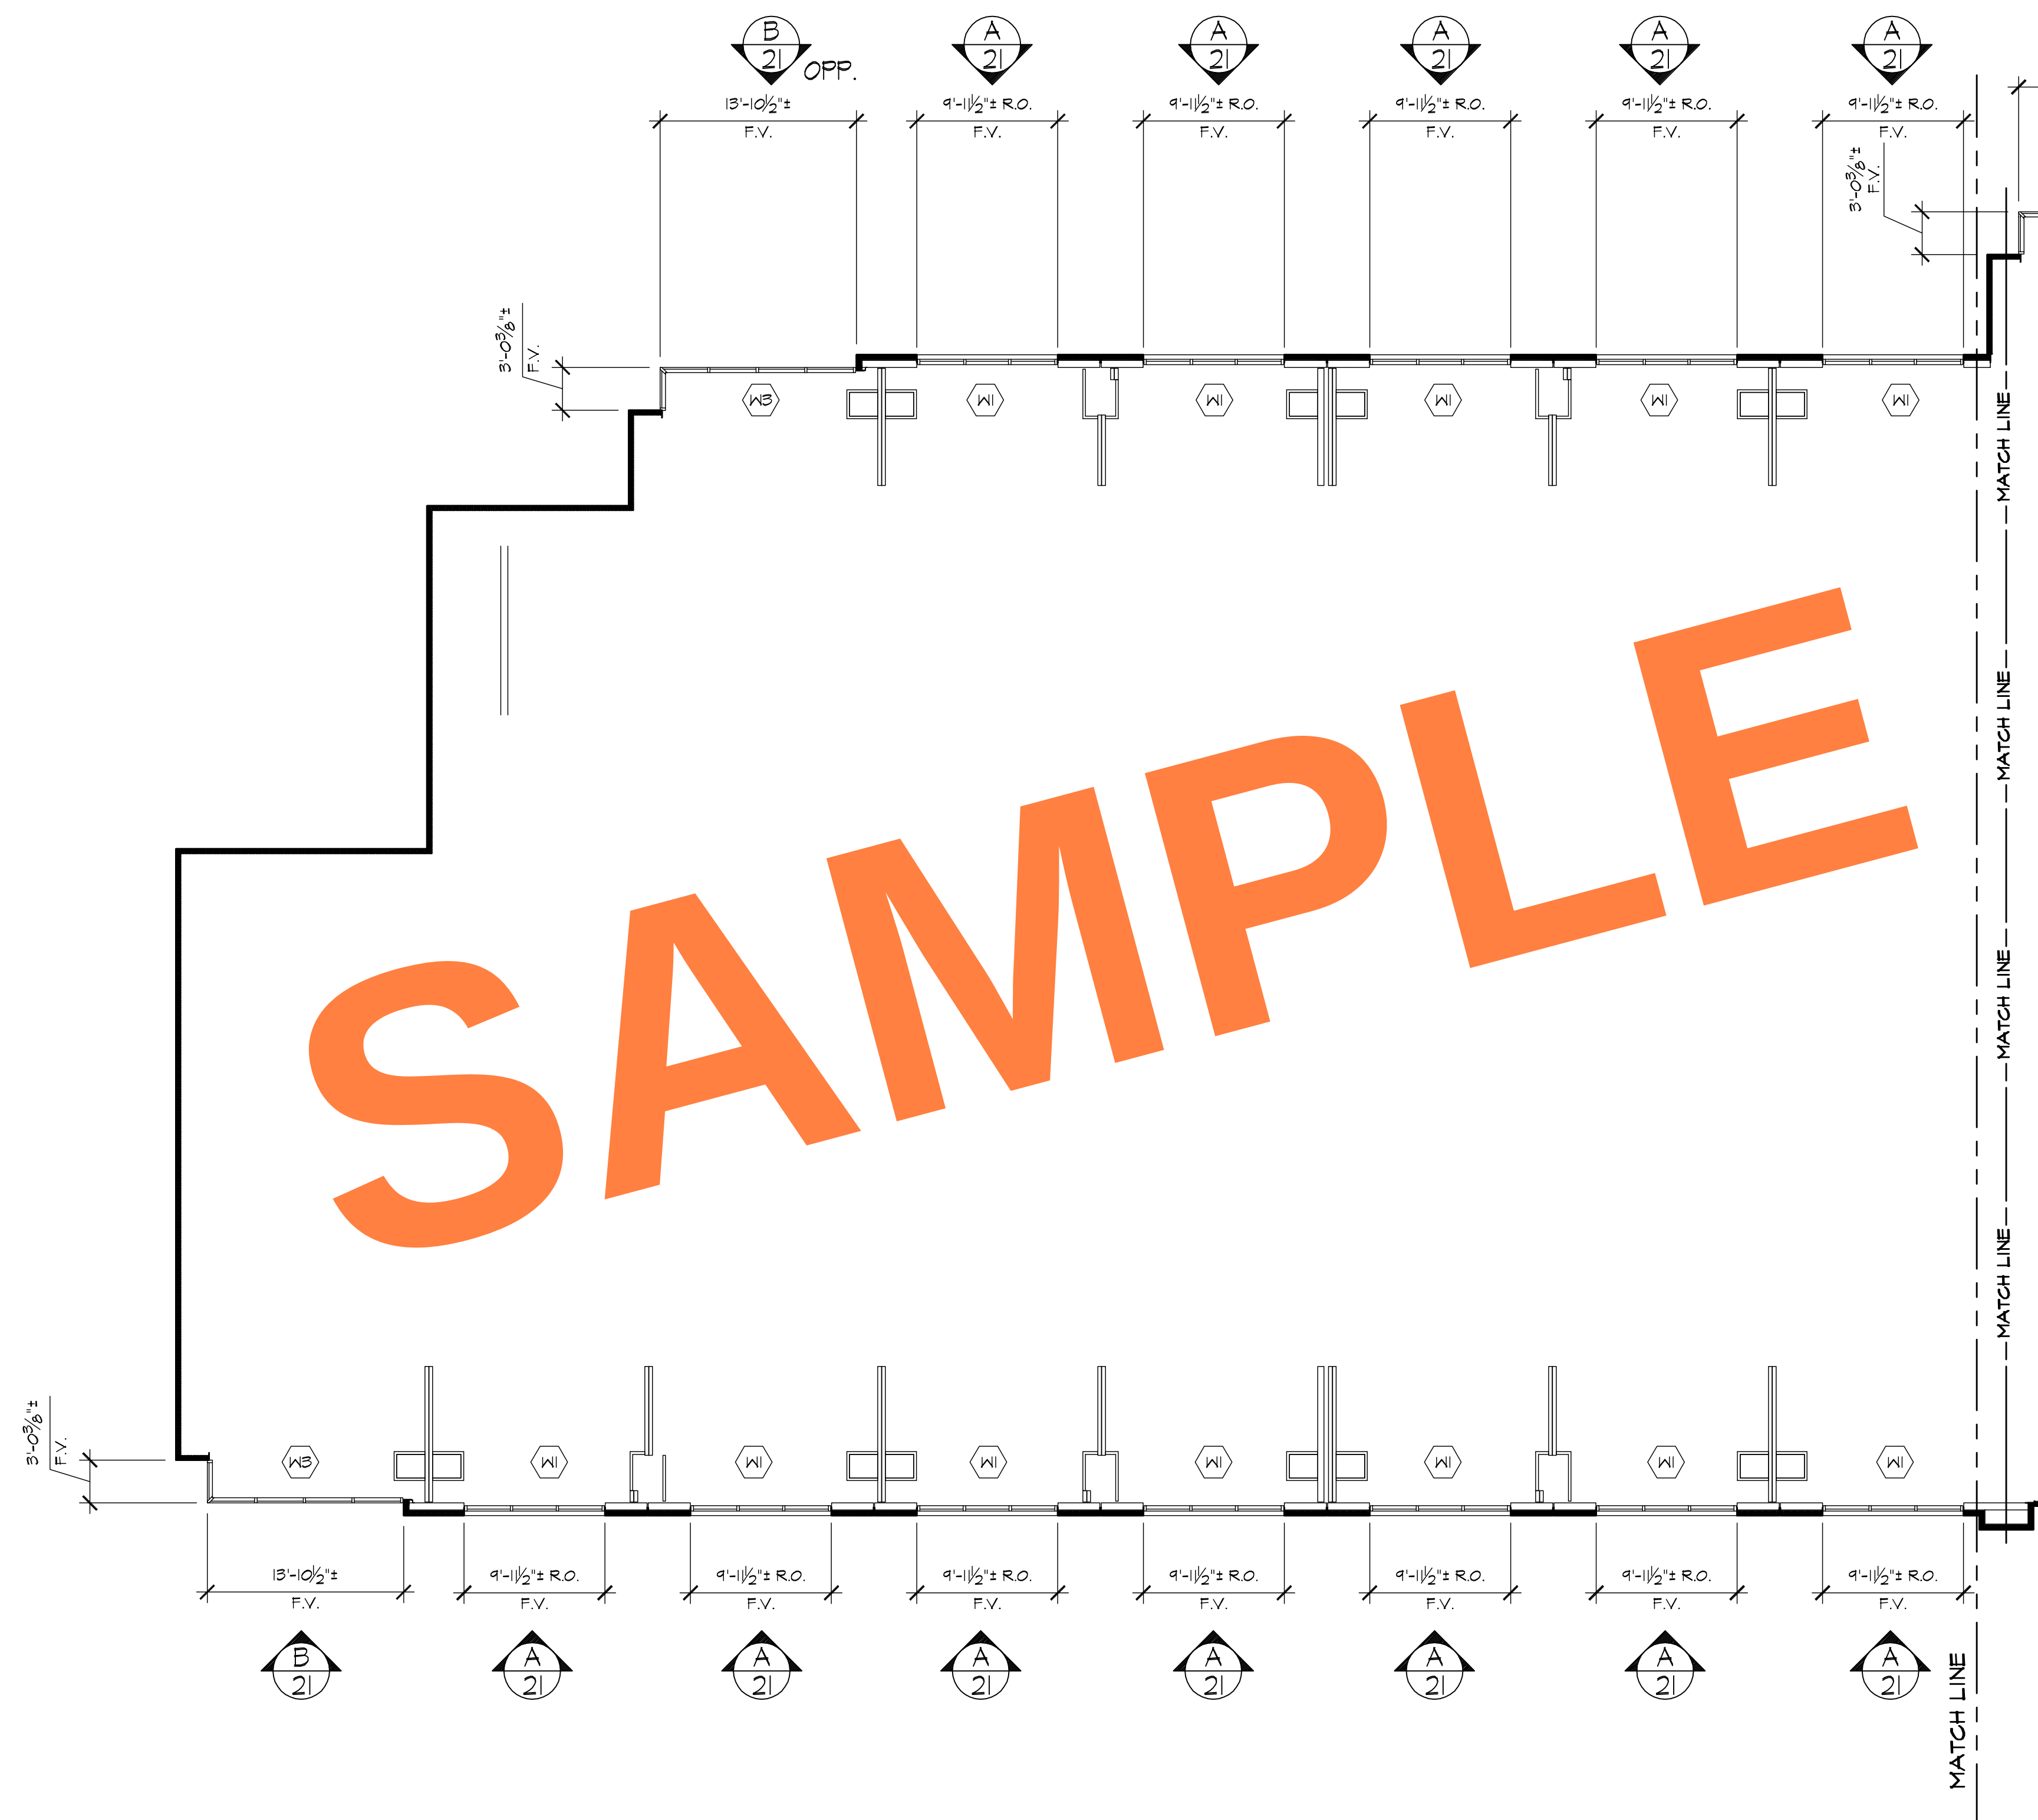

PARTIAL 4TH, 5TH, 6TH, 7TH & 8TH FLOOR PLAN
REF. ARCH'L - A104A, A105A, A106A, A107A, A108A AREA - A

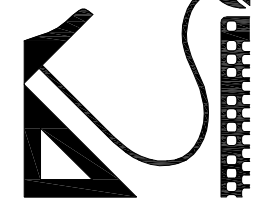
REVISIONS		BY
△		
△		
BMR  DRAFTING SERVICE SINCE 1988 23846 SUNNYMEAD BLVD. SUITE #9 MORENO VALLEY, CA 92553 B: (951) 243-7814 F: (951) 243-7873		
AS-BUILT DRAWINGS GLASS FACTORY 26383 BASE LINE HIGHLAND, CA 92346		
JOB NAME:	AGUA CALIENTE HOTEL ADDITION	
ARCHITECT:	VOA	
SHEET DESCRIPTION:	FLOOR PLAN	
DATE:	1/3/07	
SCALE:	1/8"=1'-0"	
DRAWN:	CTB	
JOB NO:	100-06	
SHEET NO:	7	

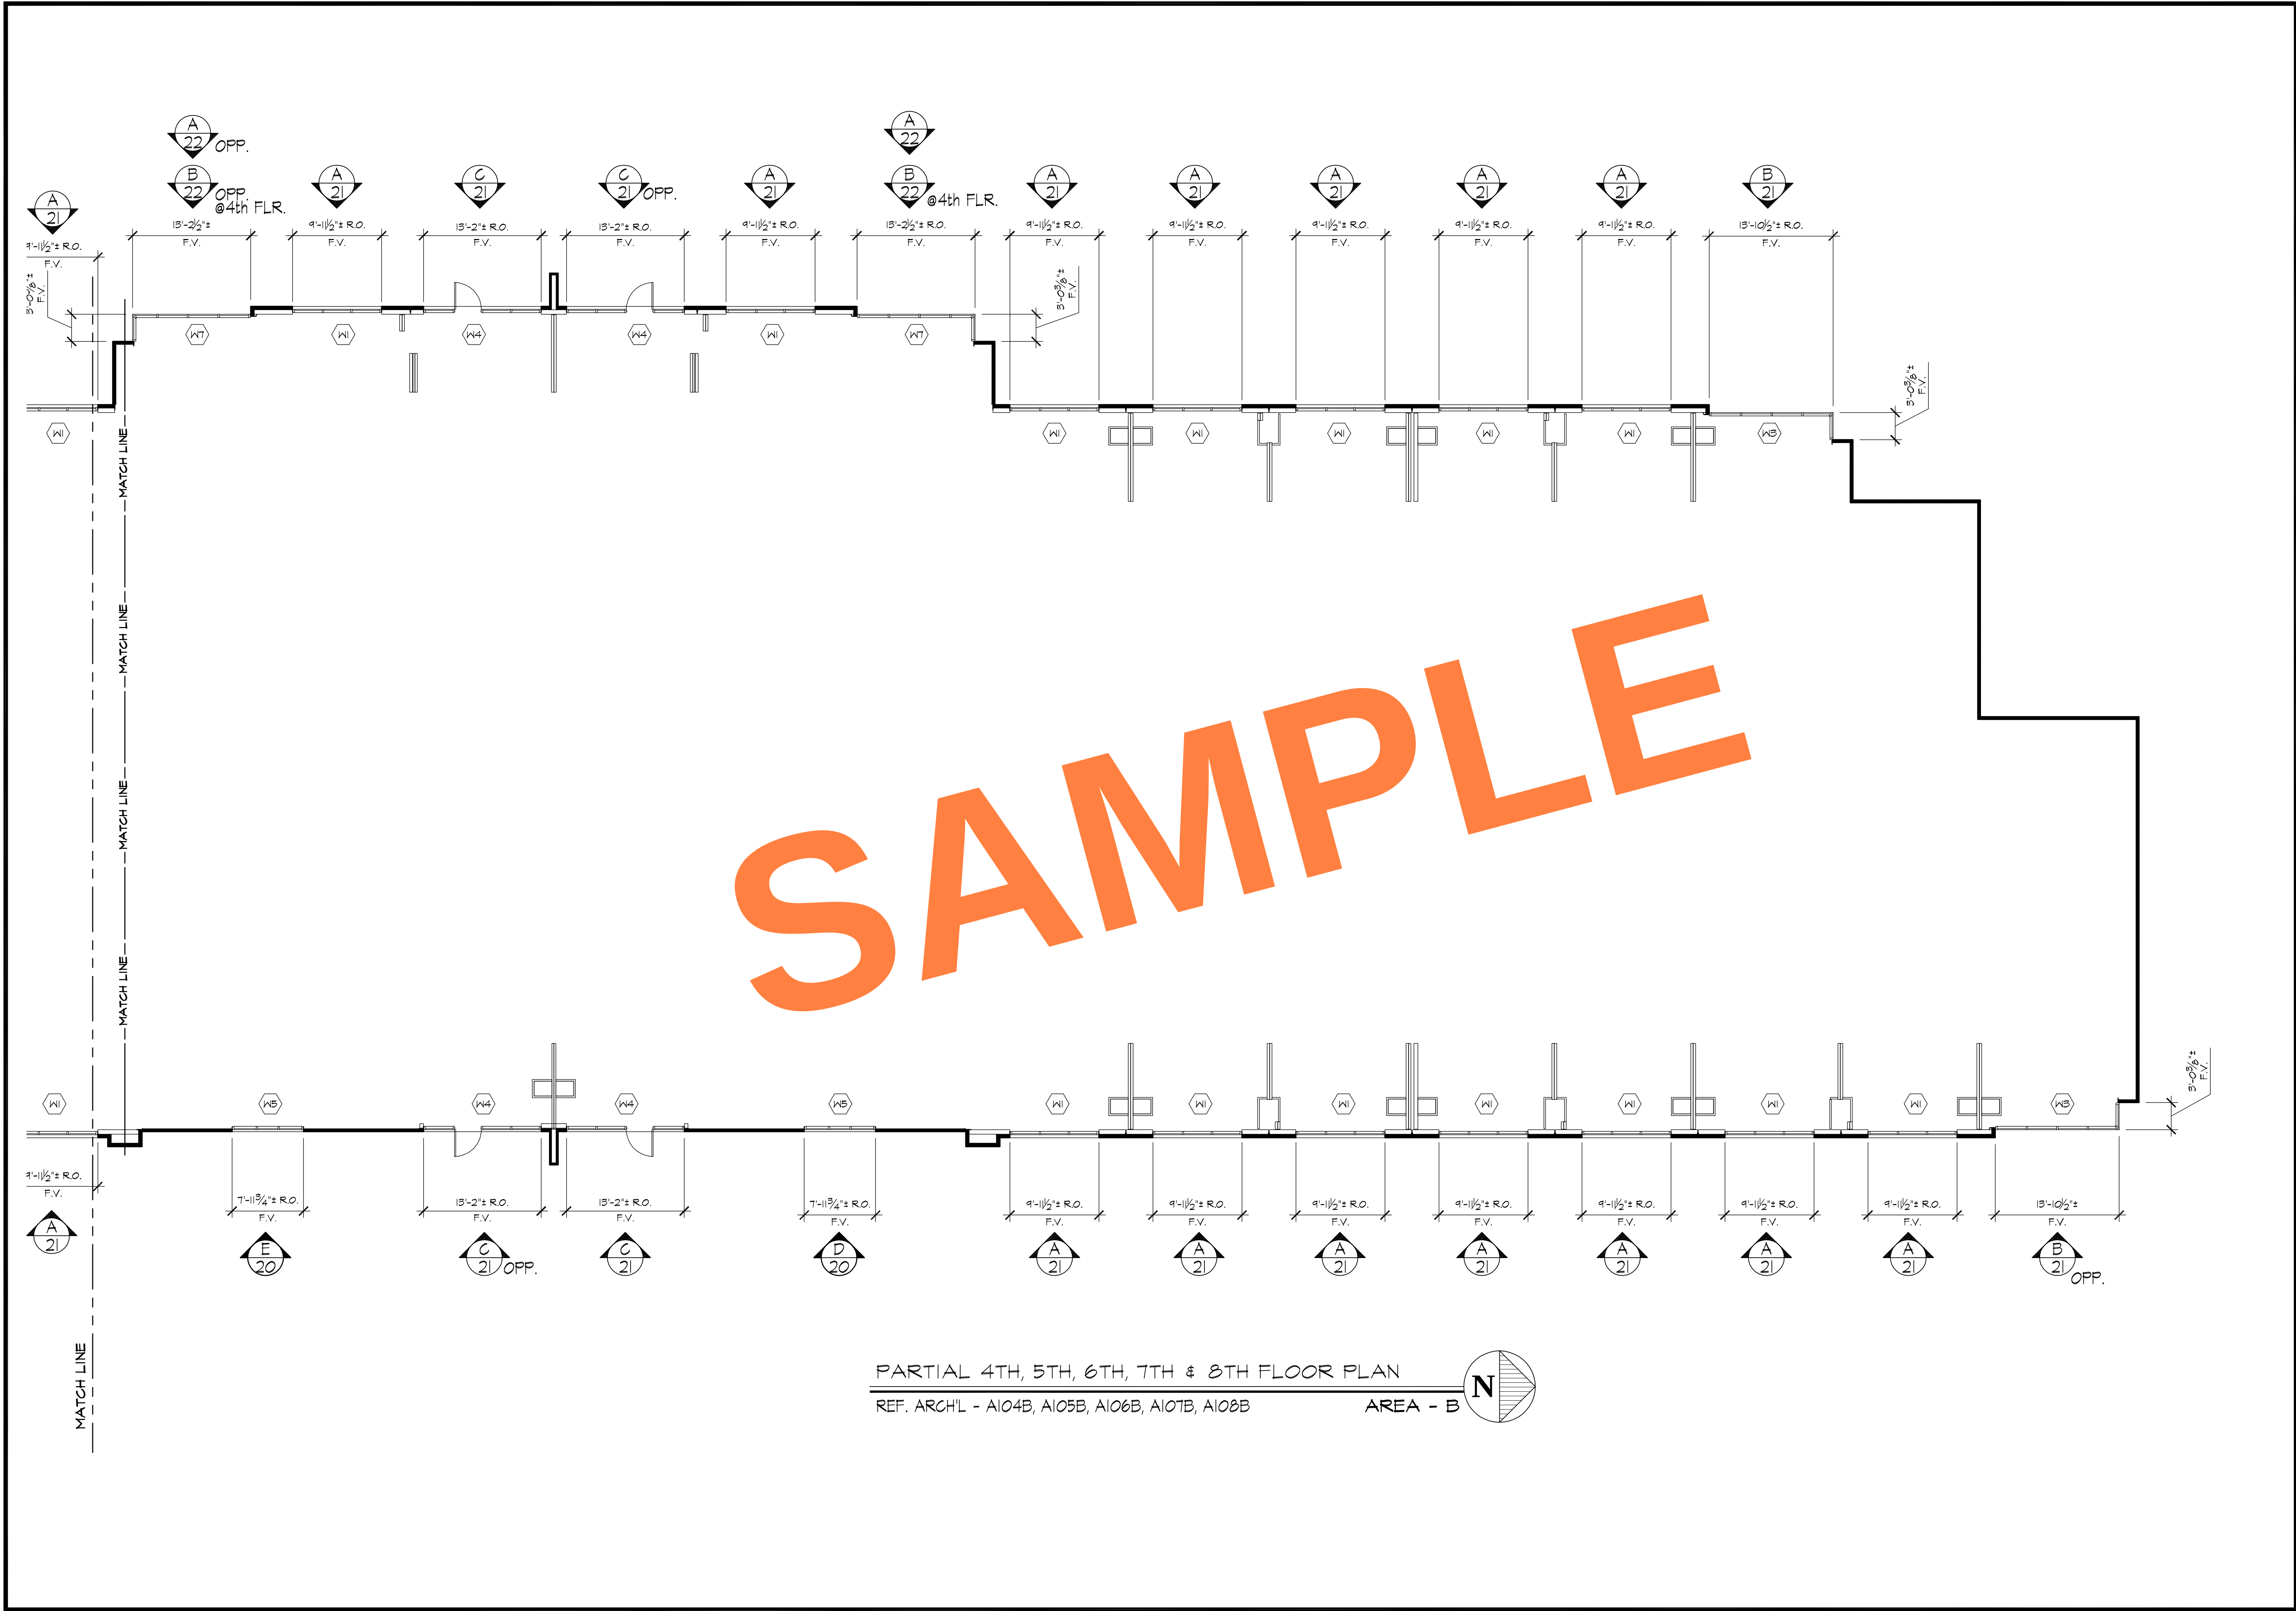



PARTIAL 4TH, 5TH, 6TH, 7TH & 8TH FLOOR PLAN

REF. ARCH'L - A104B, A105B, A106B, A107B, A108B


AREA - B

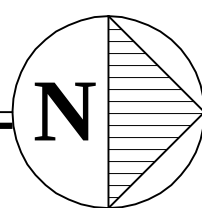

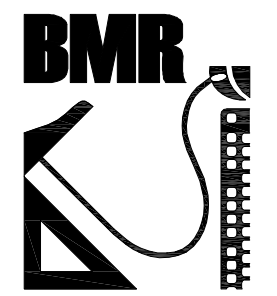
REVISIONS		BY
△		
△		
		
DRAFTING SERVICE SINCE 1988 23846 SUNNYMEAD BLVD. SUITE #9 MORENO VALLEY, CA 92553 B: (951) 243-7814 F: (951) 243-7873		
GLASS FACTORY 26383 BASE LINE HIGHLAND, CA 92346		
AS-BUILT DRAWINGS		
JOB NAME:	AGUA CALIENTE HOTEL ADDITION	
ARCHITECT:	VOA	
SHEET DESCRIPTION:	FLOOR PLAN	
DATE:	1/3/07	
SCALE:	1/8"=1'-0"	
DRAWN:	CTB	
JOB NO:	100-06	
SHEET NO:	8	

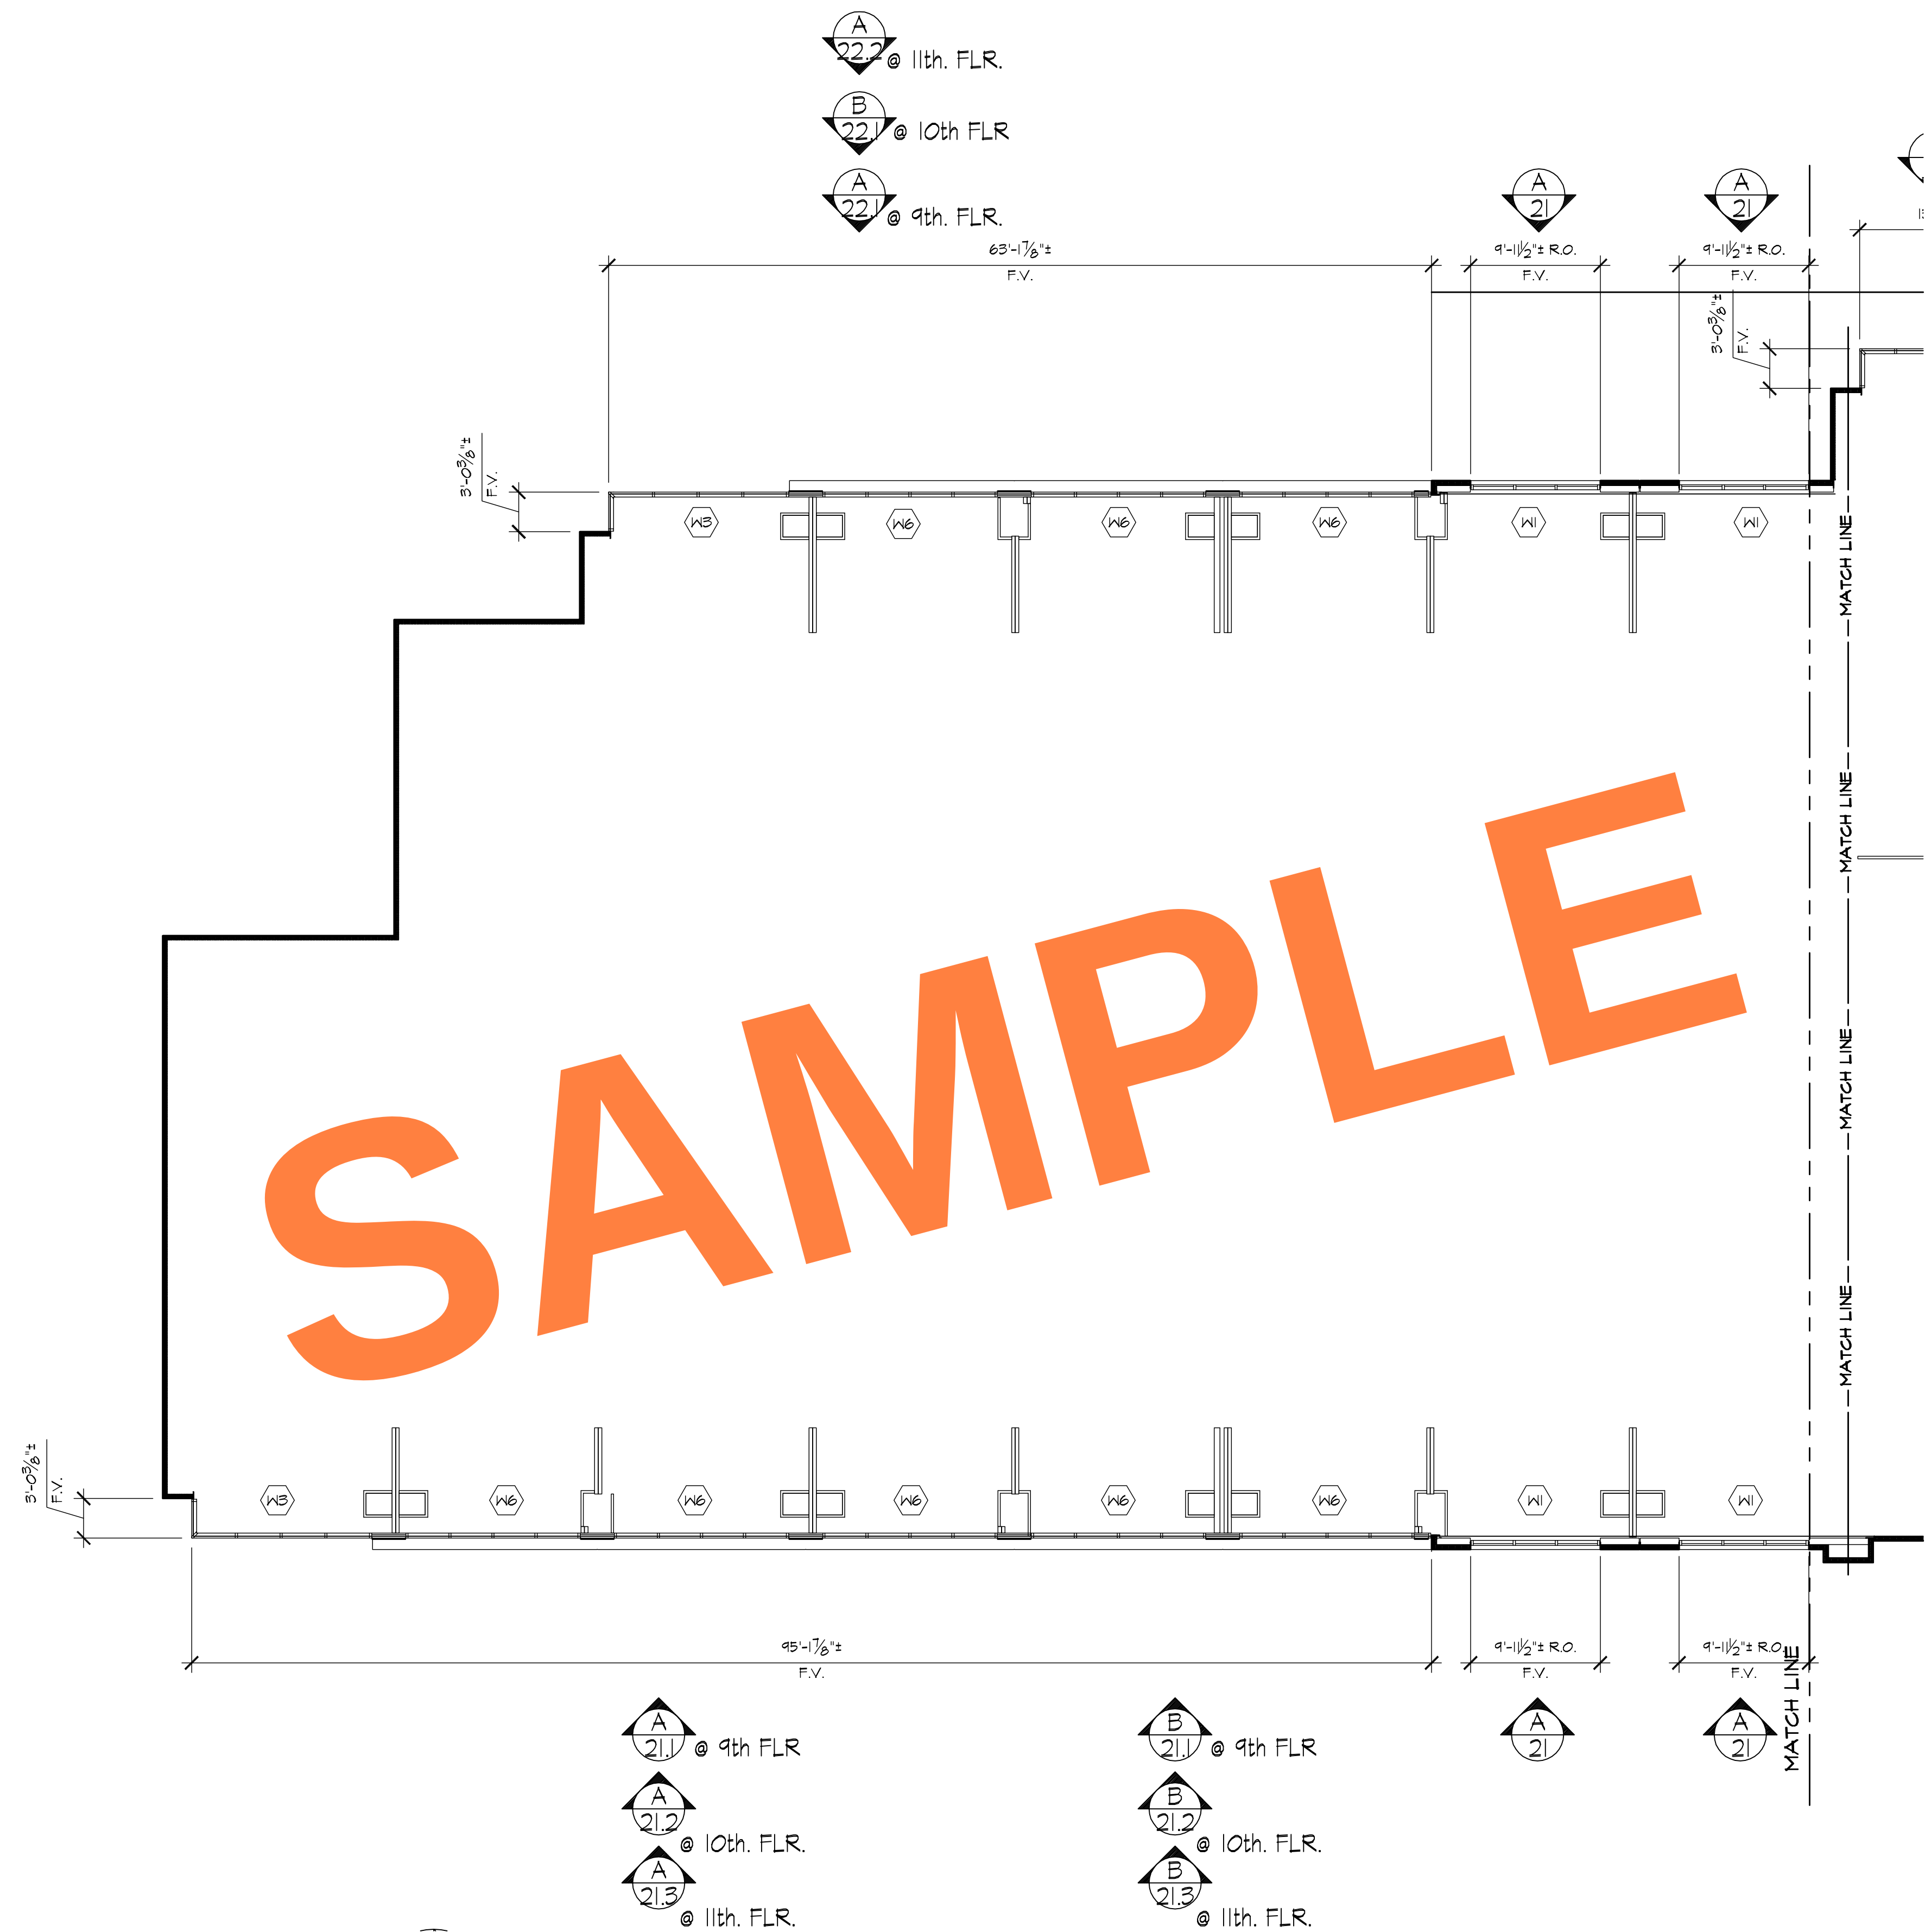

PARTIAL 9TH, 10TH & 11TH FLOOR PLAN
REF. ARCH'L - A109A, A110A, A111A
AREA - A

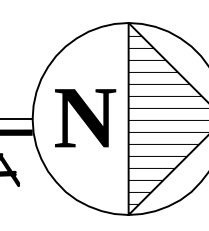


REVISIONS		BY
△		
△		
BMR DRAFTING SERVICE SINCE 1988 23846 SUNNYMEAD BLVD. SUITE #9 MORENO VALLEY, CA 92553 B: (951) 243-7814 F: (951) 243-7873		
AS-BUILT DRAWINGS GLASS FACTORY 26383 BASE LINE HIGHLAND, CA 92346		
JOB NAME:	AGUA CALIENTE HOTEL ADDITION	
ARCHITECT:	VOA	
SHEET DESCRIPTION:	FLOOR PLAN	
DATE:	1/3/07	
SCALE:	1/8"=1'-0"	
DRAWN:	CTB	
JOB NO:	100-06	
SHEET NO:	9	

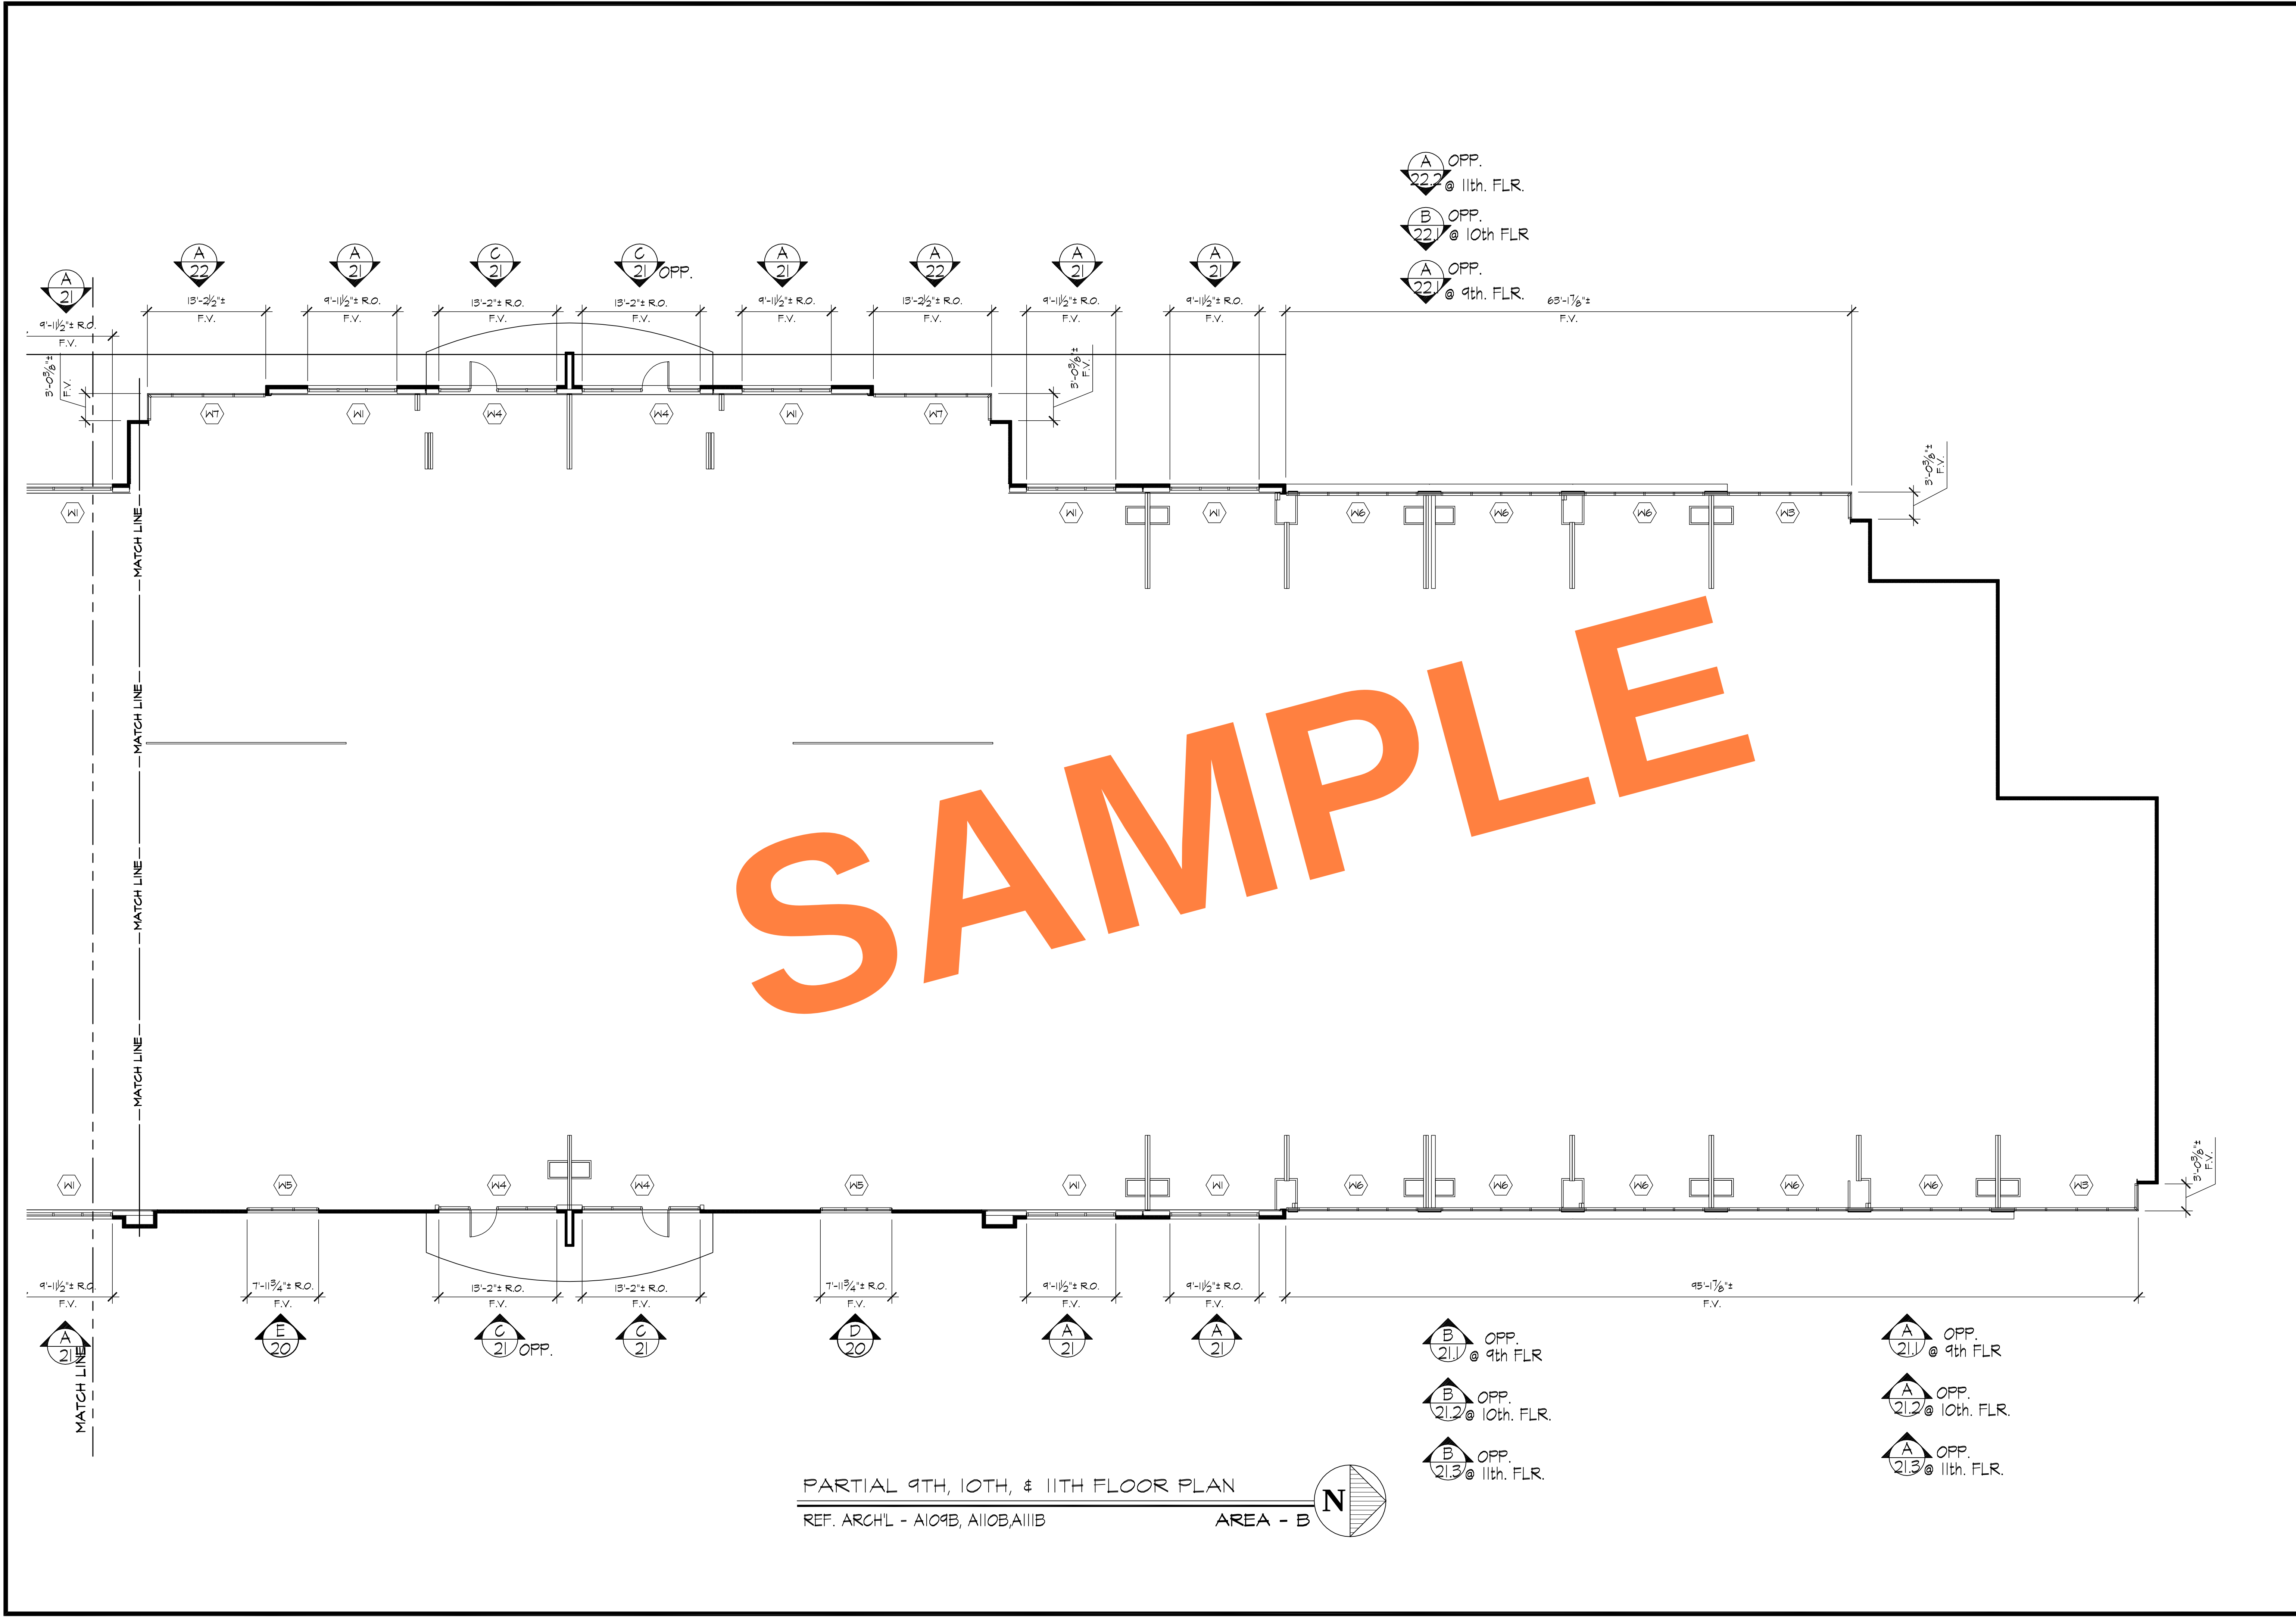


PARTIAL 9TH, 10TH, & 11TH FLOOR PLAN

REF. ARCH'L - A109B, A110B, A111B



AREA - B

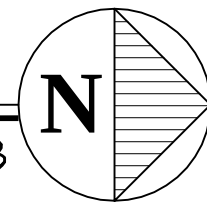


REVISIONS		BY
△		
△		
BMR DRAFTING SERVICE SINCE 1988 23846 SUNNYMEAD BLVD. SUITE #6 MORENO VALLEY, CA 92553 B: (951) 243-7814 F: (951) 243-7873		
AS-BUILT DRAWINGS		
GLASS FACTORY 26383 BASE LINE HIGHLAND, CA 92346		
JOB NAME:	AGUA CALIENTE HOTEL ADDITION	
ARCHITECT:	VOA	
SHEET DESCRIPTION:	FLOOR PLAN	
DATE:	1/3/07	
SCALE:	1/8"=1'-0"	
DRAWN:	CTB	
JOB NO:	100-06	
SHEET NO:	10	

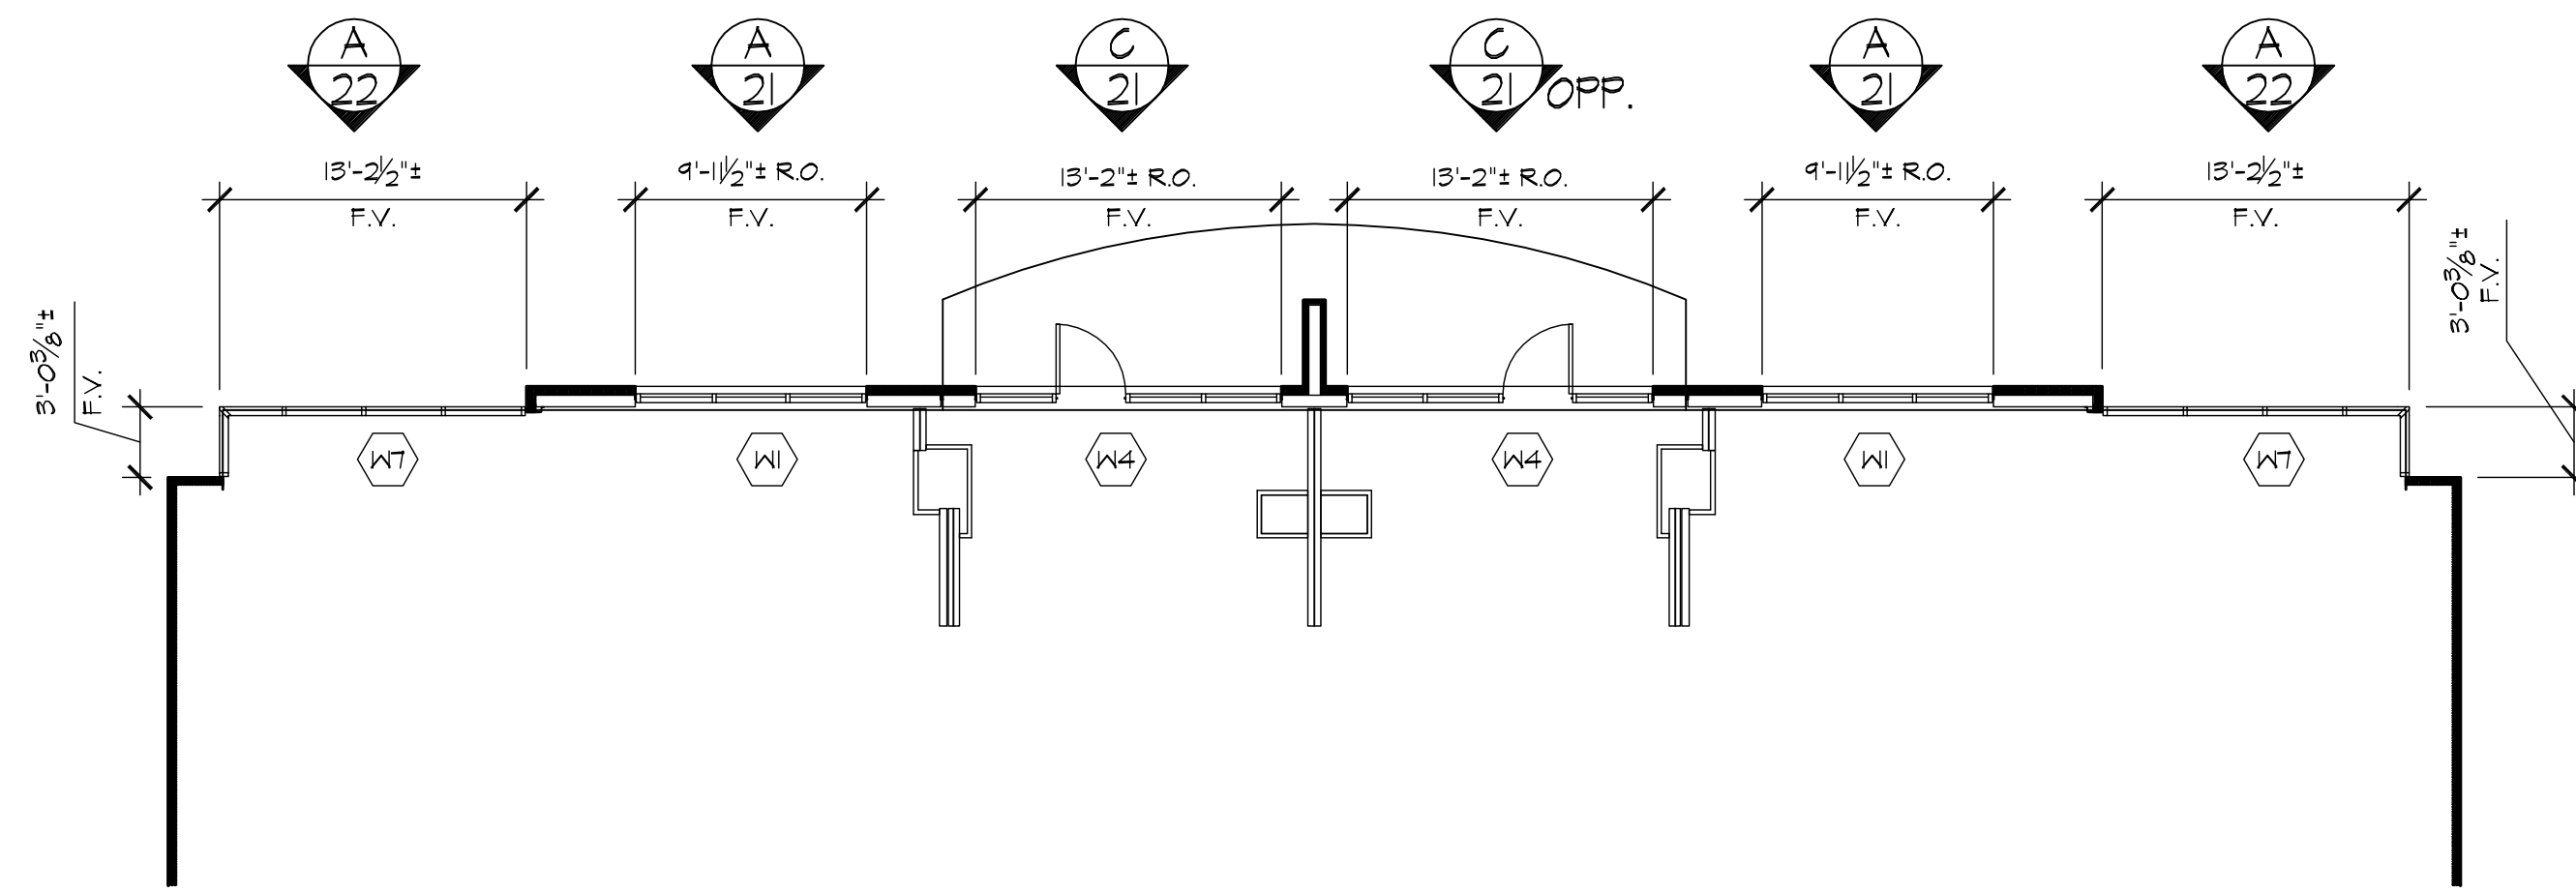

PARTIAL 12TH FLOOR PLAN
REF. ARCH'L - A112B
AREA - B

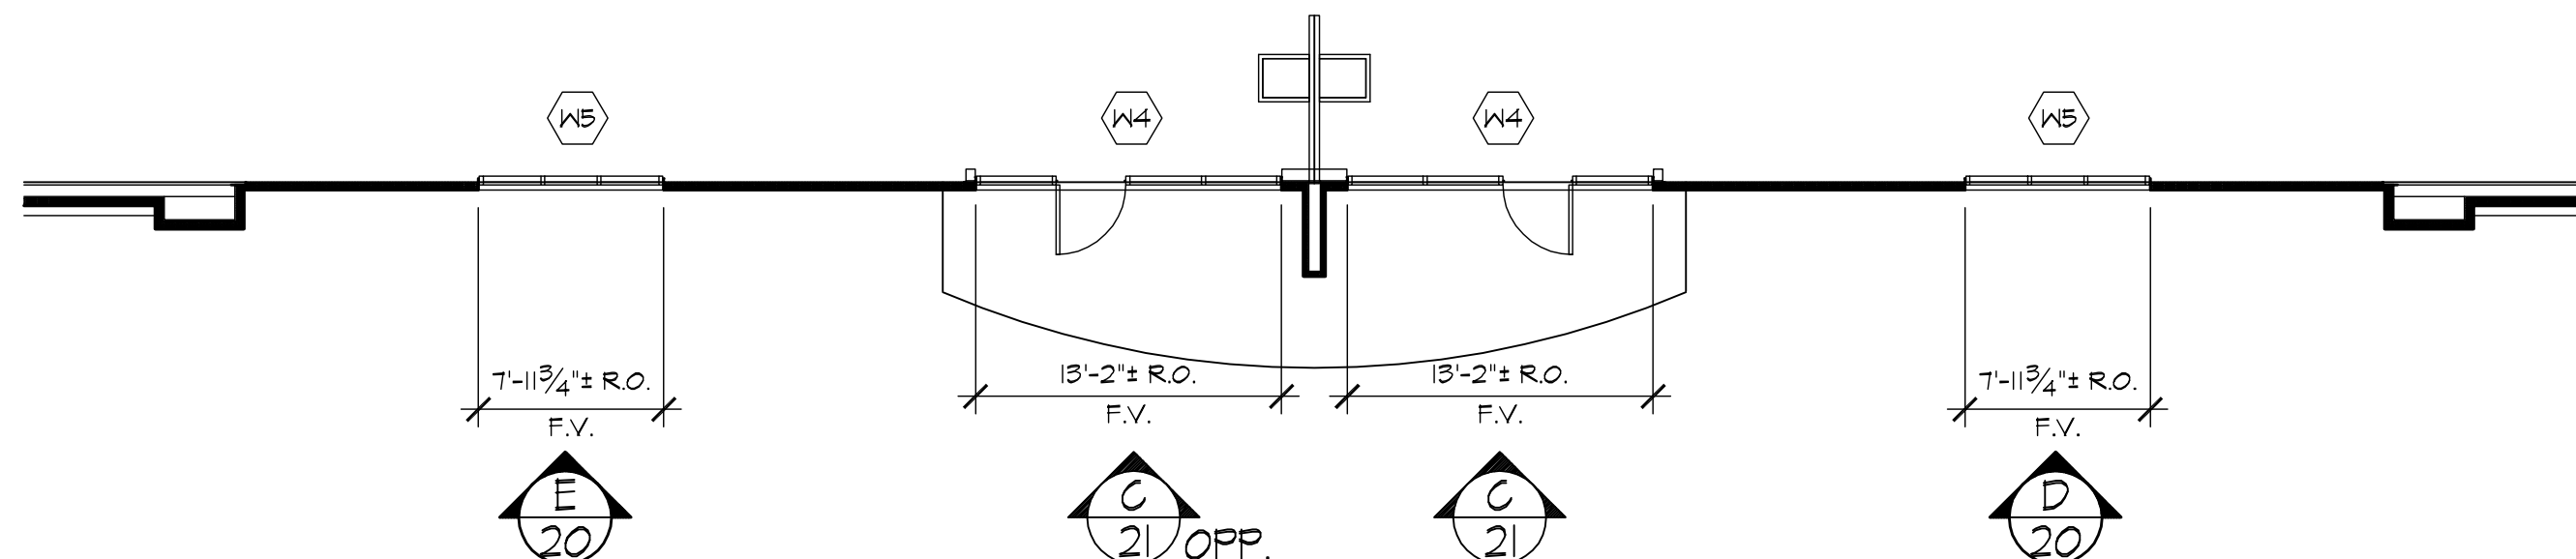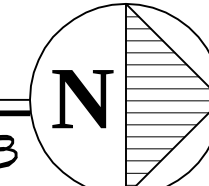


REVISIONS		BY
△		
△		
BMR DRAFTING SERVICE SINCE 1988 23846 SUNNYMEAD BLVD. SUITE #9 MORENO VALLEY, CA 92553 B: (951) 243-7814 F: (951) 243-7873		
GLASS FACTORY 26383 BASE LINE HIGHLAND, CA 92346 AS-BUILT DRAWINGS		
JOB NAME:	AGUA CALIENTE HOTEL ADDITION	
ARCHITECT:	VOA	
SHEET DESCRIPTION:	FLOOR PLAN	
DATE:	1/3/07	
SCALE:	1/8"=1'-0"	
DRAWN:	CTB	
JOB NO:	100-06	
SHEET NO:	11	

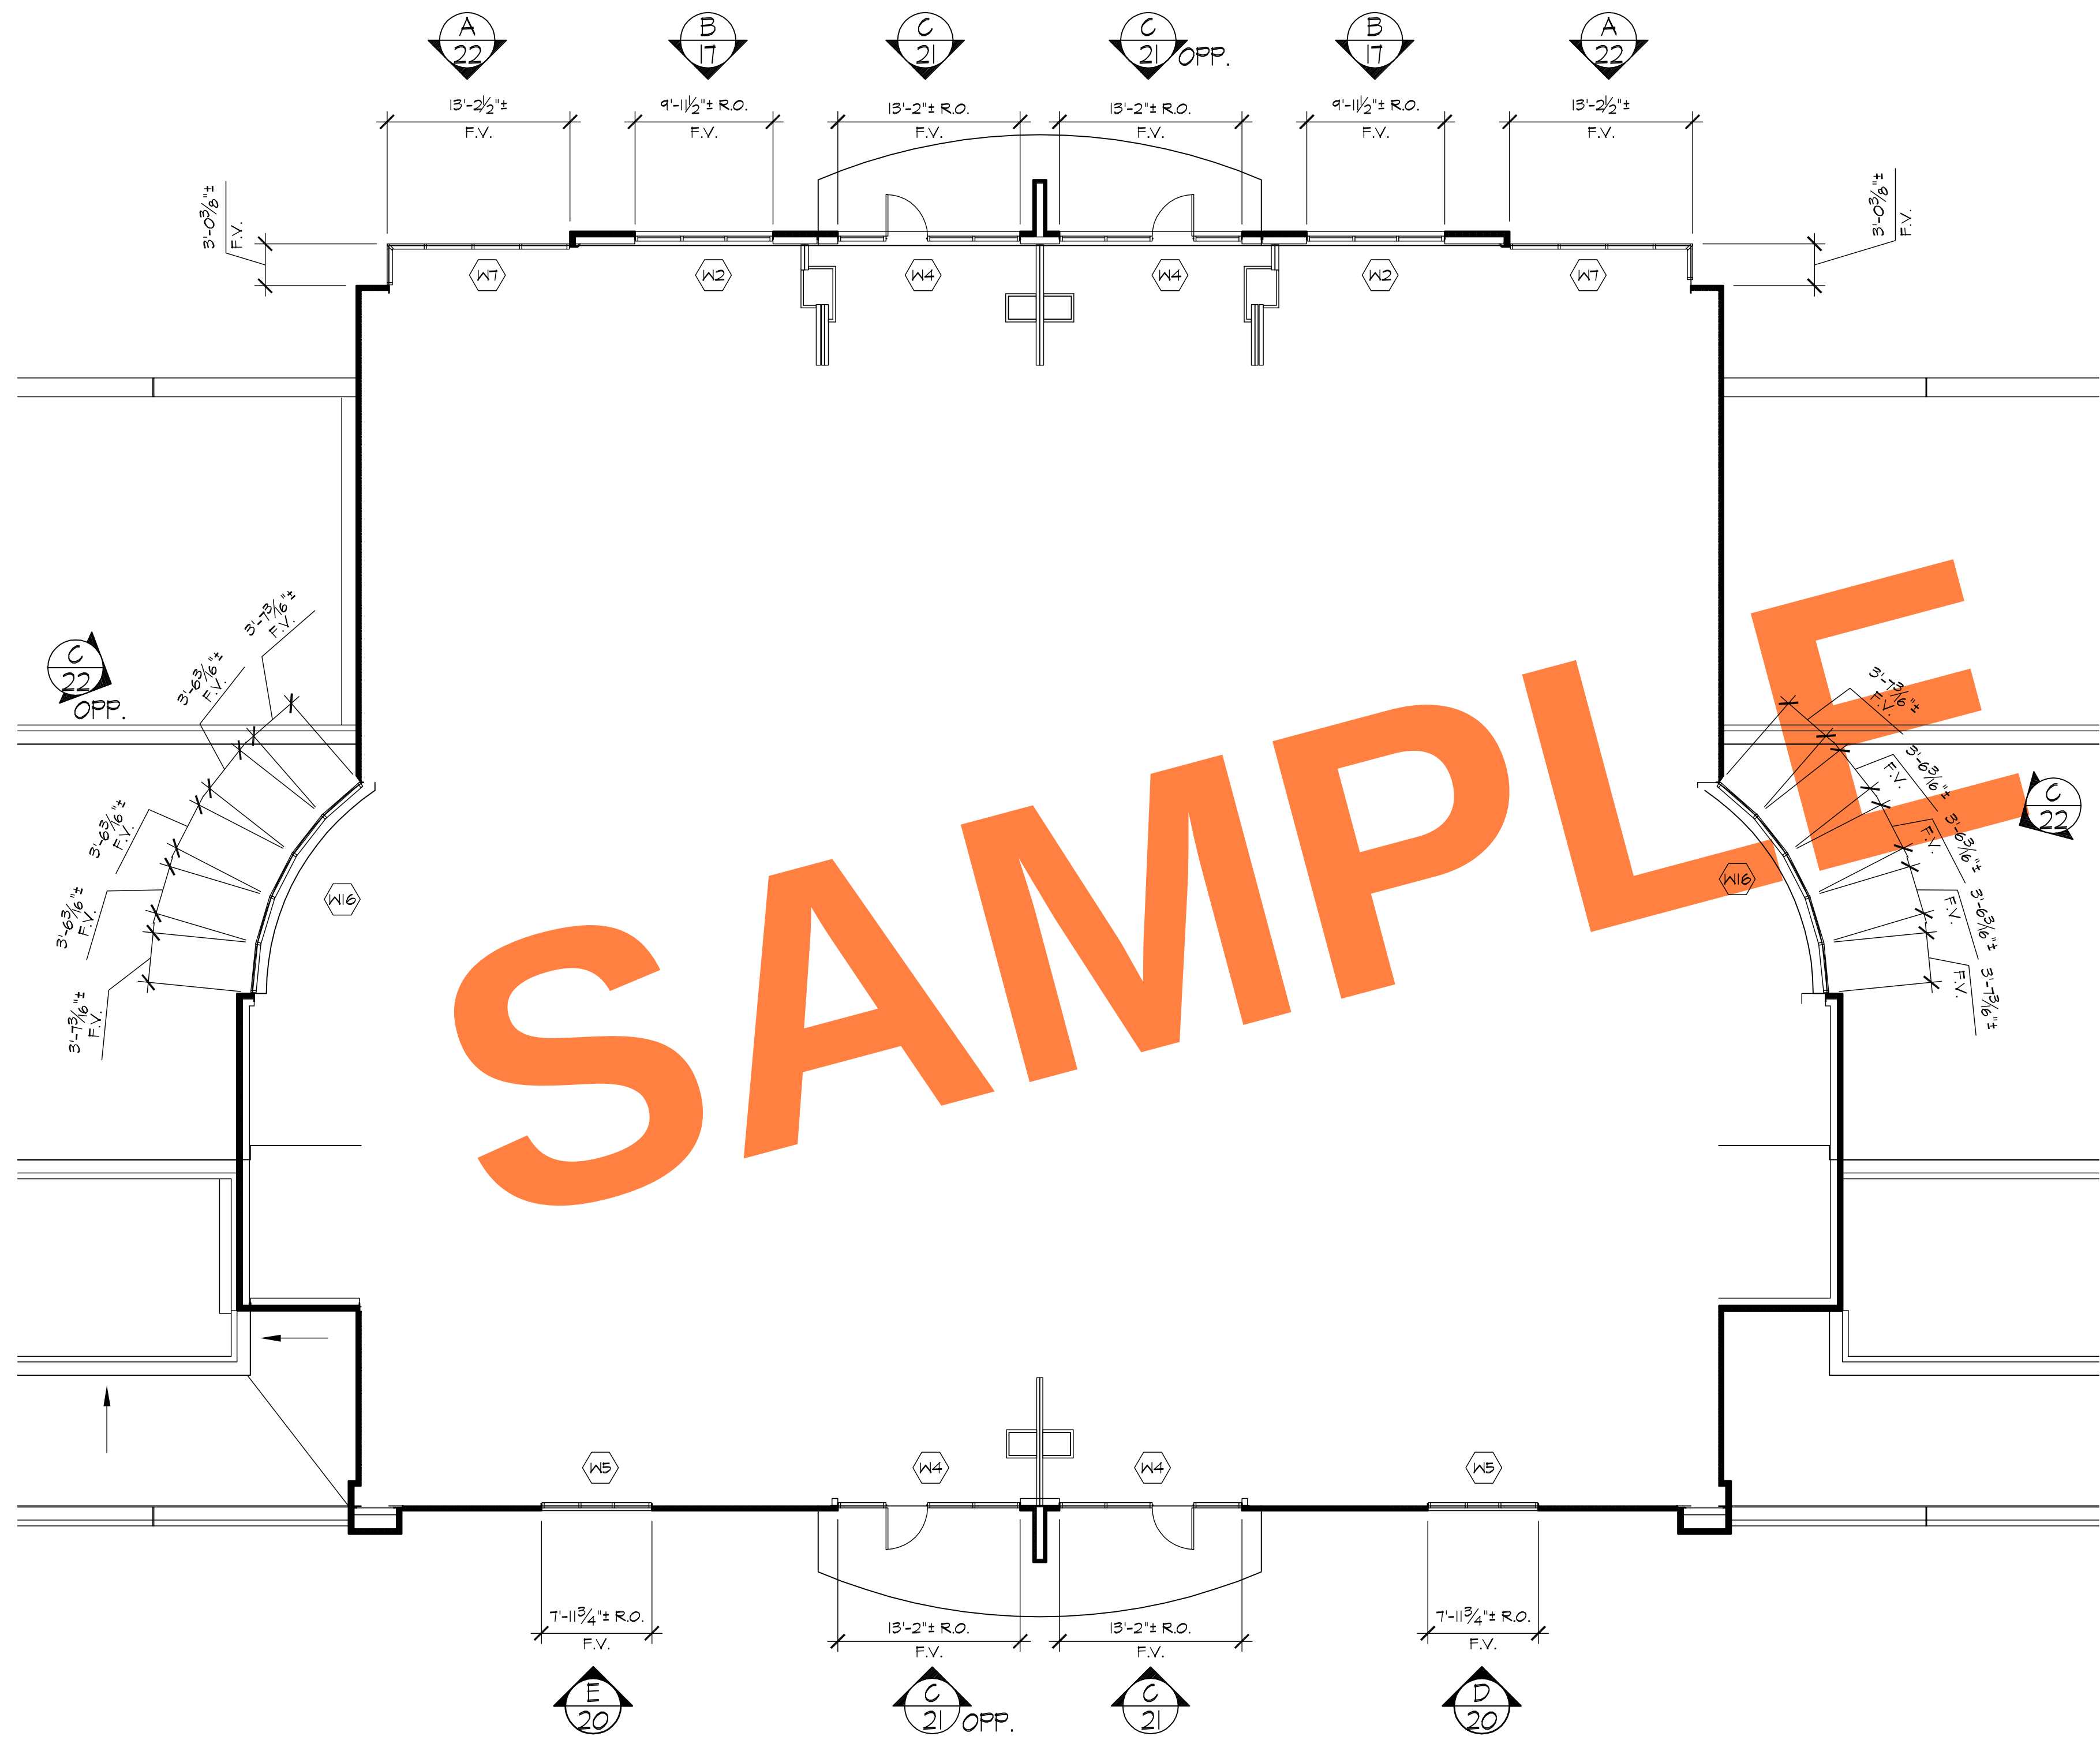

PARTIAL 13TH & 14TH FLOOR PLAN

REF. ARCH'L - A113B & A114B

AREA - B

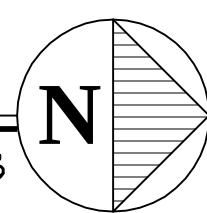

REVISIONS	BY
△	
△	
BMR
DRAFTING SERVICE
SINCE 1988
23846 SUNNYMEAD BLVD.
SUITE #9
MORENO VALLEY, CA 92553
B: (951) 243-7814
F: (951) 243-7873

GLASS FACTORY
26383 BASE LINE
HIGHLAND, CA 92346

AS-BUILT DRAWINGS

JOB NAME:	AGUA CALIENTE HOTEL ADDITION
ARCHITECT:	VOA
SHEET DESCRIPTION:	FLOOR PLAN


DATE:	1/3/07
SCALE:	1/8"=1'-0"
DRAWN:	CTB
JOB NO:	100-06
SHEET NO:	

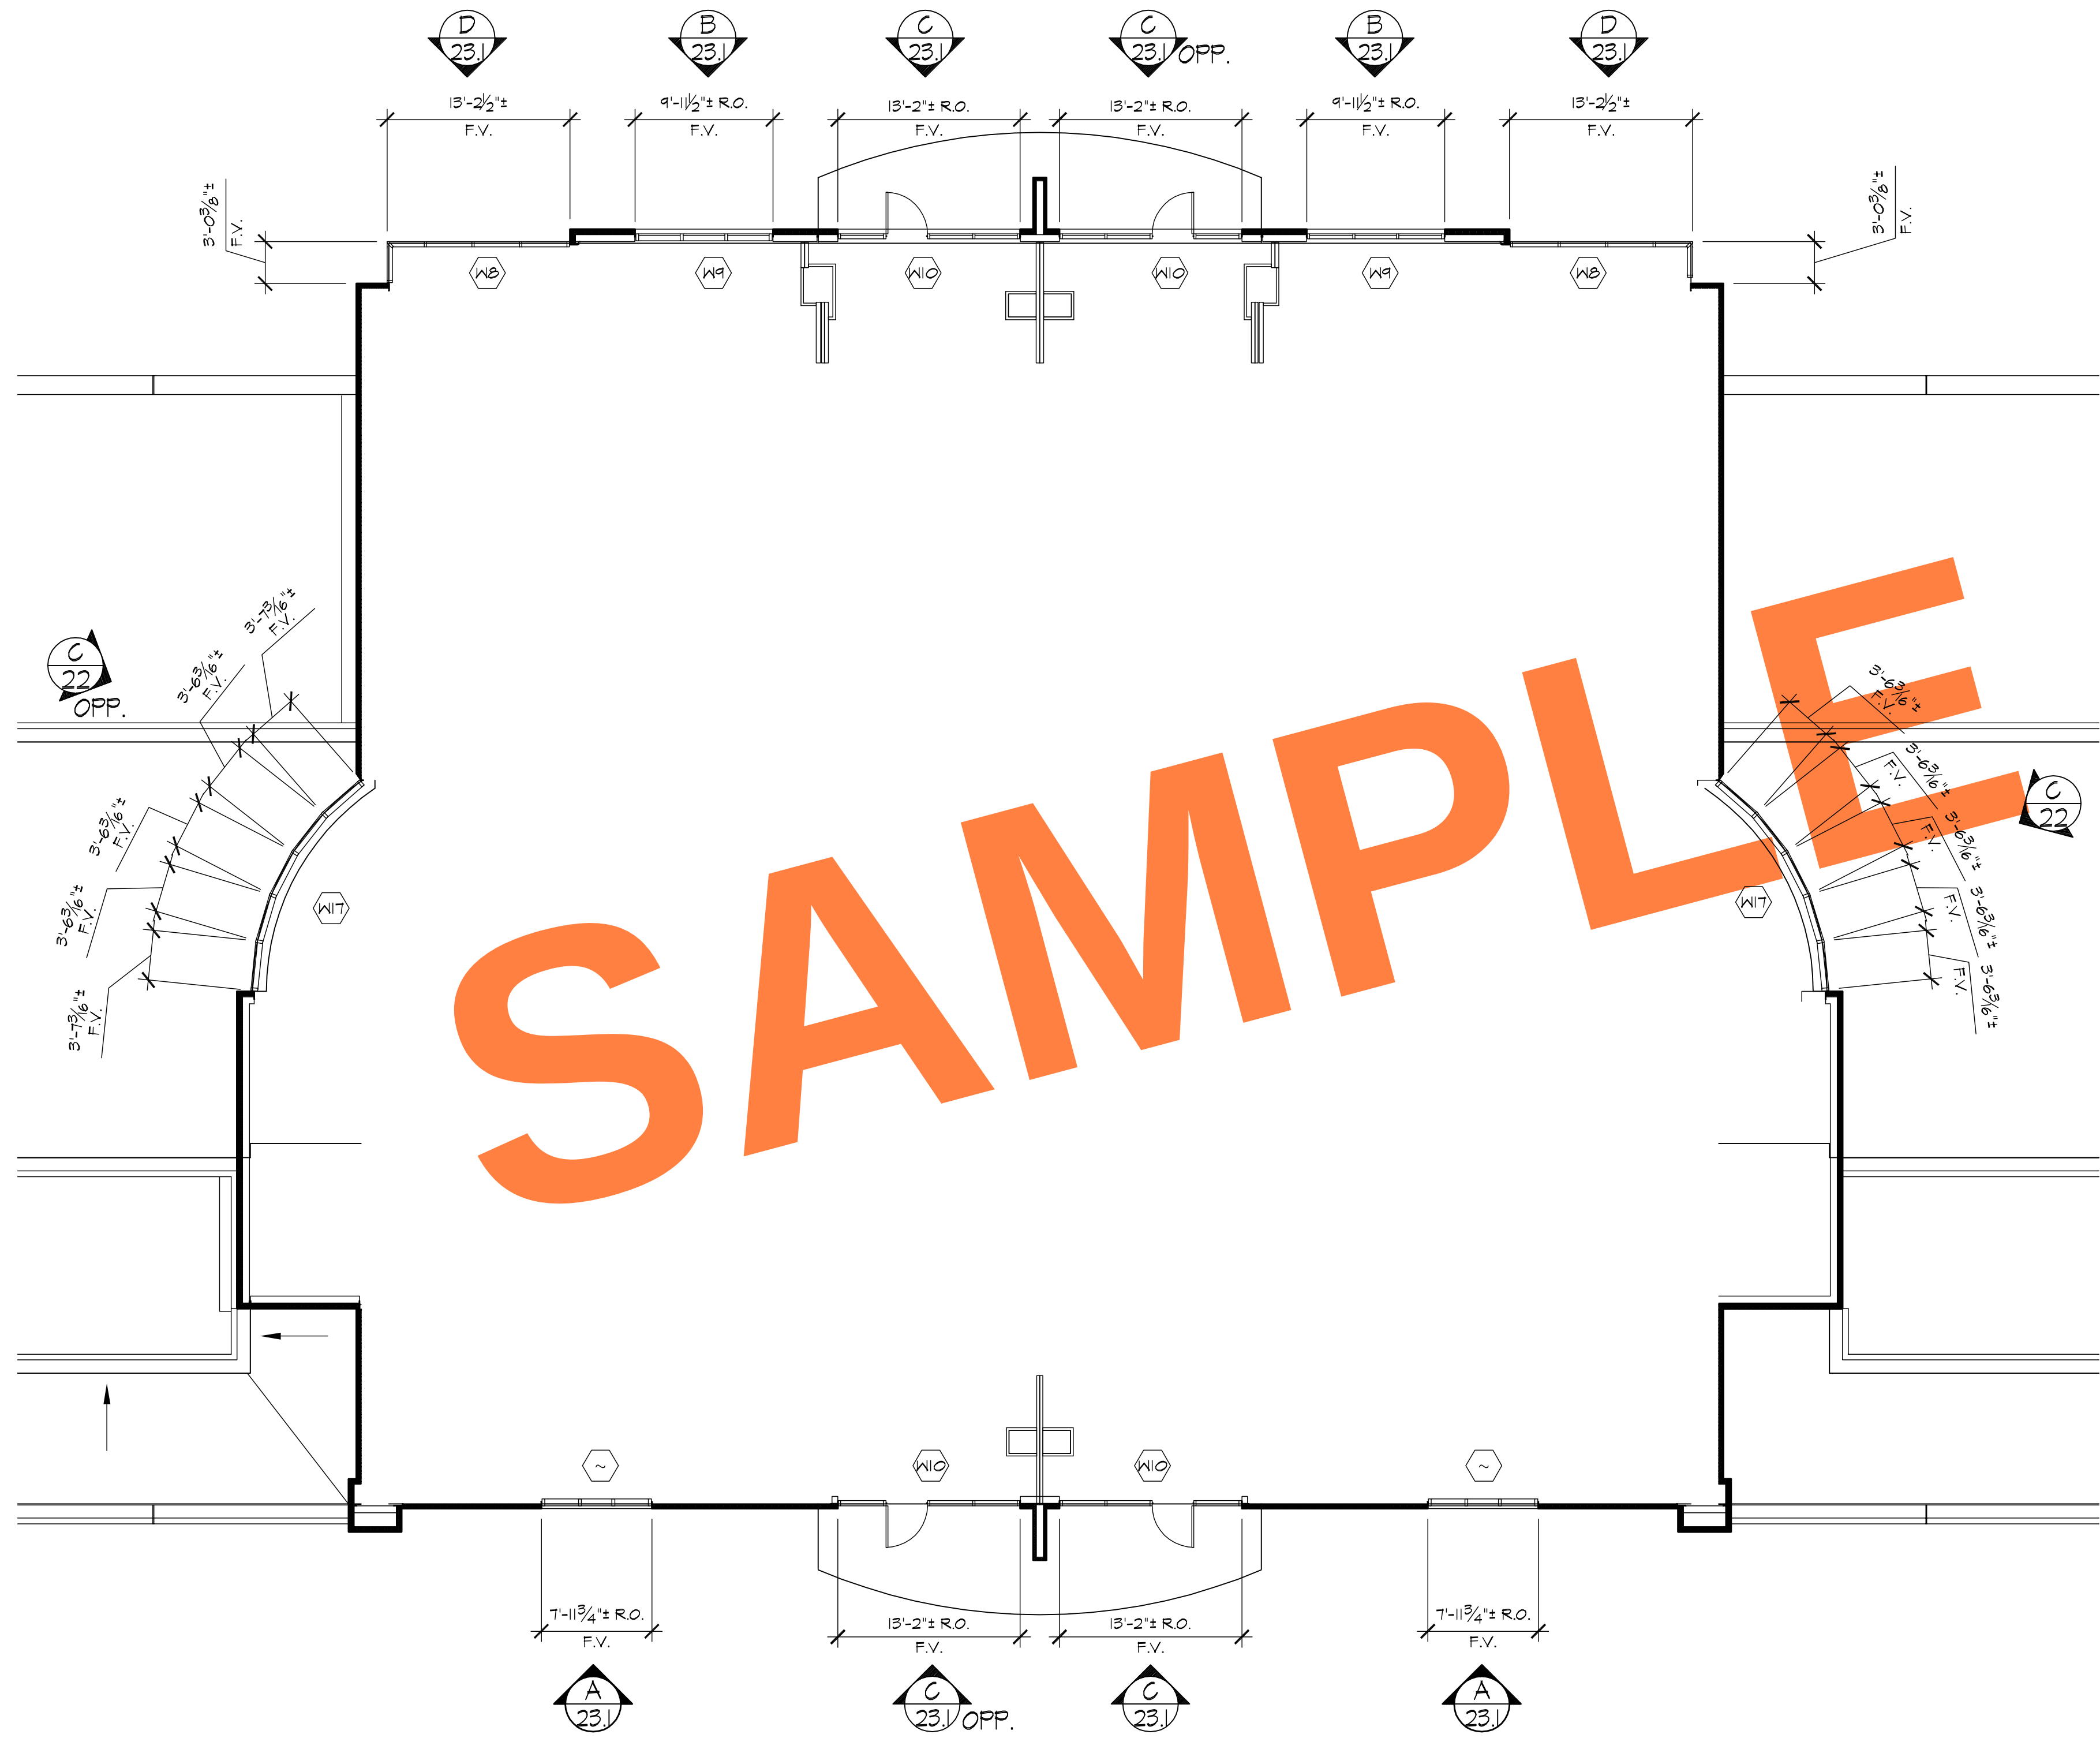

PARTIAL 15TH FLOOR PLAN

REF. ARCH'L - A115B

AREA - B

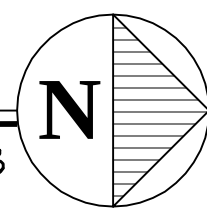

REVISIONS	BY
△	
△	
BMR
DRAFTING SERVICE
SINCE 1988
23846 SUNNYMEAD BLVD.
SUITE #9
MORENO VALLEY, CA 92553
B: (951) 243-7814
F: (951) 243-7873


GLASS FACTORY
26383 BASE LINE
HIGHLAND, CA 92346

AS-BUILT DRAWINGS


JOB NAME:	AGUA CALIENTE HOTEL ADDITION
ARCHITECT:	VOA
SHEET DESCRIPTION:	FLOOR PLAN

DATE:	6-11-07
SCALE:	1/8"=1'-0"
DRAWN:	BMR
JOB NO:	100-06
SHEET NO:	

12.1

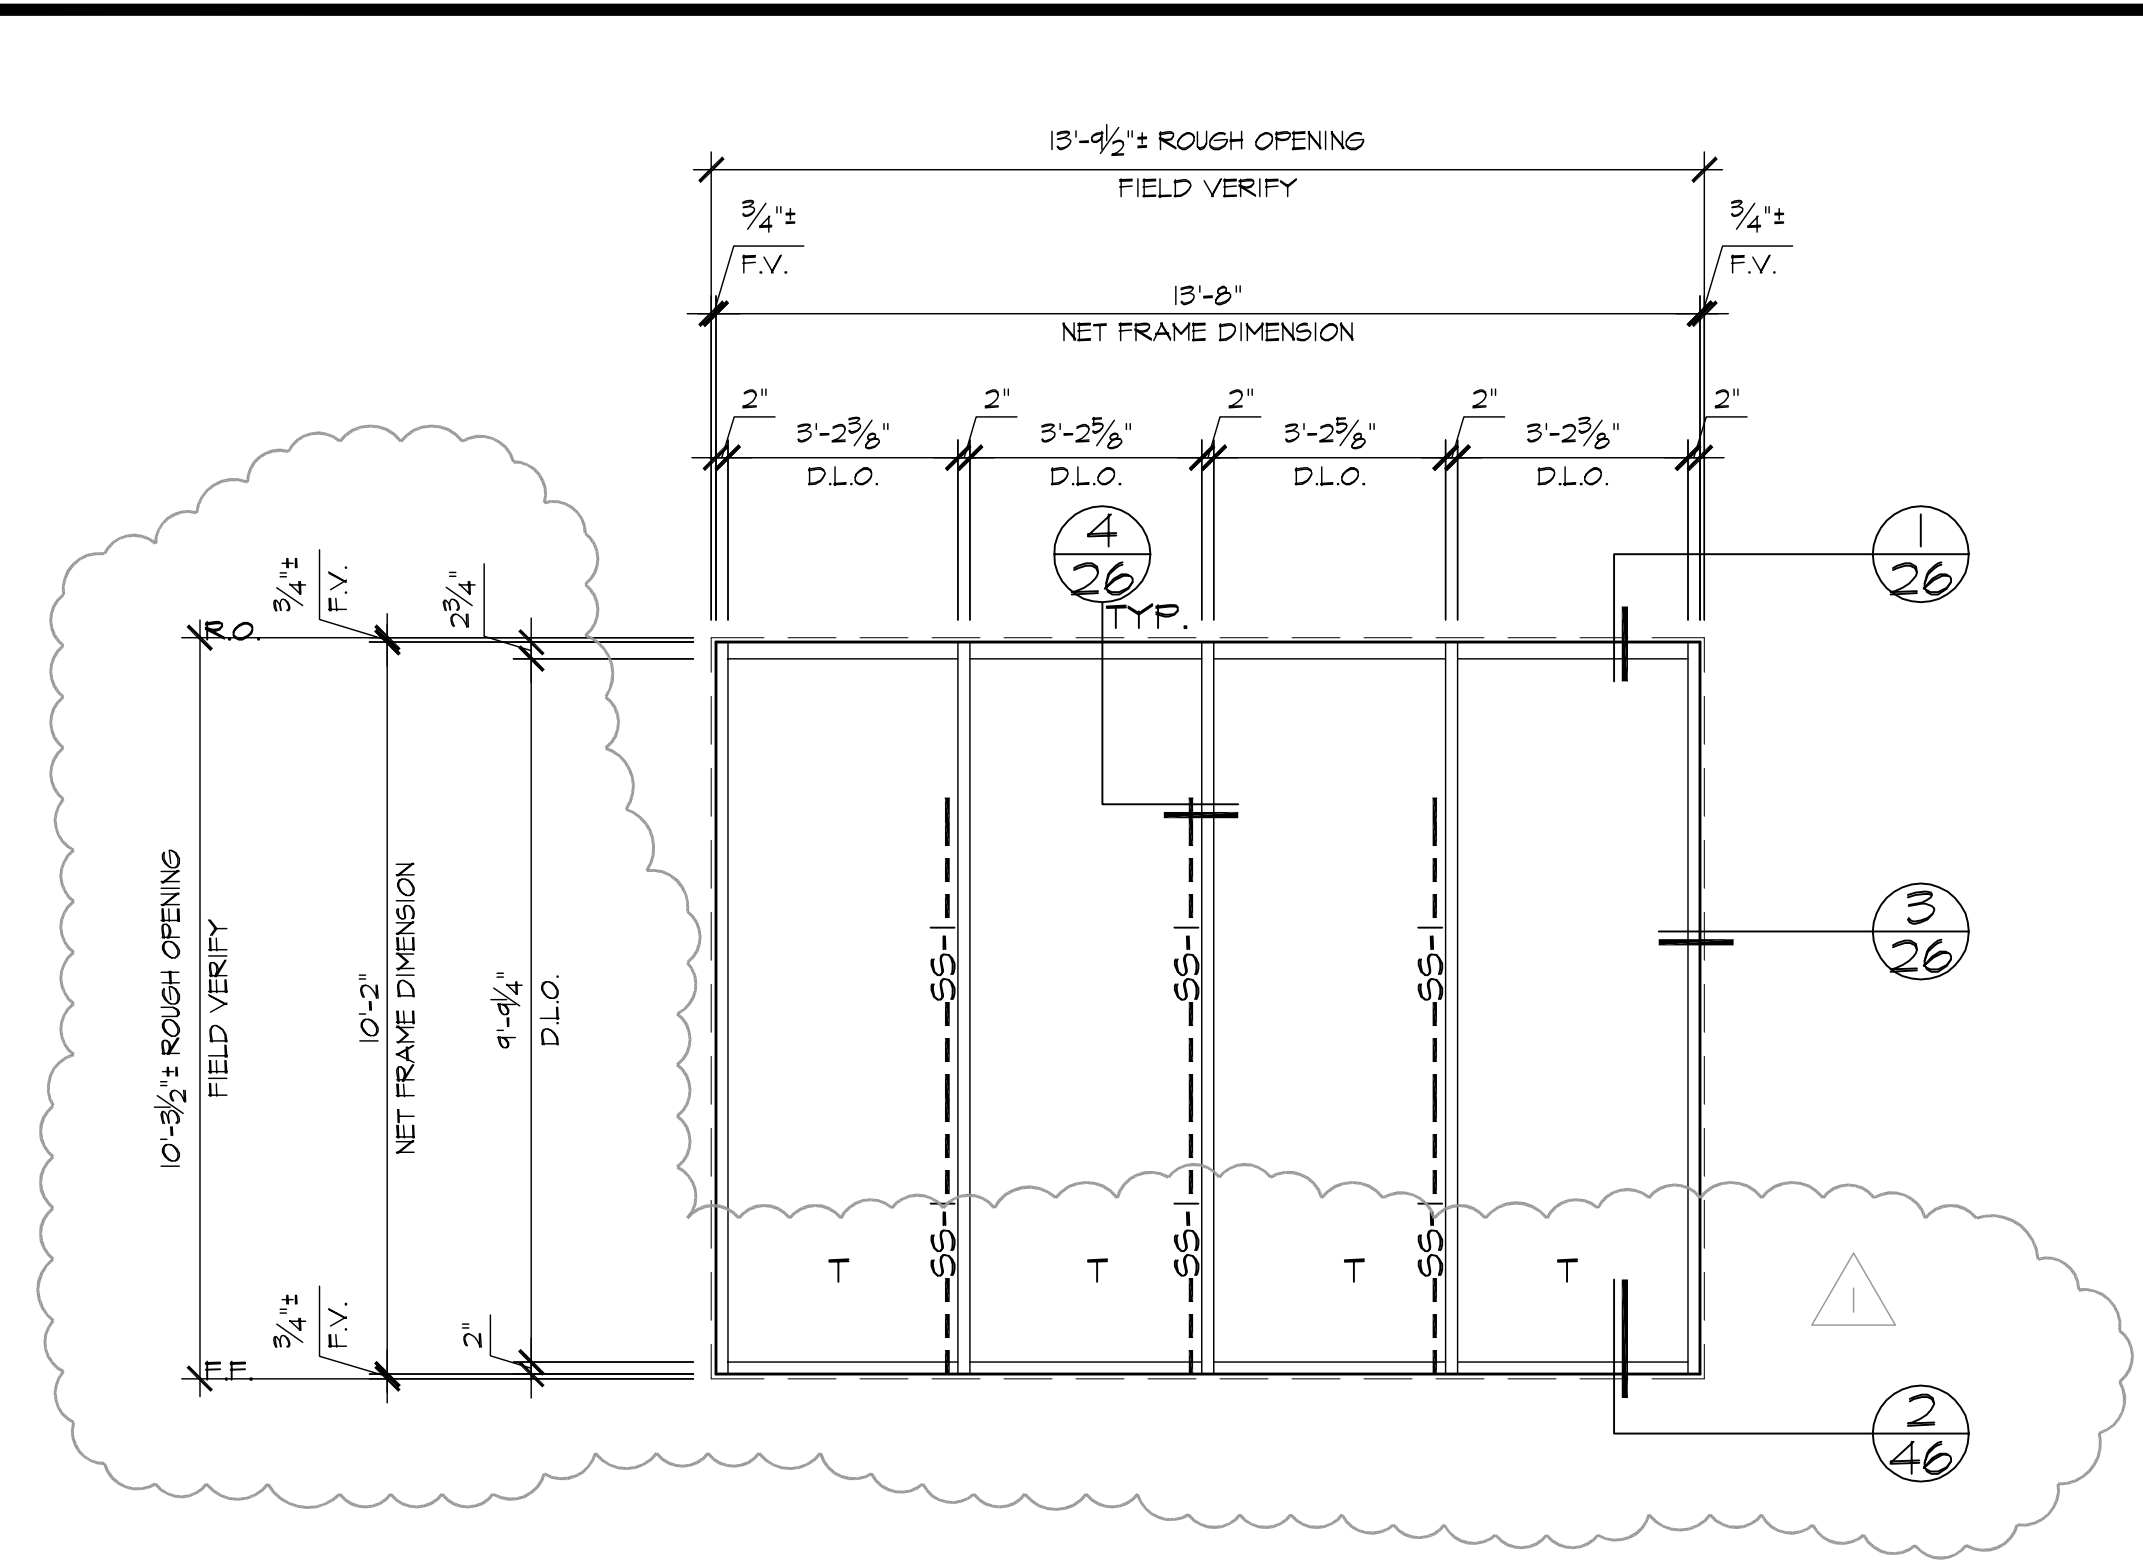


A ELEVATION (2" X 4 1/2" OFFSET GLAZED SYSTEM) (N18)
14 LOCATION
 AREA A 1st. FLR. ~ 1 REQ'D (WEST)

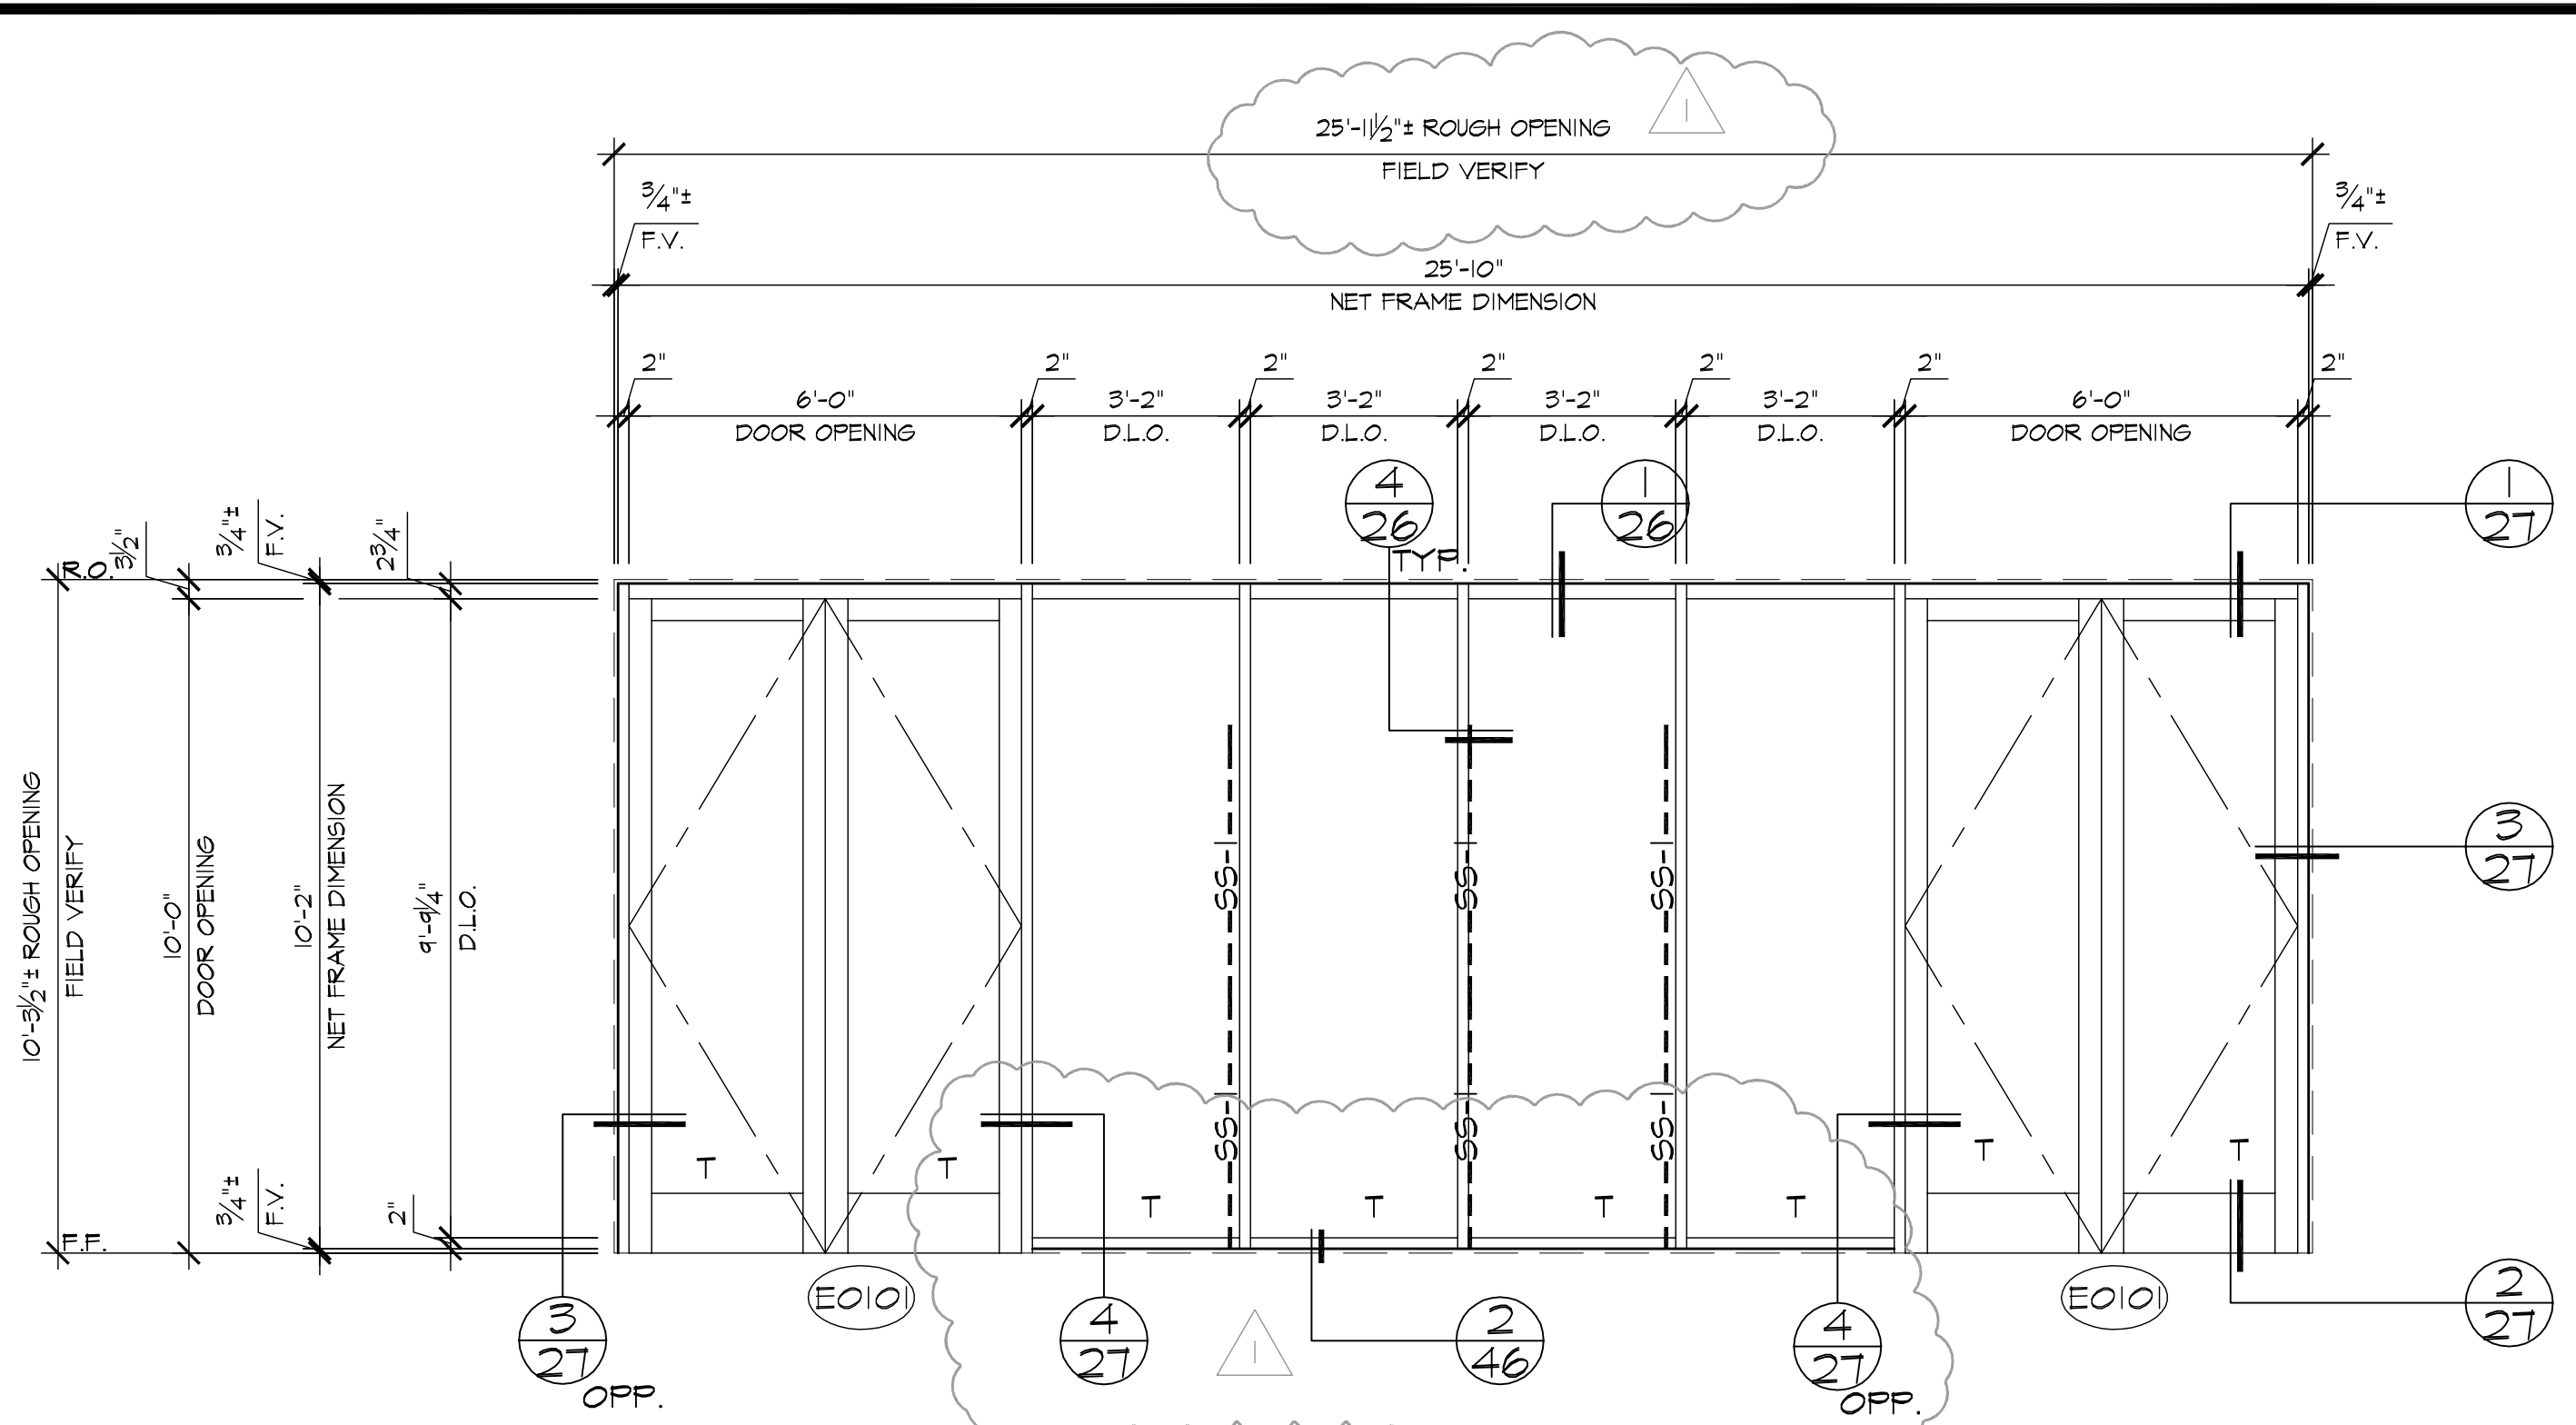


B ELEVATION (2" X 4 1/2" OFFSET GLAZED SYSTEM) (N11)
14 LOCATION
 AREA A 1st. FLR. ~ 2 REQ'D (WEST)

STEEL LEGEND:
 SS-1 ~ 1 1/2" X 3 1/4" X 10GA. X 9'-0" STEEL CHANNEL

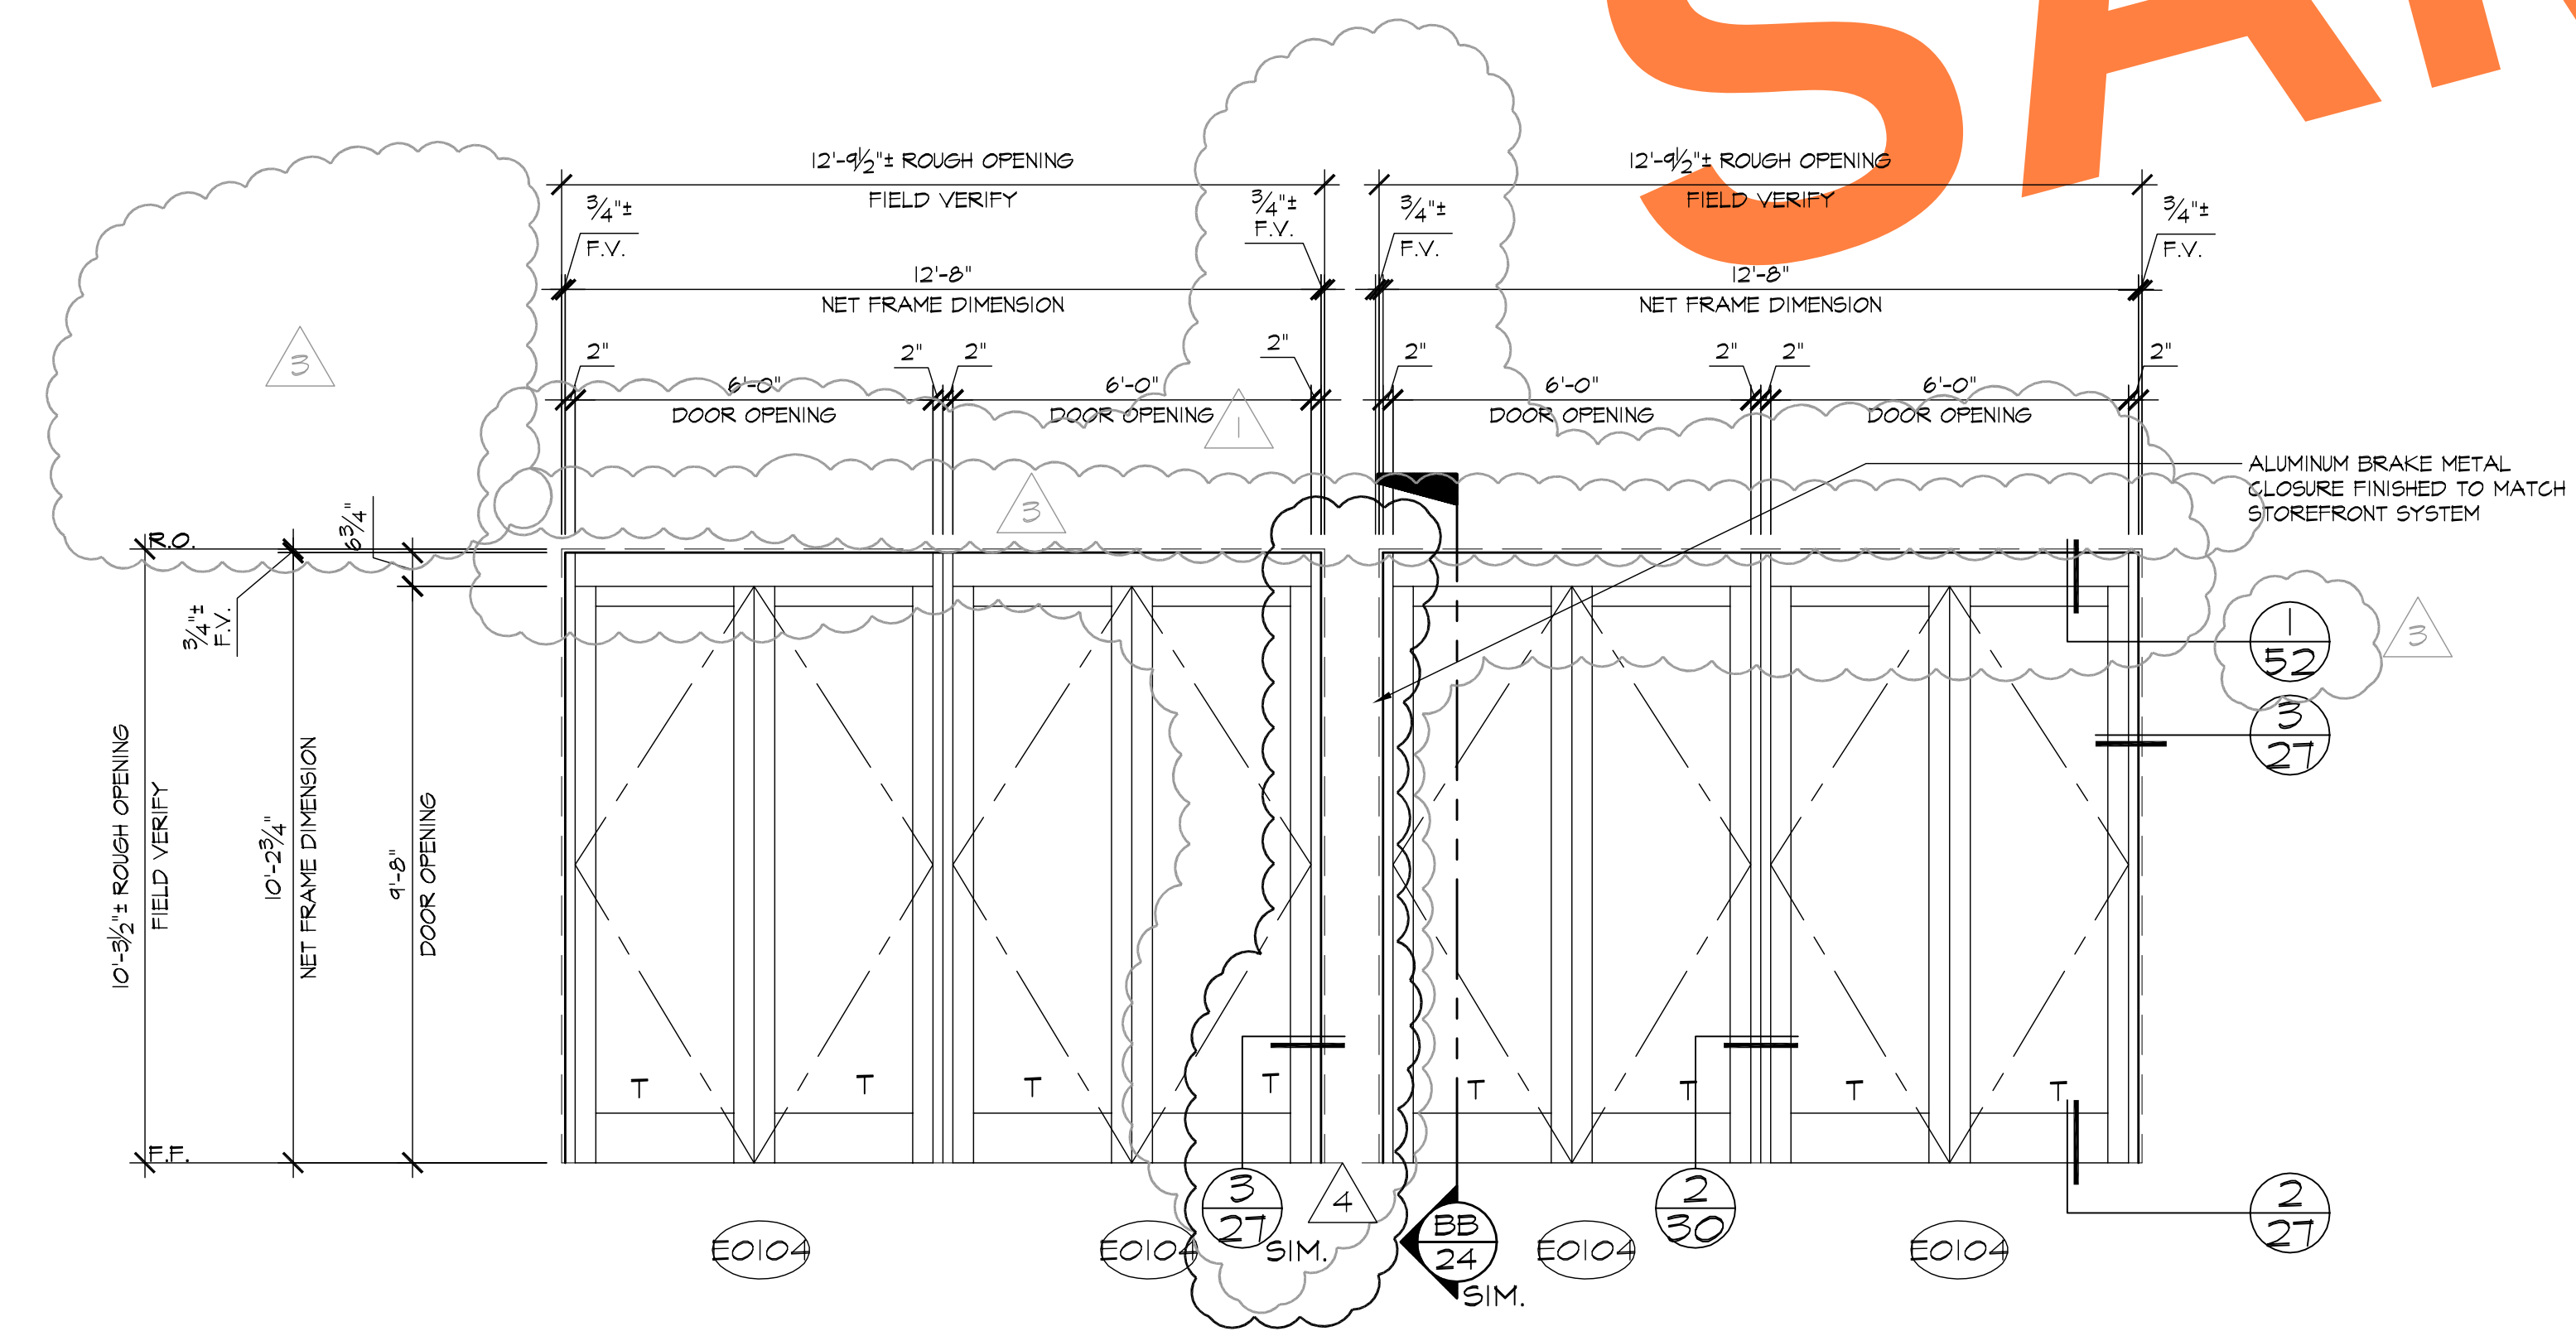


C ELEVATION (2" X 4 1/2" OFFSET GLAZED SYSTEM) (N18)
14 LOCATION
 AREA B, ENTRY 0101 1st. FLR. ~ 1 REQ'D (WEST)

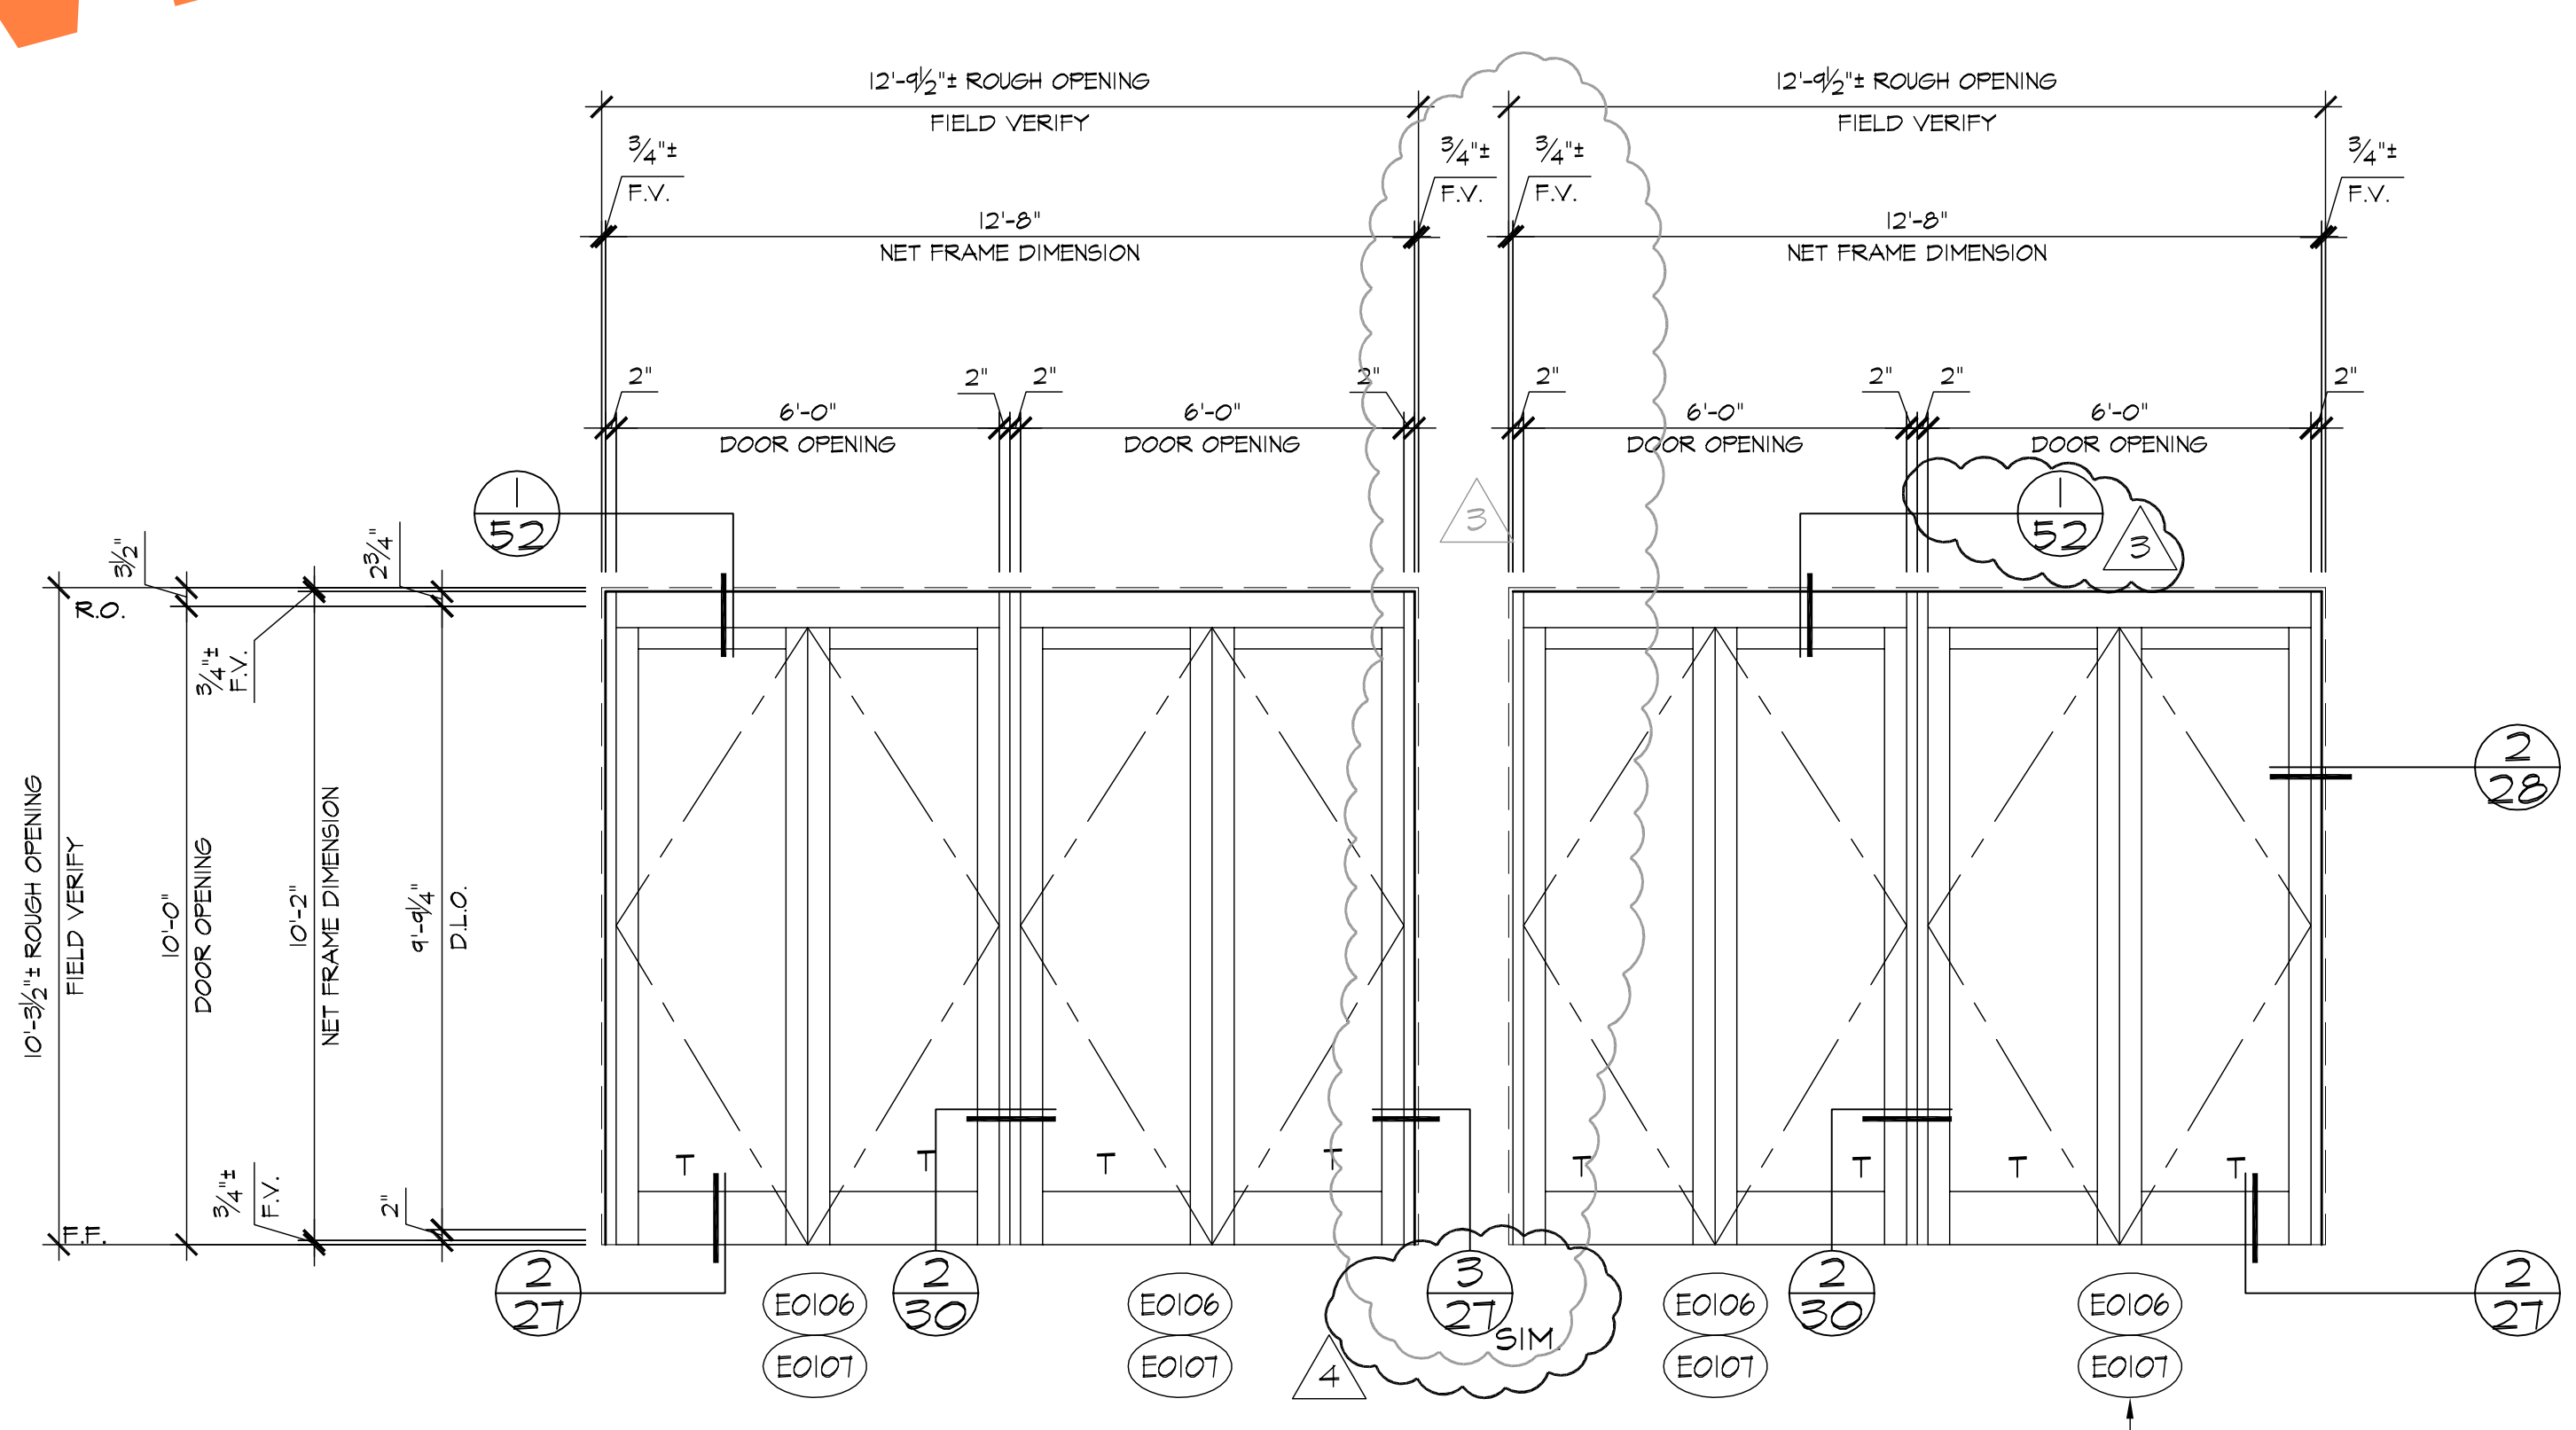

D ELEVATION (2" X 4 1/2" OFFSET GLAZED SYSTEM)
14 LOCATION
 AREA C 1st. FLR. ~ 2 REQ'D (SOUTH)

THESE TWO DOORS TO HAVE A POWER ASSISTED CLOSER

REVISIONS		BY
△	4-23-07	BMR
△	6-11-07	BMR
△	12-17-07	CTB
△	3/6/08	CTB
△		

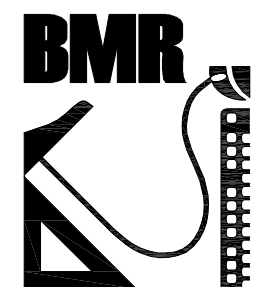

BMR
 DRAFTING SERVICE
 SINCE 1988
 23846 SUNNYMEAD BLVD.
 SUITE #9
 MORENO VALLEY, CA 92553
 B: (951) 243-7814
 F: (951) 243-7873

GLASS FACTORY
 26383 BASE LINE
 HIGHLAND, CA 92346


AS-BUILT DRAWINGS

JOB NAME:	AGUA CALIENTE HOTEL ADDITION
ARCHITECT:	VOA
SHEET DESCRIPTION:	ELEVATIONS
DATE:	1/3/07
SCALE:	3/8"=1'-0"
DRAWN:	CTB
JOB NO:	100-06
SHEET NO:	14

GLASS FACTORY
26383 BASE LINE
HIGHLAND, CA 92346


CONCLUSIONS


JOB NAME:	AQUA CALIENTE HOTEL ADDITION
ARCHITECT:	VOA
SHEET DESCRIPTION:	ELEVATIONS
DATE:	1/3/07
SCALE:	3/8"=1'-0"
DRAWN:	CTB
JOB NO:	100-06
SHEET NO:	15

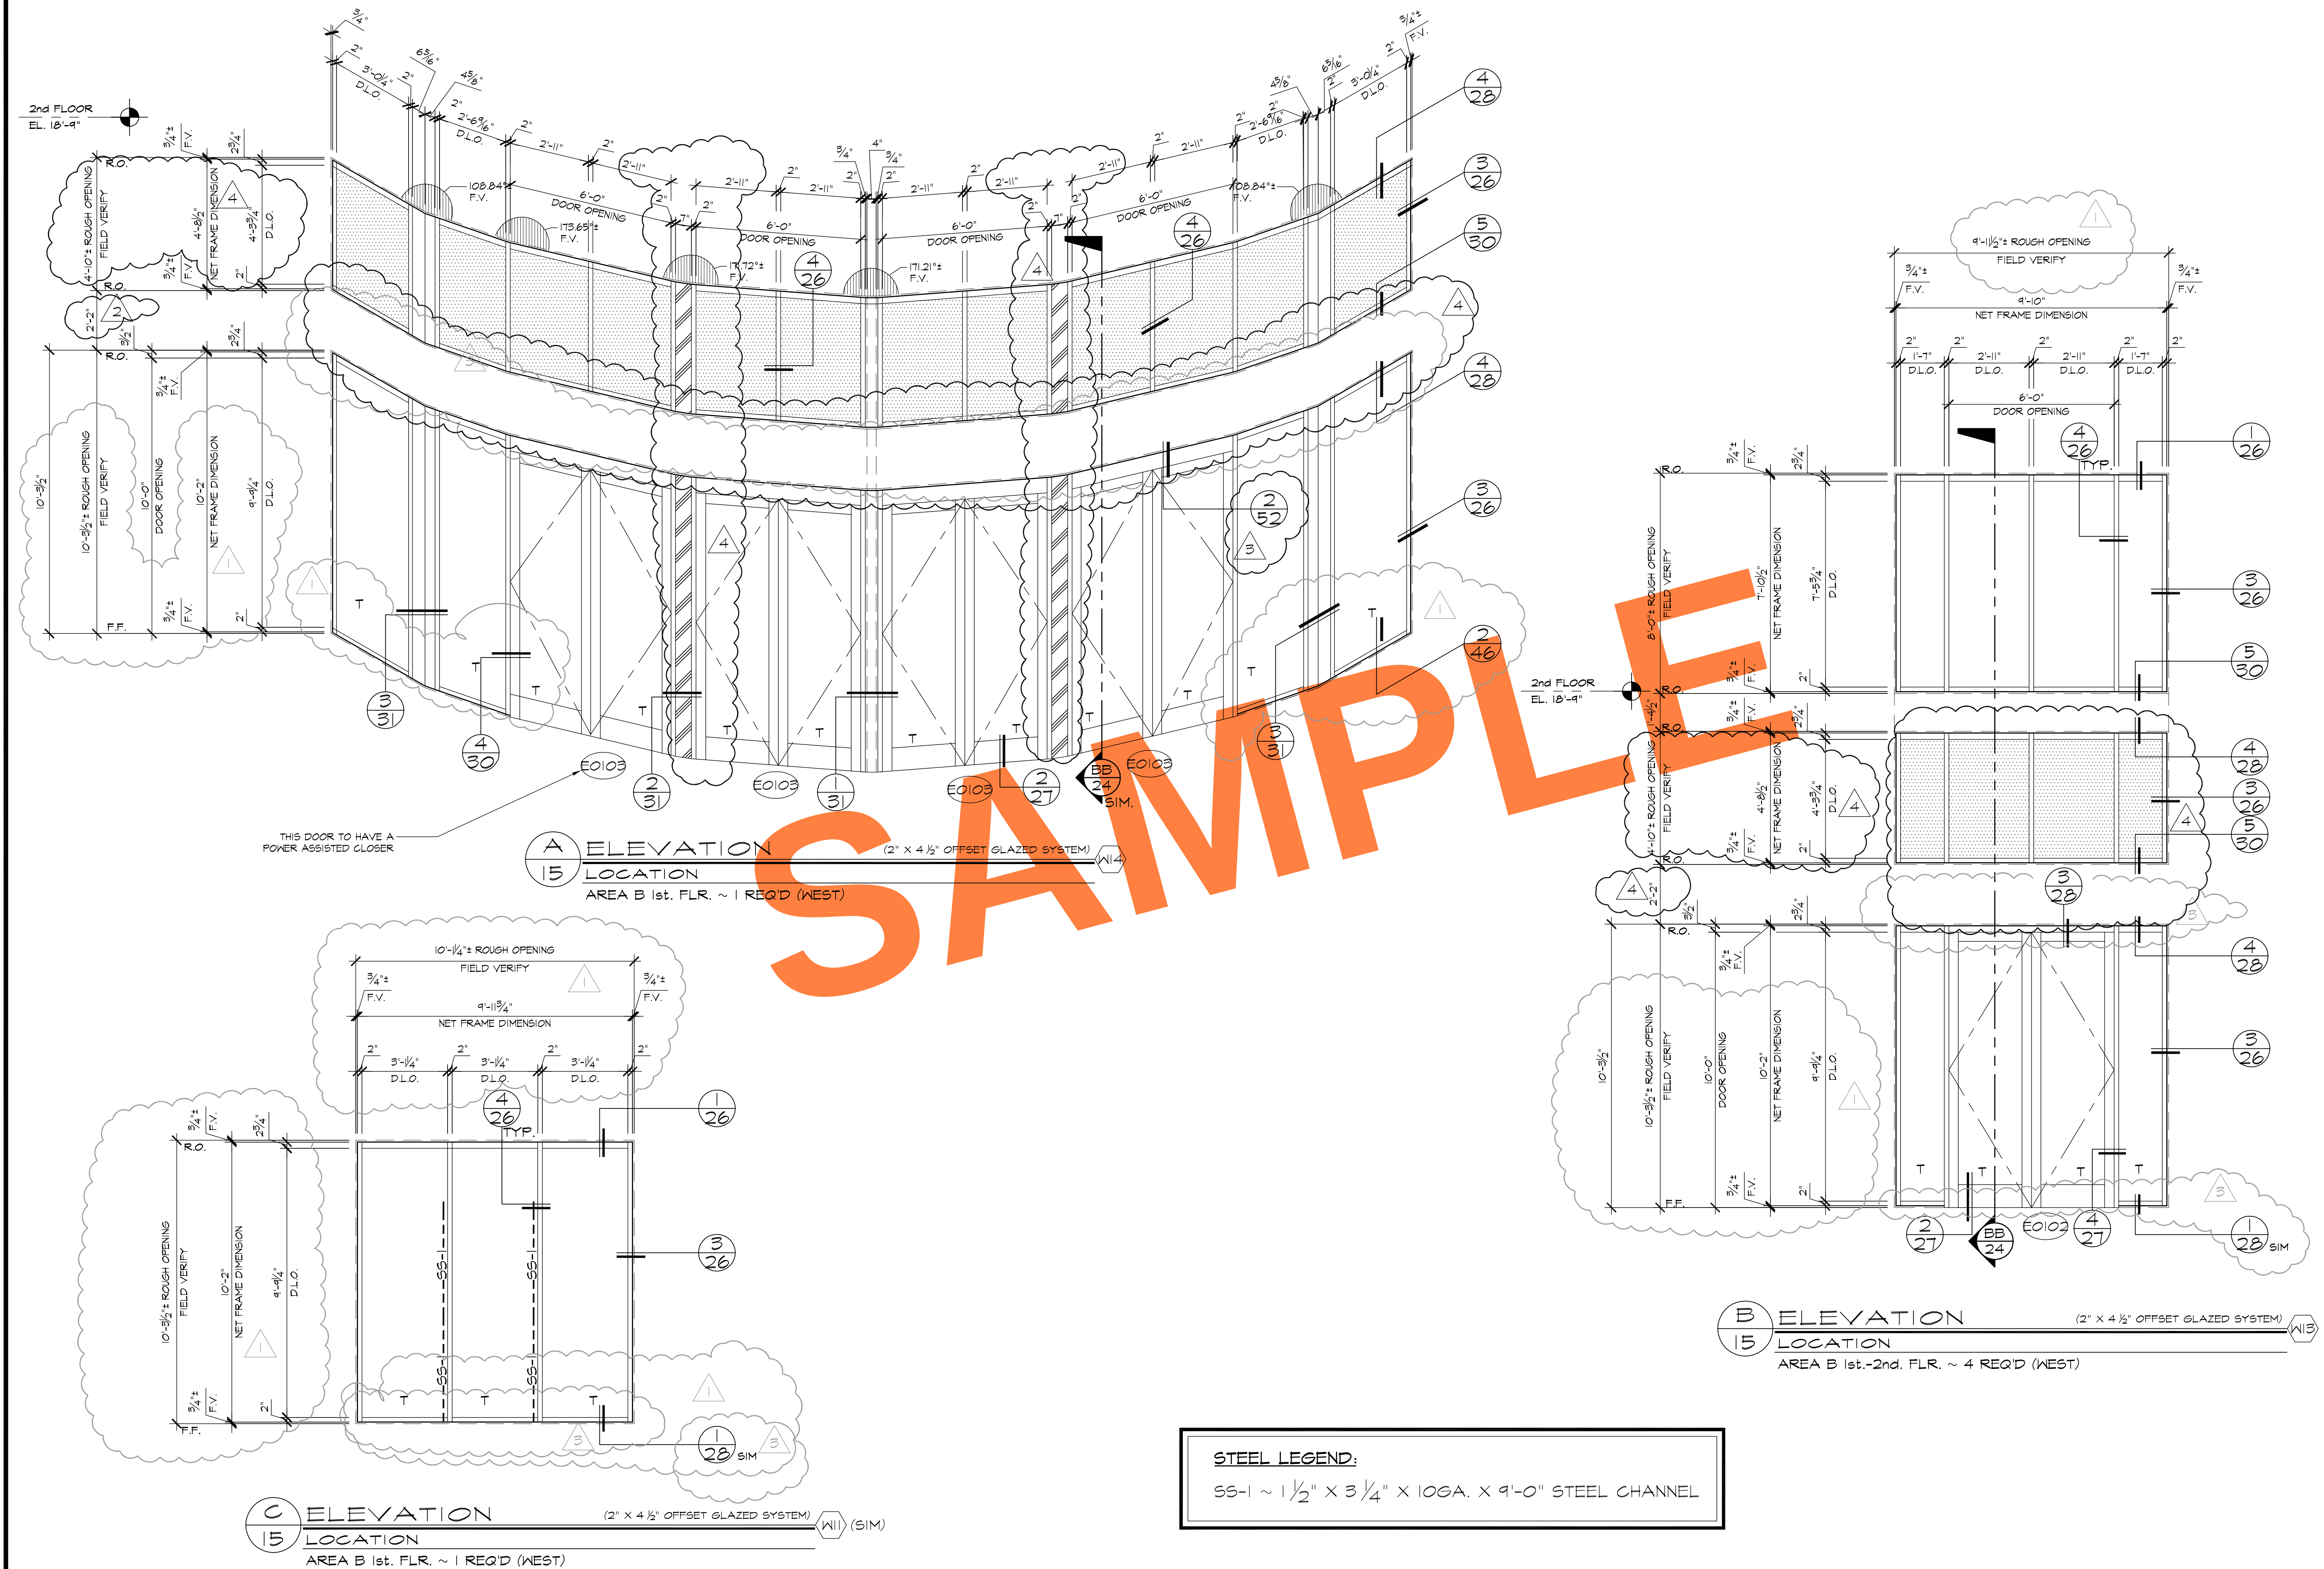

STEEL LEGEND:

SS-1 ~ 1 1/2" X 3 1/4" X 10GA. X 9'-0" STEEL CHANNEL

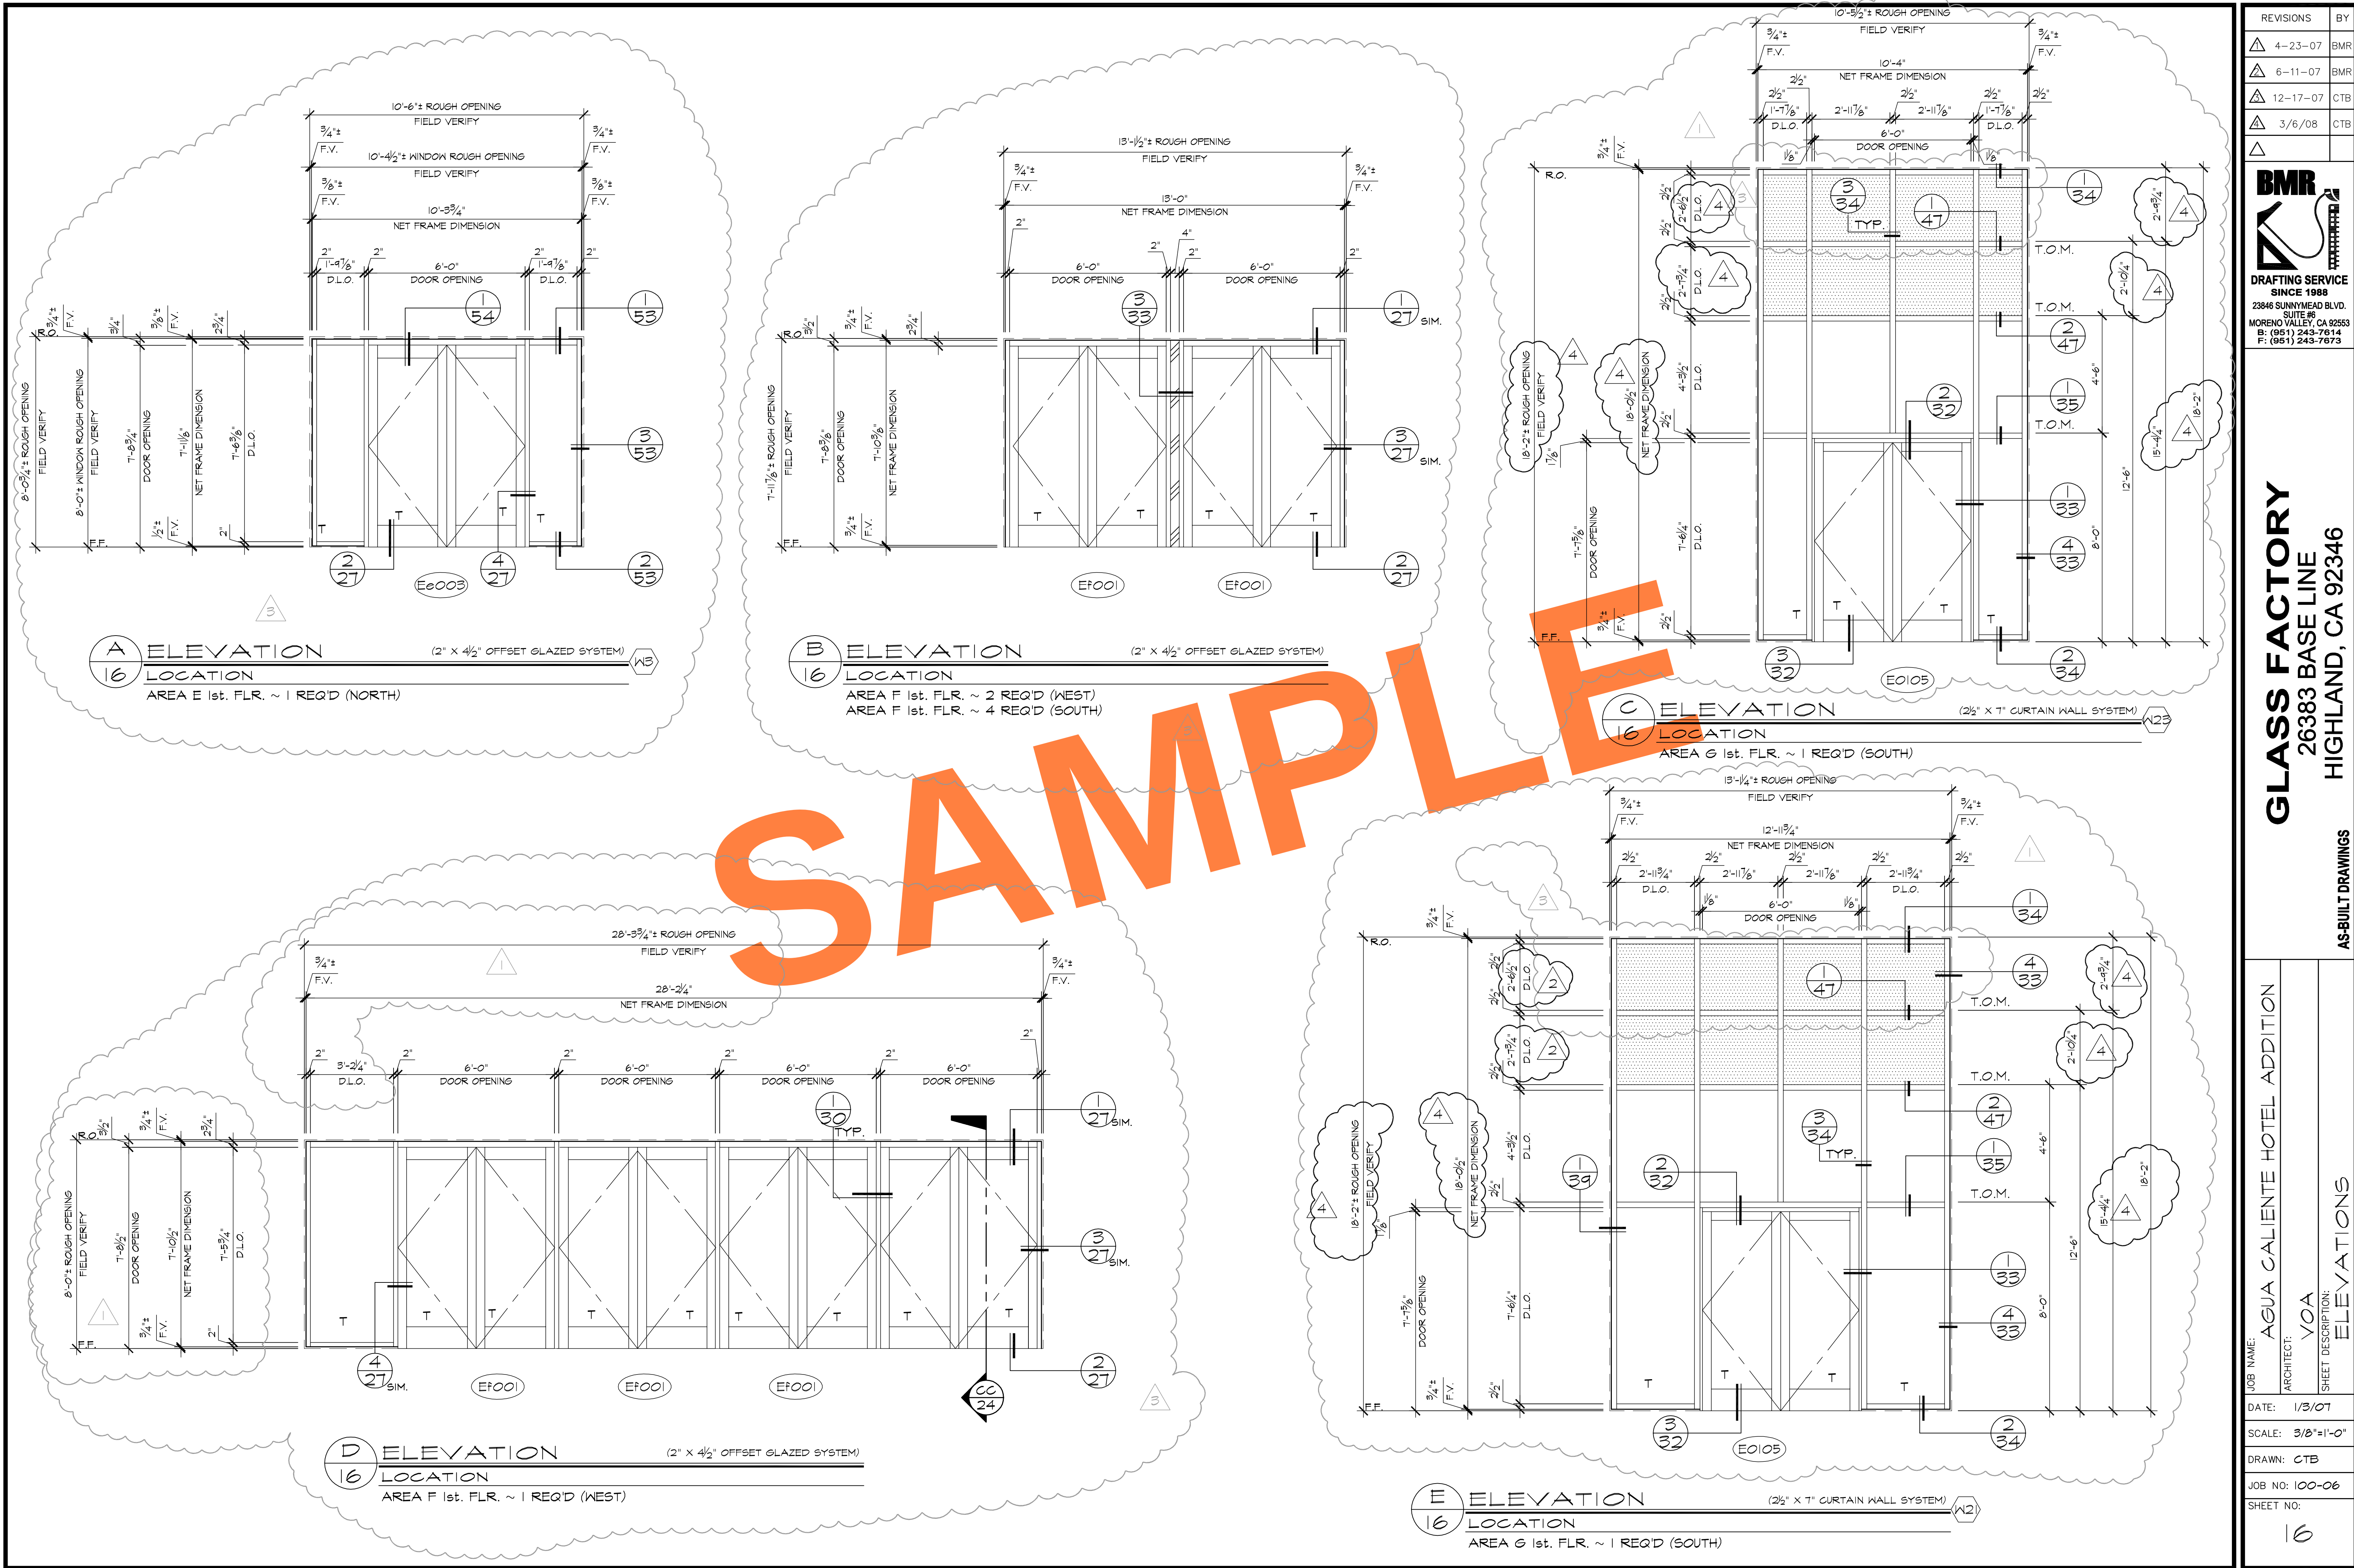

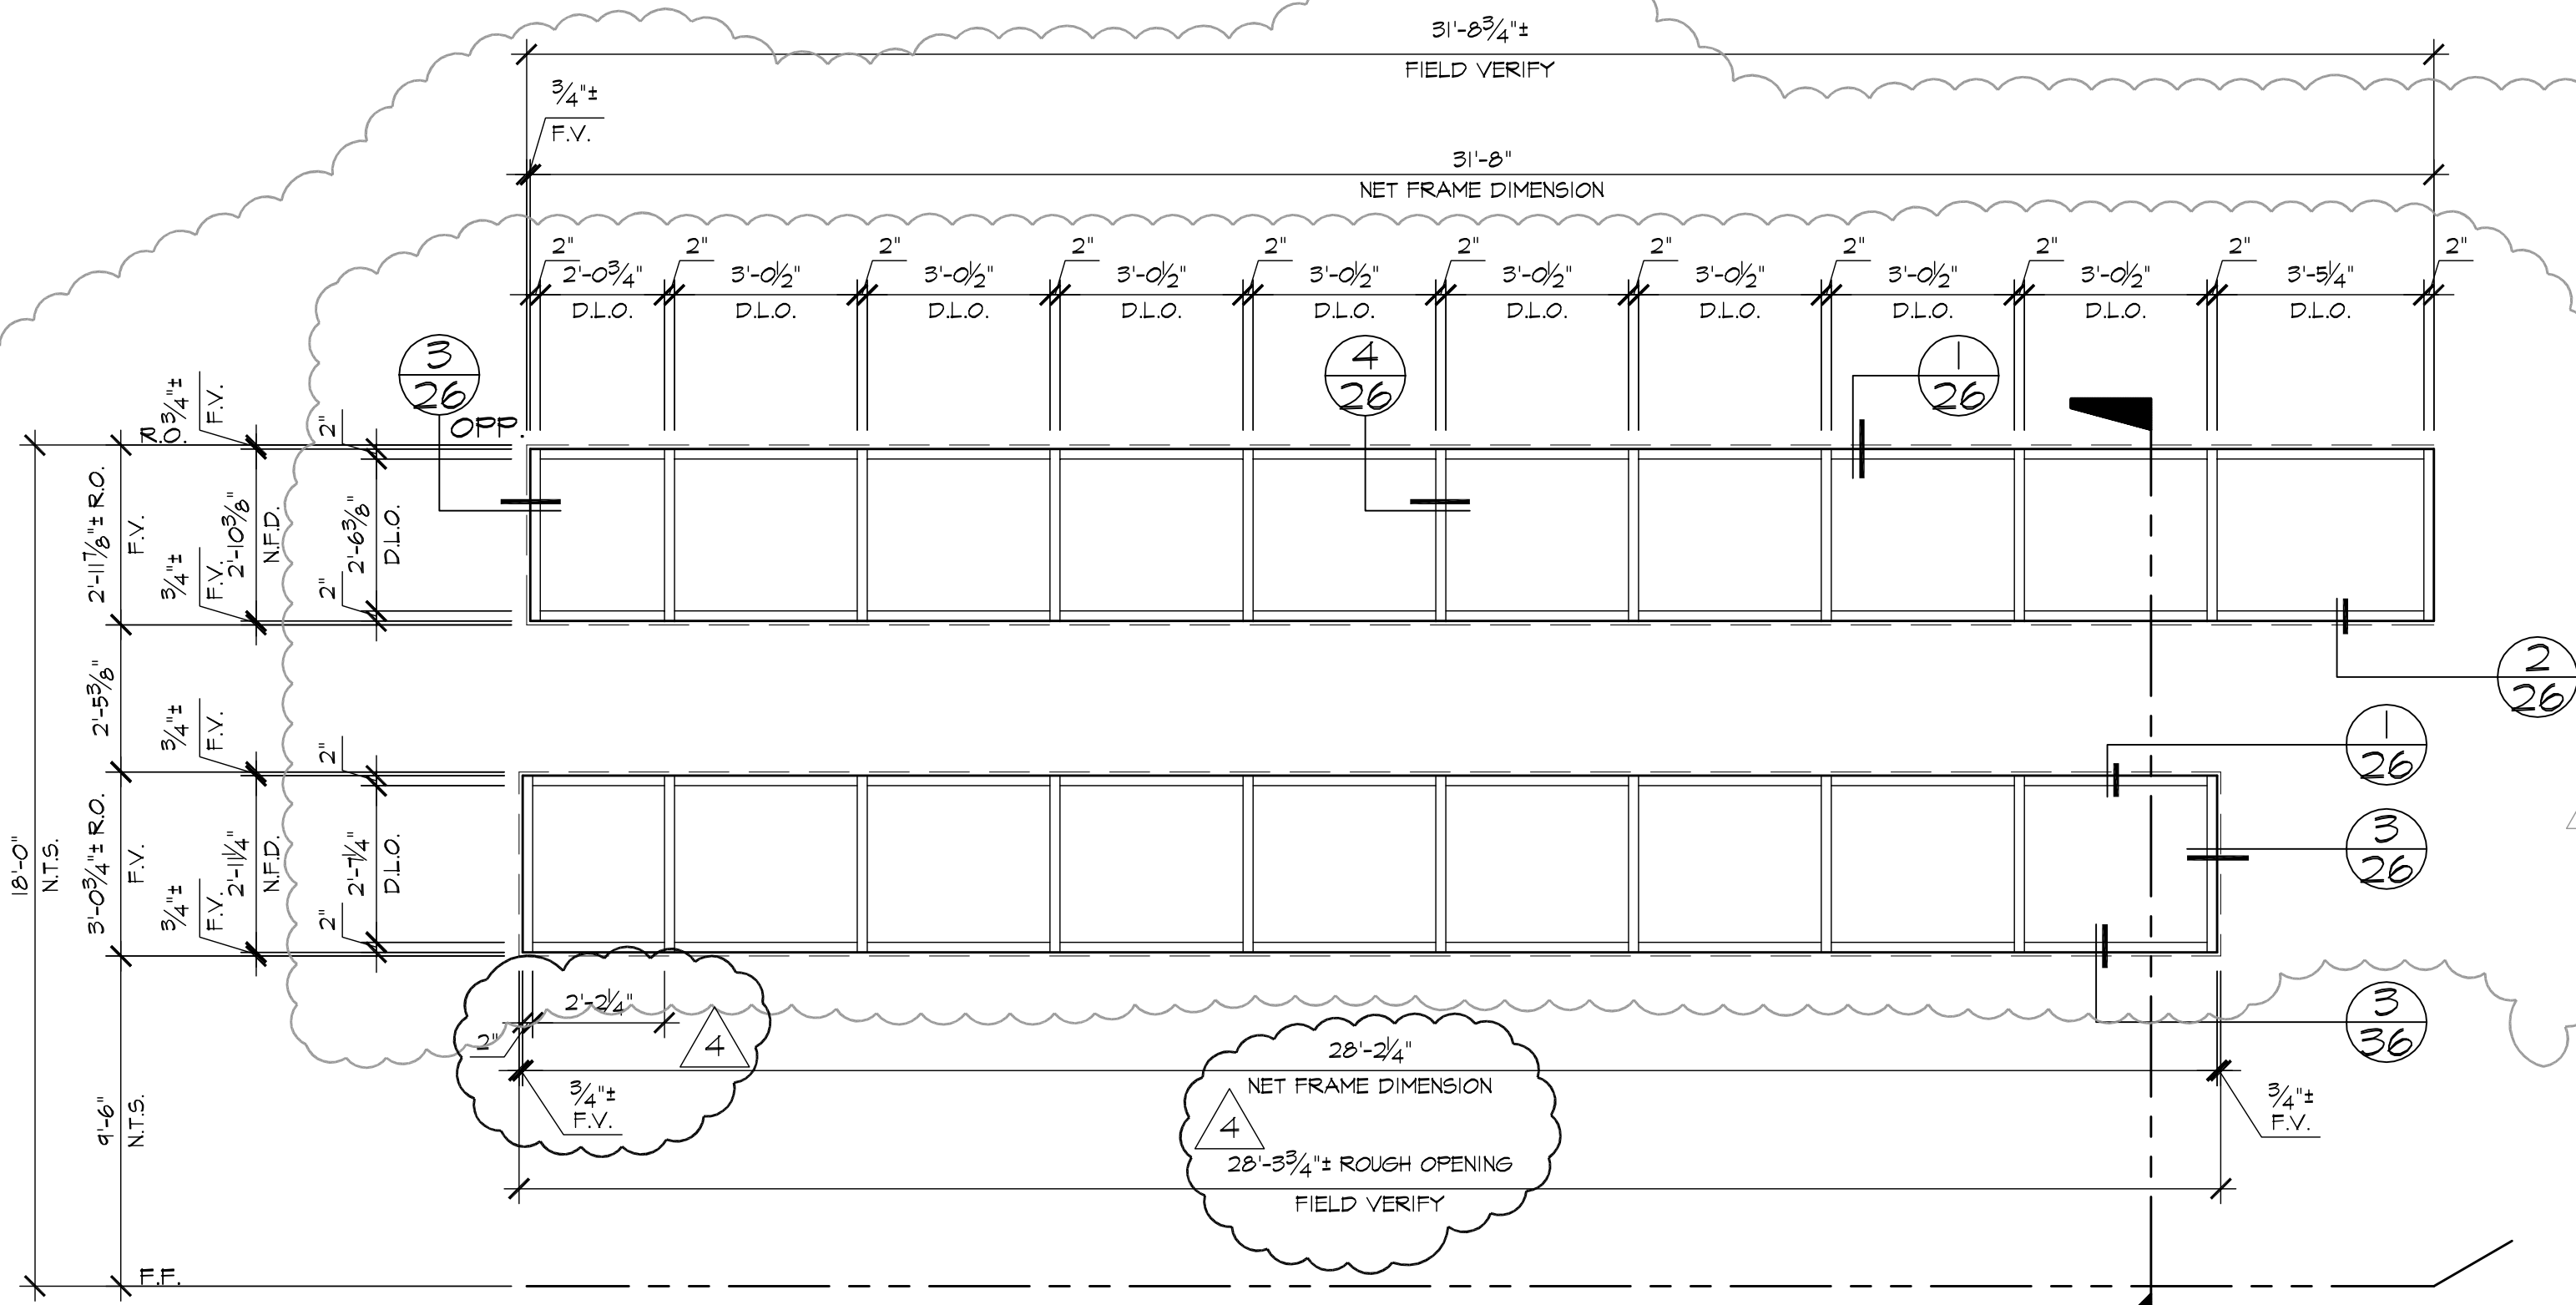


A ELEVATION (2" X 4 1/2" OFFSET GLAZED SYSTEM)
17 LOCATION
AREA F @CLERESTORY ~ 1 REQ'D (WEST)

THIS ELEVATION IS NOT USED

B ELEVATION (2 1/2" X 7" CURTAIN WALL SYSTEM)
17 LOCATION
AREA G @CLERESTORY ~ 1 REQ'D (SOUTH)


THIS ELEVATION IS NOT USED

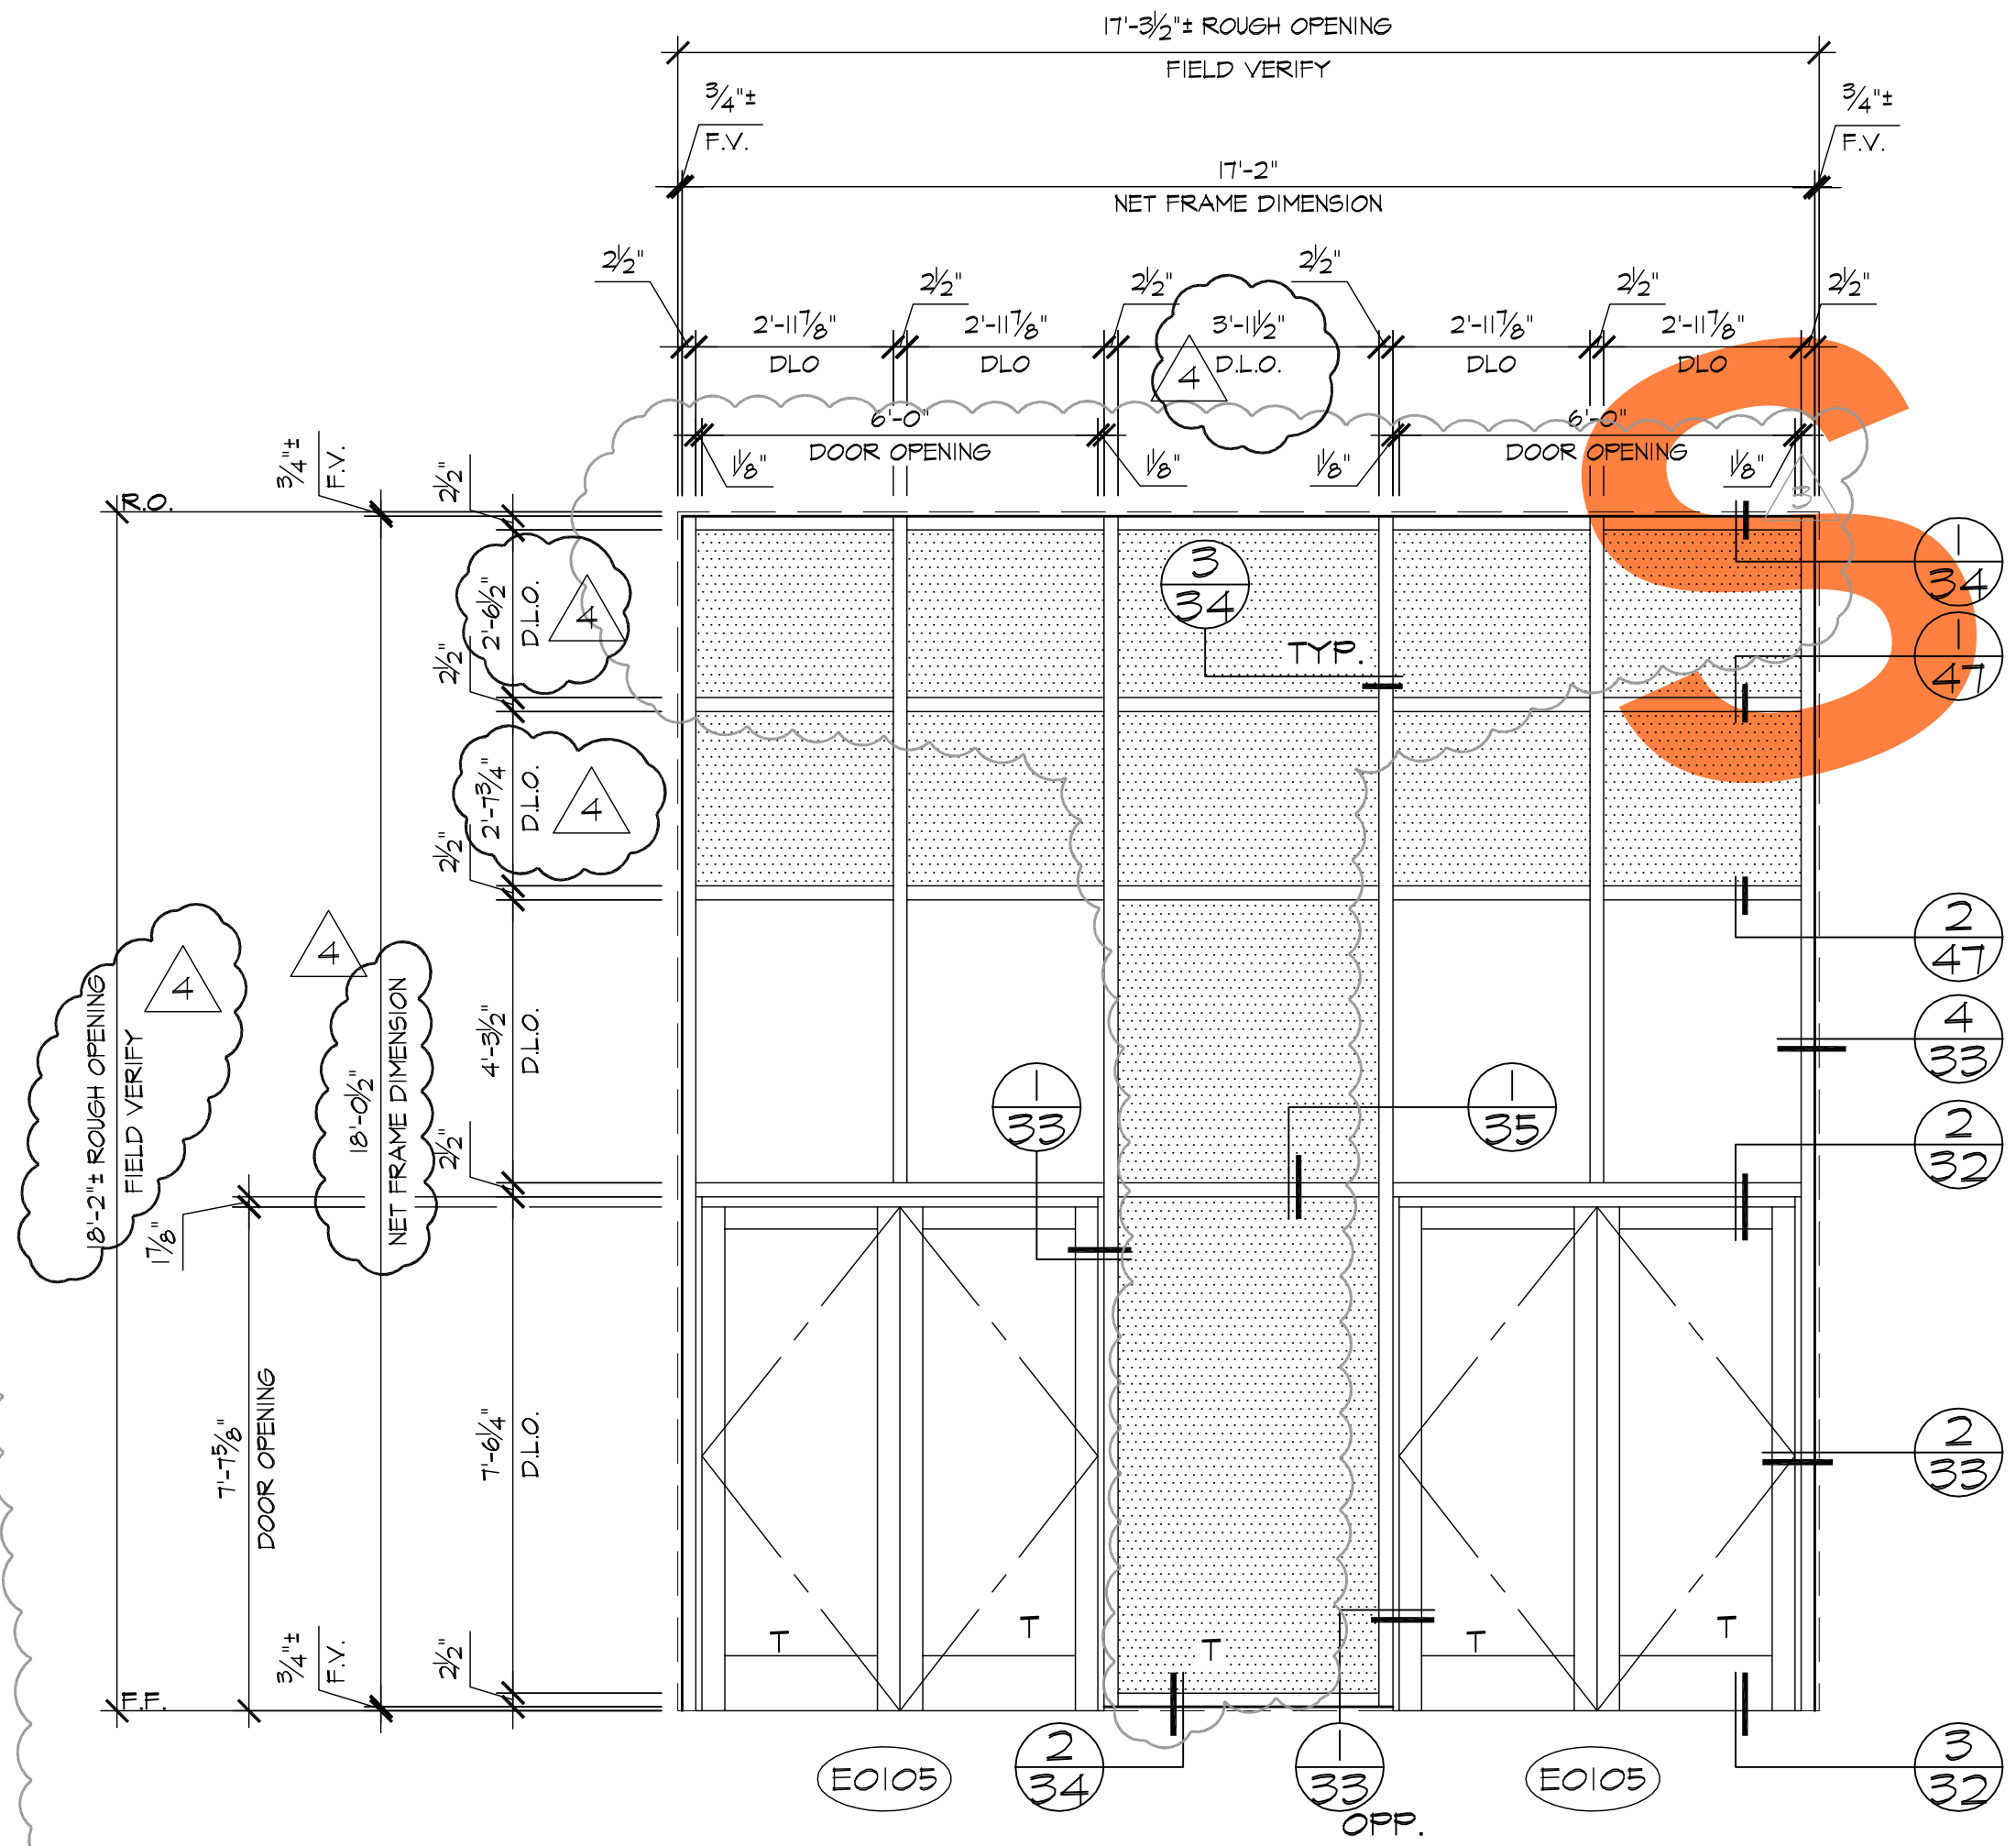

C ELEVATION (2 1/2" X 7" CURTAIN WALL SYSTEM)
17 LOCATION
AREA G 1st. FLR. ~ 1 REQ'D (SOUTH)

D ELEVATION (2 1/2" X 7" CURTAIN WALL SYSTEM)
17 LOCATION
AREA G @CLERESTORY ~ 1 REQ'D (SOUTH)

REVISIONS		BY
△	4-23-07	BMR
△	6-11-07	BMR
△	12-17-07	CTB
△	3/6/08	CTB
△		

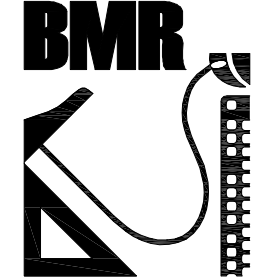


BMR
DRAFTING SERVICE
SINCE 1988
23846 SUNNYMEAD BLVD.
SUITE 6
MORENO VALLEY, CA 92553
P: (951) 243-7814
F: (951) 243-7873


GLASS FACORY
26383 BASE LINE
HIGHLAND, CA 92346

AS-BUILT DRAWINGS


JOB NAME:	AGUA CALIENTE HOTEL ADDITION
ARCHITECT:	VOA
SHEET DESCRIPTION:	ELEVATIONS
DATE:	1/3/07
SCALE:	3/8"=1'-0"
DRAWN:	CTB
JOB NO:	100-06
SHEET NO:	17

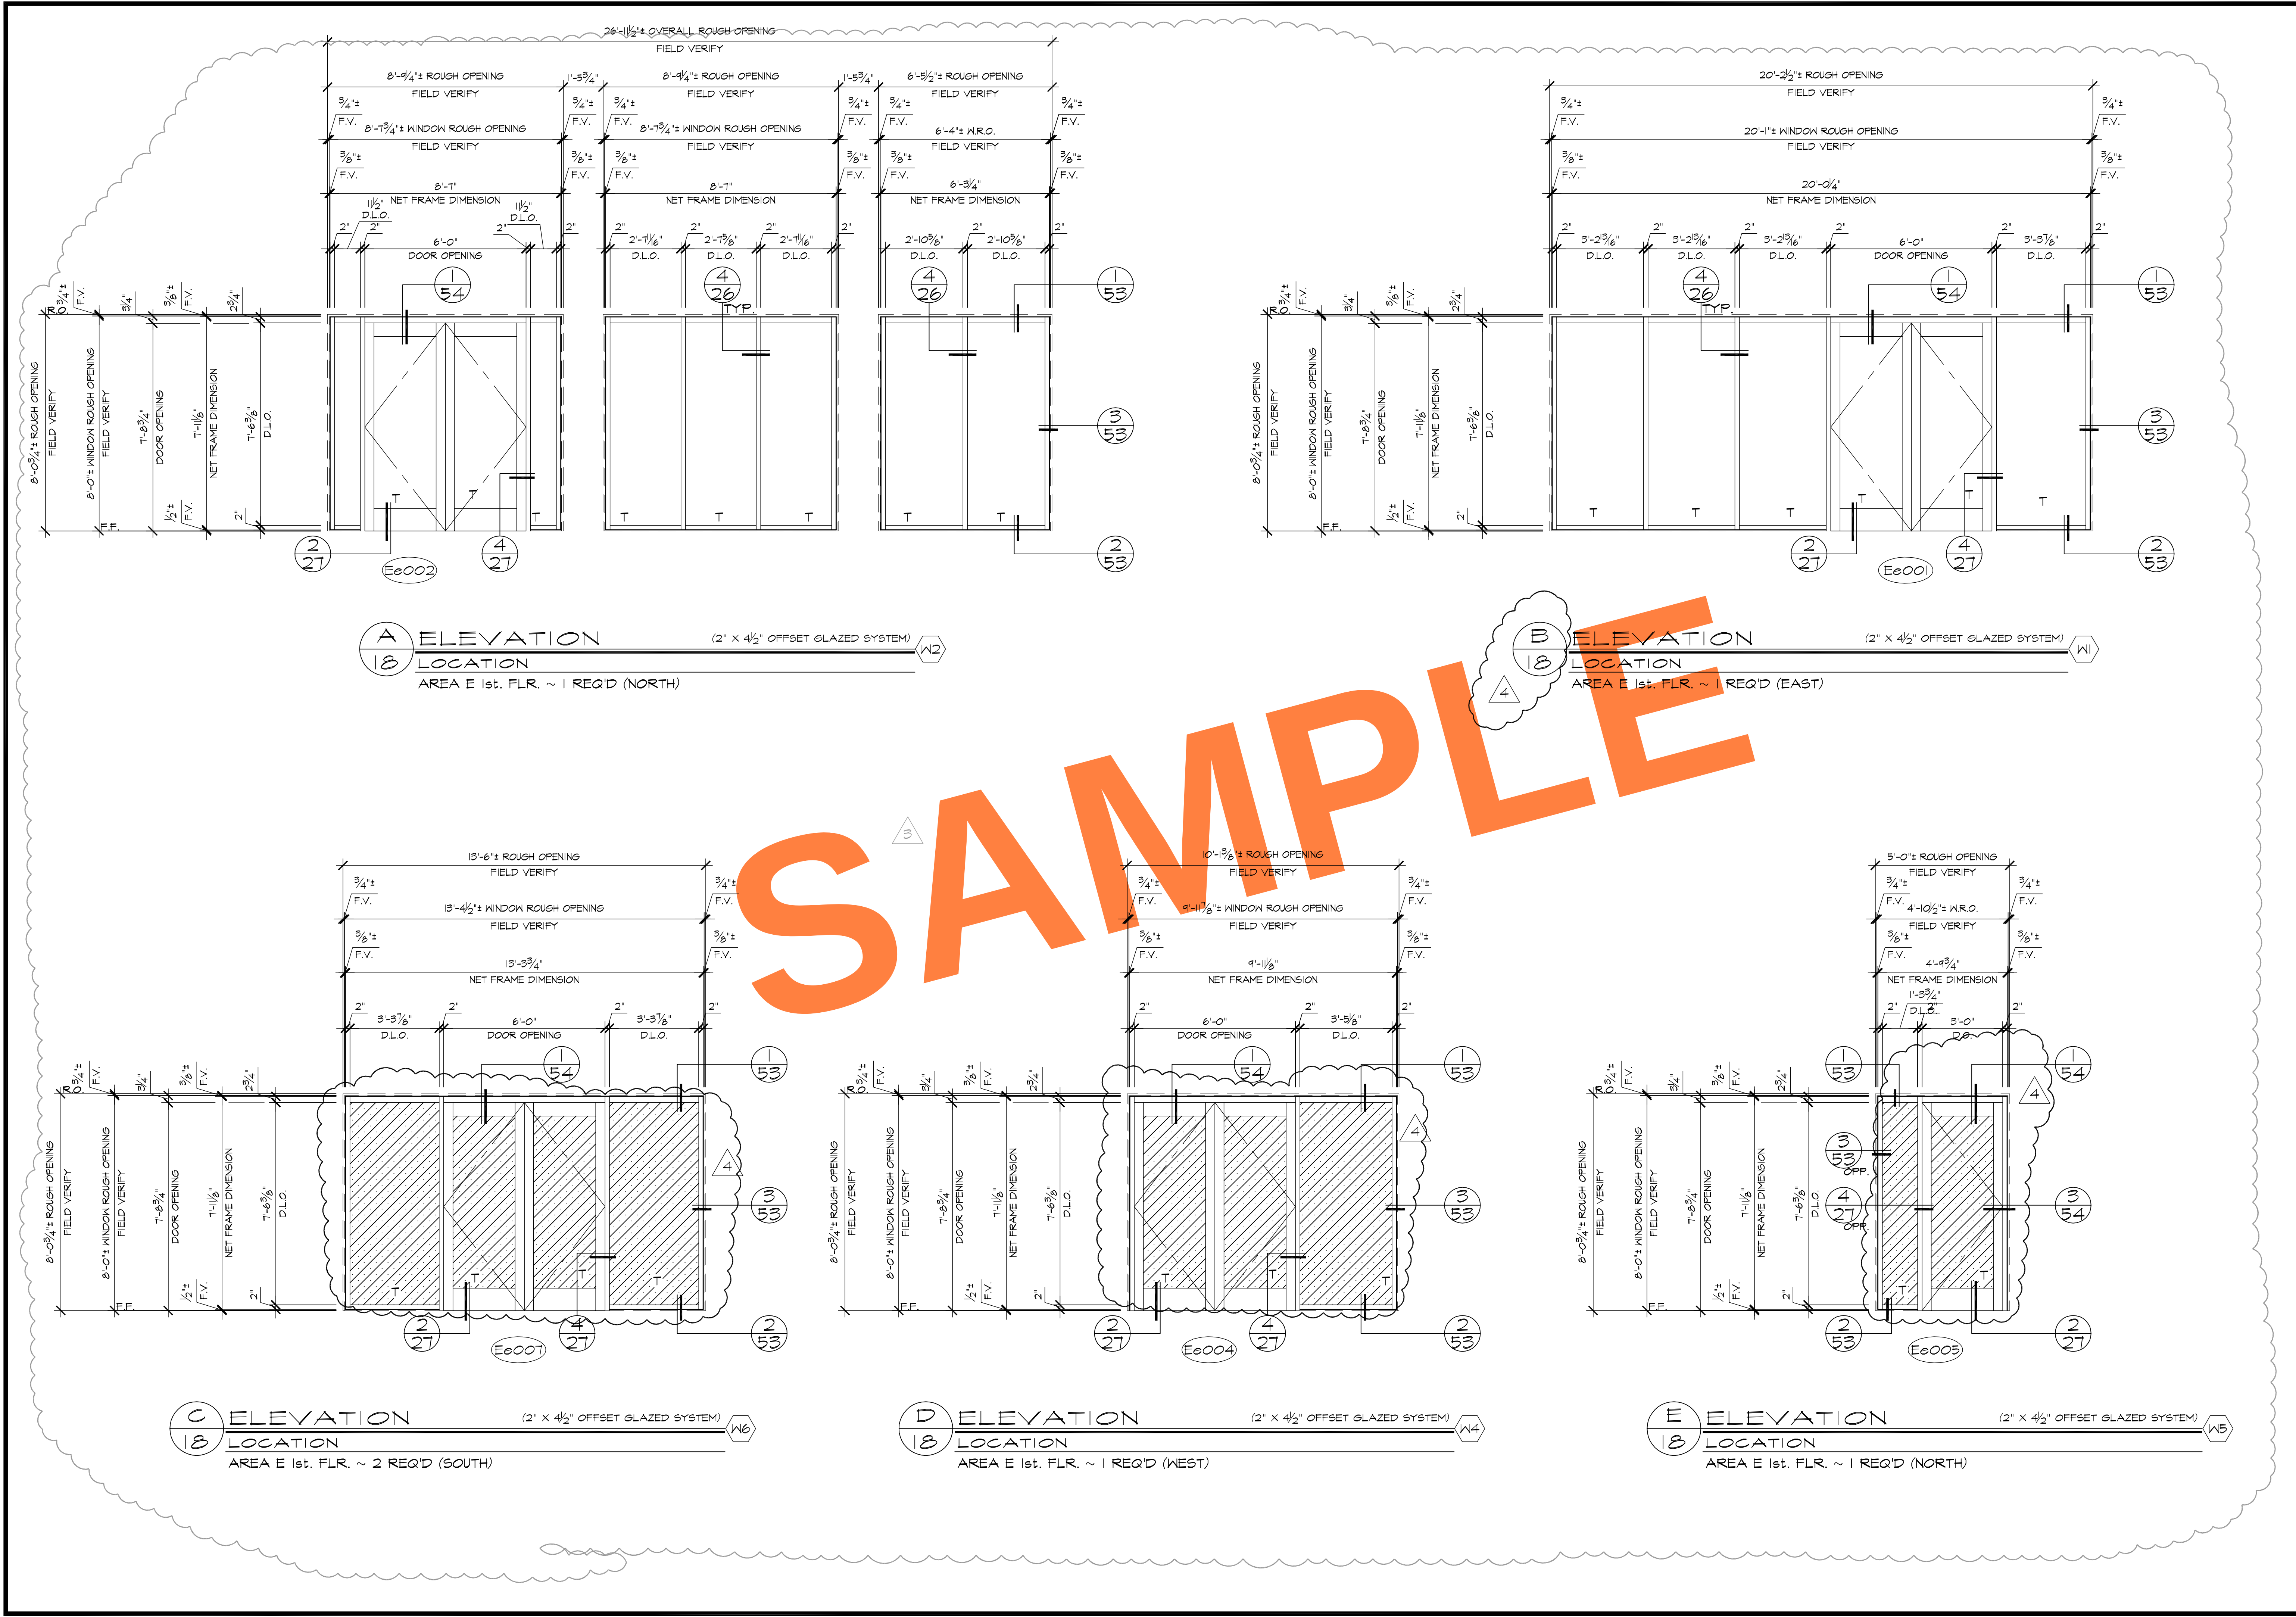


REVISIONS		BY
△	4-23-07	BMR
△	6-11-07	BMR
△	12-17-07	CTB
△	3/6/08	CTB
△		
BMR DRAFTING SERVICE SINCE 1988 23846 SUNNYMEAD BLVD. SUITE 80 MORENO VALLEY, CA 92553 B: (951) 243-7814 F: (951) 243-7873		
GLASS FACTORY 26383 BASE LINE HIGHLAND, CA 92346		
AS-BUILT DRAWINGS		
JOB NAME:	AGUA CALIENTE HOTEL ADDITION	
ARCHITECT:	VOA	
SHEET DESCRIPTION:	ELEVATIONS	
DATE:	1/3/07	
SCALE:	3/8"=1'-0"	
DRAWN:	CTB	
JOB NO:	100-06	
SHEET NO:	18	

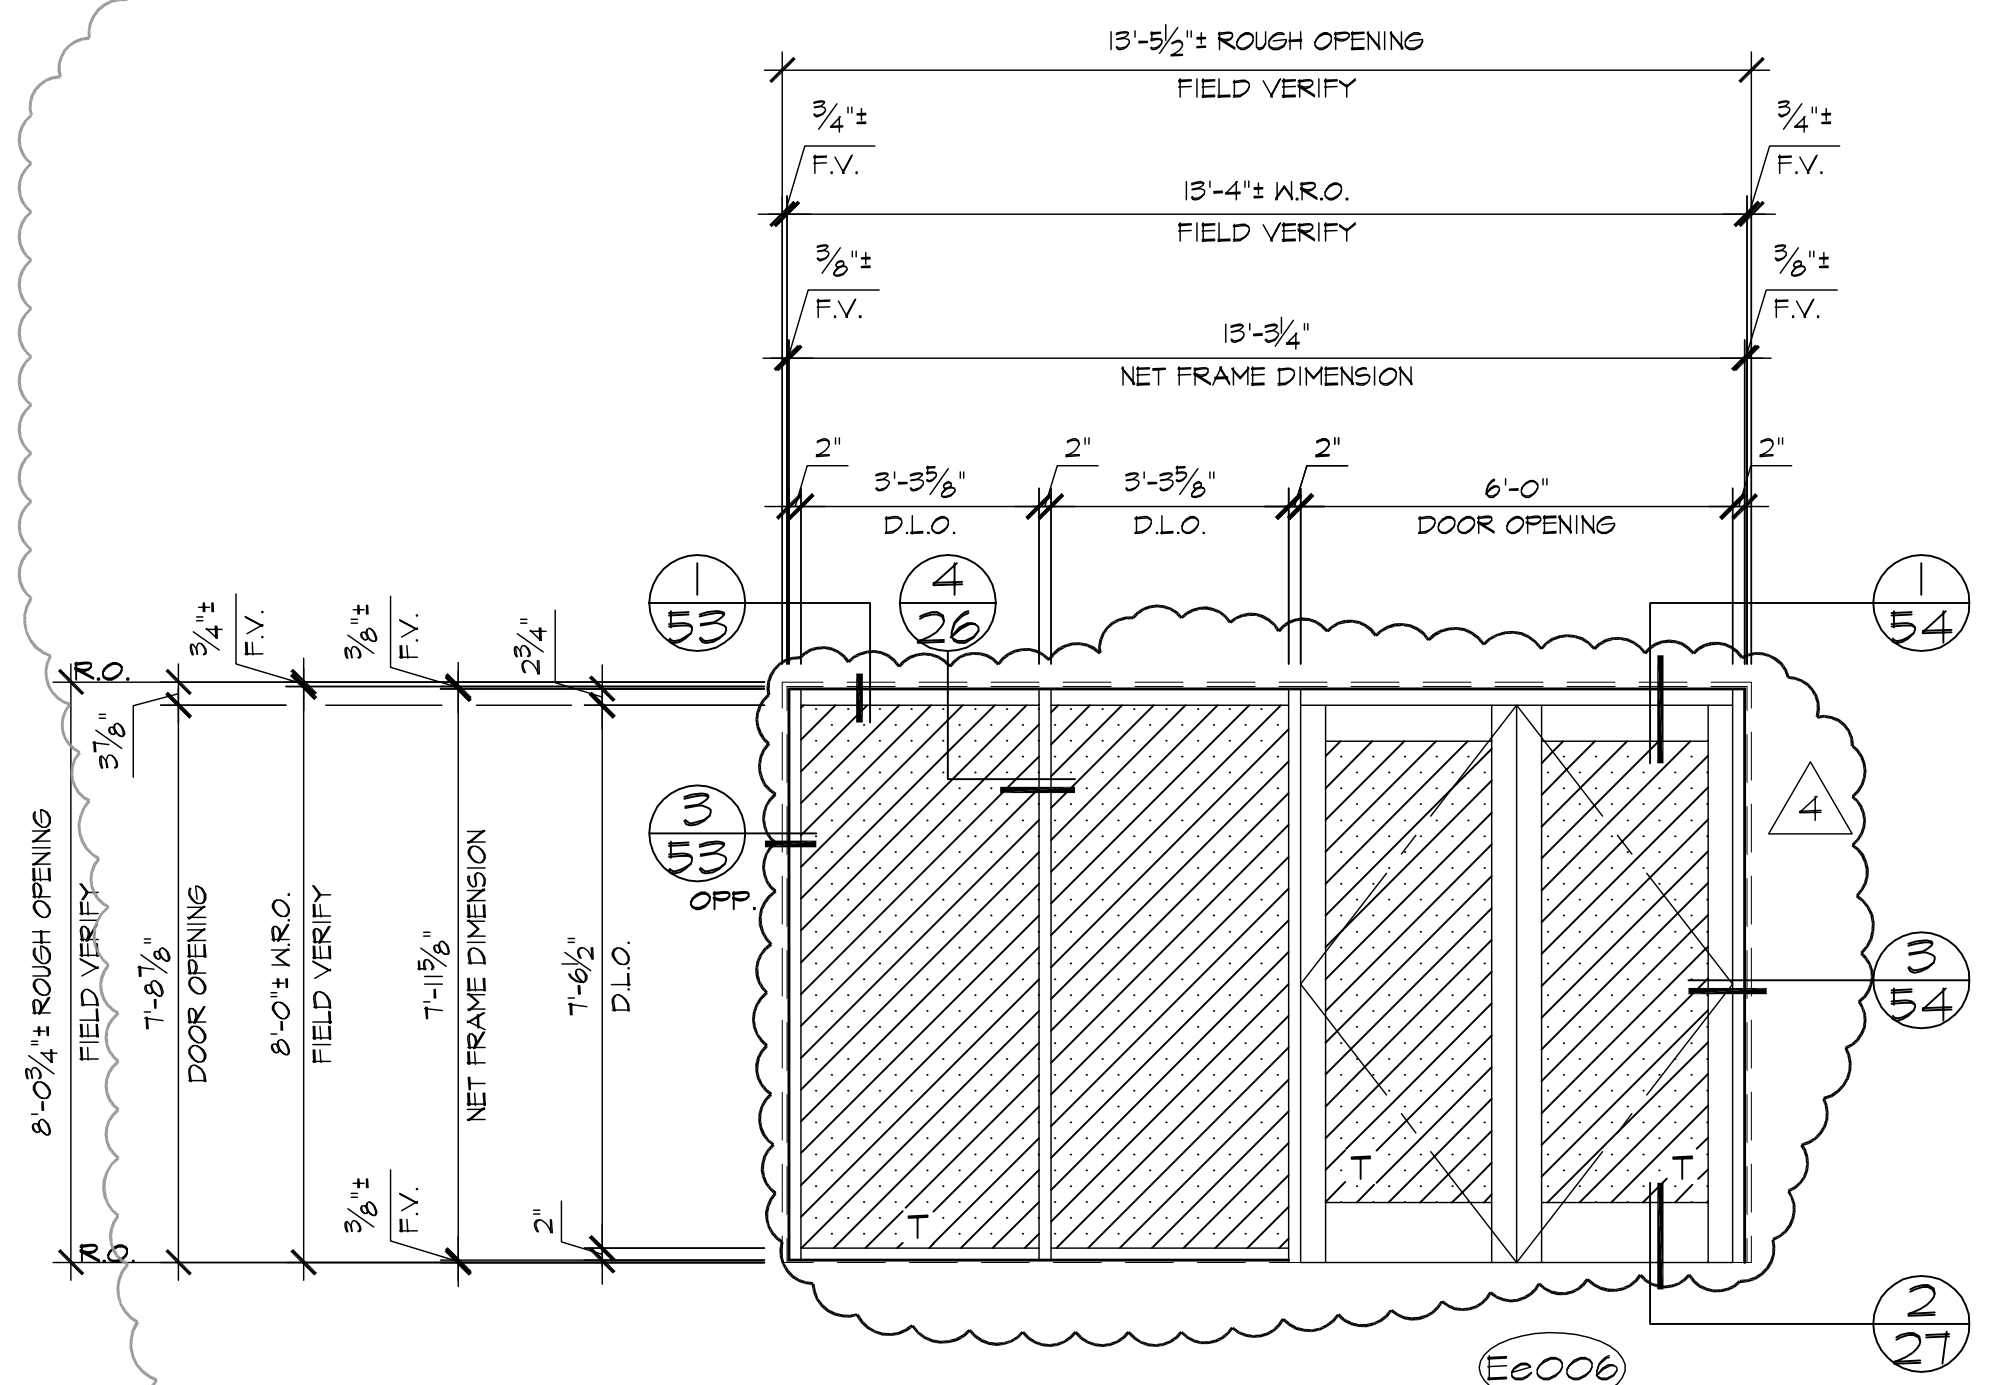


A ELEVATION (2" X 4 1/2" OFFSET GLAZED SYSTEM) **BM**
19 LOCATION
AREA E 1st. FLR. ~ 1 REQ'D (SOUTH)

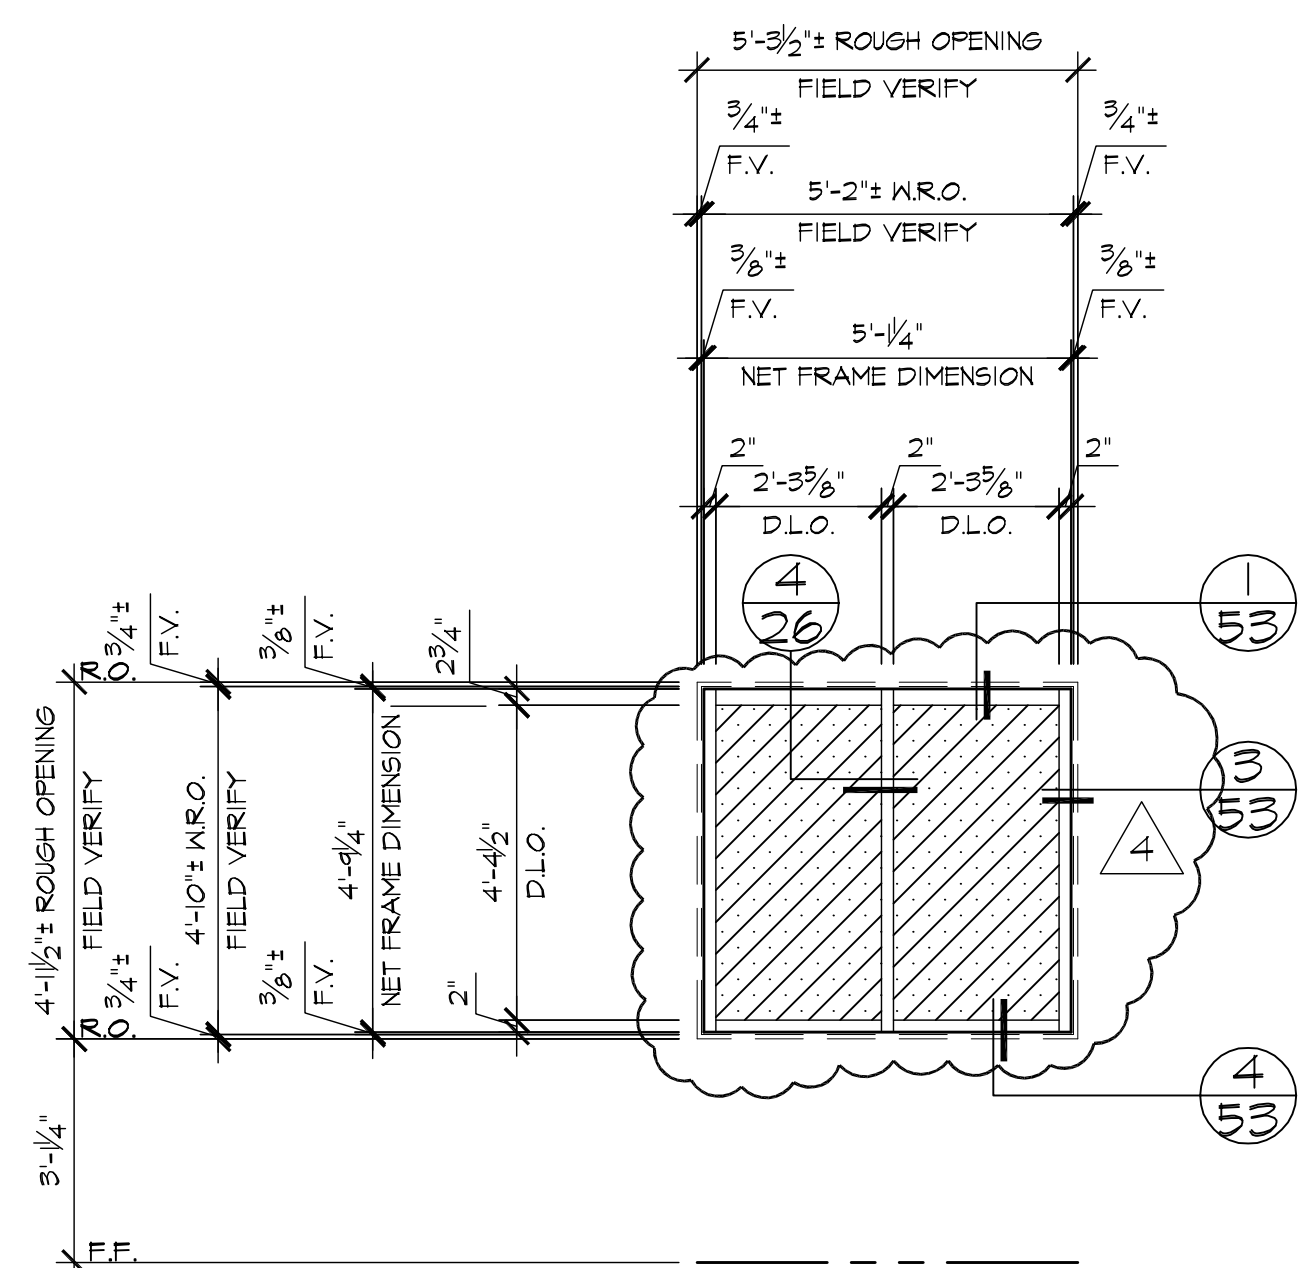

B ELEVATION (2" X 4 1/2" OFFSET GLAZED SYSTEM) **NB**
19 LOCATION
AREA E 1st. FLR. ~ 4 REQ'D (SOUTH)

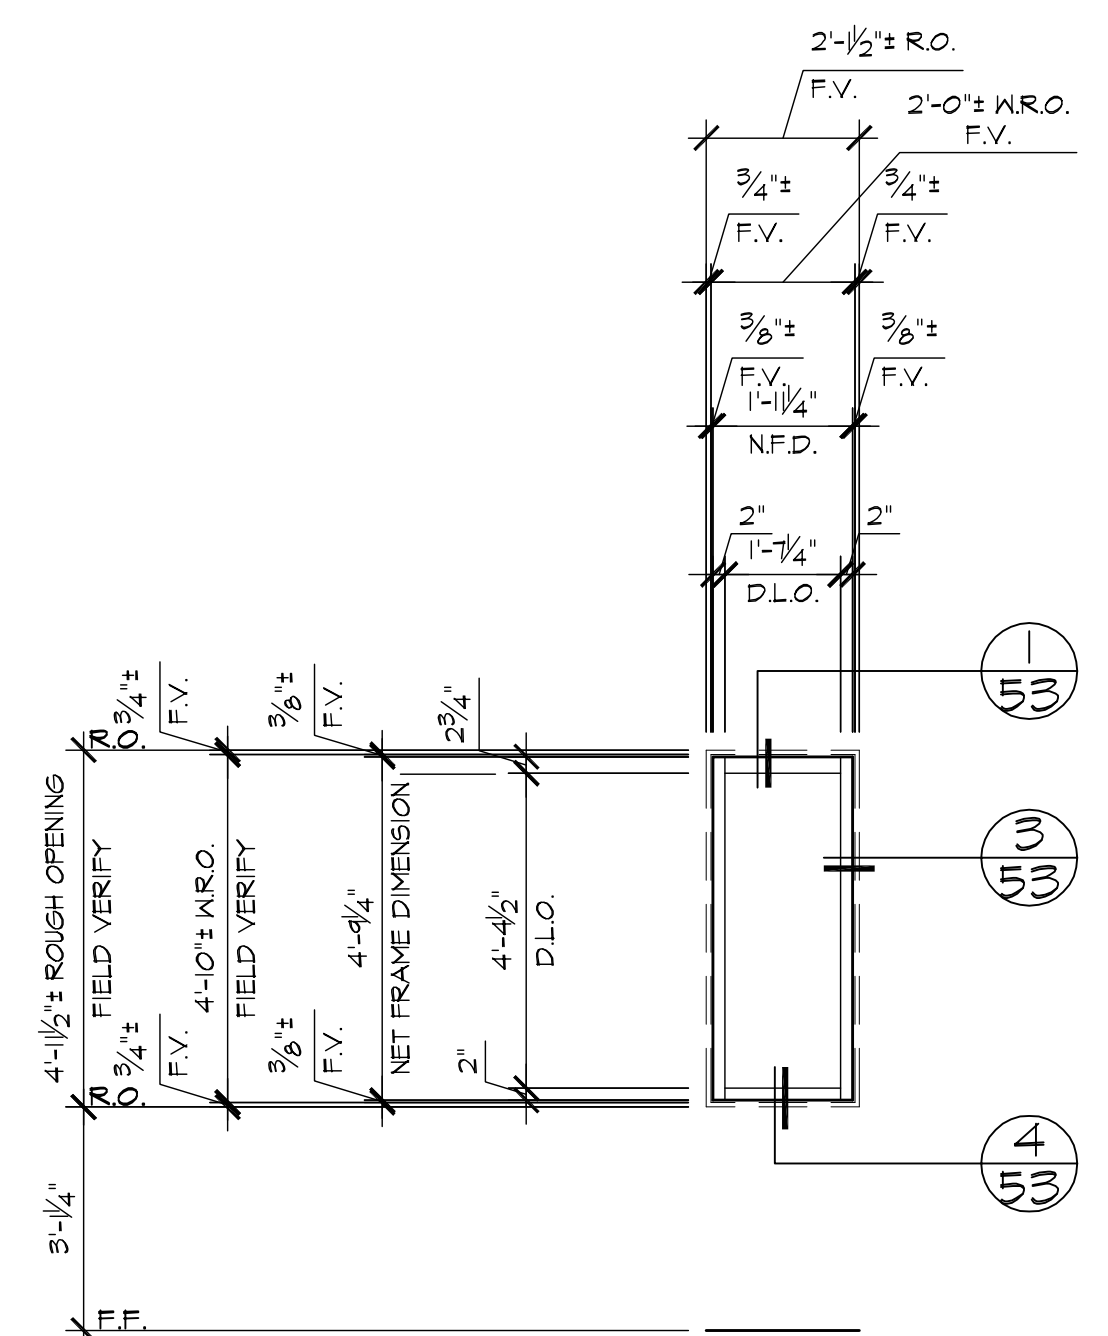

C ELEVATION (2" X 4 1/2" OFFSET GLAZED SYSTEM) **NO**
19 LOCATION
AREA E 1st. FLR. ~ 4 REQ'D (SOUTH)
AREA E 1st. FLR. ~ 3 REQ'D (NORTH)

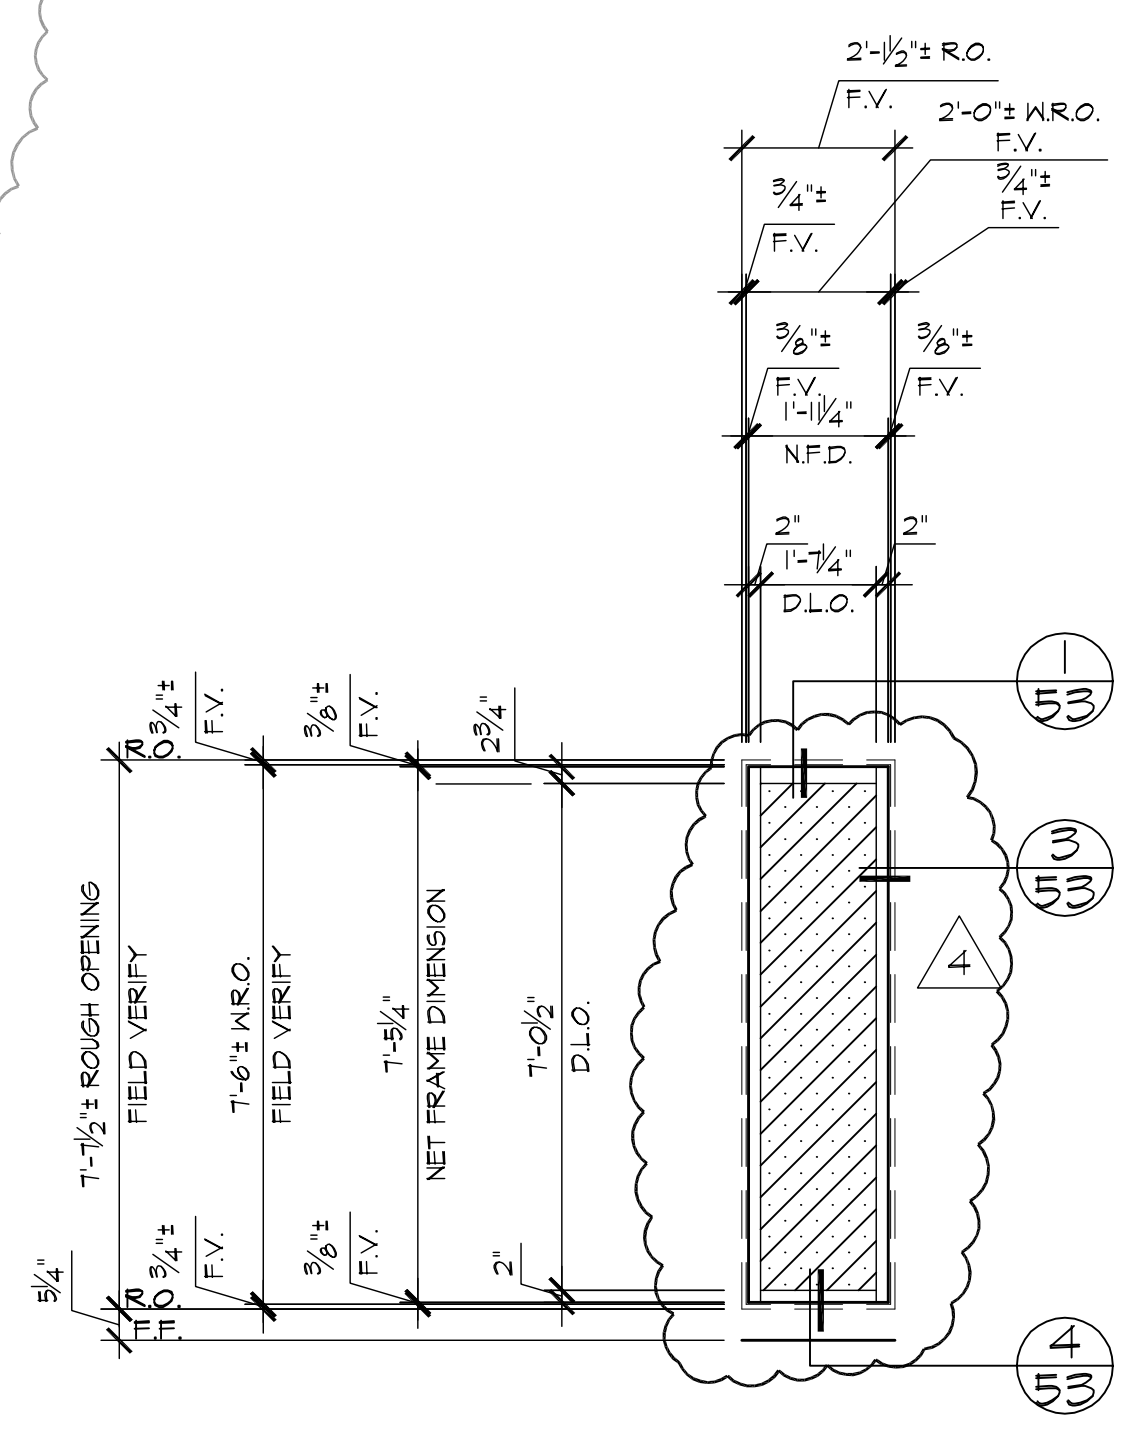


D ELEVATION (2" X 4 1/2" OFFSET GLAZED SYSTEM) **WT**
19 LOCATION
AREA E 1st. FLR. ~ 3 REQ'D (SOUTH)

SAMPLE


REVISIONS		BY
△	4-23-07	BMR
△	6-11-07	BMR
△	12-17-07	CTB
△	3/6/08	CTB
△		
 BMR DRAFTING SERVICE SINCE 1988 23846 SUNNYMEAD BLVD. SUITE 100 MORENO VALLEY, CA 92553 P: (951) 243-7814 F: (951) 243-7873		
GLASS FACTORY 26383 BASE LINE HIGHLAND, CA 92346		AS-BUILT DRAWINGS
JOB NAME:	AGUA CALIENTE HOTEL ADDITION	
ARCHITECT:	VOA	
SHEET DESCRIPTION:	ELEVATIONS	
DATE:	1/3/07	
SCALE:	3/8"=1'-0"	
DRAWN:	CTB	
JOB NO:	100-06	
SHEET NO:	19	

THIS ELEVATION IS NOT USED

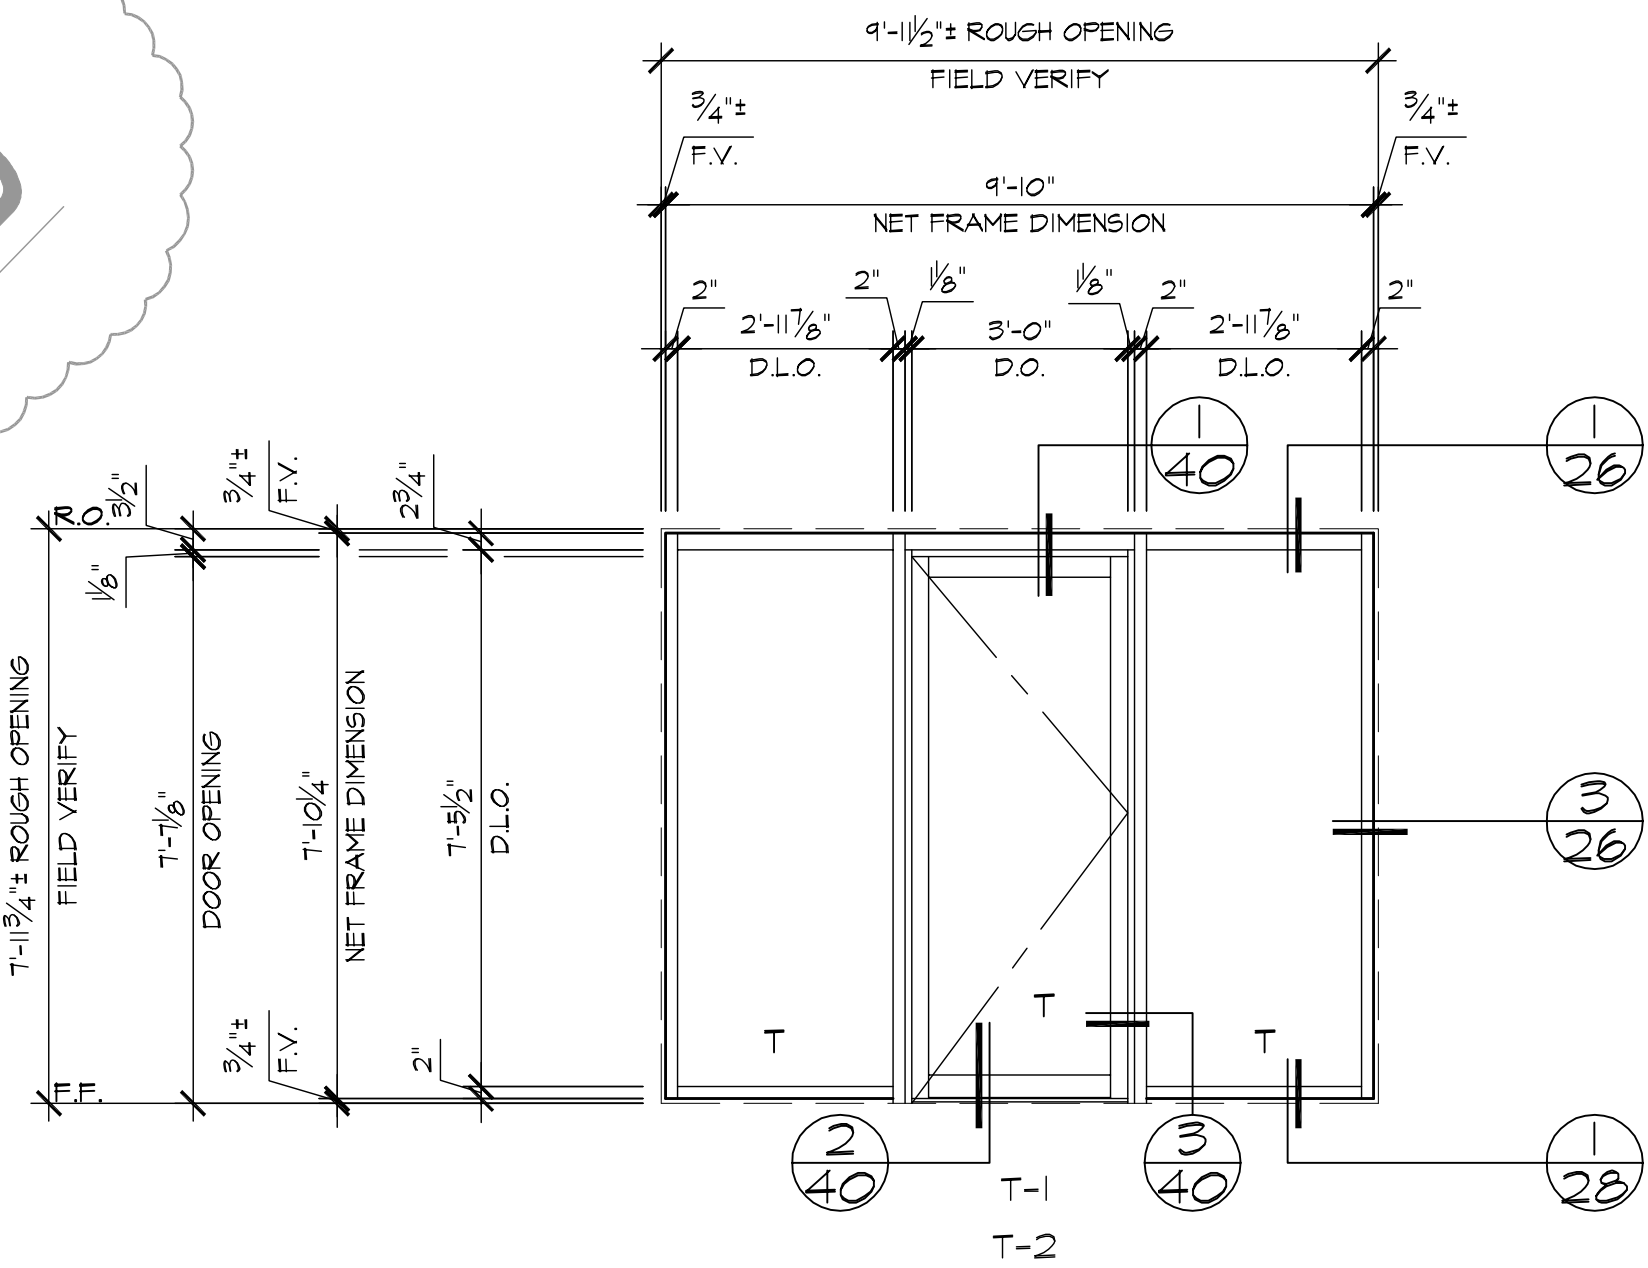


A ELEVATION (2½" X 7" CURTAIN WALL SYSTEM)
20 LOCATION
AREA A CLERESTORY ~ 1 REQ'D (SOUTH)


B ELEVATION (2" X 4 ½" OFFSET GLAZED SYSTEM) (W2)
20 LOCATION
AREA A 2nd. FLR. ~ 6 REQ'D (WEST)
AREA B 2nd. FLR. ~ 6 REQ'D (WEST)

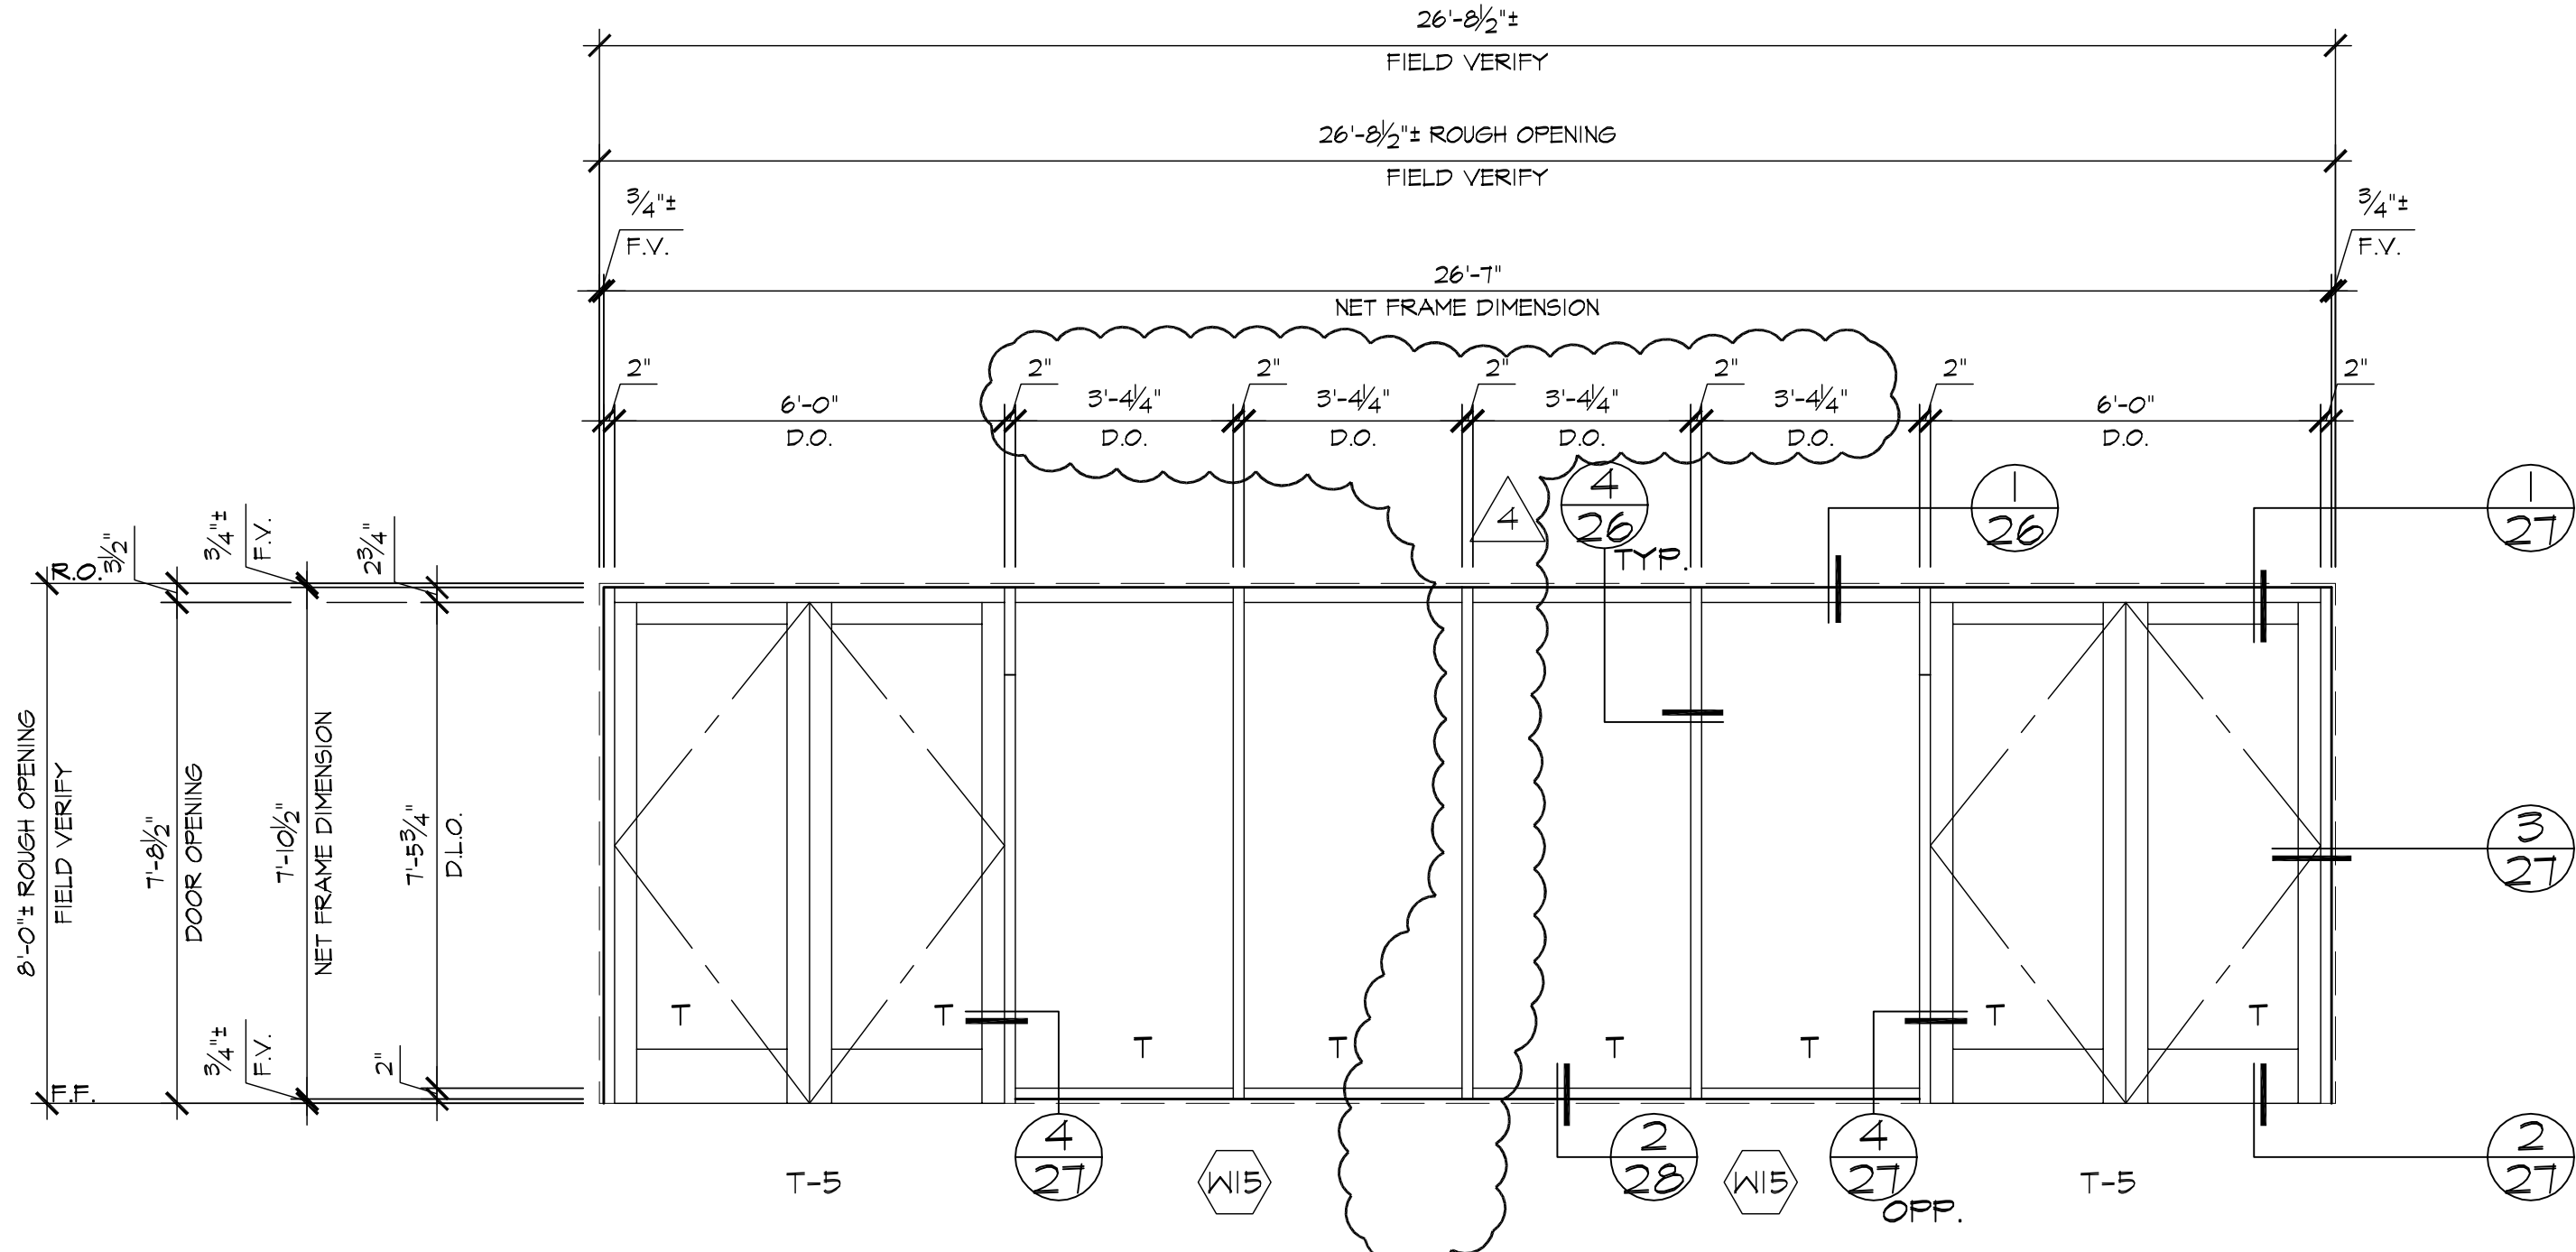


C ELEVATION (2" X 4 ½" OFFSET GLAZED SYSTEM) (W15)
20 LOCATION
AREA B 2nd. FLR. ~ 1 REQ'D (WEST)

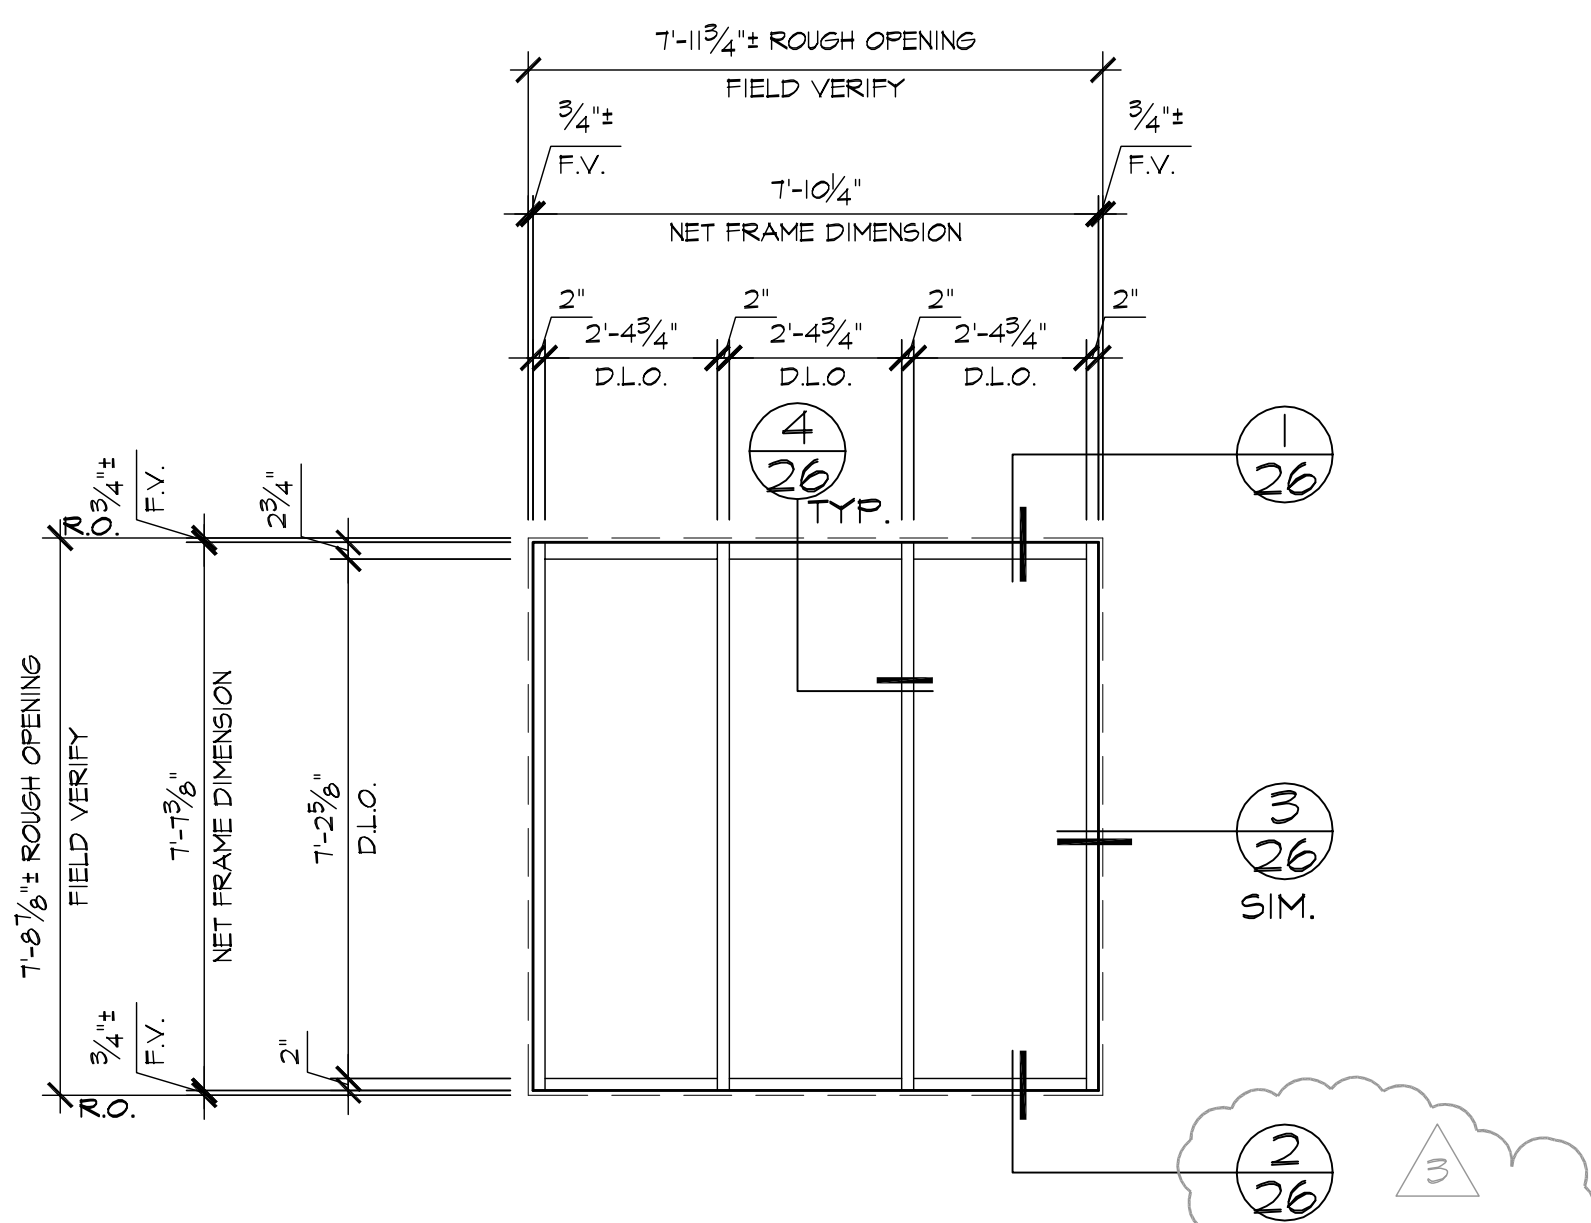

D ELEVATION (2" X 4 ½" OFFSET GLAZED SYSTEM) (W5)
20 LOCATION
AREA B 2nd. FLR. ~ 1 REQ'D (EAST)
AREA B 3rd. FLR. ~ 1 REQ'D (EAST)
AREA B 4th. FLR. ~ 1 REQ'D (EAST)
AREA B 5th. FLR. ~ 1 REQ'D (EAST)
AREA B 6th. FLR. ~ 1 REQ'D (EAST)
AREA B 7th. FLR. ~ 1 REQ'D (EAST)
AREA B 8th. FLR. ~ 1 REQ'D (EAST)
AREA B 9th. FLR. ~ 1 REQ'D (EAST)
AREA B 10th. FLR. ~ 1 REQ'D (EAST)
AREA B 11th. FLR. ~ 1 REQ'D (EAST)
AREA B 12th. FLR. ~ 1 REQ'D (EAST)
AREA B 13th. FLR. ~ 1 REQ'D (EAST)
AREA B 14th. FLR. ~ 1 REQ'D (EAST)

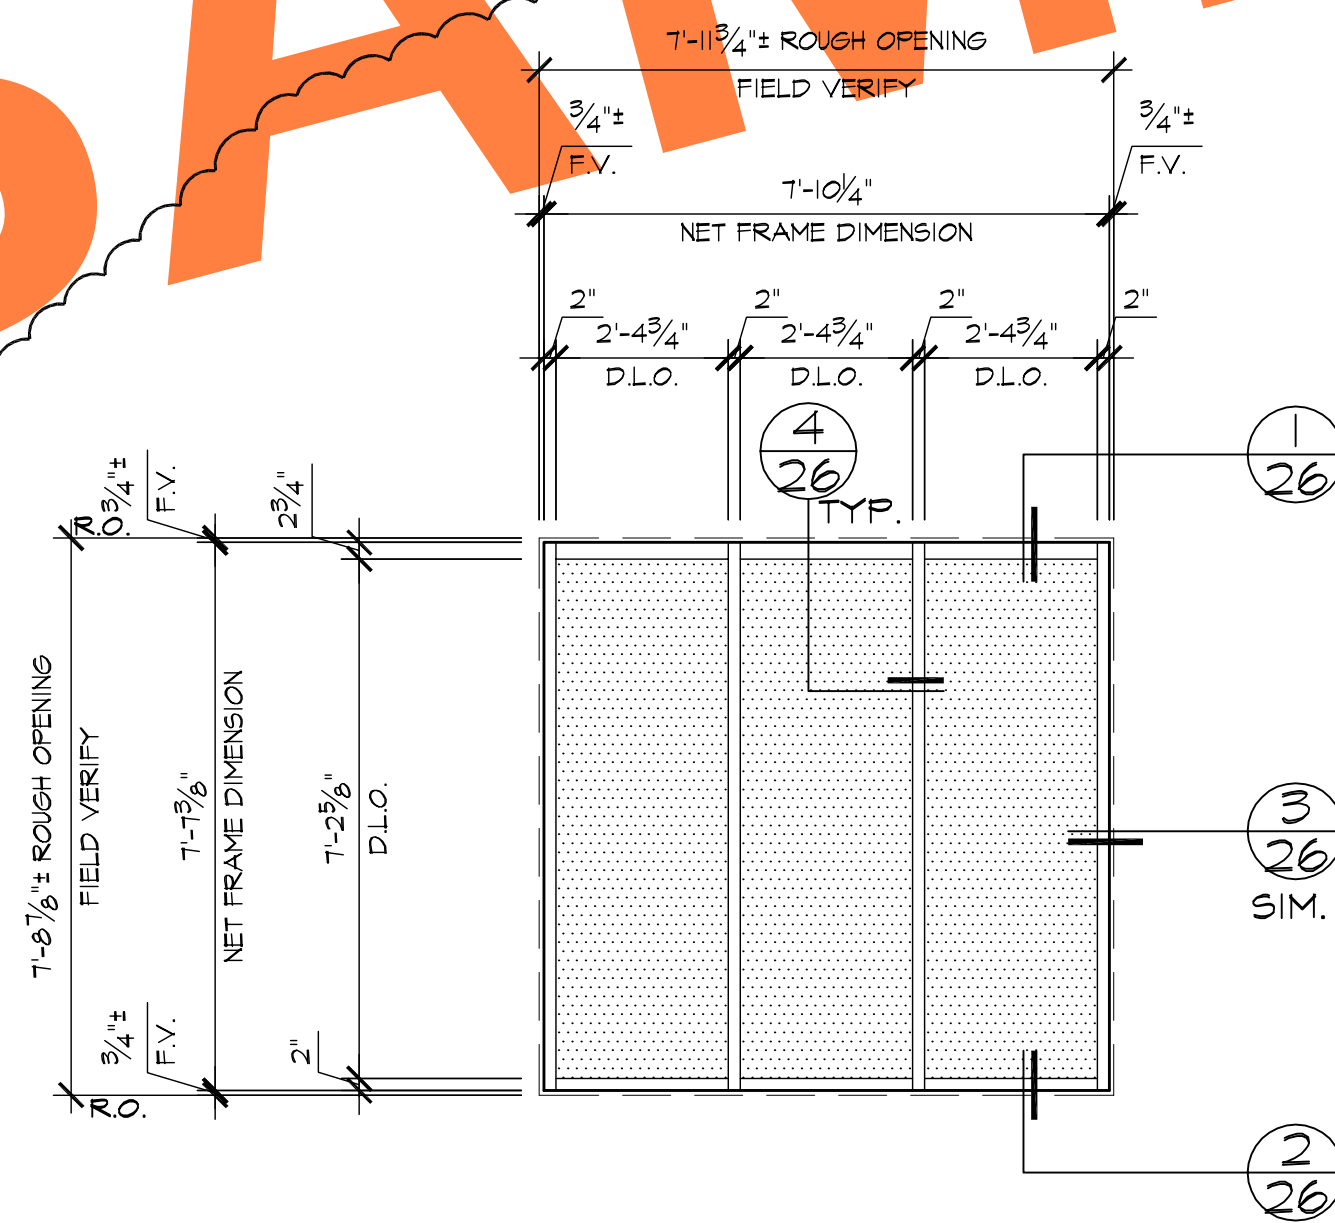

E ELEVATION (2" X 4 ½" OFFSET GLAZED SYSTEM) (W5)
20 LOCATION
AREA B 2nd. FLR. ~ 1 REQ'D (EAST)
AREA B 3rd. FLR. ~ 1 REQ'D (EAST)
AREA B 4th. FLR. ~ 1 REQ'D (EAST)
AREA B 5th. FLR. ~ 1 REQ'D (EAST)
AREA B 6th. FLR. ~ 1 REQ'D (EAST)
AREA B 7th. FLR. ~ 1 REQ'D (EAST)
AREA B 8th. FLR. ~ 1 REQ'D (EAST)
AREA B 9th. FLR. ~ 1 REQ'D (EAST)
AREA B 10th. FLR. ~ 1 REQ'D (EAST)
AREA B 11th. FLR. ~ 1 REQ'D (EAST)
AREA B 12th. FLR. ~ 1 REQ'D (EAST)
AREA B 13th. FLR. ~ 1 REQ'D (EAST)
AREA B 14th. FLR. ~ 1 REQ'D (EAST)

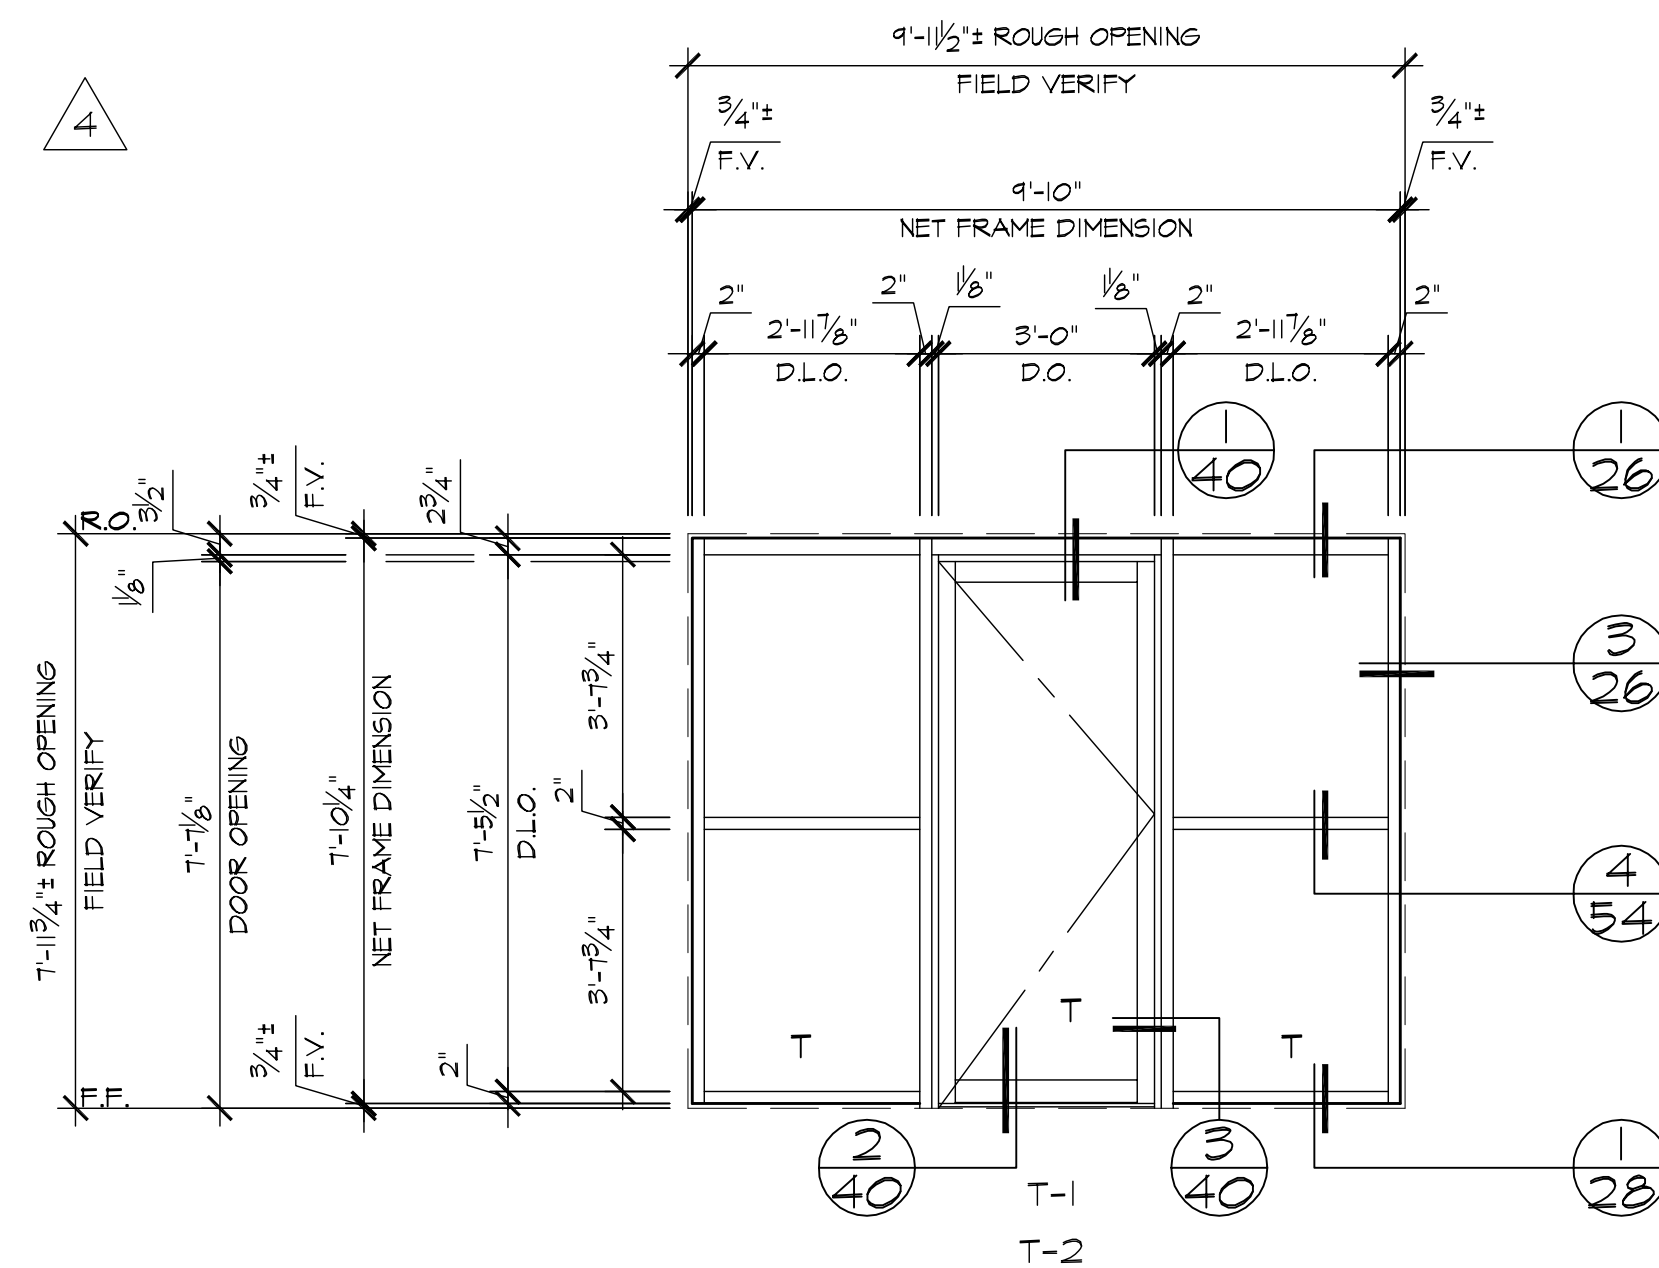

F ELEVATION (2" X 4 ½" OFFSET GLAZED SYSTEM) (W2)
20 LOCATION
AREA B 3rd. FLR. ~ 3 REQ'D (WEST)
AREA B 3rd. FLR. ~ 1 REQ'D/OPF (WEST)




REVISIONS	BY
△ 4-23-07	BMR
△ 6-11-07	BMR
△ 12-17-07	CTB
△ 3/6/08	CTB
△	

BMR
DRAFTING SERVICE
SINCE 1988
23846 SUNNYMEAD BLVD.
SUITE #9
MORENO VALLEY, CA 92553
B: (951) 243-7814
F: (951) 243-7873

GLASS FACE FACTORY
26383 BASE LINE
HIGHLAND, CA 92346

AS-BUILT DRAWINGS

JOB NAME:	AGUA CALIENTE HOTEL ADDITION
ARCHITECT:	VOA
SHEET DESCRIPTION:	ELEVATIONS
DATE:	1/3/07
SCALE:	3/8"=1'-0"
DRAWN:	CTB
JOB NO:	100-06
SHEET NO:	20

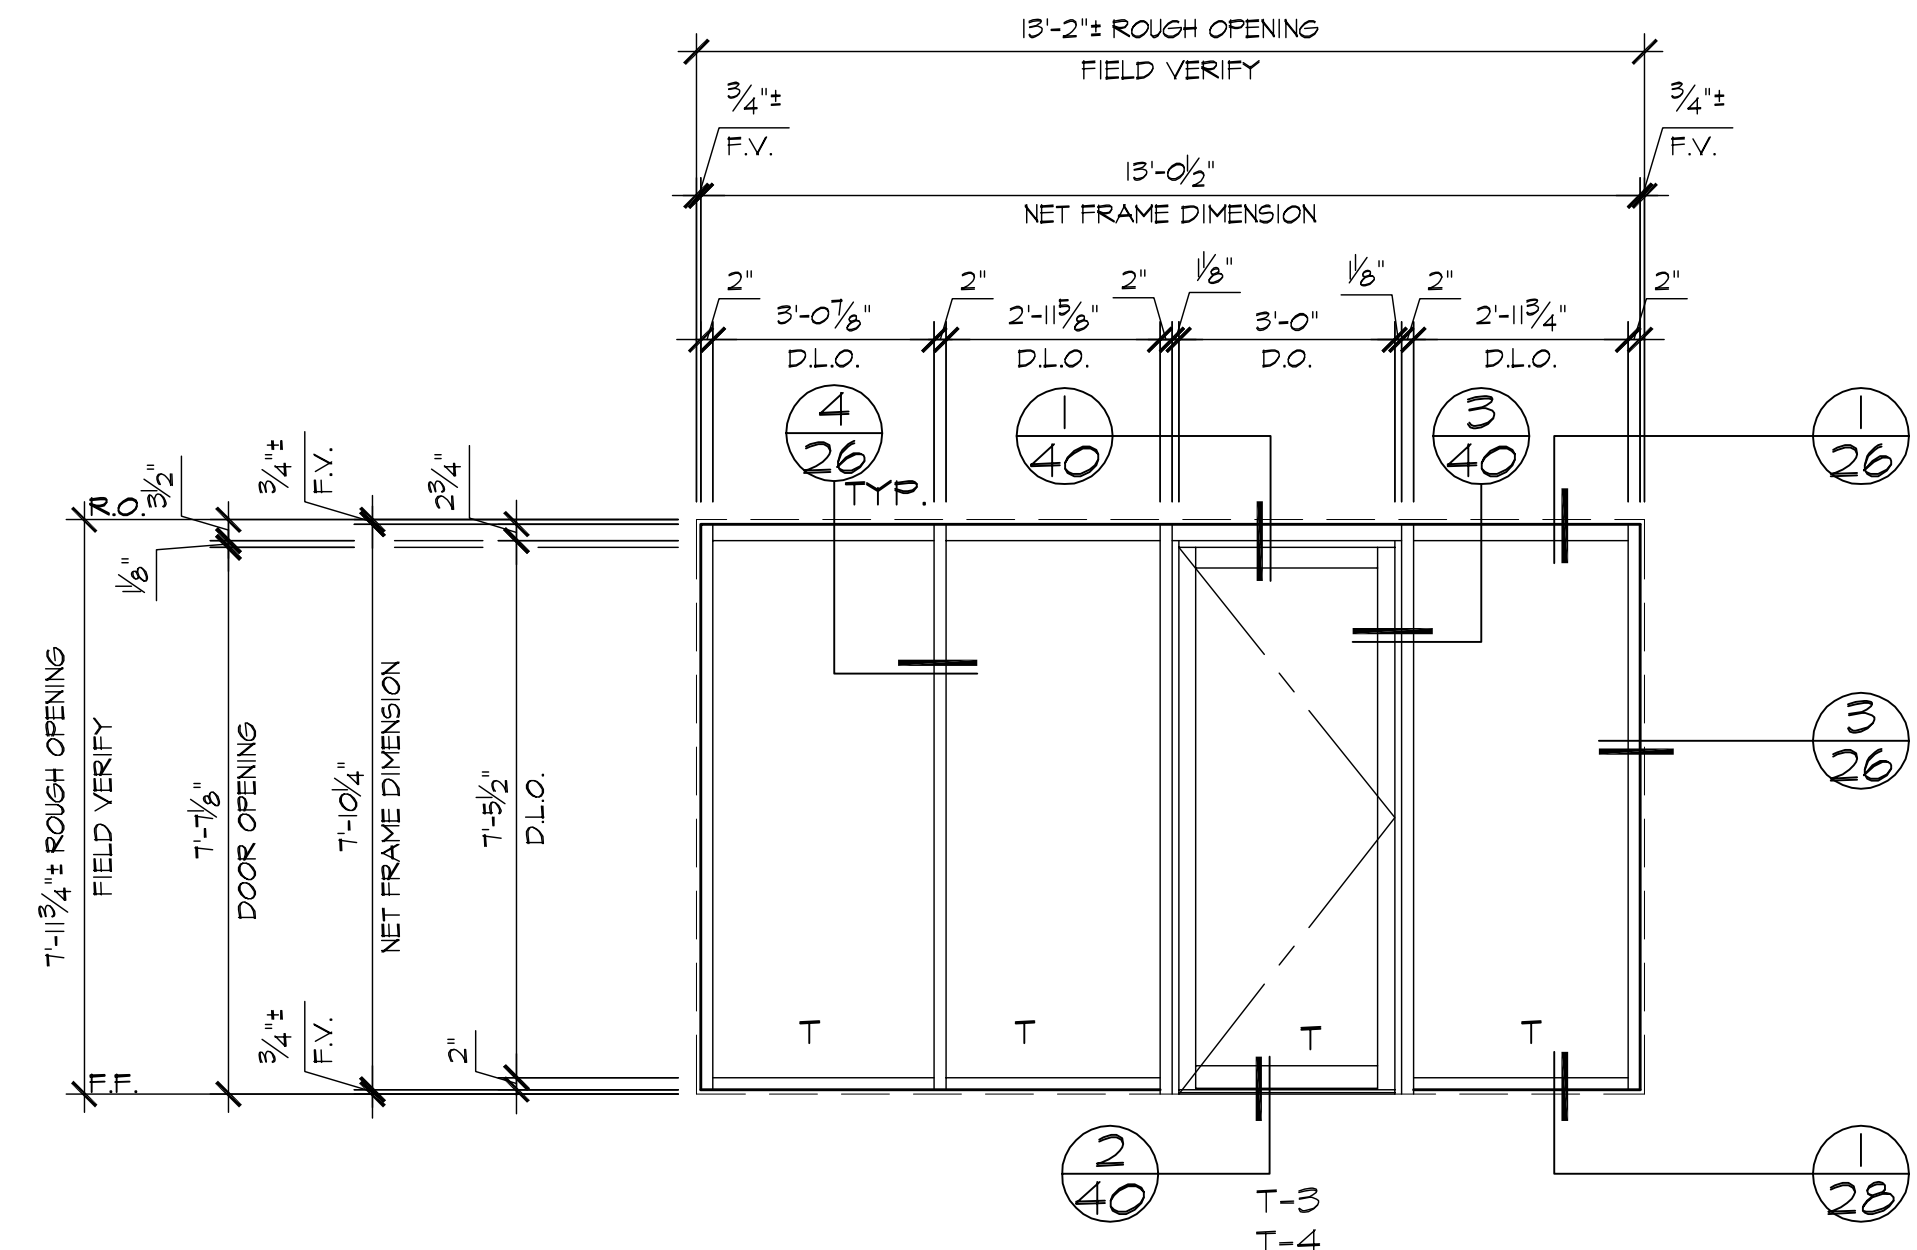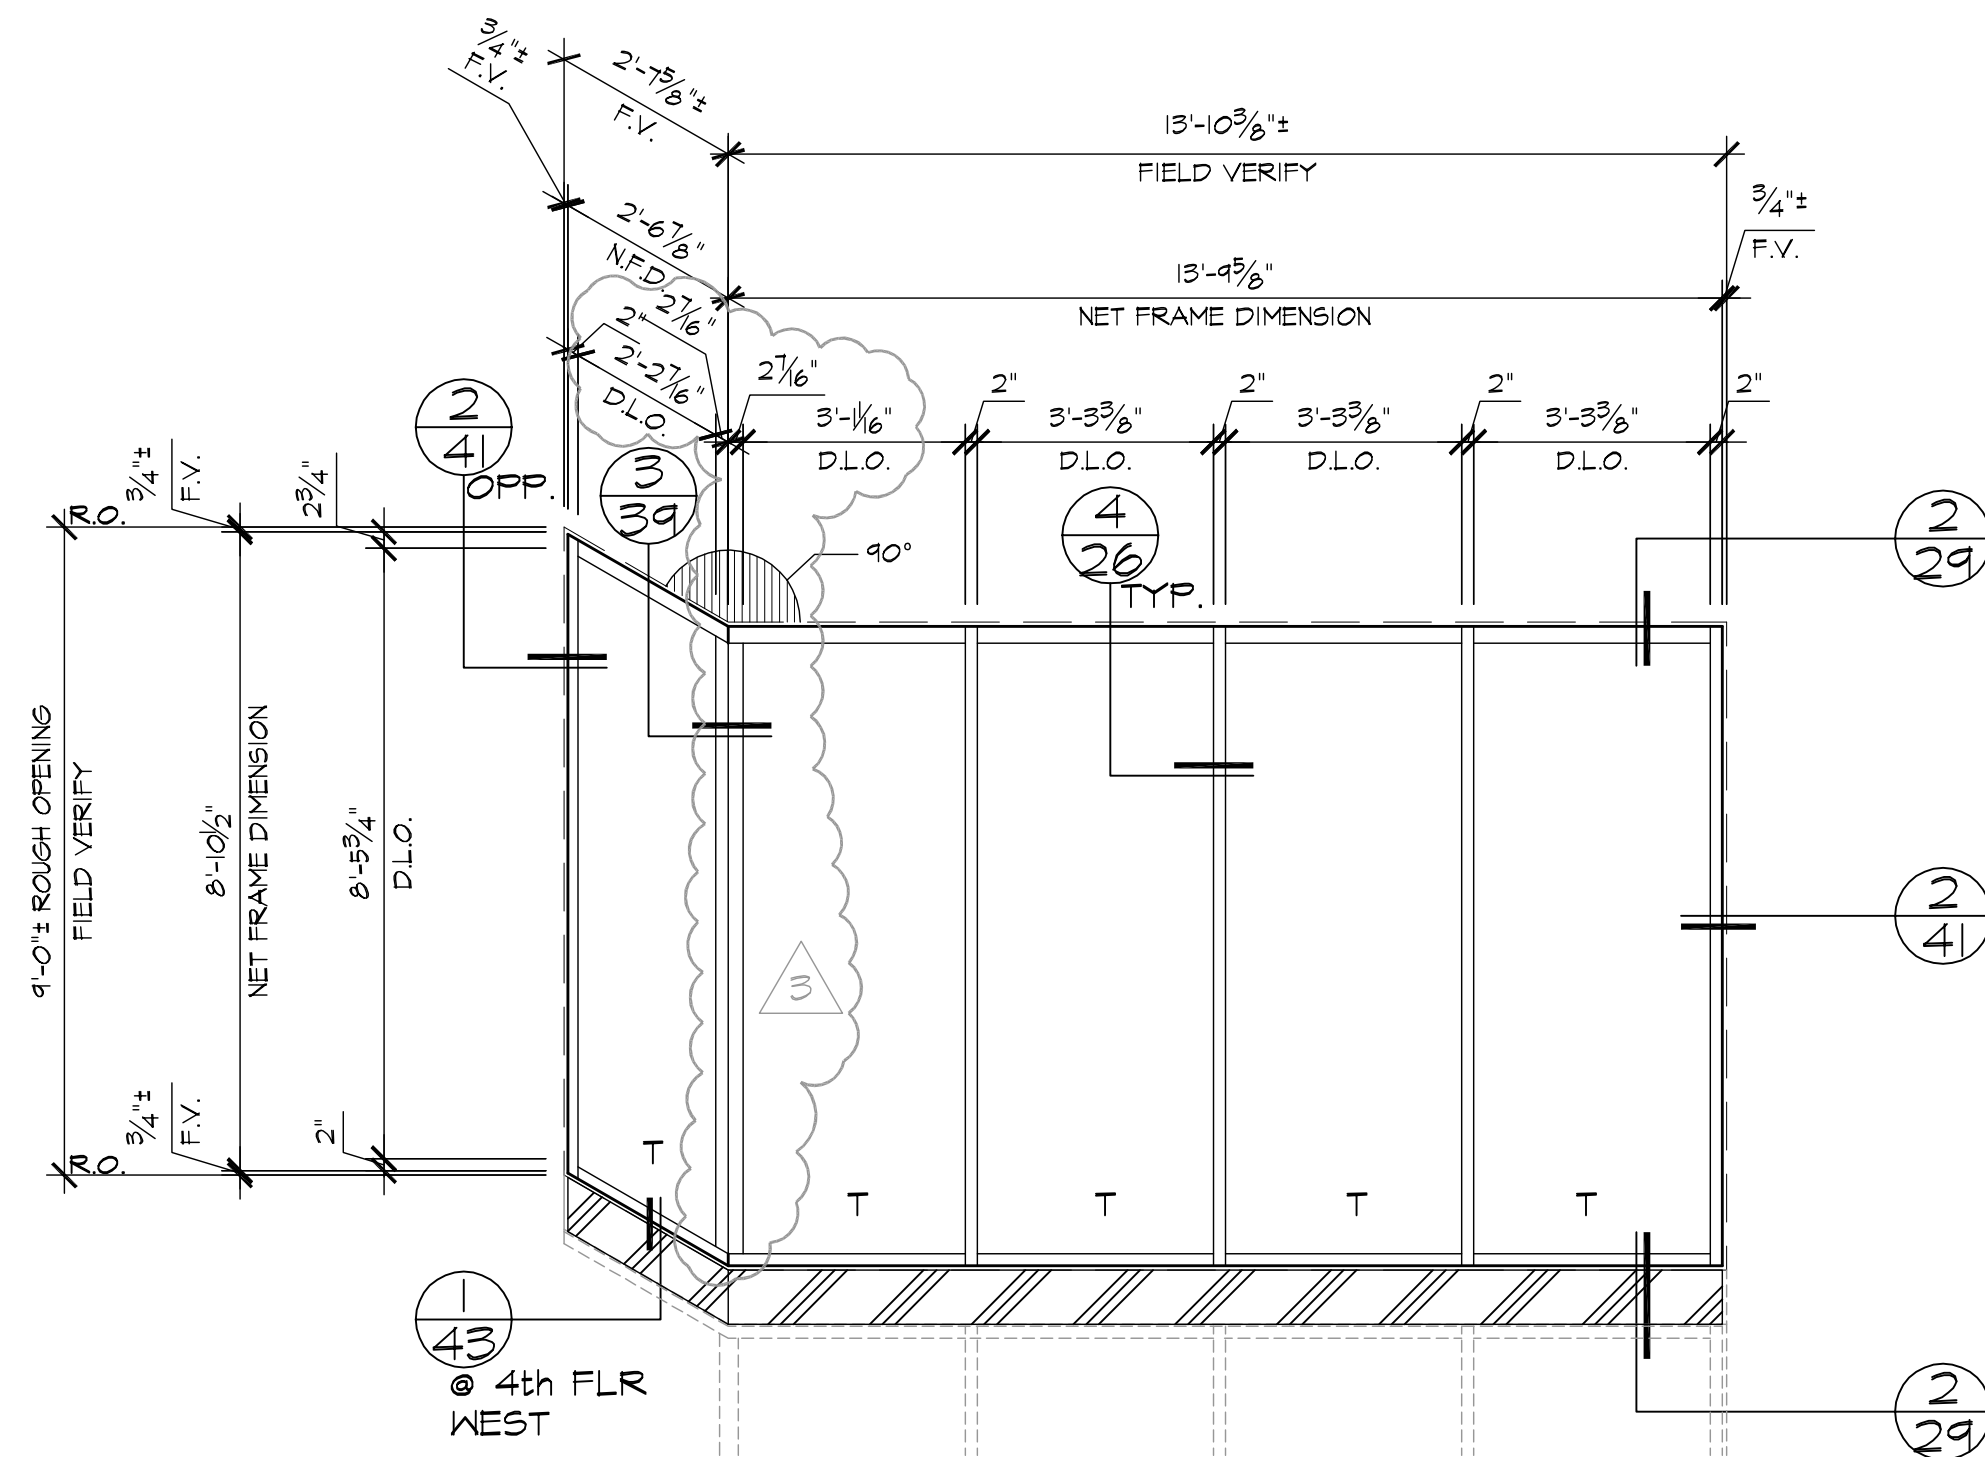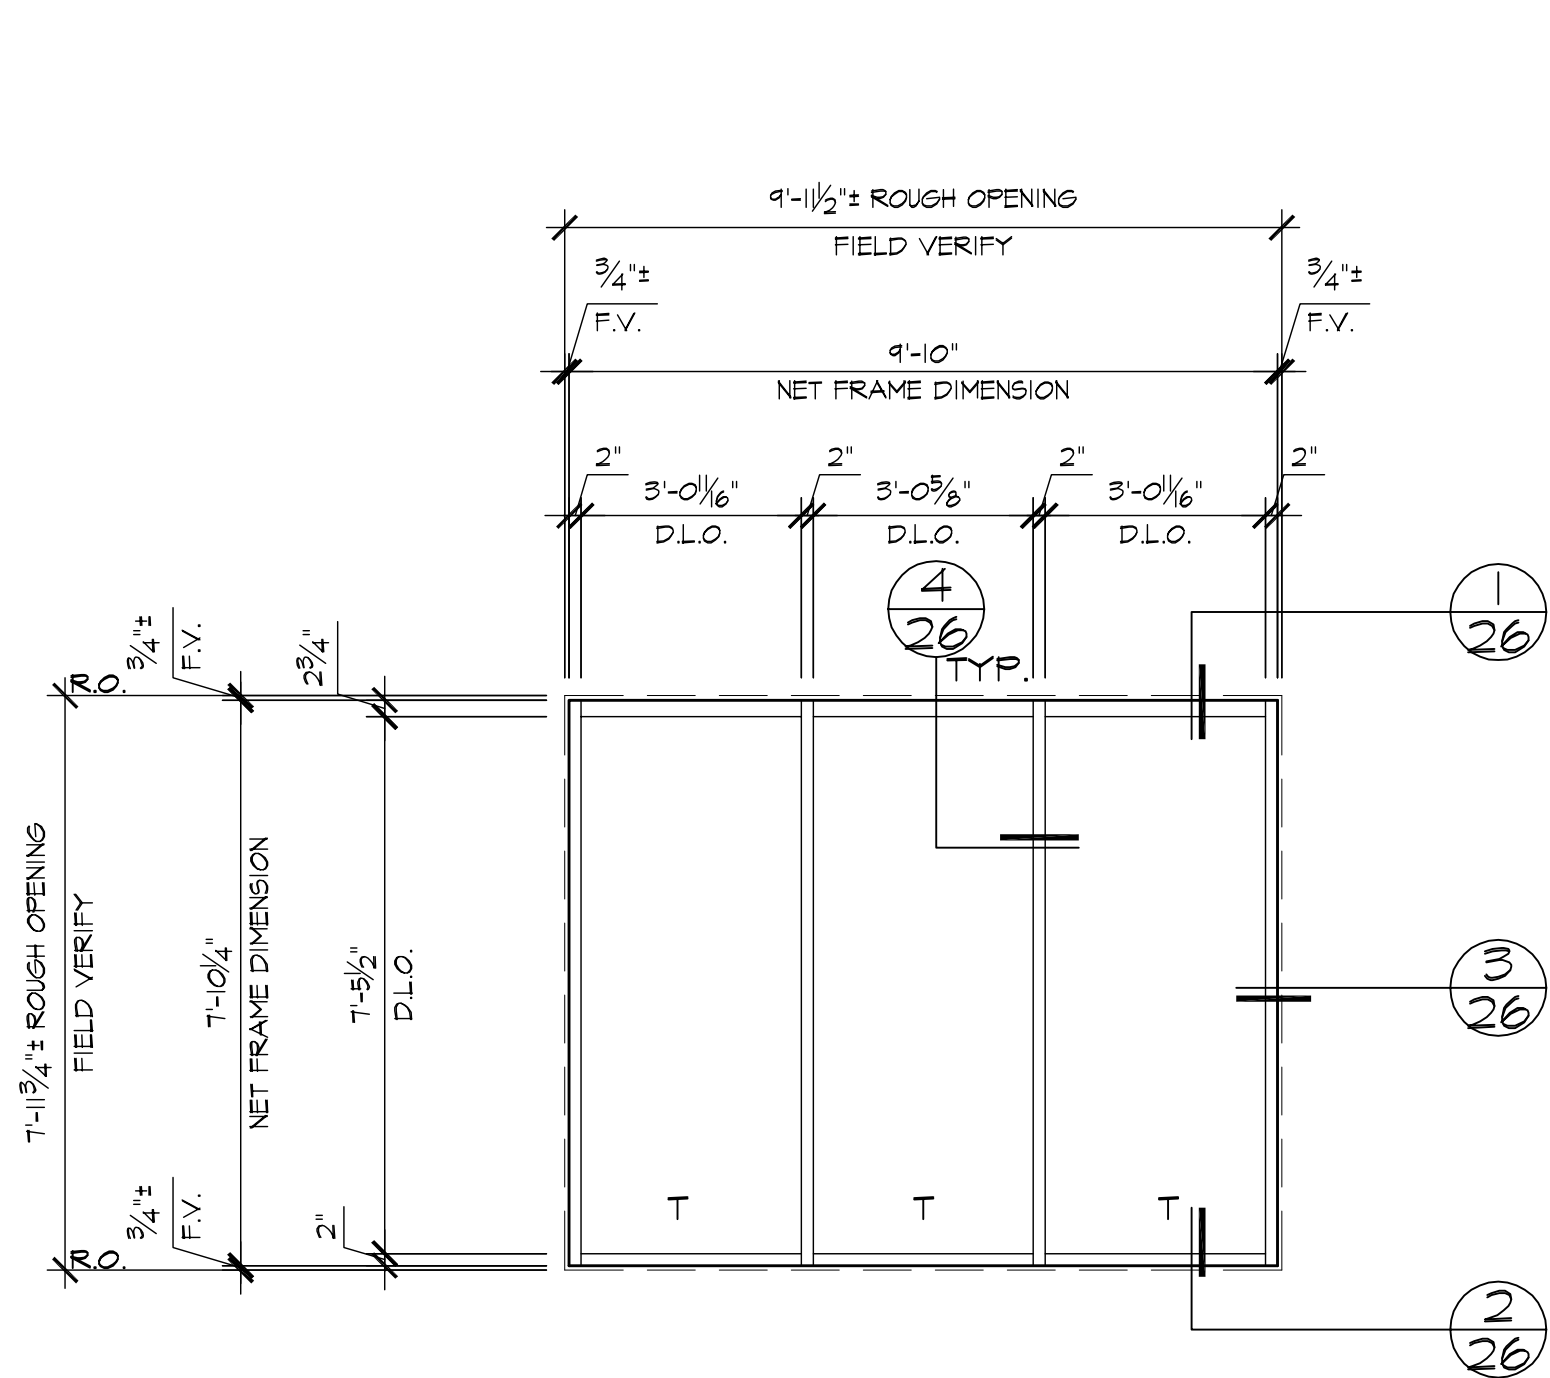


A ELEVATION (2" X 4 1/2" OFFSET GLAZED SYSTEM)
21 LOCATION

AREA A 3rd. FLR. ~ 4 REQ'D (WEST)
AREA A 3rd. FLR. ~ 1 REQ'D (EAST)
AREA A 4th. FLR. ~ 5 REQ'D (WEST)
AREA A 4th. FLR. ~ 1 REQ'D (EAST)
AREA A 5th. FLR. ~ 5 REQ'D (WEST)
AREA A 5th. FLR. ~ 1 REQ'D (EAST)
AREA A 6th. FLR. ~ 5 REQ'D (WEST)
AREA A 6th. FLR. ~ 1 REQ'D (EAST)
AREA A 7th. FLR. ~ 5 REQ'D (WEST)
AREA A 7th. FLR. ~ 1 REQ'D (EAST)
AREA A 8th. FLR. ~ 5 REQ'D (WEST)
AREA A 8th. FLR. ~ 1 REQ'D (EAST)
AREA A 9th. FLR. ~ 2 REQ'D (WEST)
AREA A 9th. FLR. ~ 2 REQ'D (EAST)
AREA A 10th. FLR. ~ 2 REQ'D (WEST)
AREA A 10th. FLR. ~ 2 REQ'D (EAST)
AREA A 11th. FLR. ~ 2 REQ'D (WEST)
AREA A 11th. FLR. ~ 2 REQ'D (EAST)
AREA B 3rd. FLR. ~ 8 REQ'D (WEST)
AREA B 3rd. FLR. ~ 1 REQ'D (EAST)
AREA B 4th. FLR. ~ 7 REQ'D (WEST)
AREA B 4th. FLR. ~ 1 REQ'D (EAST)
AREA B 5th. FLR. ~ 7 REQ'D (WEST)
AREA B 5th. FLR. ~ 1 REQ'D (EAST)
AREA B 6th. FLR. ~ 7 REQ'D (WEST)
AREA B 6th. FLR. ~ 1 REQ'D (EAST)
AREA B 7th. FLR. ~ 7 REQ'D (WEST)
AREA B 7th. FLR. ~ 1 REQ'D (EAST)
AREA B 8th. FLR. ~ 7 REQ'D (WEST)
AREA B 8th. FLR. ~ 1 REQ'D (EAST)
AREA B 9th. FLR. ~ 4 REQ'D (WEST)
AREA B 9th. FLR. ~ 2 REQ'D (EAST)
AREA B 10th. FLR. ~ 4 REQ'D (WEST)
AREA B 10th. FLR. ~ 2 REQ'D (EAST)
AREA B 11th. FLR. ~ 4 REQ'D (WEST)
AREA B 11th. FLR. ~ 2 REQ'D (EAST)
AREA B 12th. FLR. ~ 2 REQ'D (EAST)
AREA B 13th. FLR. ~ 2 REQ'D (EAST)
AREA B 14th. FLR. ~ 2 REQ'D (EAST)

B ELEVATION (2" X 4 1/2" OFFSET GLAZED SYSTEM)
21 LOCATION


AREA A 4th. FLR. ~ 1 REQ'D (EAST)
AREA A 4th. FLR. ~ 1 REQ'D/OFF. (WEST)
AREA A 5th. FLR. ~ 1 REQ'D (EAST)
AREA A 5th. FLR. ~ 1 REQ'D/OFF. (WEST)
AREA A 6th. FLR. ~ 1 REQ'D (EAST)
AREA A 6th. FLR. ~ 1 REQ'D/OFF. (WEST)
AREA A 7th. FLR. ~ 1 REQ'D (EAST)
AREA A 7th. FLR. ~ 1 REQ'D/OFF. (WEST)
AREA A 8th. FLR. ~ 1 REQ'D (EAST)
AREA A 8th. FLR. ~ 1 REQ'D/OFF. (WEST)
AREA B 4th. FLR. ~ 1 REQ'D (WEST)
AREA B 5th. FLR. ~ 1 REQ'D (EAST)
AREA B 5th. FLR. ~ 1 REQ'D (WEST)
AREA B 6th. FLR. ~ 1 REQ'D/OFF. (EAST)
AREA B 6th. FLR. ~ 1 REQ'D (WEST)
AREA B 7th. FLR. ~ 1 REQ'D/OFF. (EAST)
AREA B 7th. FLR. ~ 1 REQ'D (WEST)
AREA B 8th. FLR. ~ 1 REQ'D/OFF. (EAST)
AREA B 8th. FLR. ~ 1 REQ'D (WEST)

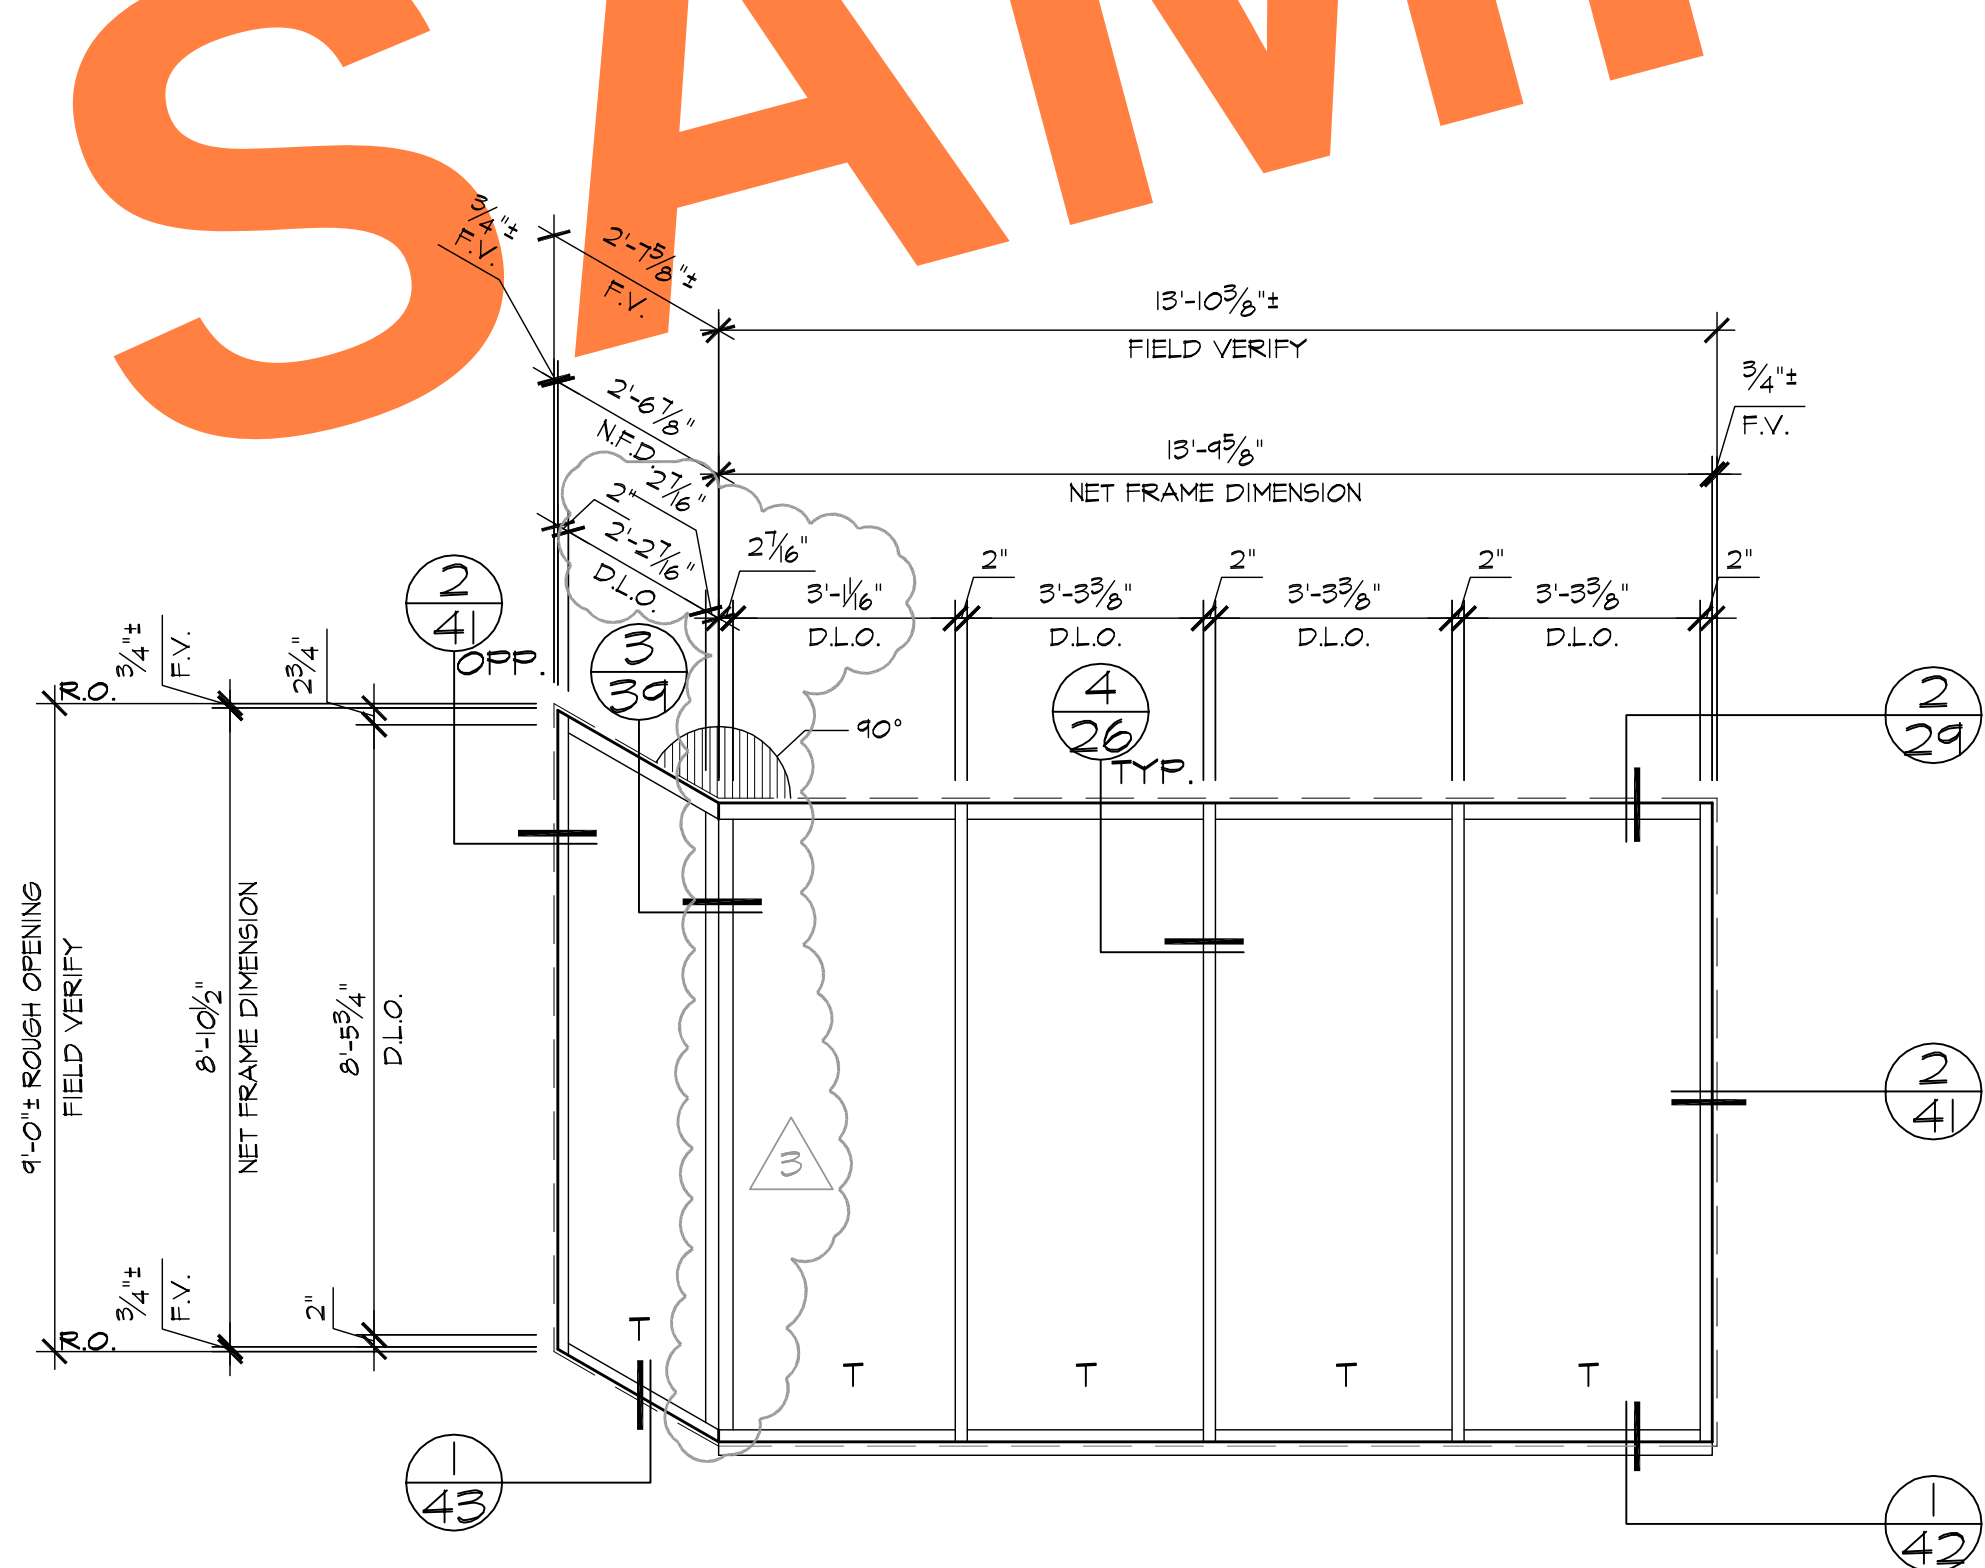

D ELEVATION (2" X 4 1/2" OFFSET GLAZED SYSTEM)
21 LOCATION
AREA A 3rd. FLR. ~ 1 REQ'D (EAST)
AREA B 3rd. FLR. ~ 1 REQ'D/OFF. (EAST)

C ELEVATION (2" X 4 1/2" OFFSET GLAZED SYSTEM)
21 LOCATION

AREA B 4th. FLR. ~ 1 REQ'D (WEST)
AREA B 4th. FLR. ~ 1 REQ'D/OFF. (WEST)
AREA B 4th. FLR. ~ 1 REQ'D (EAST)
AREA B 4th. FLR. ~ 1 REQ'D/OFF. (EAST)
AREA B 5th. FLR. ~ 1 REQ'D (WEST)
AREA B 5th. FLR. ~ 1 REQ'D/OFF. (WEST)
AREA B 5th. FLR. ~ 1 REQ'D (EAST)
AREA B 5th. FLR. ~ 1 REQ'D/OFF. (EAST)
AREA B 6th. FLR. ~ 1 REQ'D (WEST)
AREA B 6th. FLR. ~ 1 REQ'D/OFF. (WEST)
AREA B 6th. FLR. ~ 1 REQ'D (EAST)
AREA B 6th. FLR. ~ 1 REQ'D/OFF. (EAST)
AREA B 7th. FLR. ~ 1 REQ'D (WEST)
AREA B 7th. FLR. ~ 1 REQ'D/OFF. (WEST)
AREA B 7th. FLR. ~ 1 REQ'D (EAST)
AREA B 7th. FLR. ~ 1 REQ'D/OFF. (EAST)
AREA B 8th. FLR. ~ 1 REQ'D (WEST)
AREA B 8th. FLR. ~ 1 REQ'D/OFF. (WEST)
AREA B 8th. FLR. ~ 1 REQ'D (EAST)
AREA B 8th. FLR. ~ 1 REQ'D/OFF. (EAST)
AREA B 9th. FLR. ~ 1 REQ'D (WEST)
AREA B 9th. FLR. ~ 1 REQ'D/OFF. (WEST)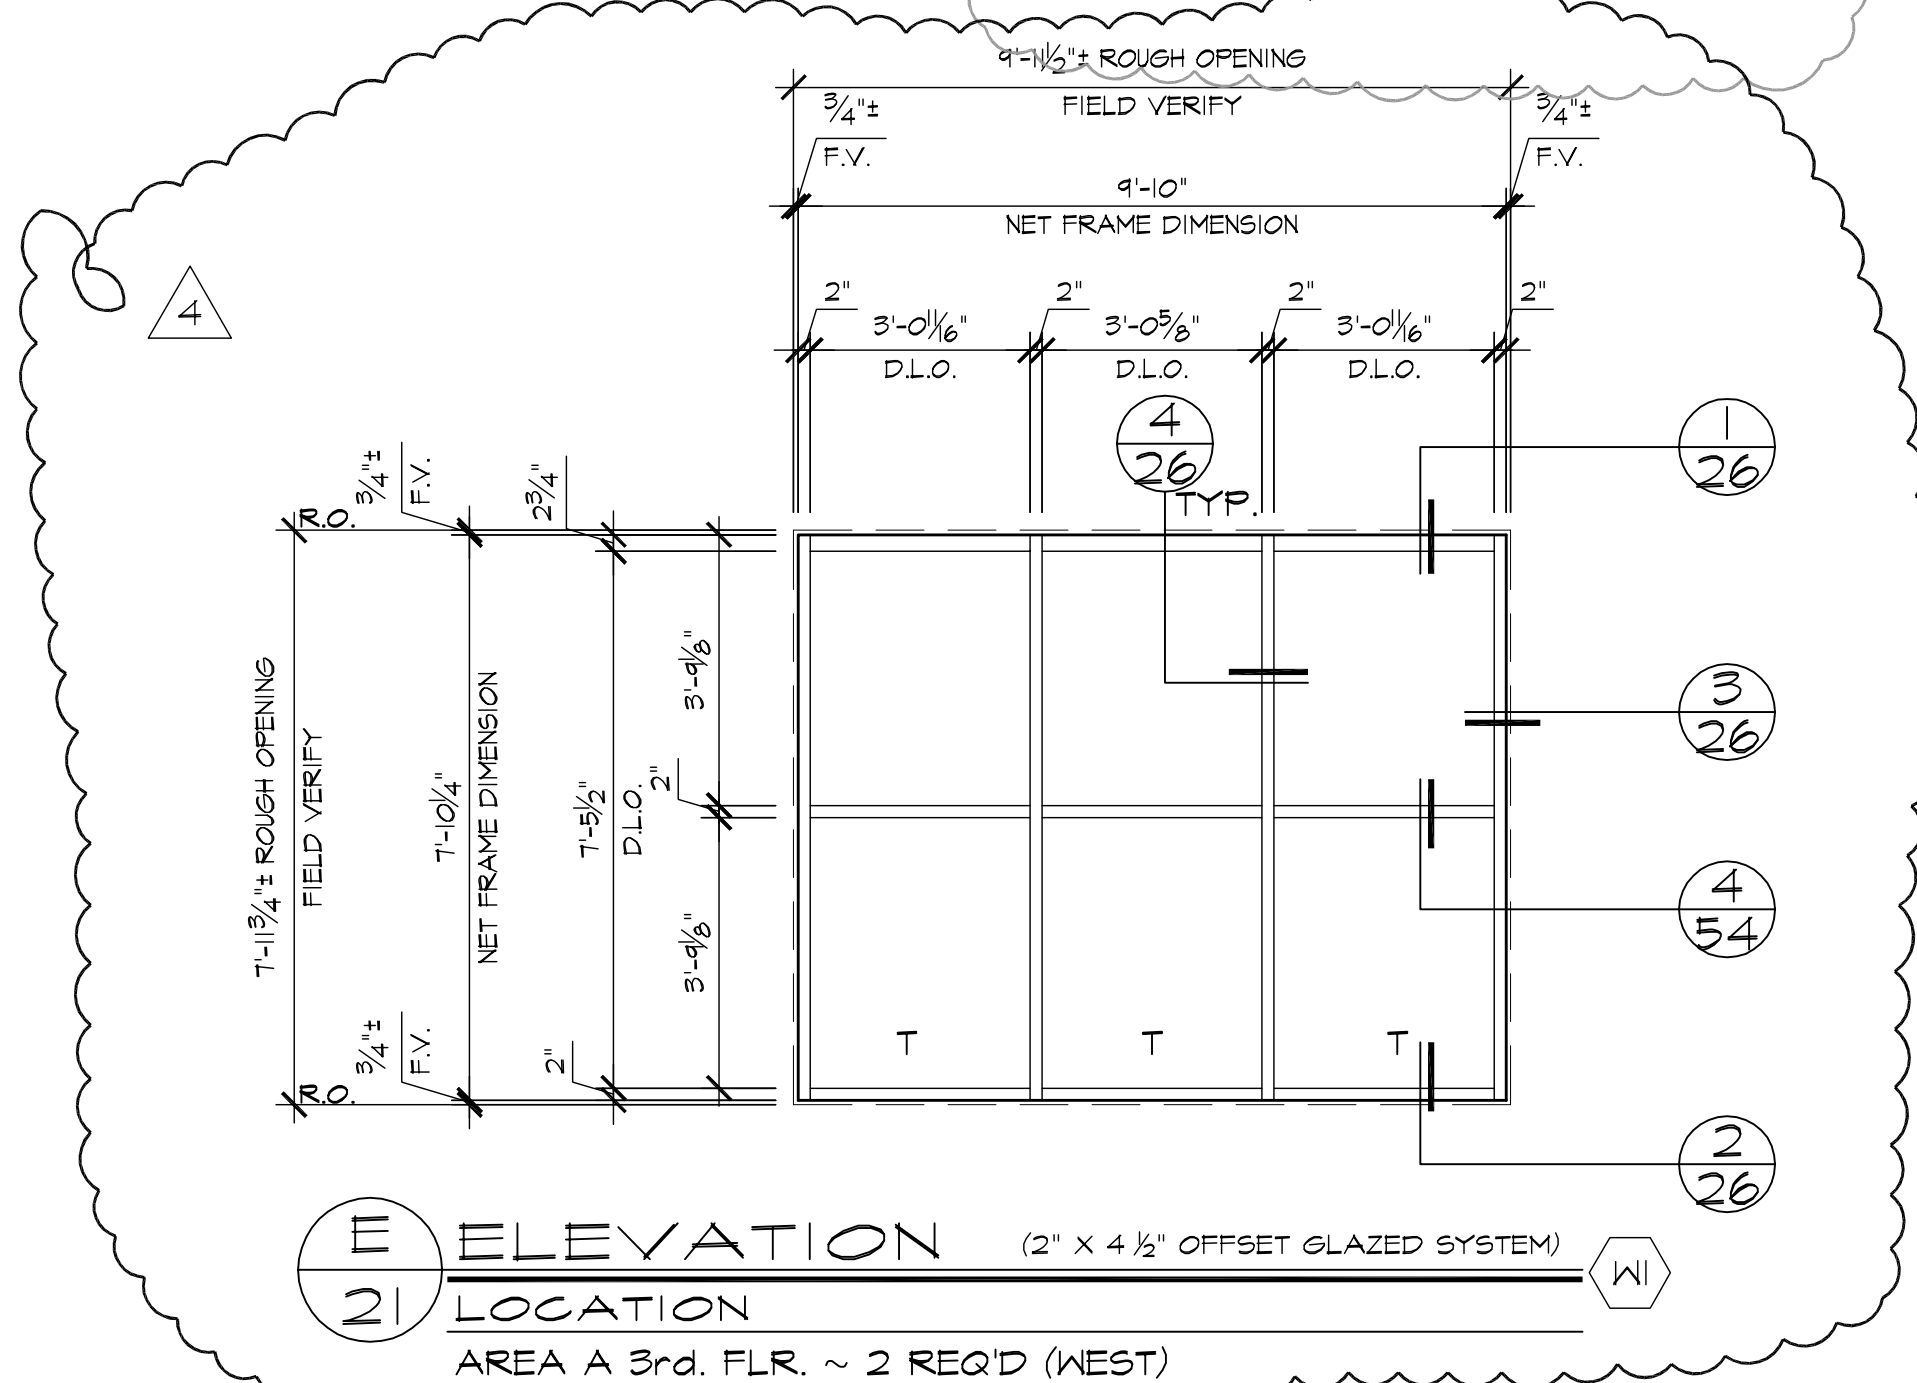
E ELEVATION (2" X 4 1/2" OFFSET GLAZED SYSTEM)
21 LOCATION
AREA A 3rd. FLR. ~ 2 REQ'D (WEST)


REVISIONS	BY
4-23-07	BMR
6-11-07	BMR
12-17-07	CTB
3/6/08	CTB

BMR
DRAFTING SERVICE
SINCE 1988
23846 SUNNYMEAD BLVD.
SUITE 80
MORENO VALLEY, CA 92553
B: (951) 243-7814
F: (951) 243-7873


GLASS FACTORY
26383 BASE LINE
HIGHLAND, CA 92346

AS-BUILT DRAWINGS

JOB NAME:	AGUA CALIENTE HOTEL ADDITION
ARCHITECT:	VOA
SHEET DESCRIPTION:	ELEVATIONS
DATE:	1/3/07
SCALE:	3/8"=1'-0"
DRAWN:	CTB
JOB NO:	100-06
SHEET NO:	21

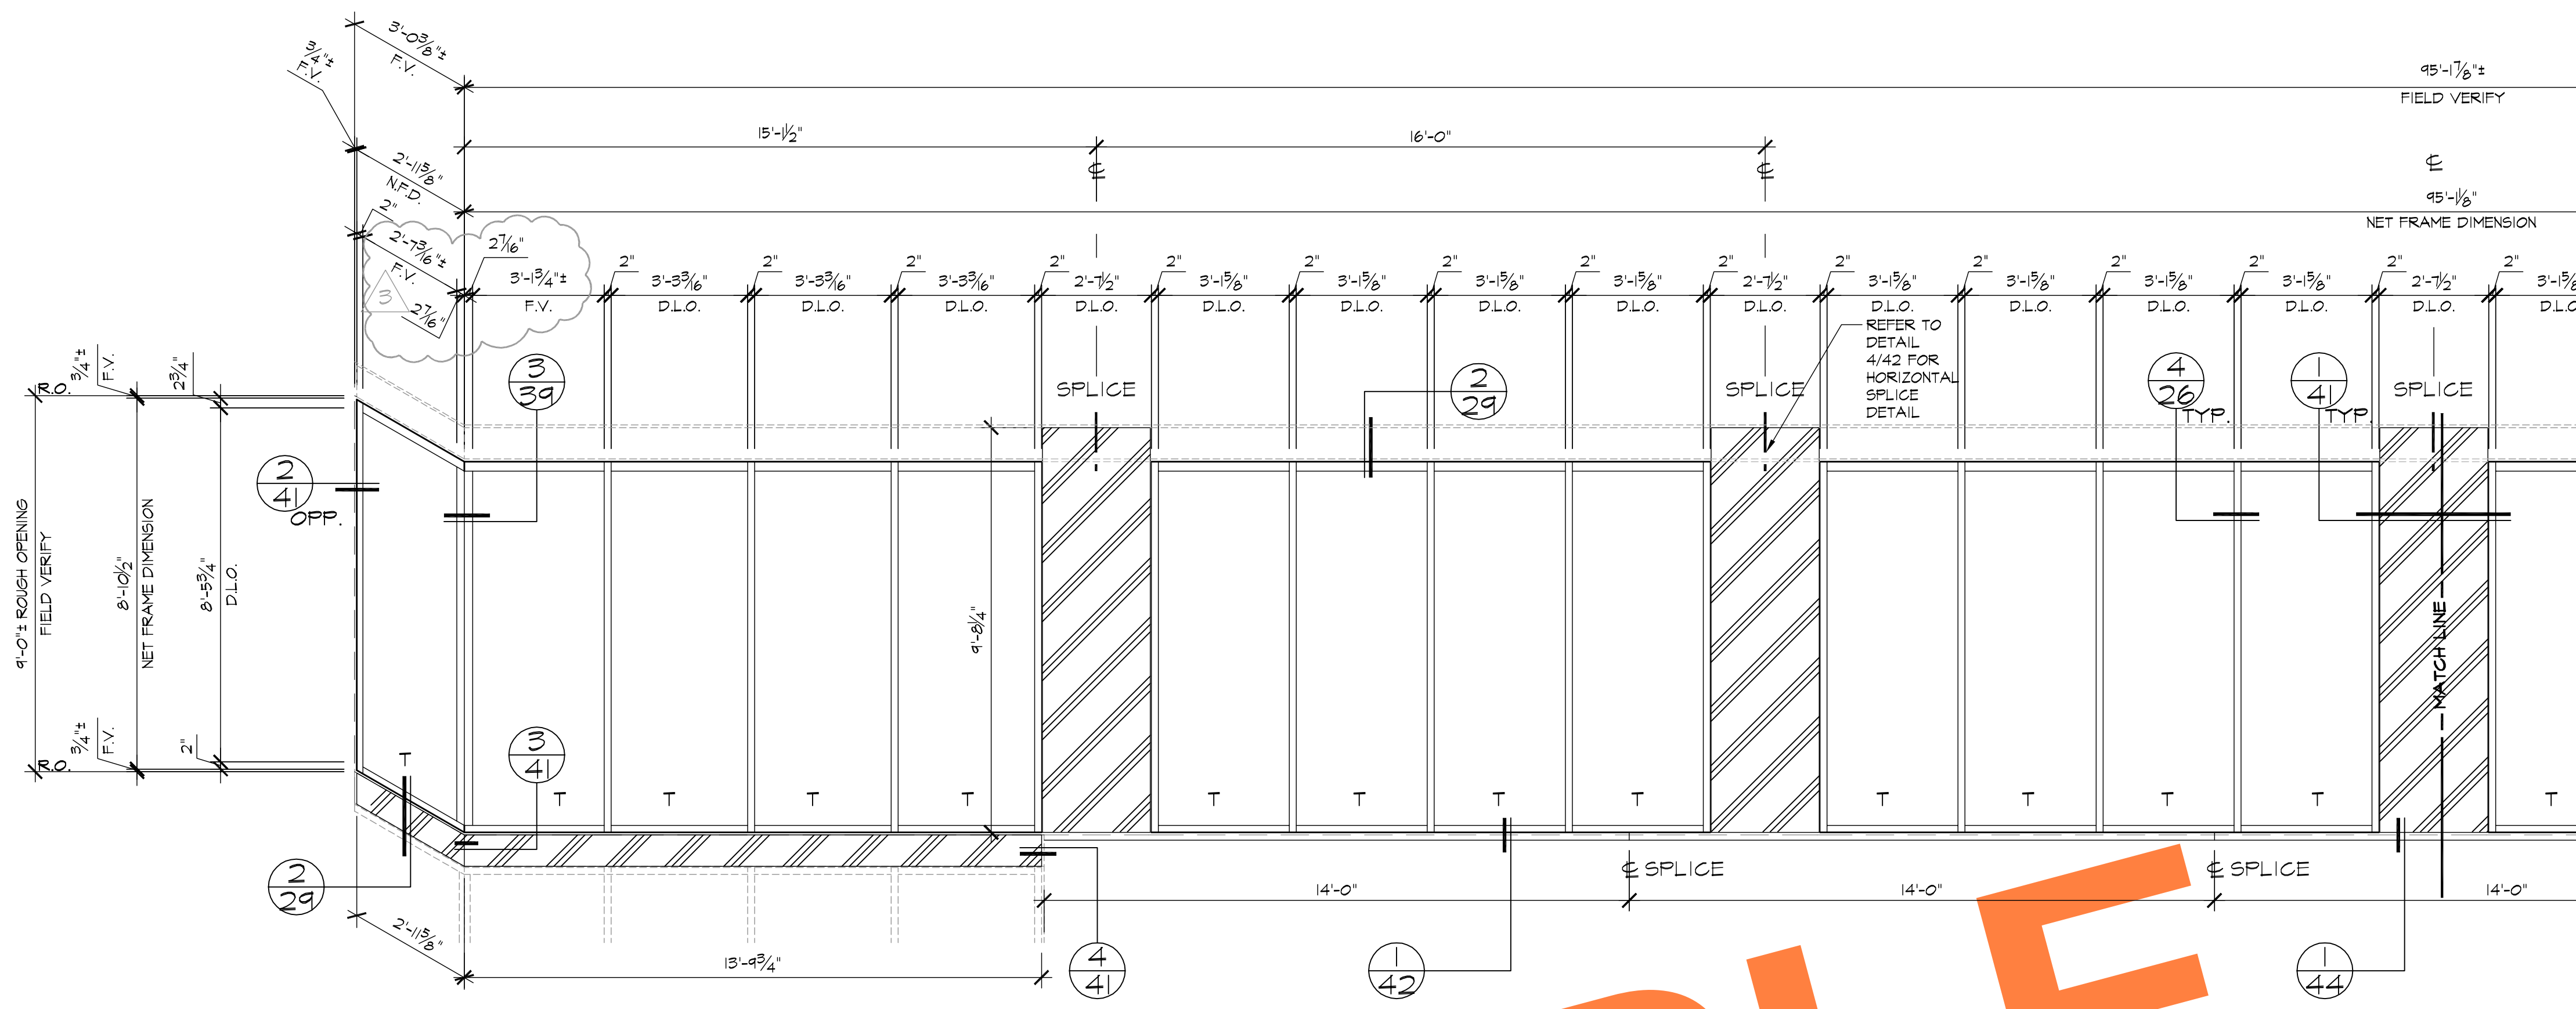

A ELEVATION
21.1 LOCATION
(2" X 4 1/2" OFFSET GLAZED SYSTEM) W3 W6
AREA A 9th. FLR. ~ 1 REQ'D (EAST) AREA B 9th. FLR. ~ 1 REQ'D/OPP. (EAST)

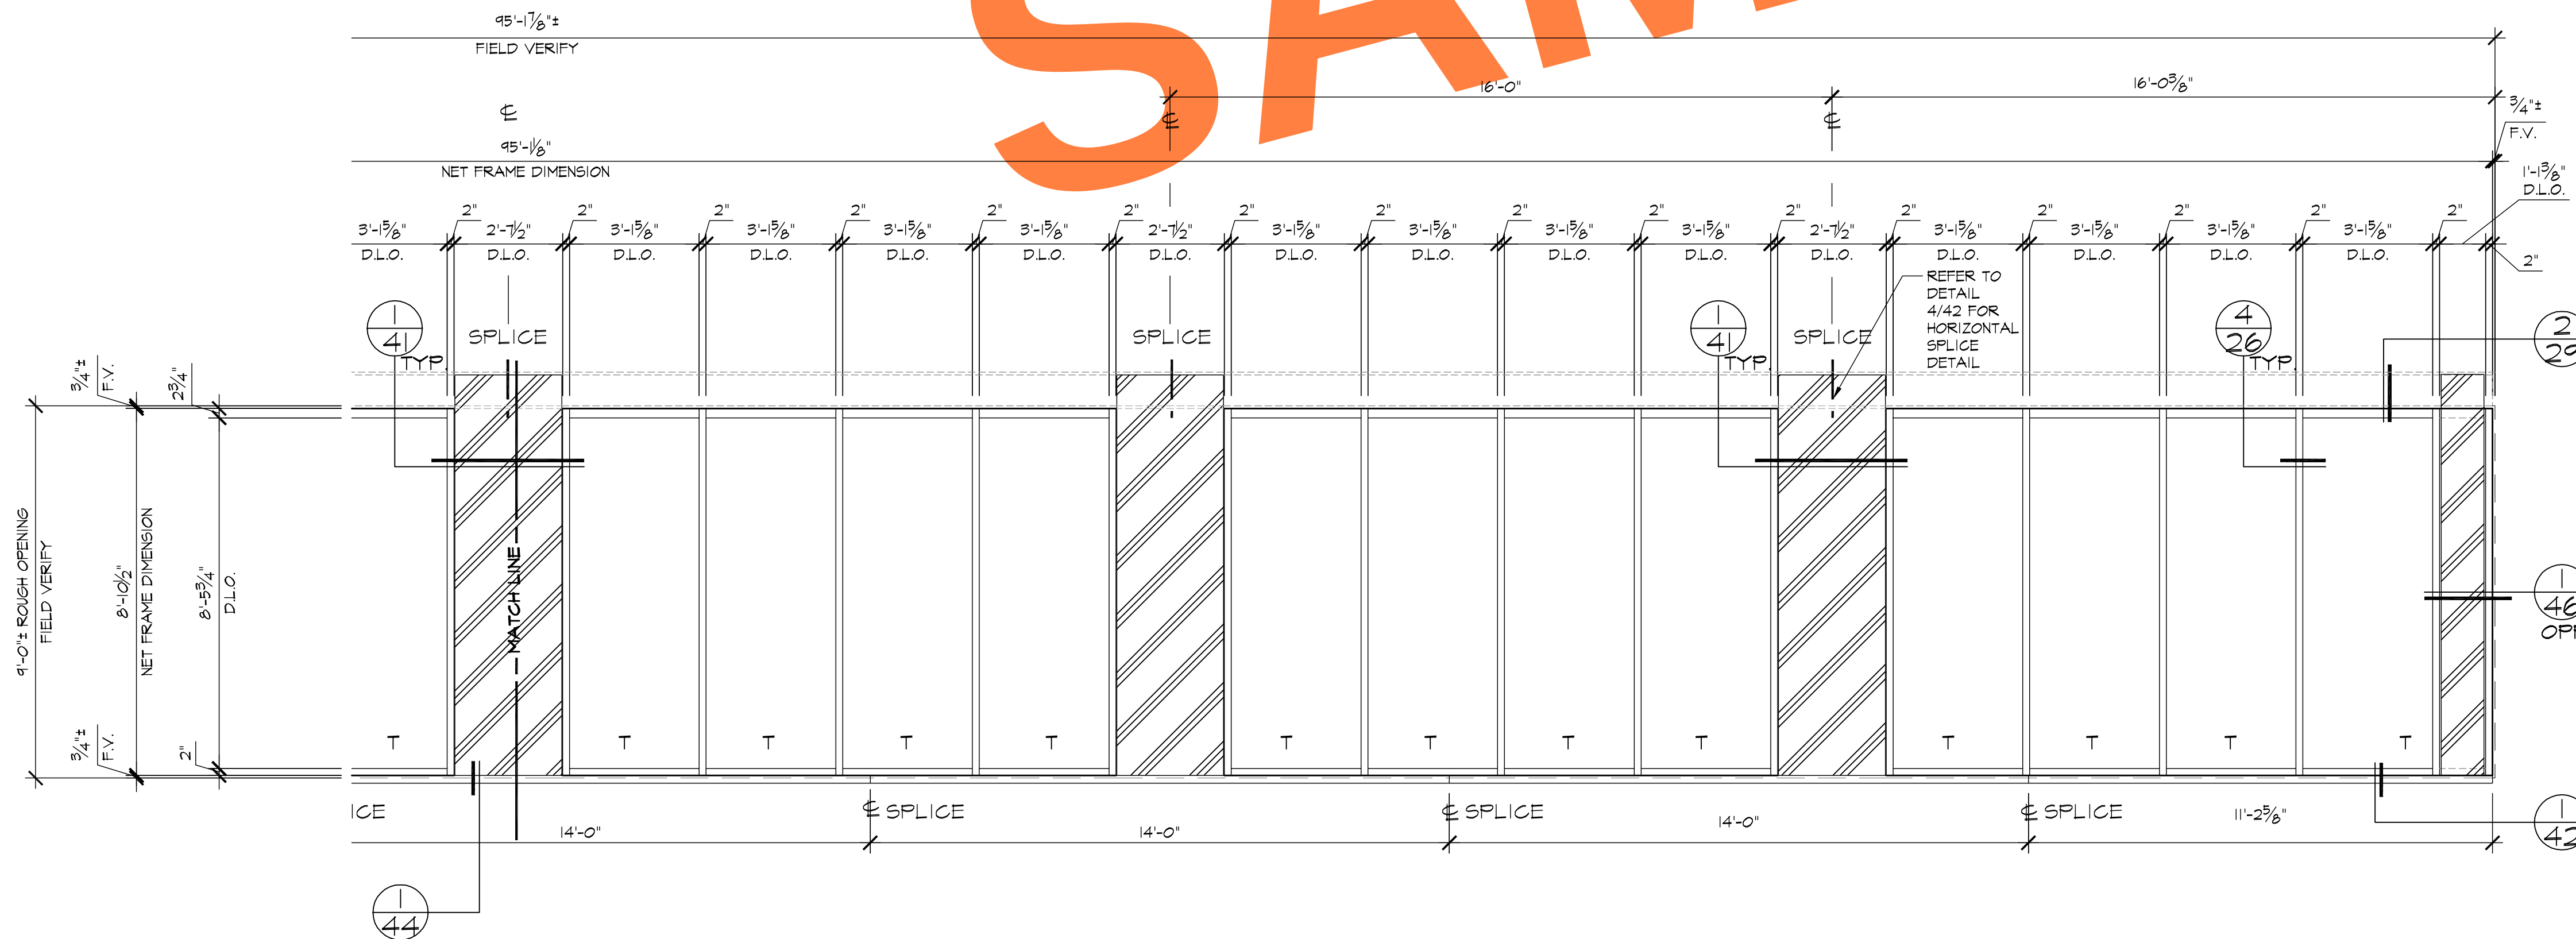

B ELEVATION
21.1 LOCATION
(2" X 4 1/2" OFFSET GLAZED SYSTEM) W3 W6
AREA A 9th. FLR. ~ 1 REQ'D (EAST) AREA B 9th. FLR. ~ 1 REQ'D/OPP. (EAST)

REVISIONS	BY
△ 4-23-07	BMR
△ 6-11-07	BMR
△ 12-17-07	CTB
△ 3/6/08	CTB
△	



GLASS FACTORY
26383 BASE LINE
HIGHLAND, CA 92346

AS-BUILT DRAWINGS

JOB NAME:	AGUA CALIENTE HOTEL ADDITION
ARCHITECT:	VOA
SHEET DESCRIPTION:	ELEVATIONS
DATE:	1/3/07
SCALE:	3/8"=1'-0"
DRAWN:	CTB
JOB NO:	100-06
SHEET NO:	21.1


REVISIONS	BY
△ 4-23-07	BMR
△ 6-11-07	BMR
△ 12-17-07	CTB
△ 3/6/08	CTB
△	




GLASS FACORY
26383 BASE LINE
HIGHLAND, CA 92346

AS-BUILT DRAWINGS


JOB NAME:	AGUA CALIENTE HOTEL ADDITION
ARCHITECT:	VOA
SHEET DESCRIPTION:	ELEVATIONS
DATE:	1/3/07
SCALE:	3/8"=1'-0"
DRAWN:	CTB
JOB NO:	100-06
SHEET NO:	21.3

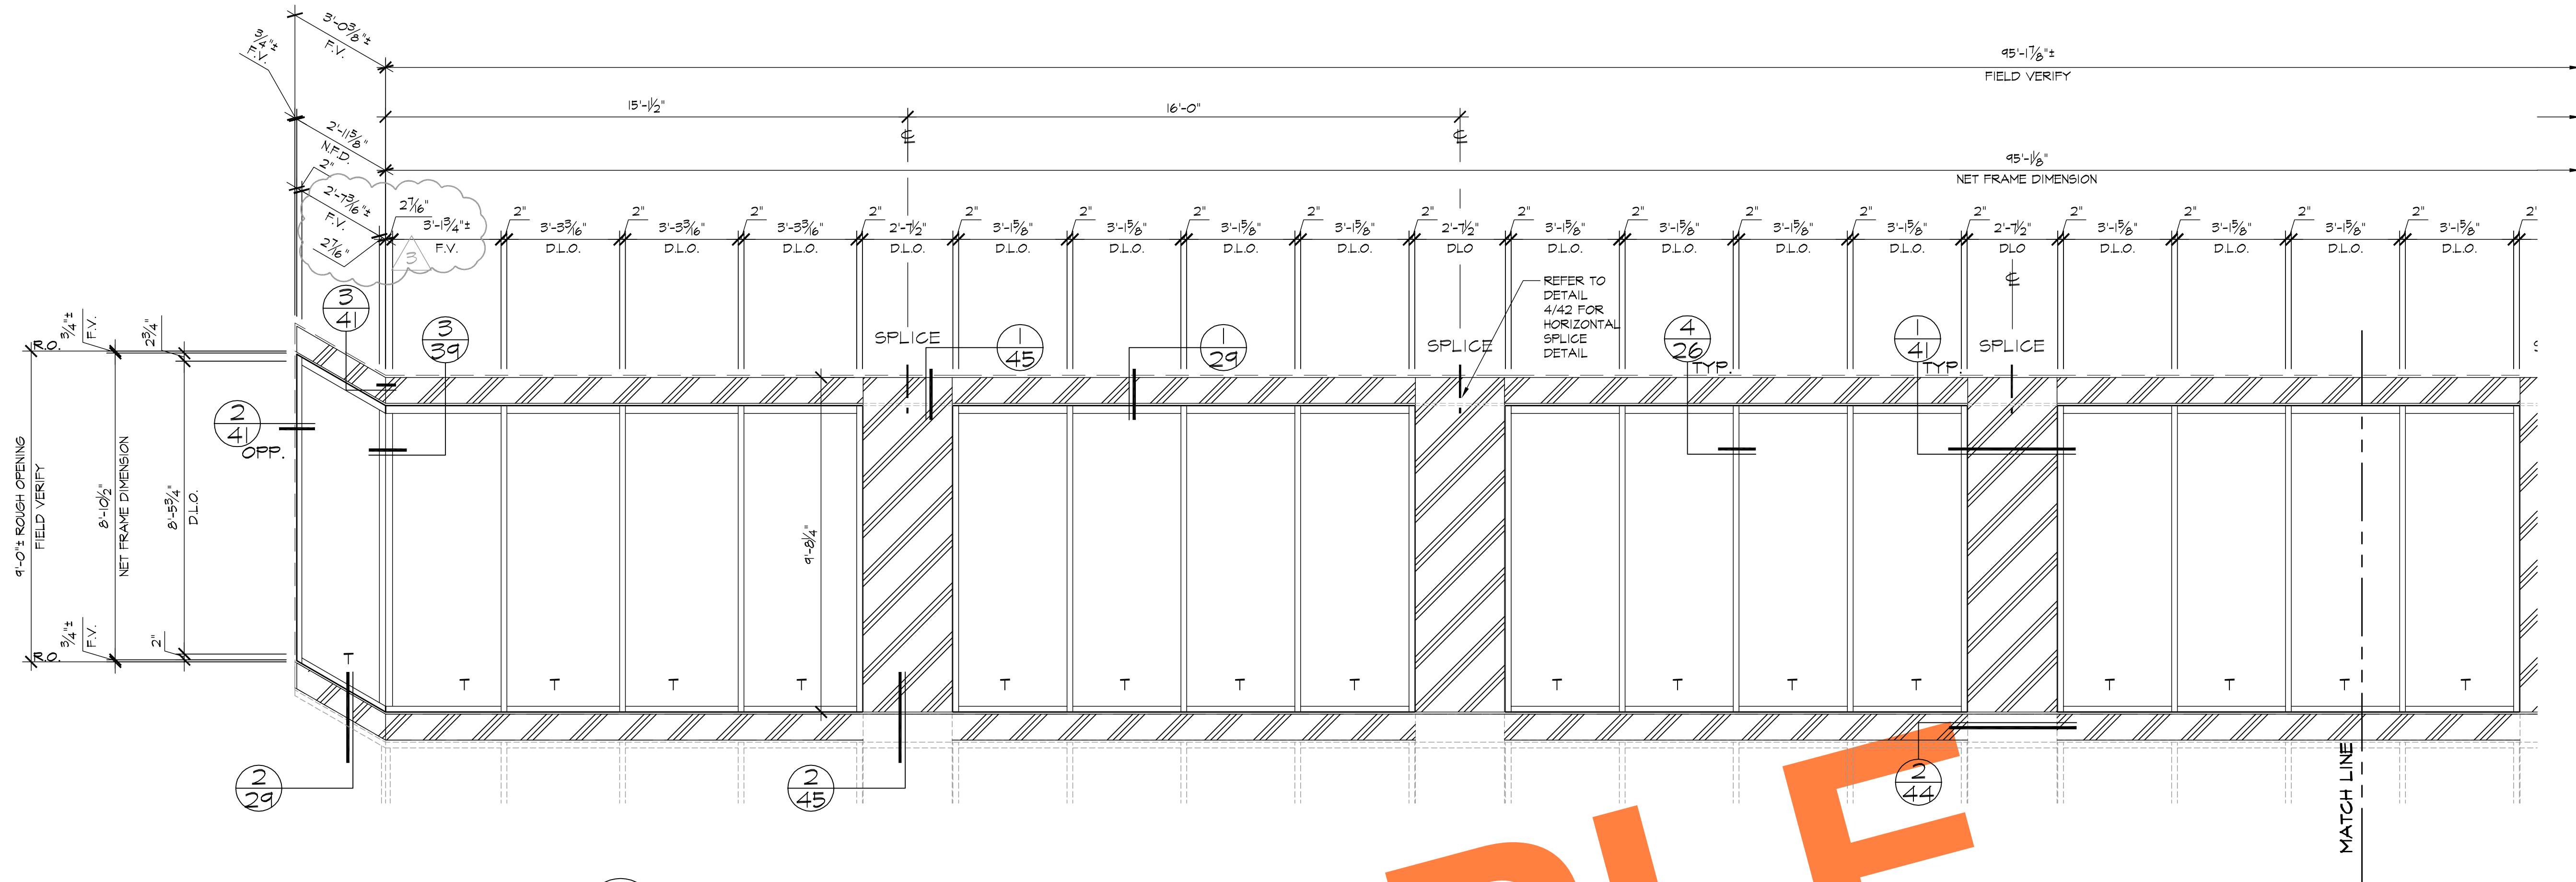

A ELEVATION
21.3 LOCATION
(2" X 4 1/2" OFFSET GLAZED SYSTEM) W3 W6
AREA A 11th. FLR. ~ I REQ'D (EAST) AREA B 11th. FLR. ~ I REQ'D/OPP. (EAST)

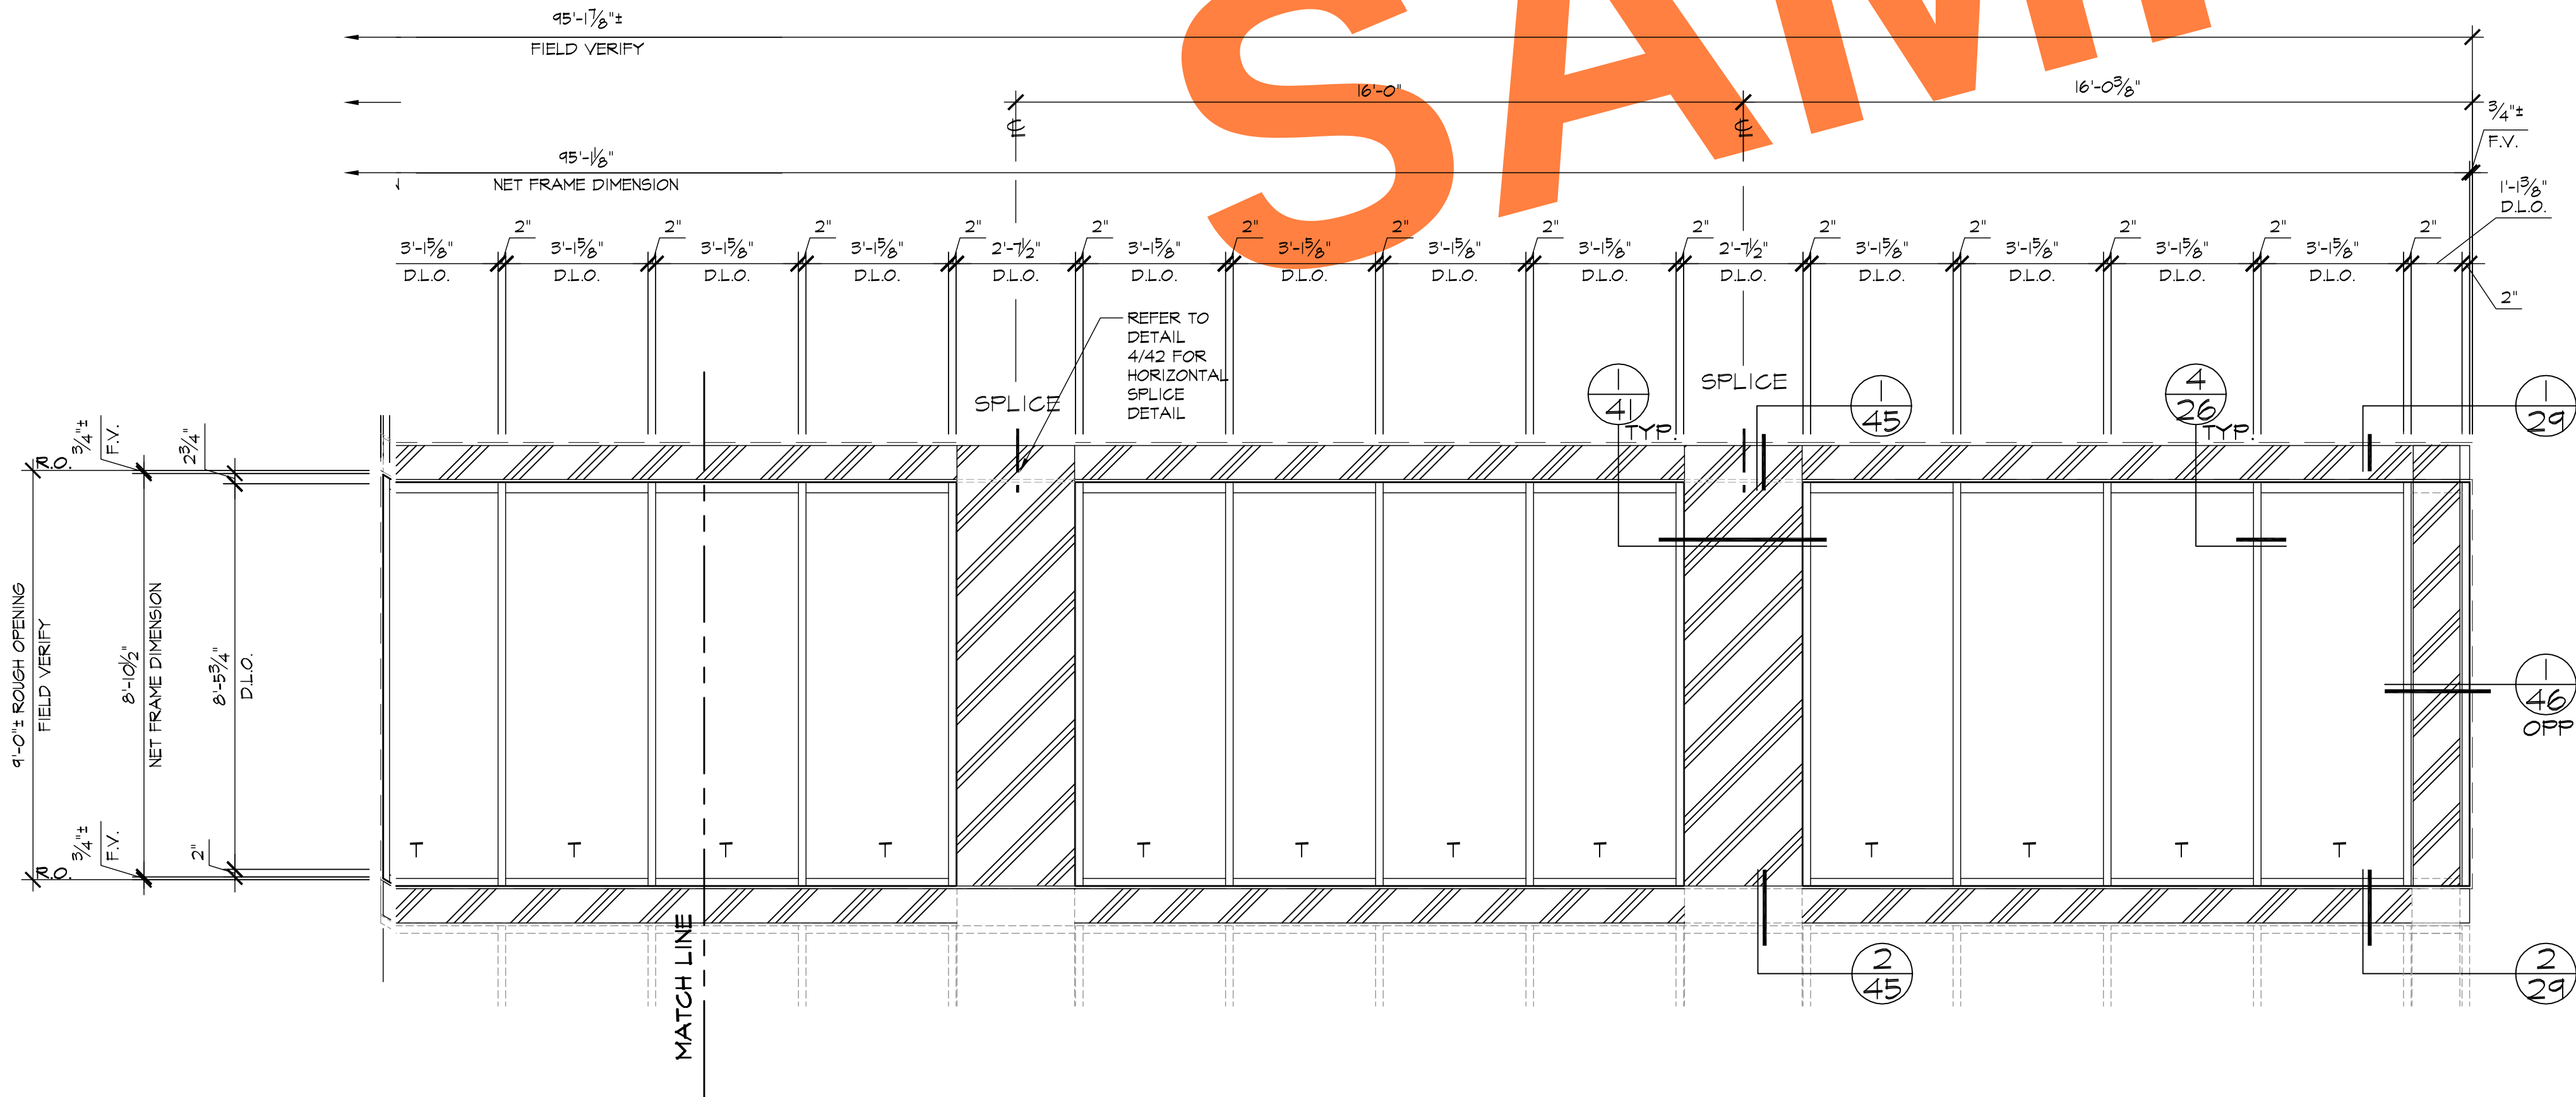


B ELEVATION
21.3 LOCATION
(2" X 4 1/2" OFFSET GLAZED SYSTEM) W3 W6
AREA A 11th. FLR. ~ I REQ'D (EAST) AREA B 11th. FLR. ~ I REQ'D/OPP. (EAST)

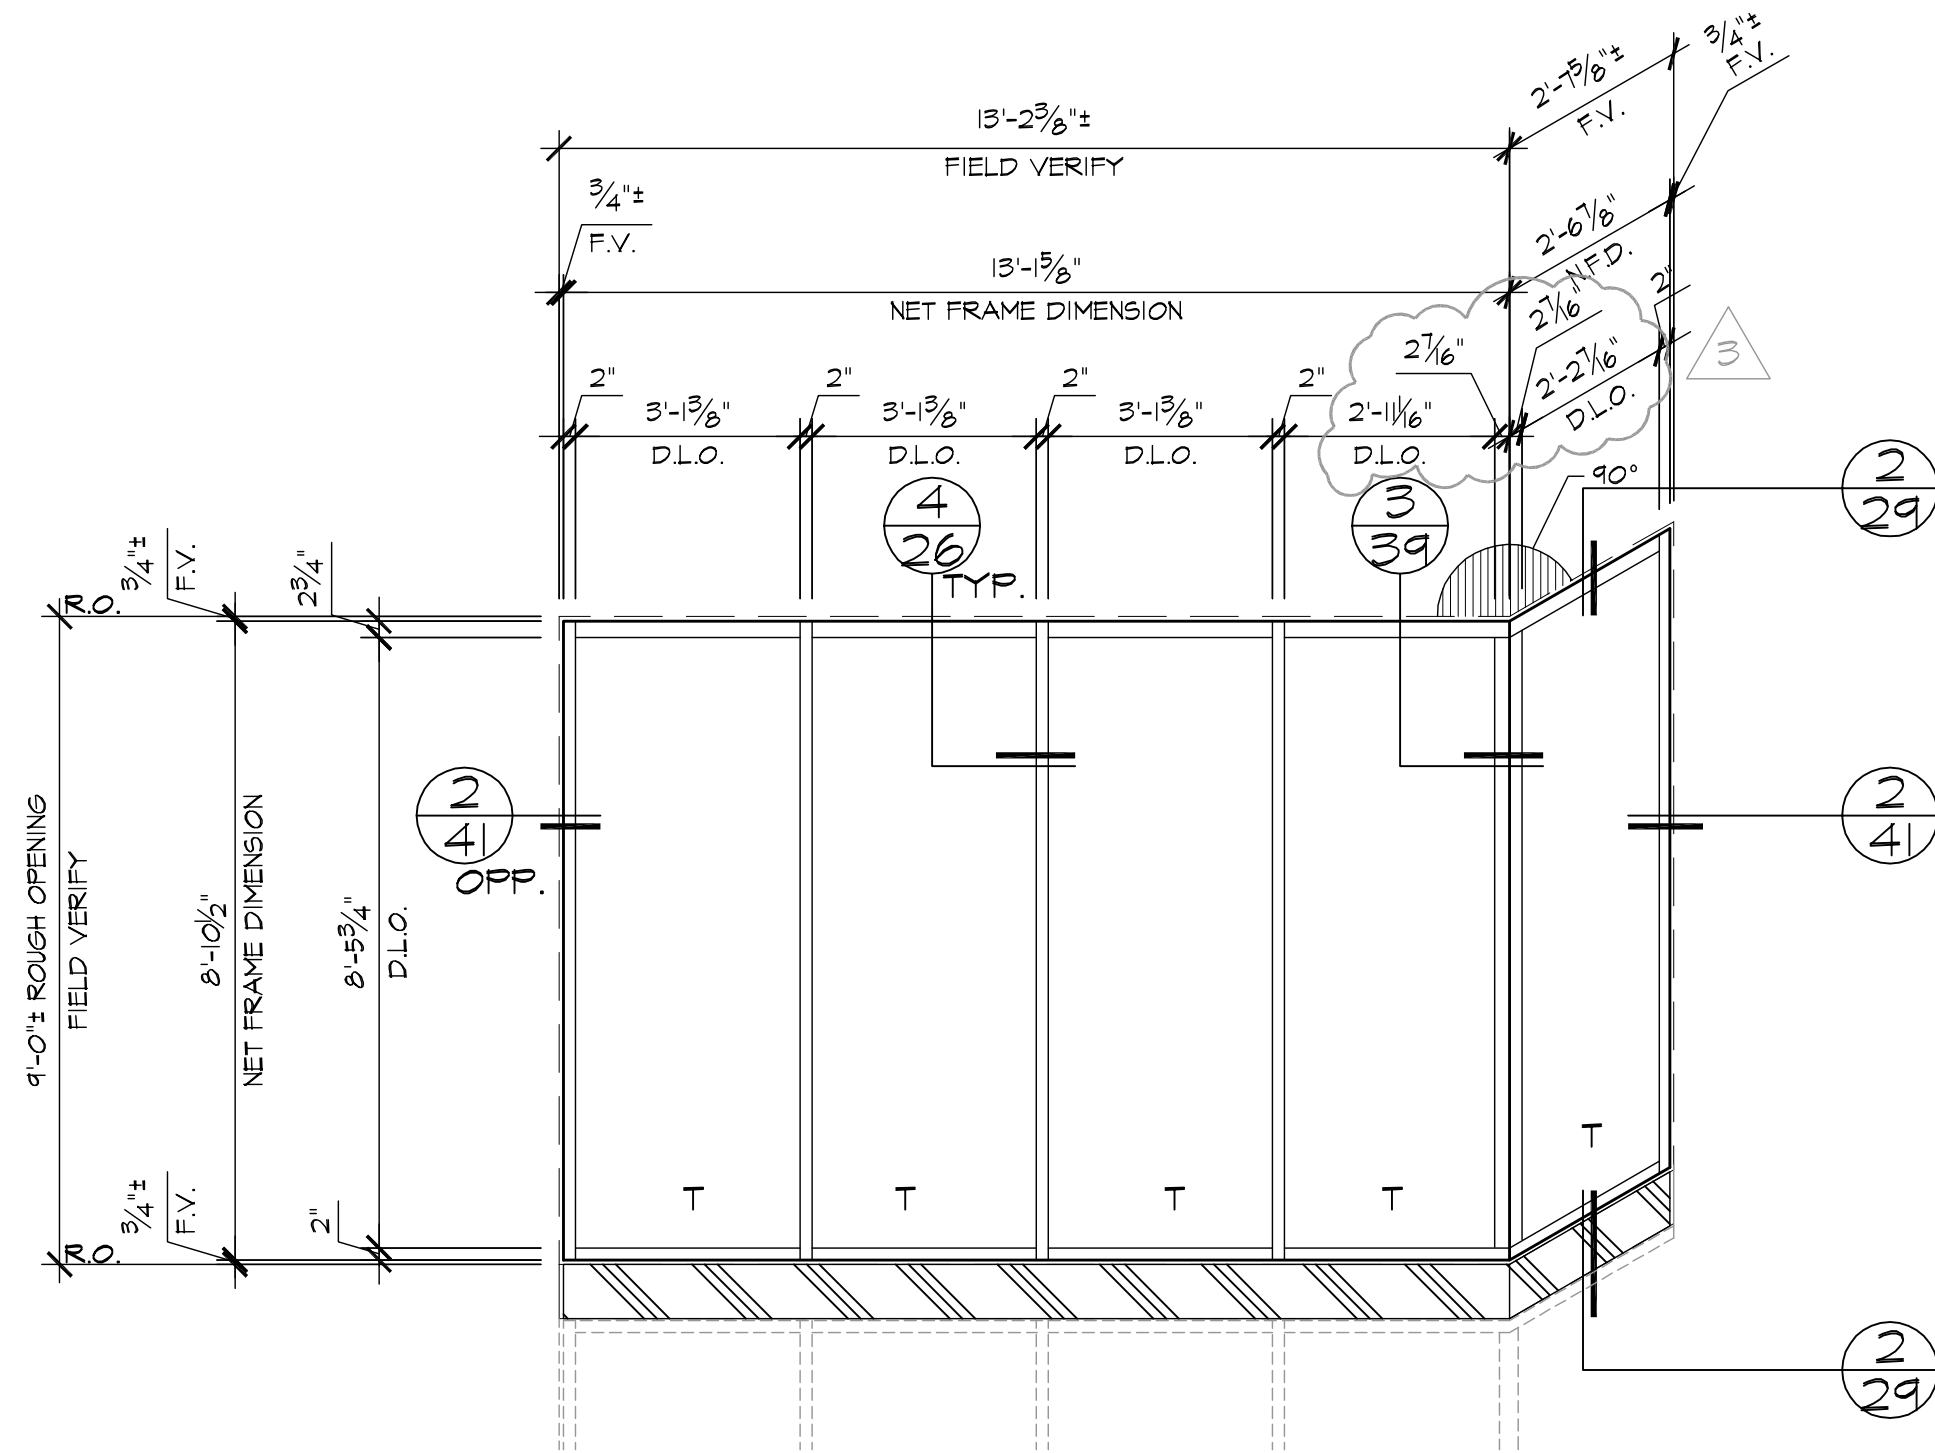

A ELEVATION (2" X 4 1/2" OFFSET GLAZED SYSTEM) (WT)

22 LOCATION


AREA B 4th. FLR. ~ REQ'D (WEST)	AREA B 10th. FLR. ~ REQ'D (WEST)
AREA B 4th. FLR. ~ REQ'D/OPP (WEST)	AREA B 10th. FLR. ~ REQ'D/OPP (WEST)
AREA B 5th. FLR. ~ REQ'D (WEST)	AREA B 11th. FLR. ~ REQ'D (WEST)
AREA B 5th. FLR. ~ REQ'D/OPP (WEST)	AREA B 11th. FLR. ~ REQ'D/OPP (WEST)
AREA B 6th. FLR. ~ REQ'D (WEST)	AREA B 12th. FLR. ~ REQ'D (WEST)
AREA B 6th. FLR. ~ REQ'D/OPP (WEST)	AREA B 12th. FLR. ~ REQ'D/OPP (WEST)
AREA B 7th. FLR. ~ REQ'D (WEST)	AREA B 13th. FLR. ~ REQ'D (WEST)
AREA B 7th. FLR. ~ REQ'D/OPP (WEST)	AREA B 13th. FLR. ~ REQ'D/OPP (WEST)
AREA B 8th. FLR. ~ REQ'D (WEST)	AREA B 14th. FLR. ~ REQ'D (WEST)
AREA B 8th. FLR. ~ REQ'D/OPP (WEST)	AREA B 14th. FLR. ~ REQ'D/OPP (WEST)
AREA B 9th. FLR. ~ REQ'D (WEST)	AREA B 15th. FLR. ~ REQ'D (WEST)
AREA B 9th. FLR. ~ REQ'D/OPP (WEST)	AREA B 15th. FLR. ~ REQ'D/OPP (WEST)

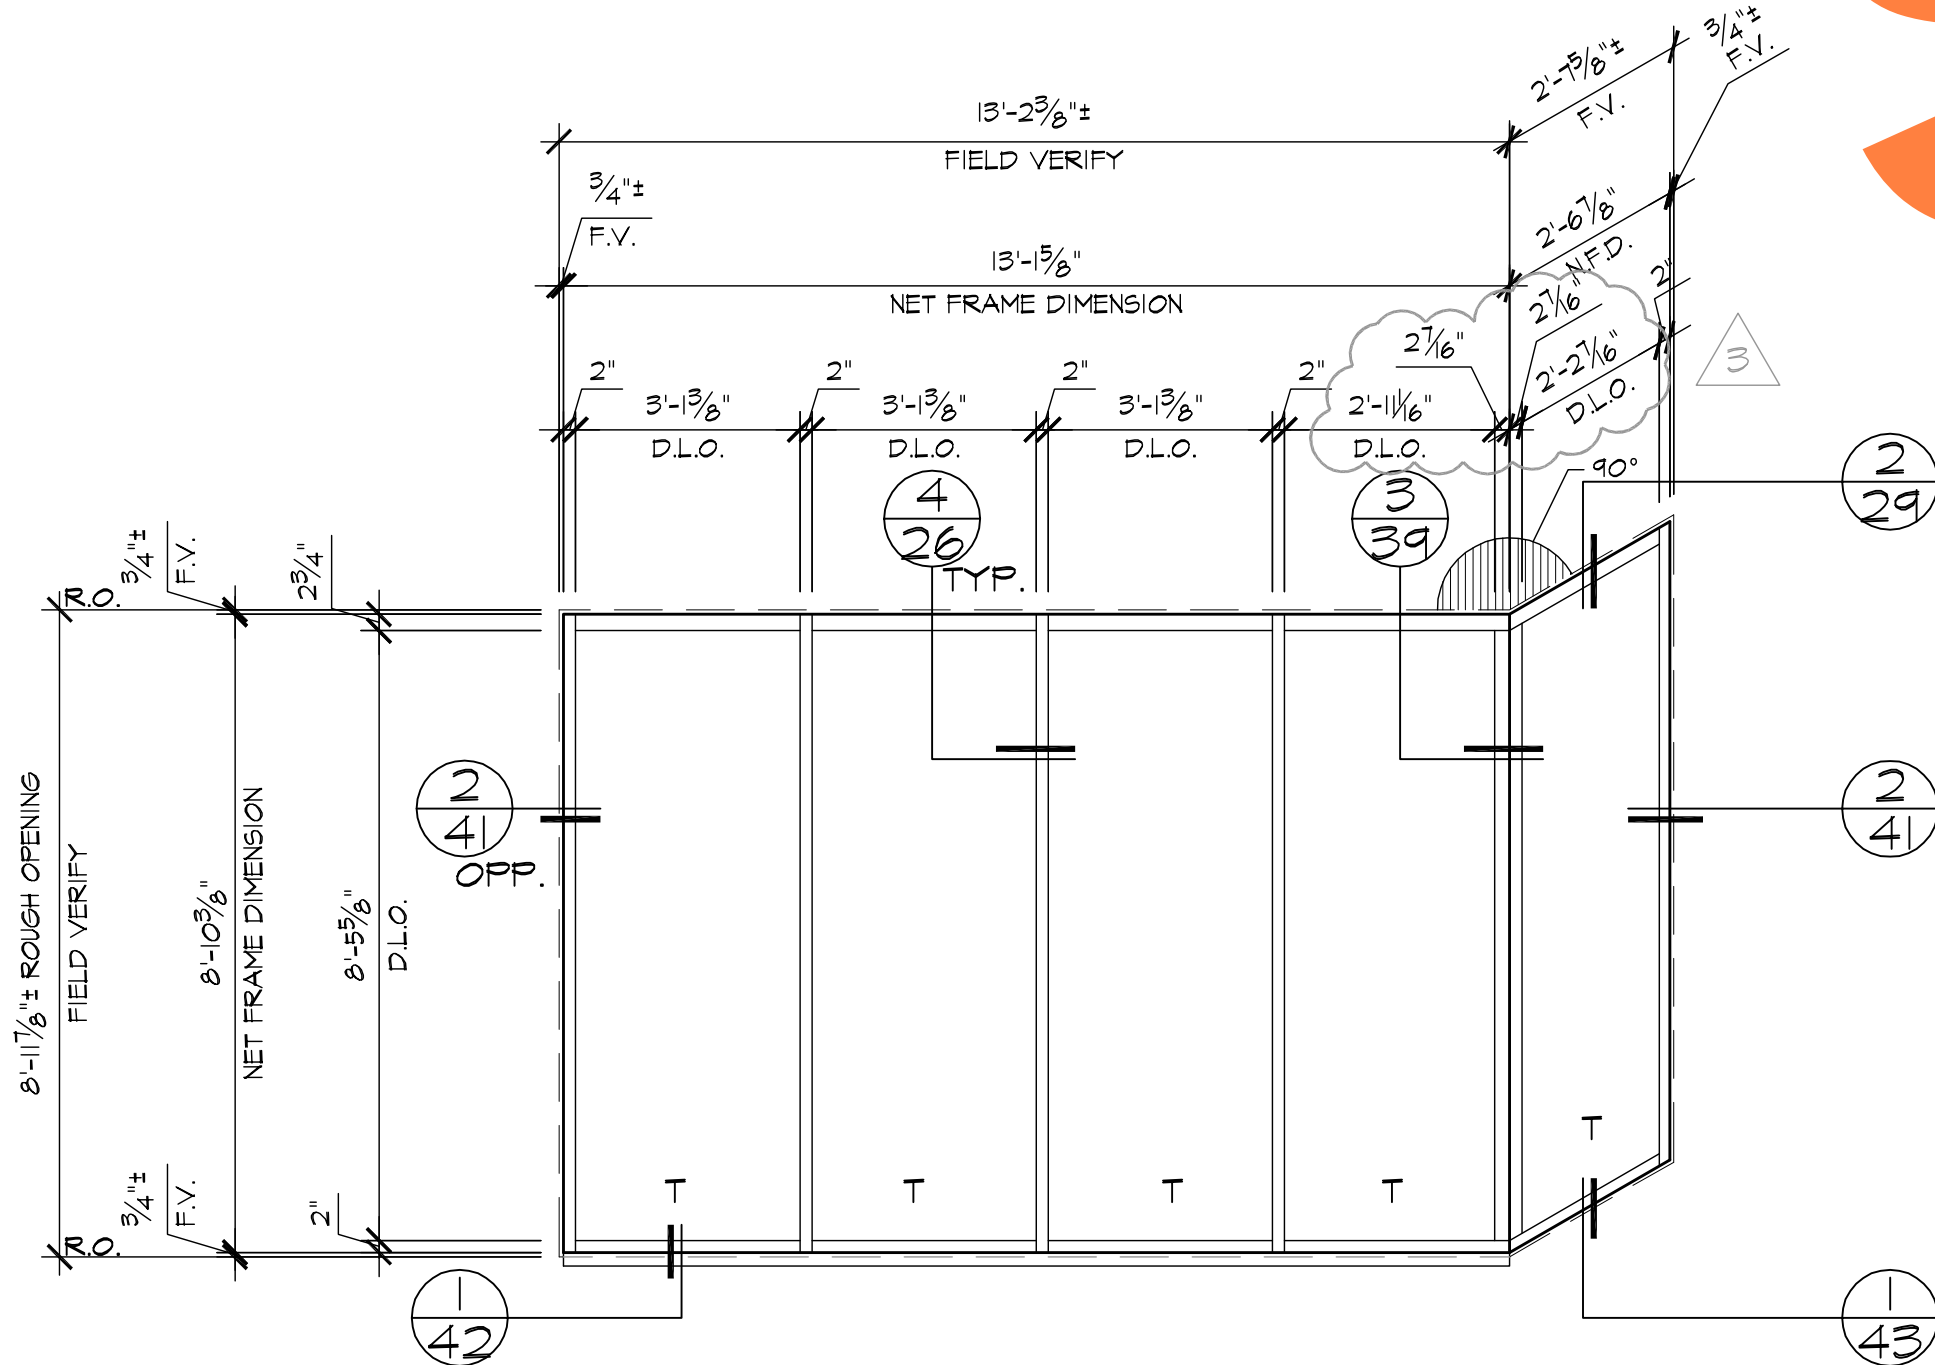

A ELEVATION (2" X 4 1/2" OFFSET GLAZED SYSTEM) (WT)

22 LOCATION

AREA B 4th. FLR. ~ REQ'D (WEST)
AREA B 4th. FLR. ~ REQ'D/OPP (WEST)

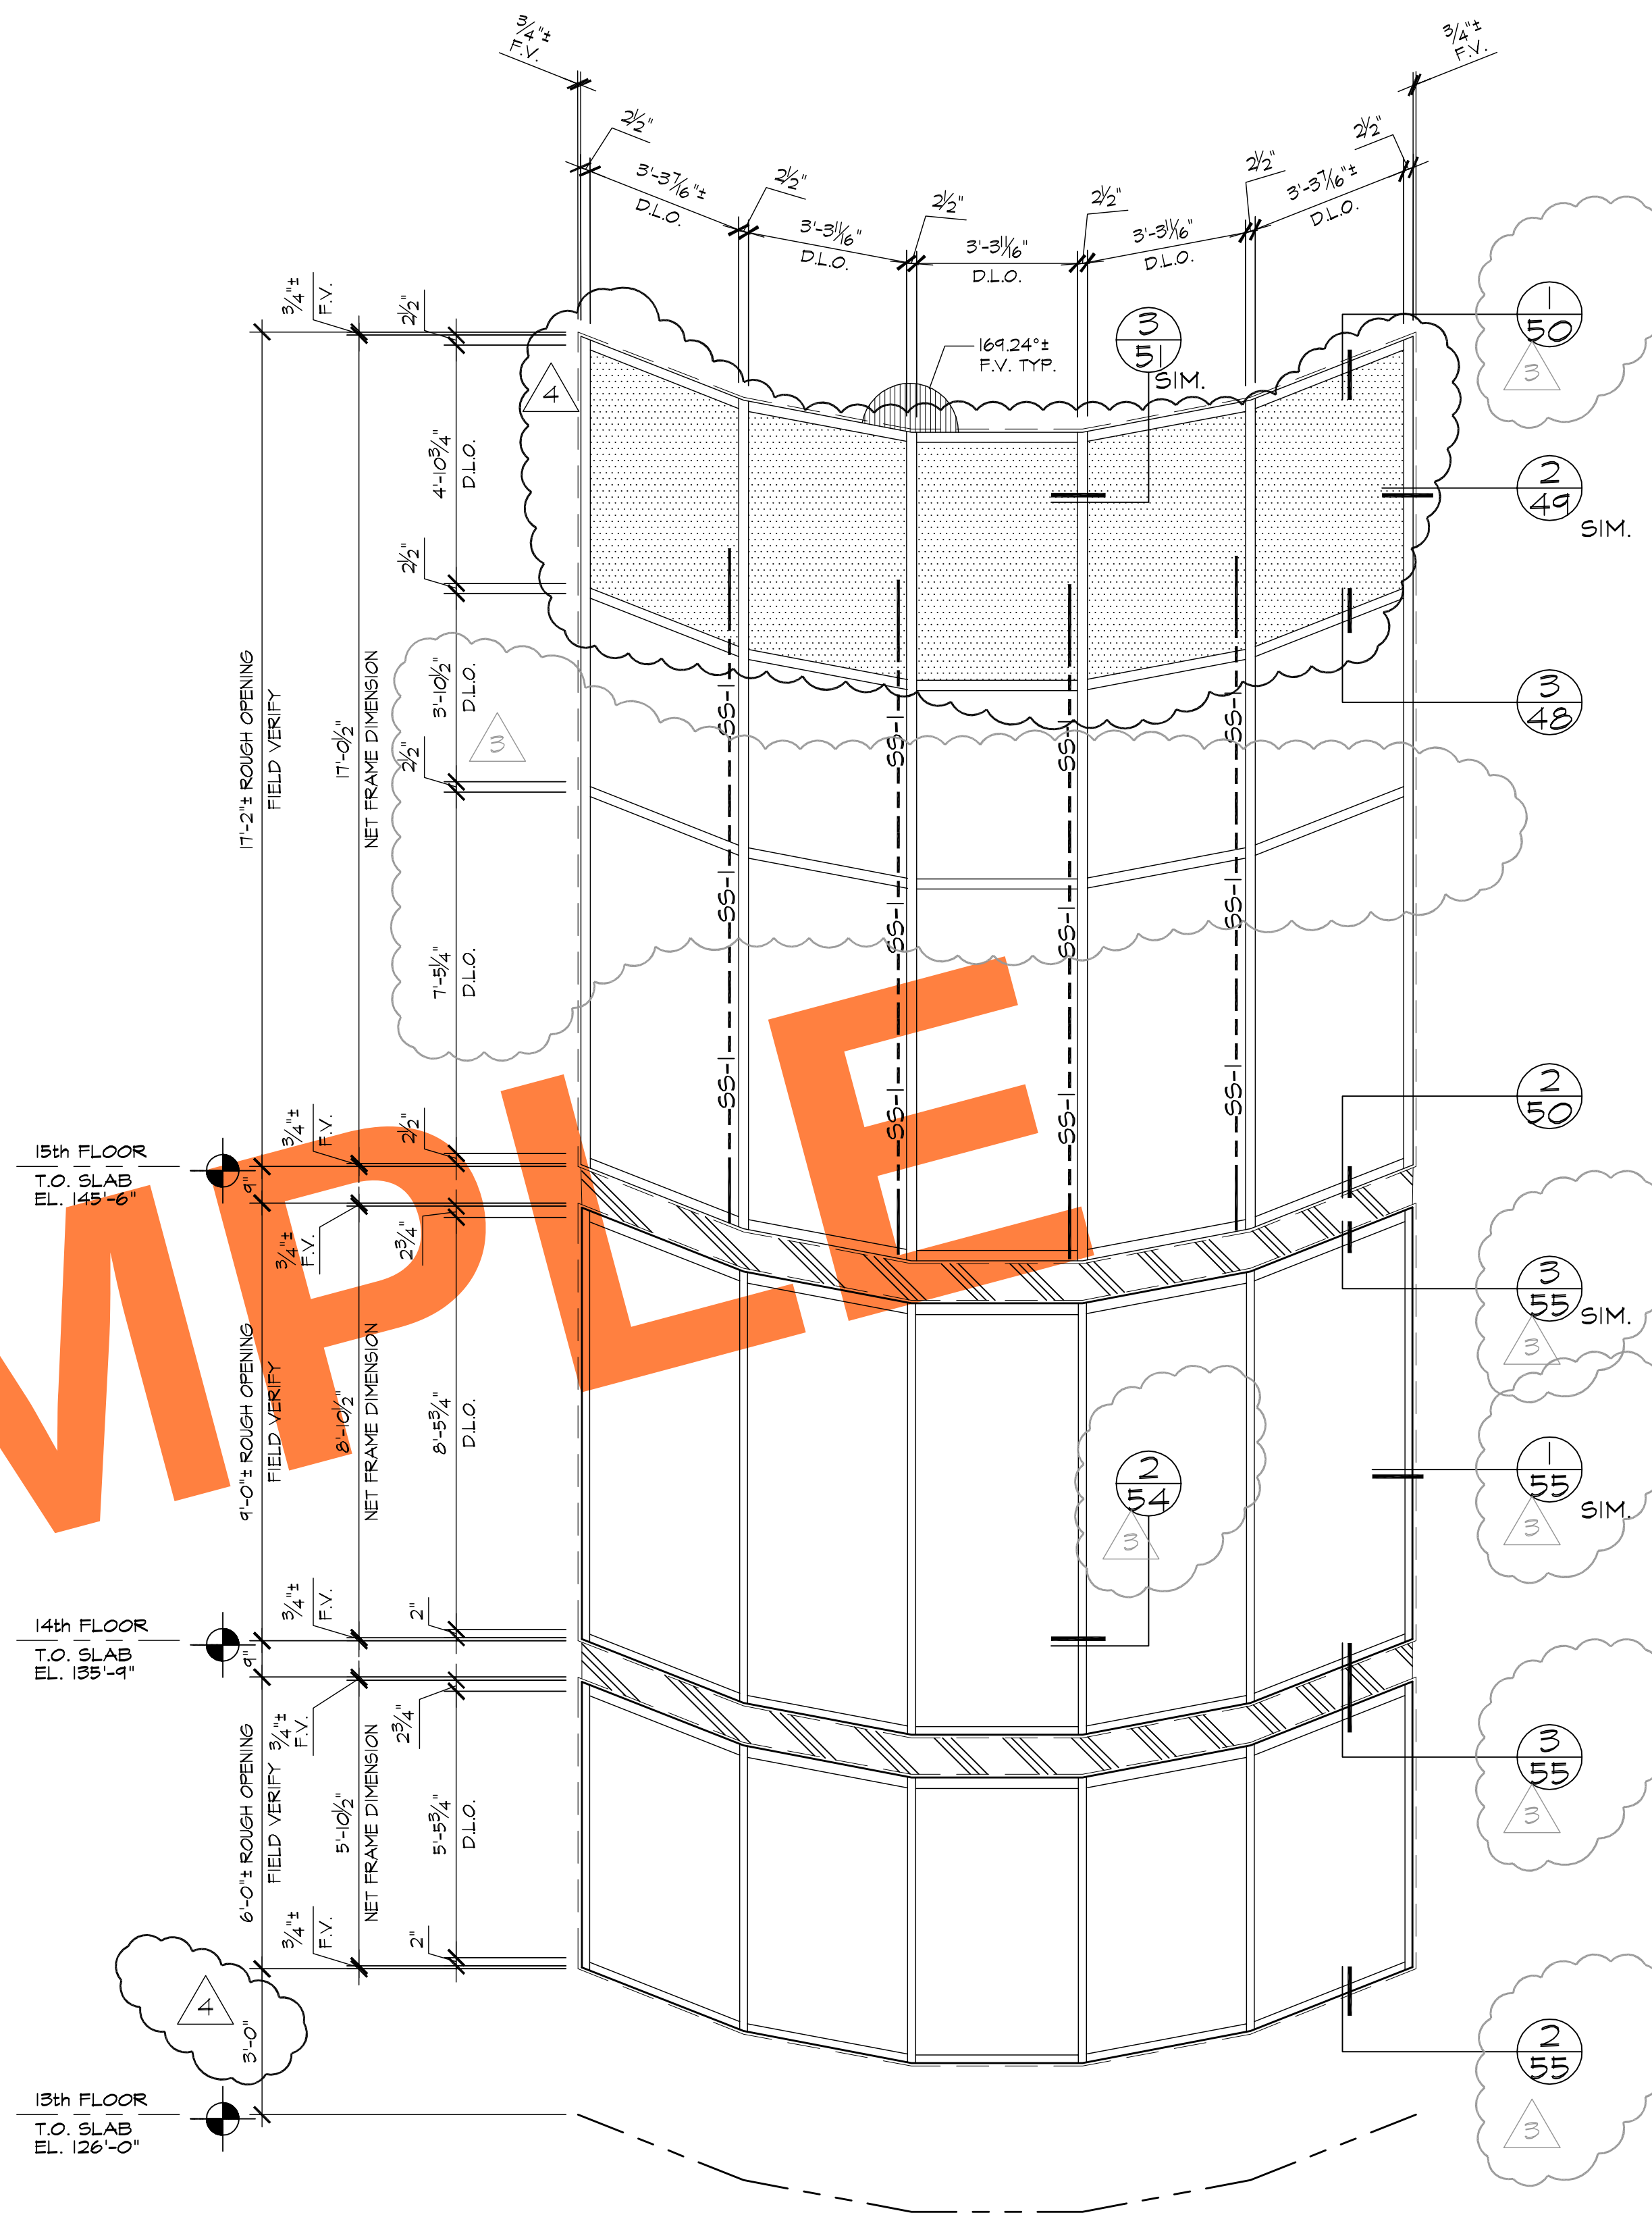

C ELEVATION (SERIES 4250T -- CURTAIN WALL SYSTEM) (2" X 4 1/2" OFFSET GLAZED SYSTEM) (WT) (WT) @ 15th FLR

22 LOCATION

13TH.- 15TH. FLR. ~ REQ'D (NORTH)
13TH.- 15TH. FLR. ~ REQ'D/OPP. (SOUTH)

STEEL LEGEND:

SS-1 ~ 1 1/2" X 3 1/4" X 10GA. X 9'-0" STEEL CHANNEL

REVISIONS	BY
△ 4-23-07	BMR
△ 6-11-07	BMR
△ 12-17-07	CTB
△ 3/6/08	CTB
△	




GLASS FACORY
26383 BASE LINE
HIGHLAND, CA 92346


AS-BUILT DRAWINGS

JOB NAME: AGUA CALIENTE HOTEL ADDITION
ARCHITECT: VOA
SHEET DESCRIPTION: ELEVATIONS

DATE: 1/3/07
SCALE: 3/8"=1'-0"
DRAWN: CTB
JOB NO: 100-06
SHEET NO:

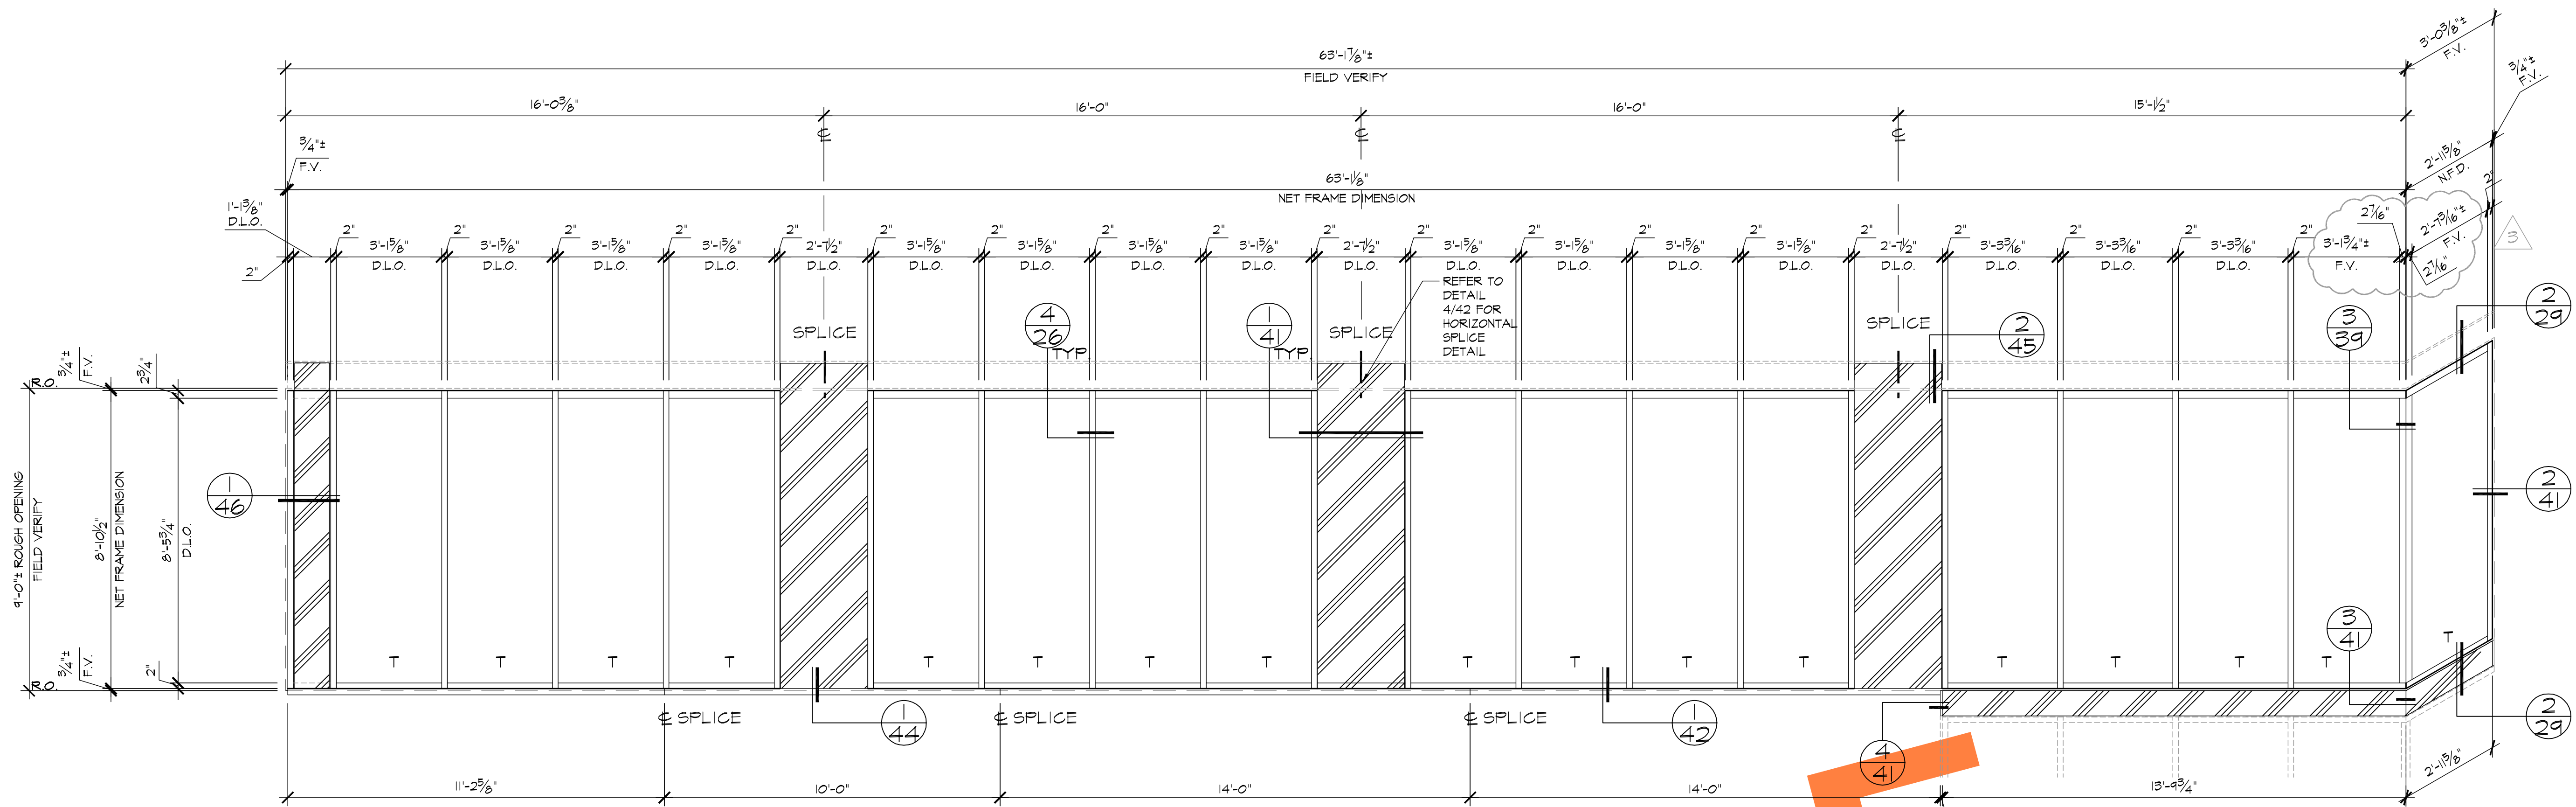

A ELEVATION (2" X 4 1/2" OFFSET GLAZED SYSTEM)
22. LOCATION
AREA A 9th. FLR. ~ 1 REQ'D (WEST)
AREA B 9th. FLR. ~ 1 REQ'D/OPP (WEST)

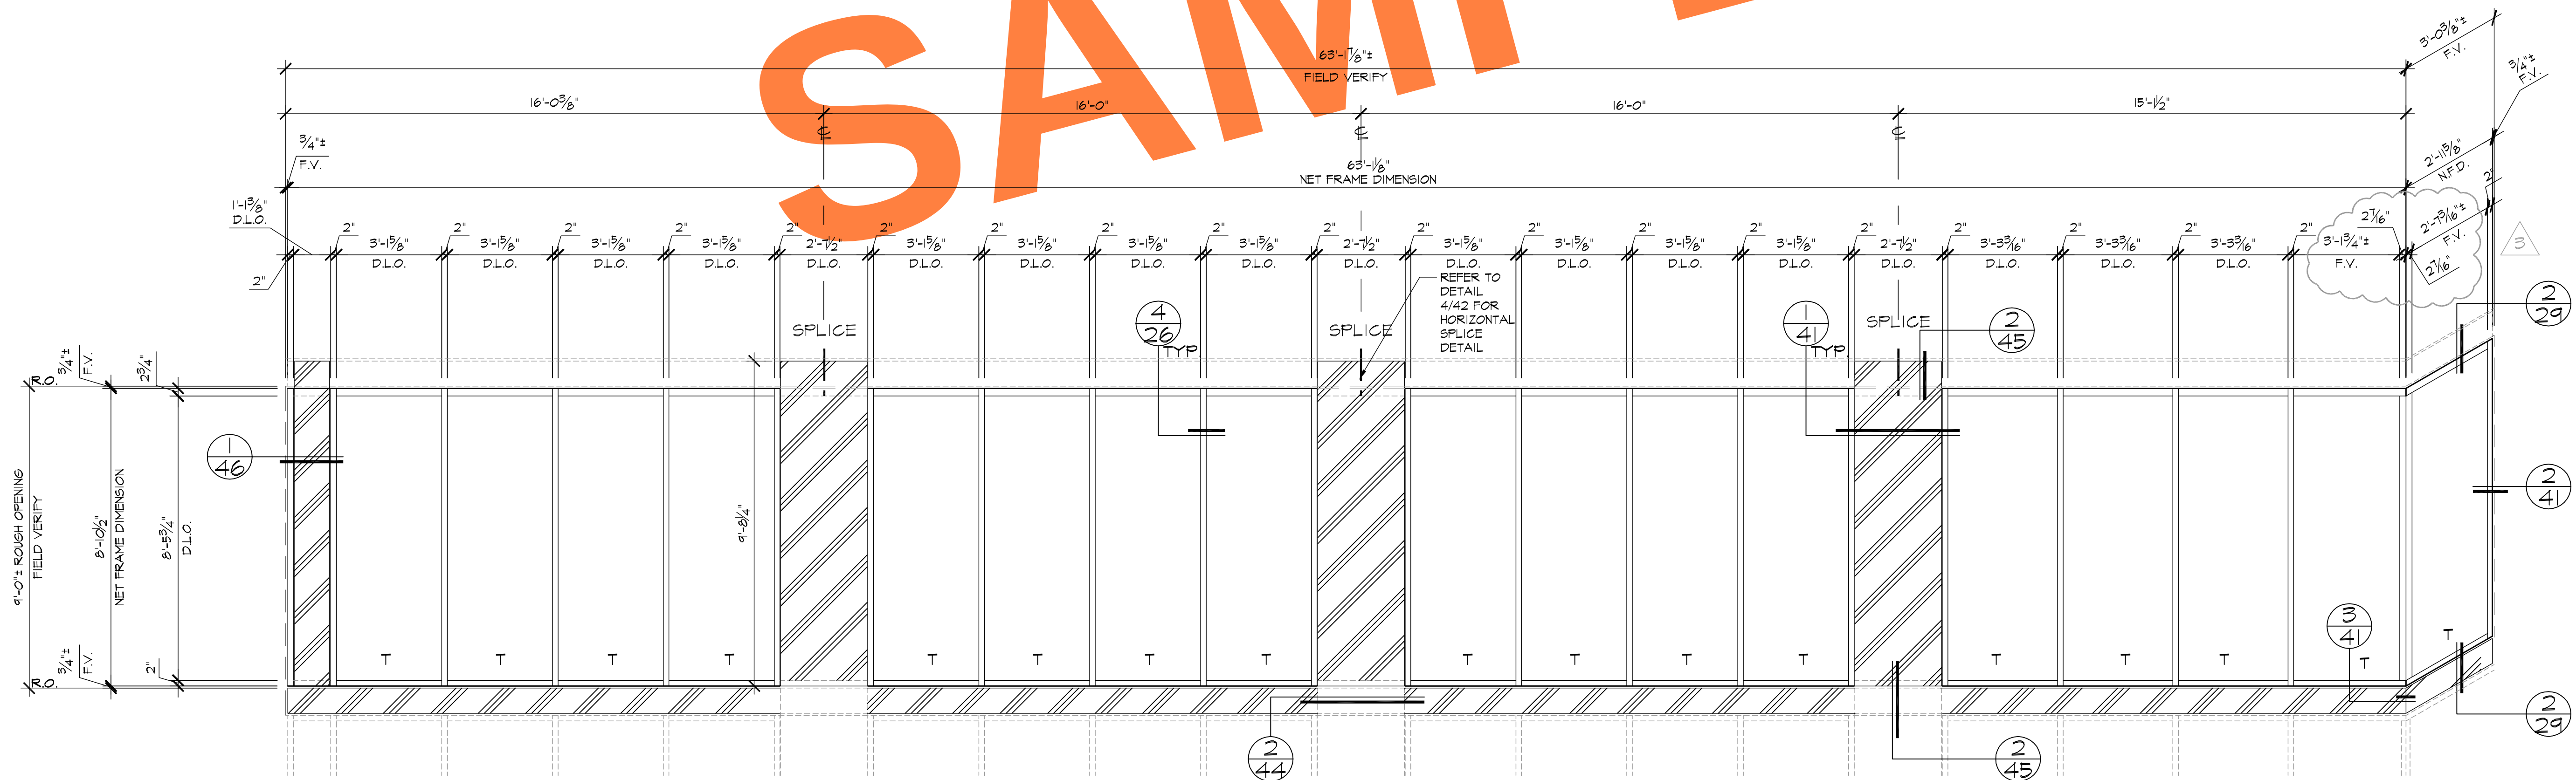

B ELEVATION (2" X 4 1/2" OFFSET GLAZED SYSTEM)
22. LOCATION
AREA B 10th. FLR. ~ 1 REQ'D (WEST)
AREA B 10th. FLR. ~ 1 REQ'D/OPP (WEST)


REVISIONS	BY
△ 4-23-07	BMR
△ 6-11-07	BMR
△ 12-17-07	CTB
△ 3/6/08	CTB
△	




GLASS FACTORY
26383 BASE LINE
HIGHLAND, CA 92346

AS-BUILT DRAWINGS

JOB NAME:	AGUA CALIENTE HOTEL ADDITION
ARCHITECT:	VOA
SHEET DESCRIPTION:	ELEVATIONS
DATE:	1/3/07
SCALE:	3/8"=1'-0"
DRAWN:	CTB
JOB NO:	100-06
SHEET NO:	22.1

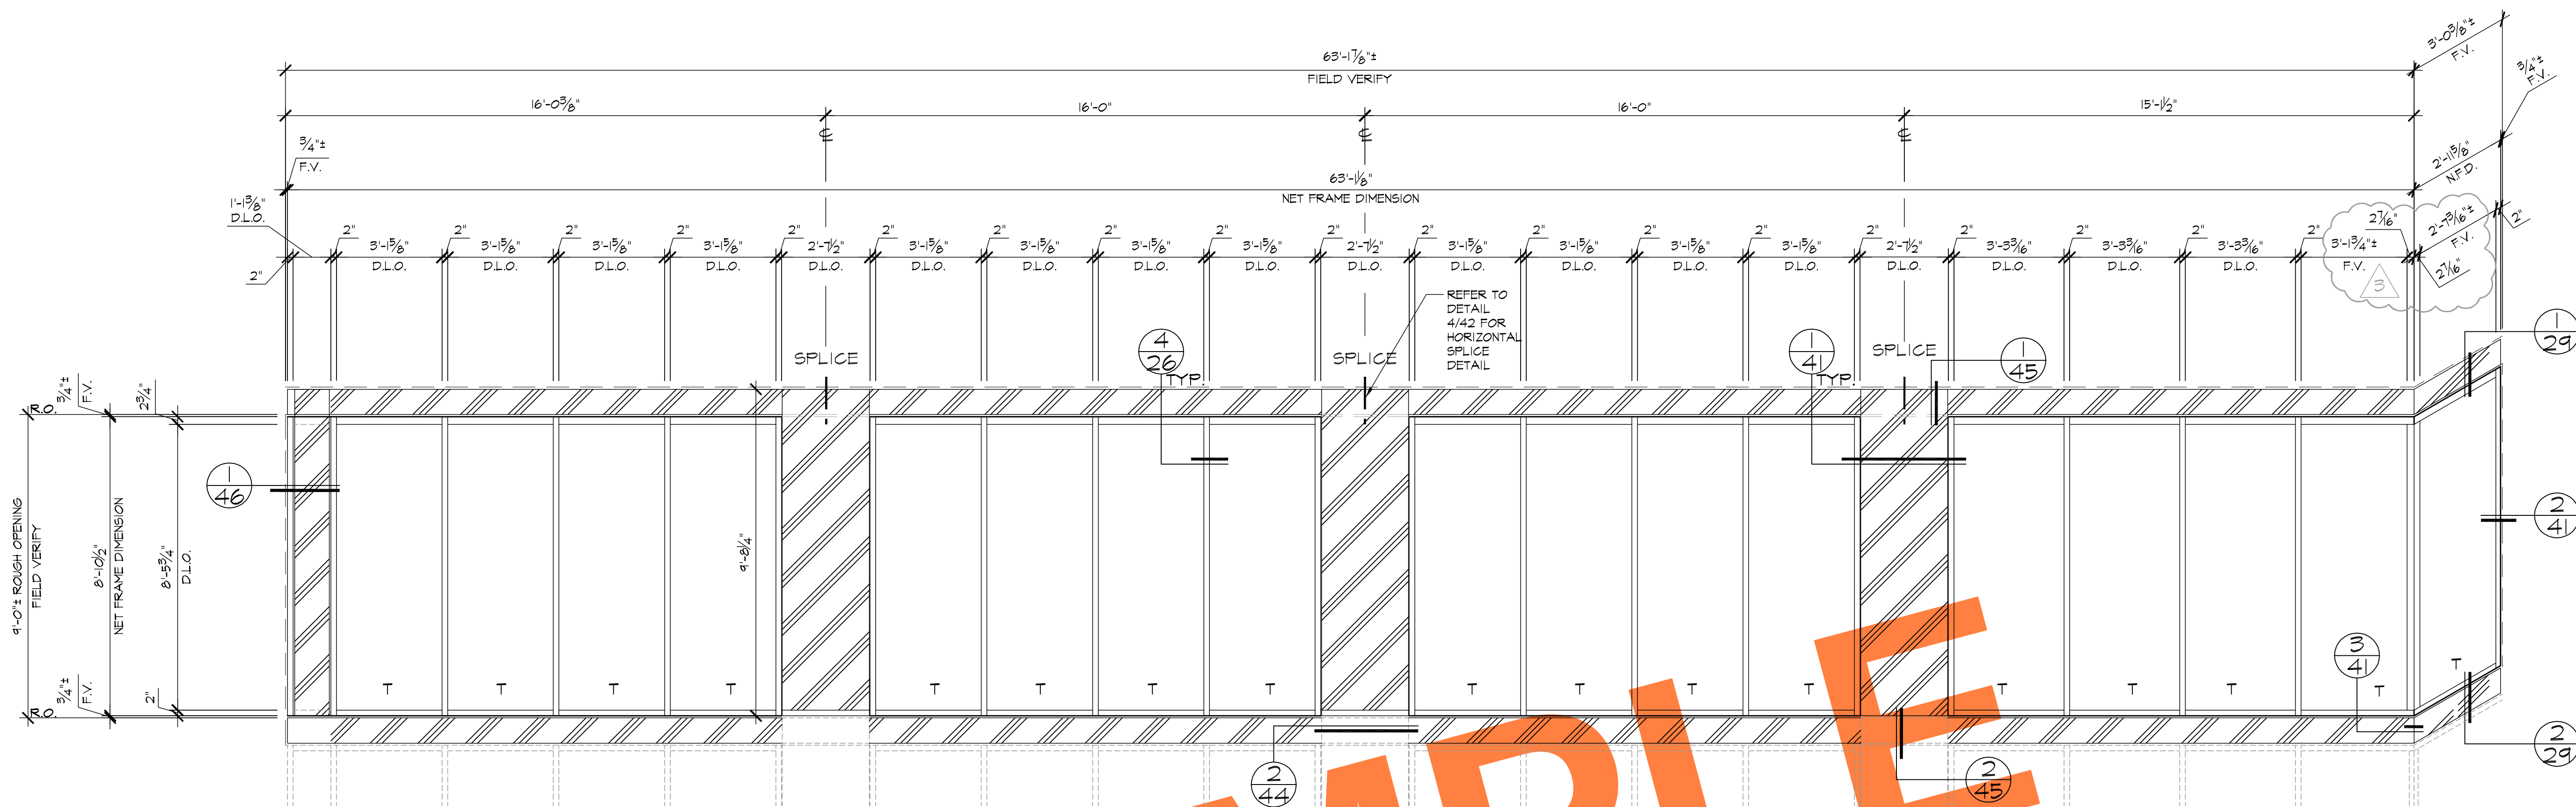

A ELEVATION
22.2 LOCATION
AREA B 11th. FLR. ~ | REQ'D (WEST)
AREA B 11th. FLR. ~ | REQ'D/OPP (WEST)

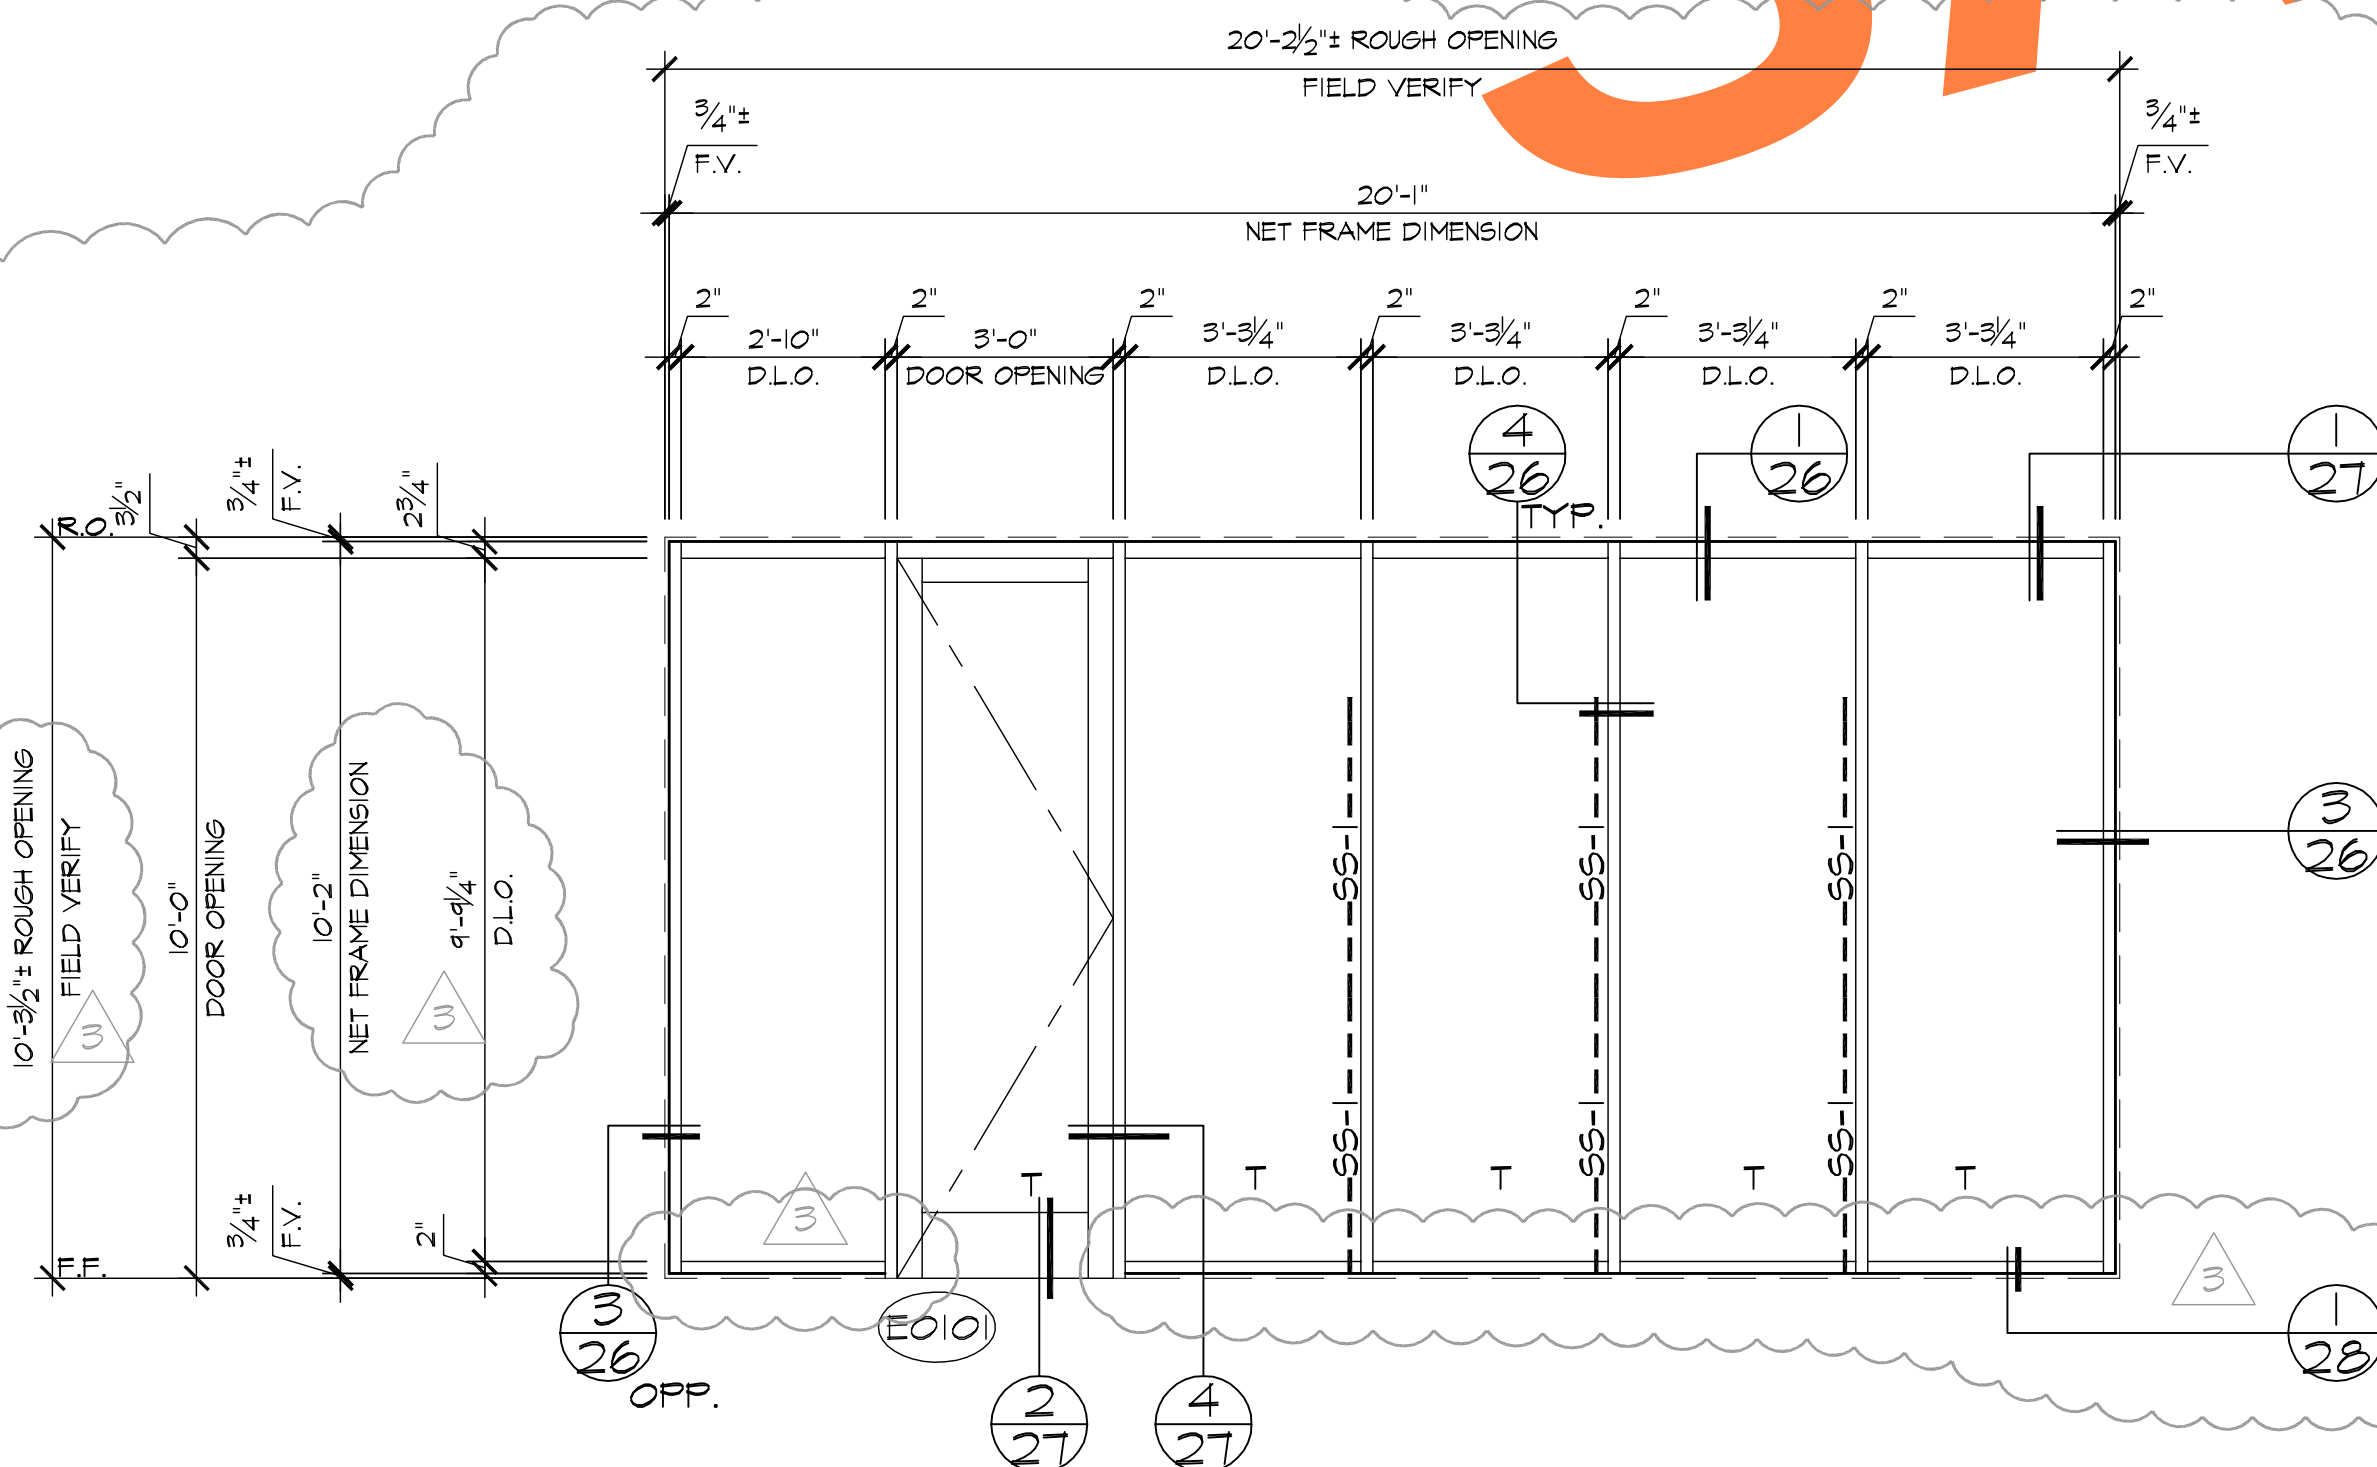

B ELEVATION
22.2 LOCATION
AREA B 1st. FLR. ~ | REQ'D (WEST)


REVISIONS	BY
△ 4-23-07	BMR
△ 6-11-07	BMR
△ 12-17-07	CTB
△ 3/6/08	CTB
△	




GLASS FACORY
26383 BASE LINE
HIGHLAND, CA 92346

AS-BUILT DRAWINGS


JOB NAME:	AGUA CALIENTE HOTEL ADDITION
ARCHITECT:	VOA
SHEET DESCRIPTION:	ELEVATIONS
DATE:	1/3/07
SCALE:	3/8"=1'-0"
DRAWN:	CTB
JOB NO:	100-06
SHEET NO:	22.2

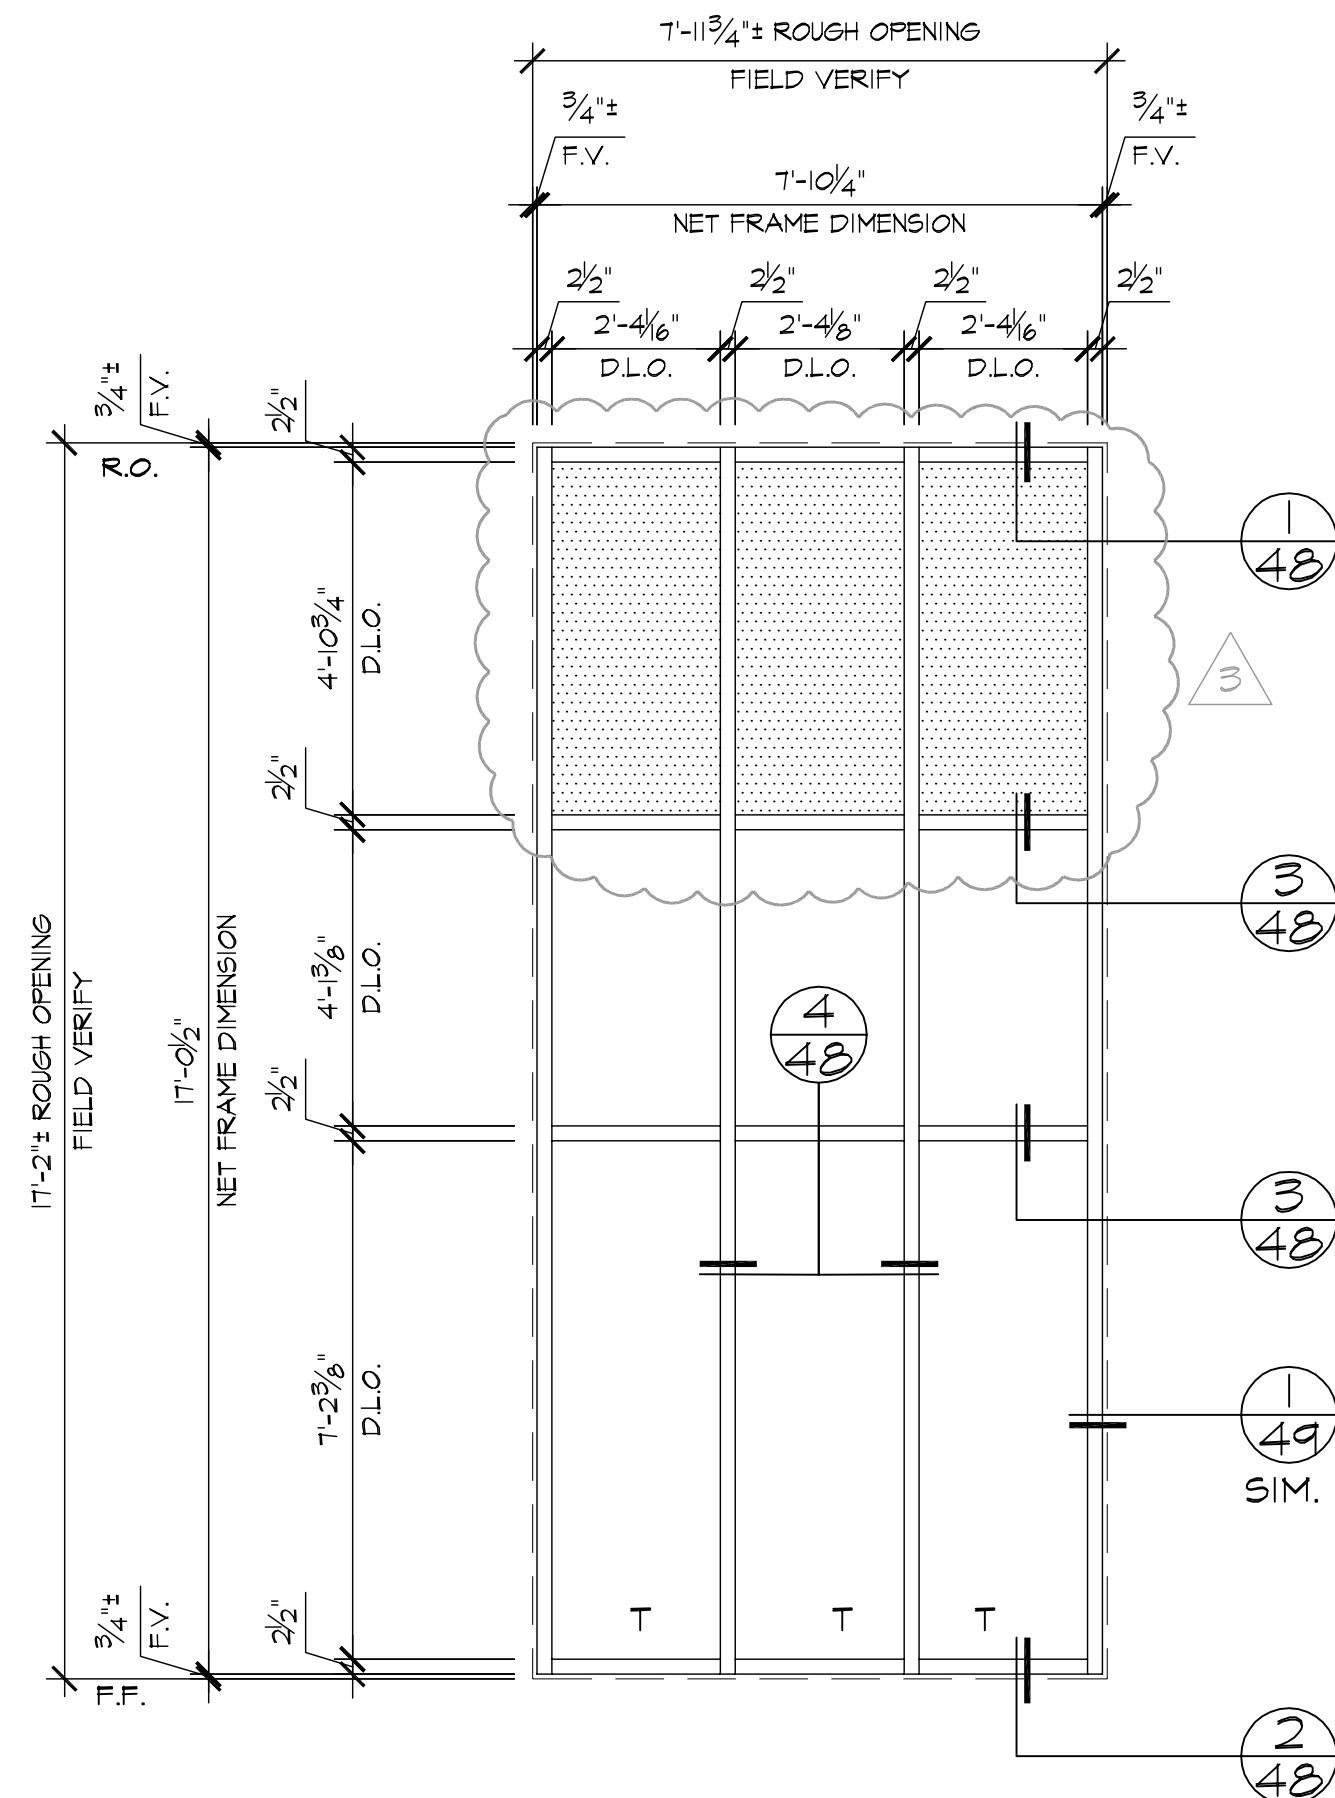


A ELEVATION (SERIES 4250T -- CURTAIN WALL SYSTEM) 
23.1 LOCATION
 AREA B 15th. FLR. ~ 2 REQ'D (EAST)

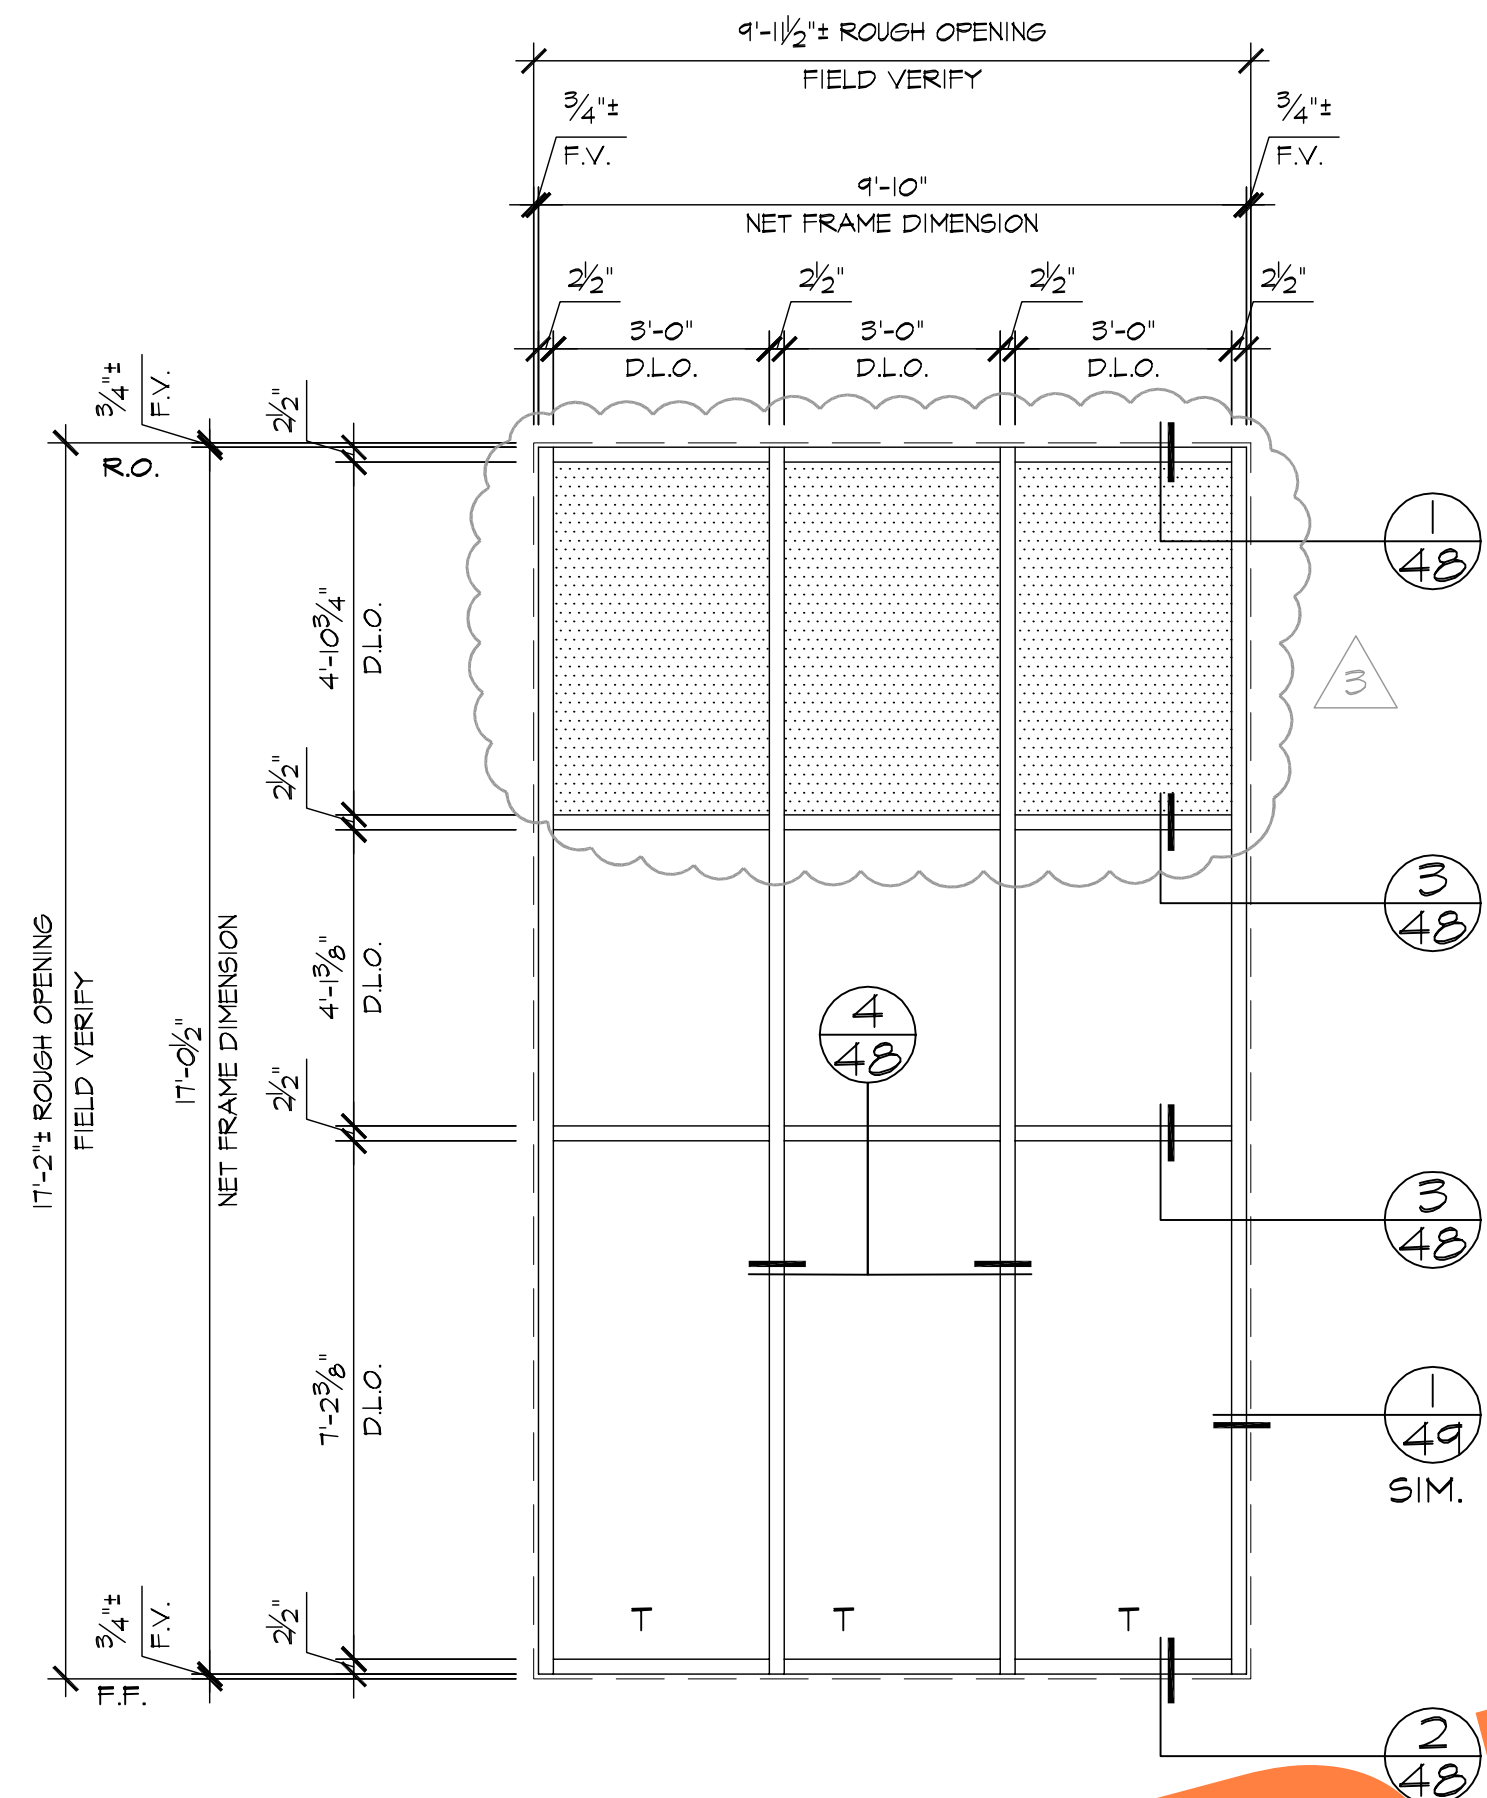

B ELEVATION (SERIES 4250T -- CURTAIN WALL SYSTEM) 
23.1 LOCATION
 AREA B 15th. FLR. ~ 2 REQ'D (WEST)

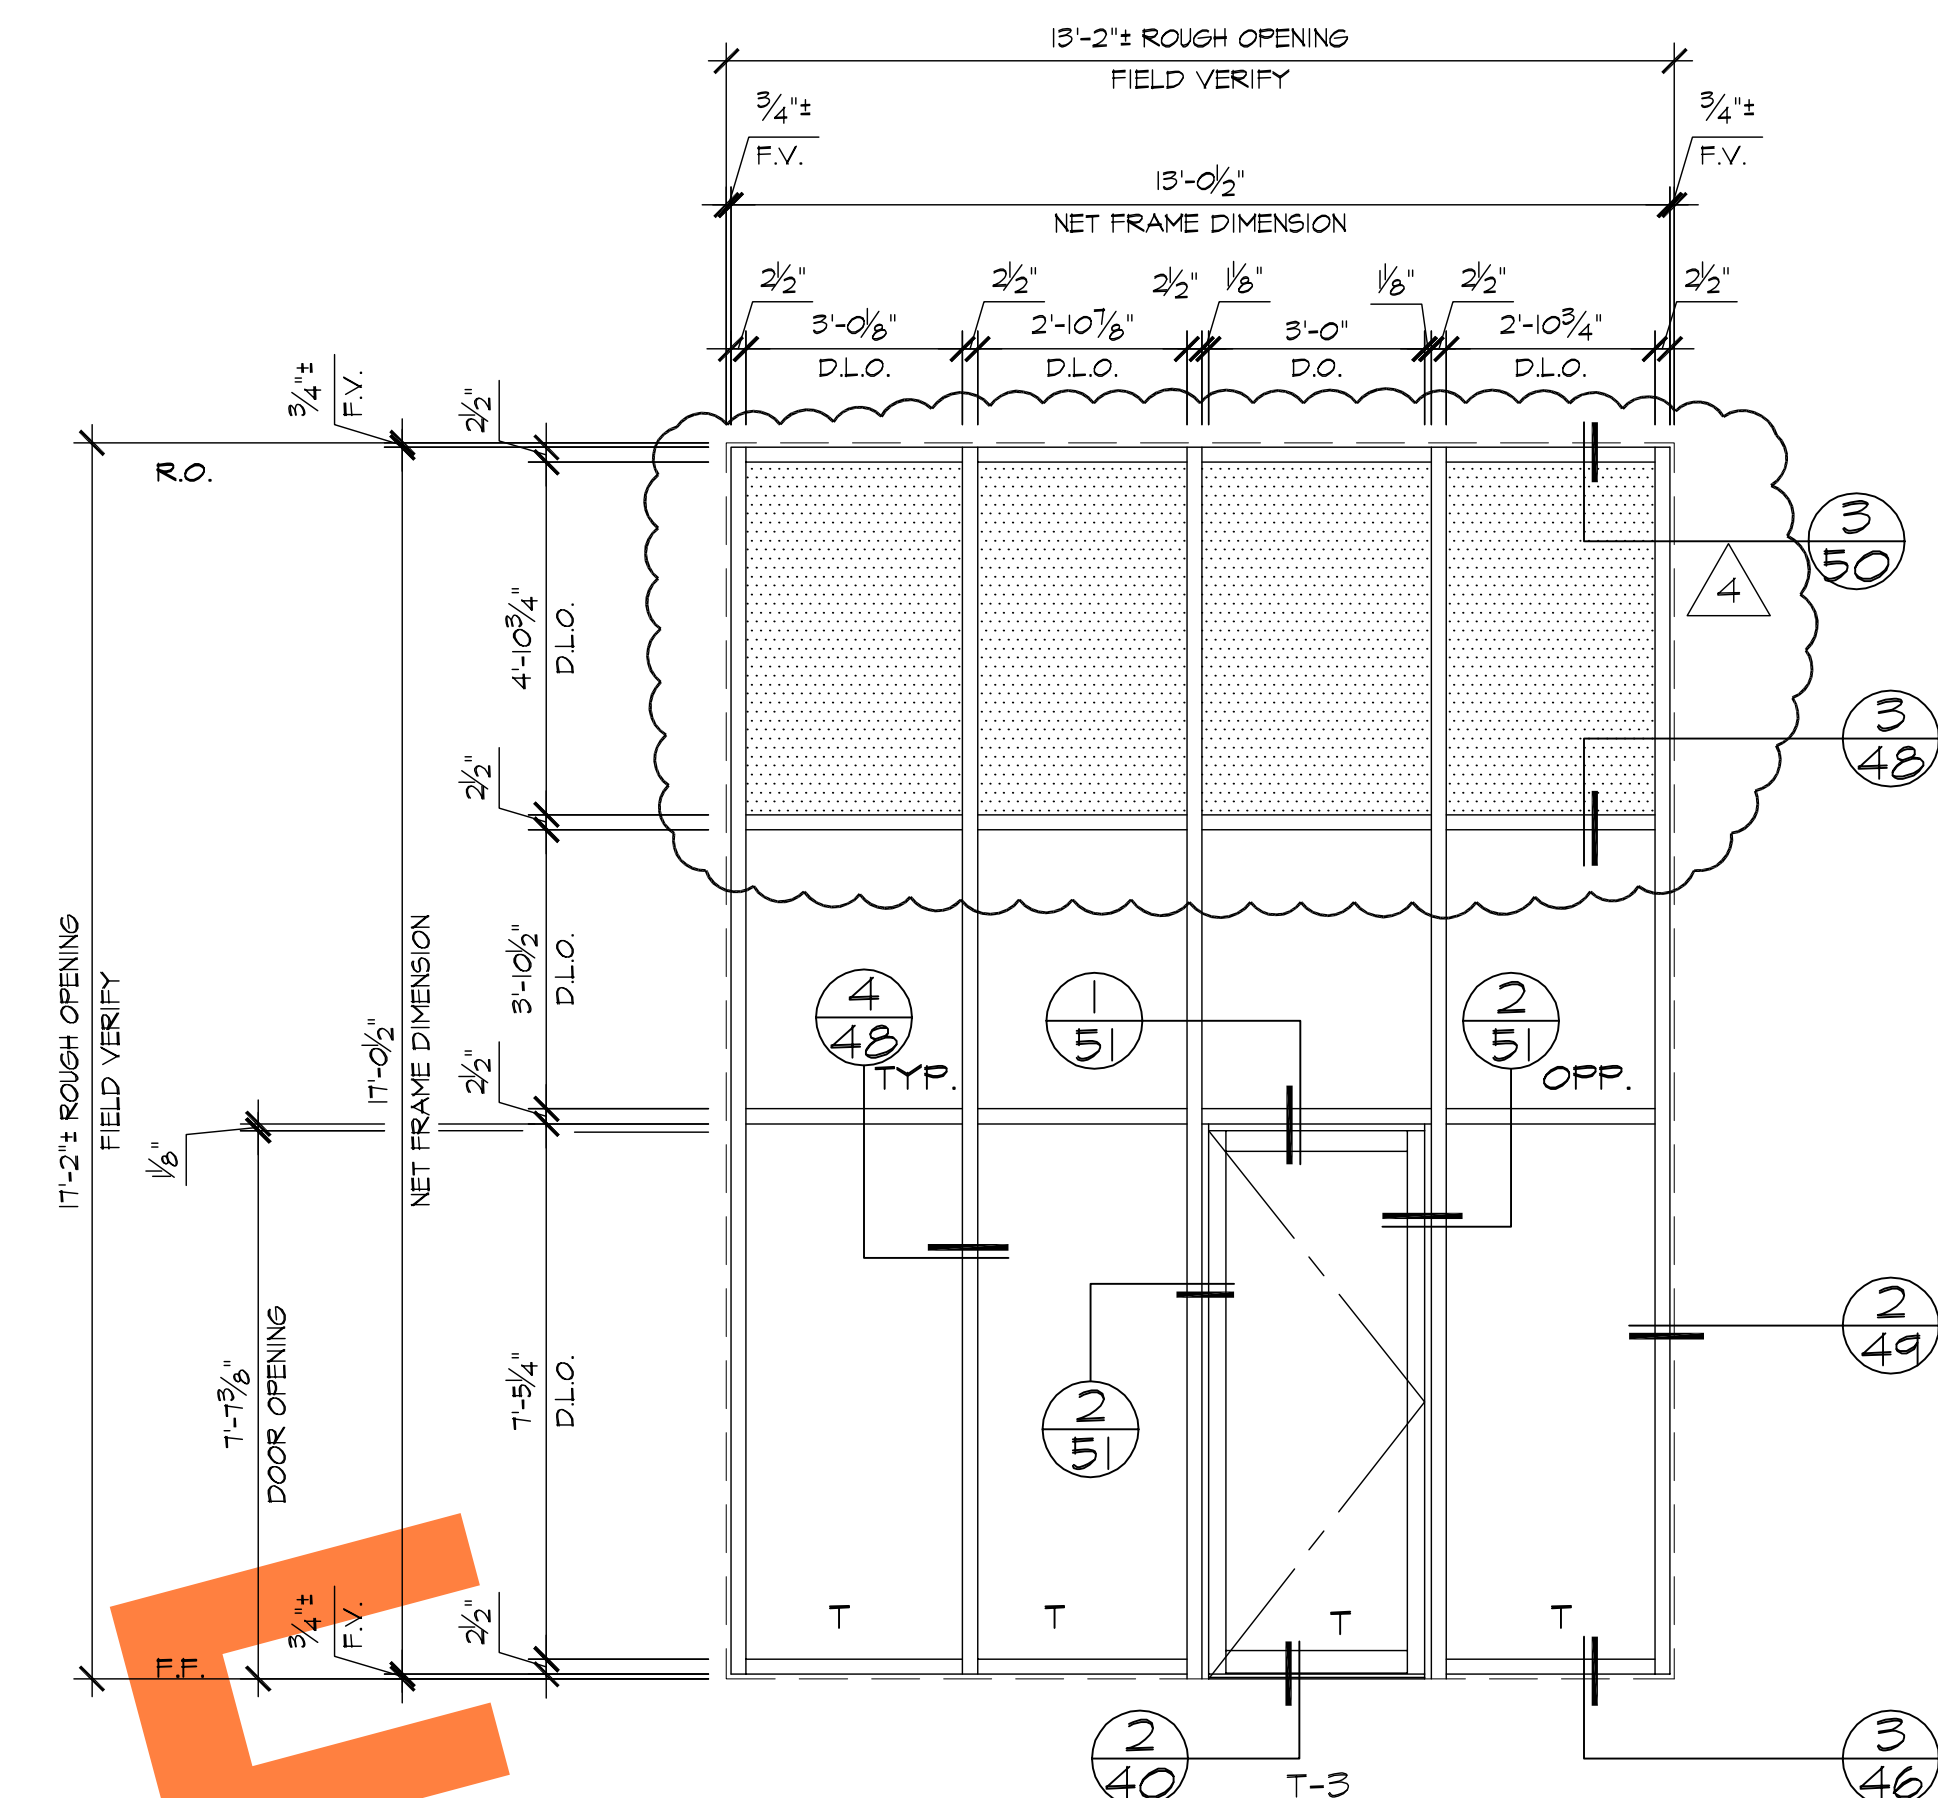

C ELEVATION (SERIES 4250T -- CURTAIN WALL SYSTEM) 
23.1 LOCATION
 AREA B 15th. FLR. ~ 1 REQ'D (WEST)
 AREA B 15th. FLR. ~ 1 REQ'D/OPP (WEST)
 AREA B 15th. FLR. ~ 1 REQ'D (EAST)
 AREA B 15th. FLR. ~ 1 REQ'D/OPP (EAST)

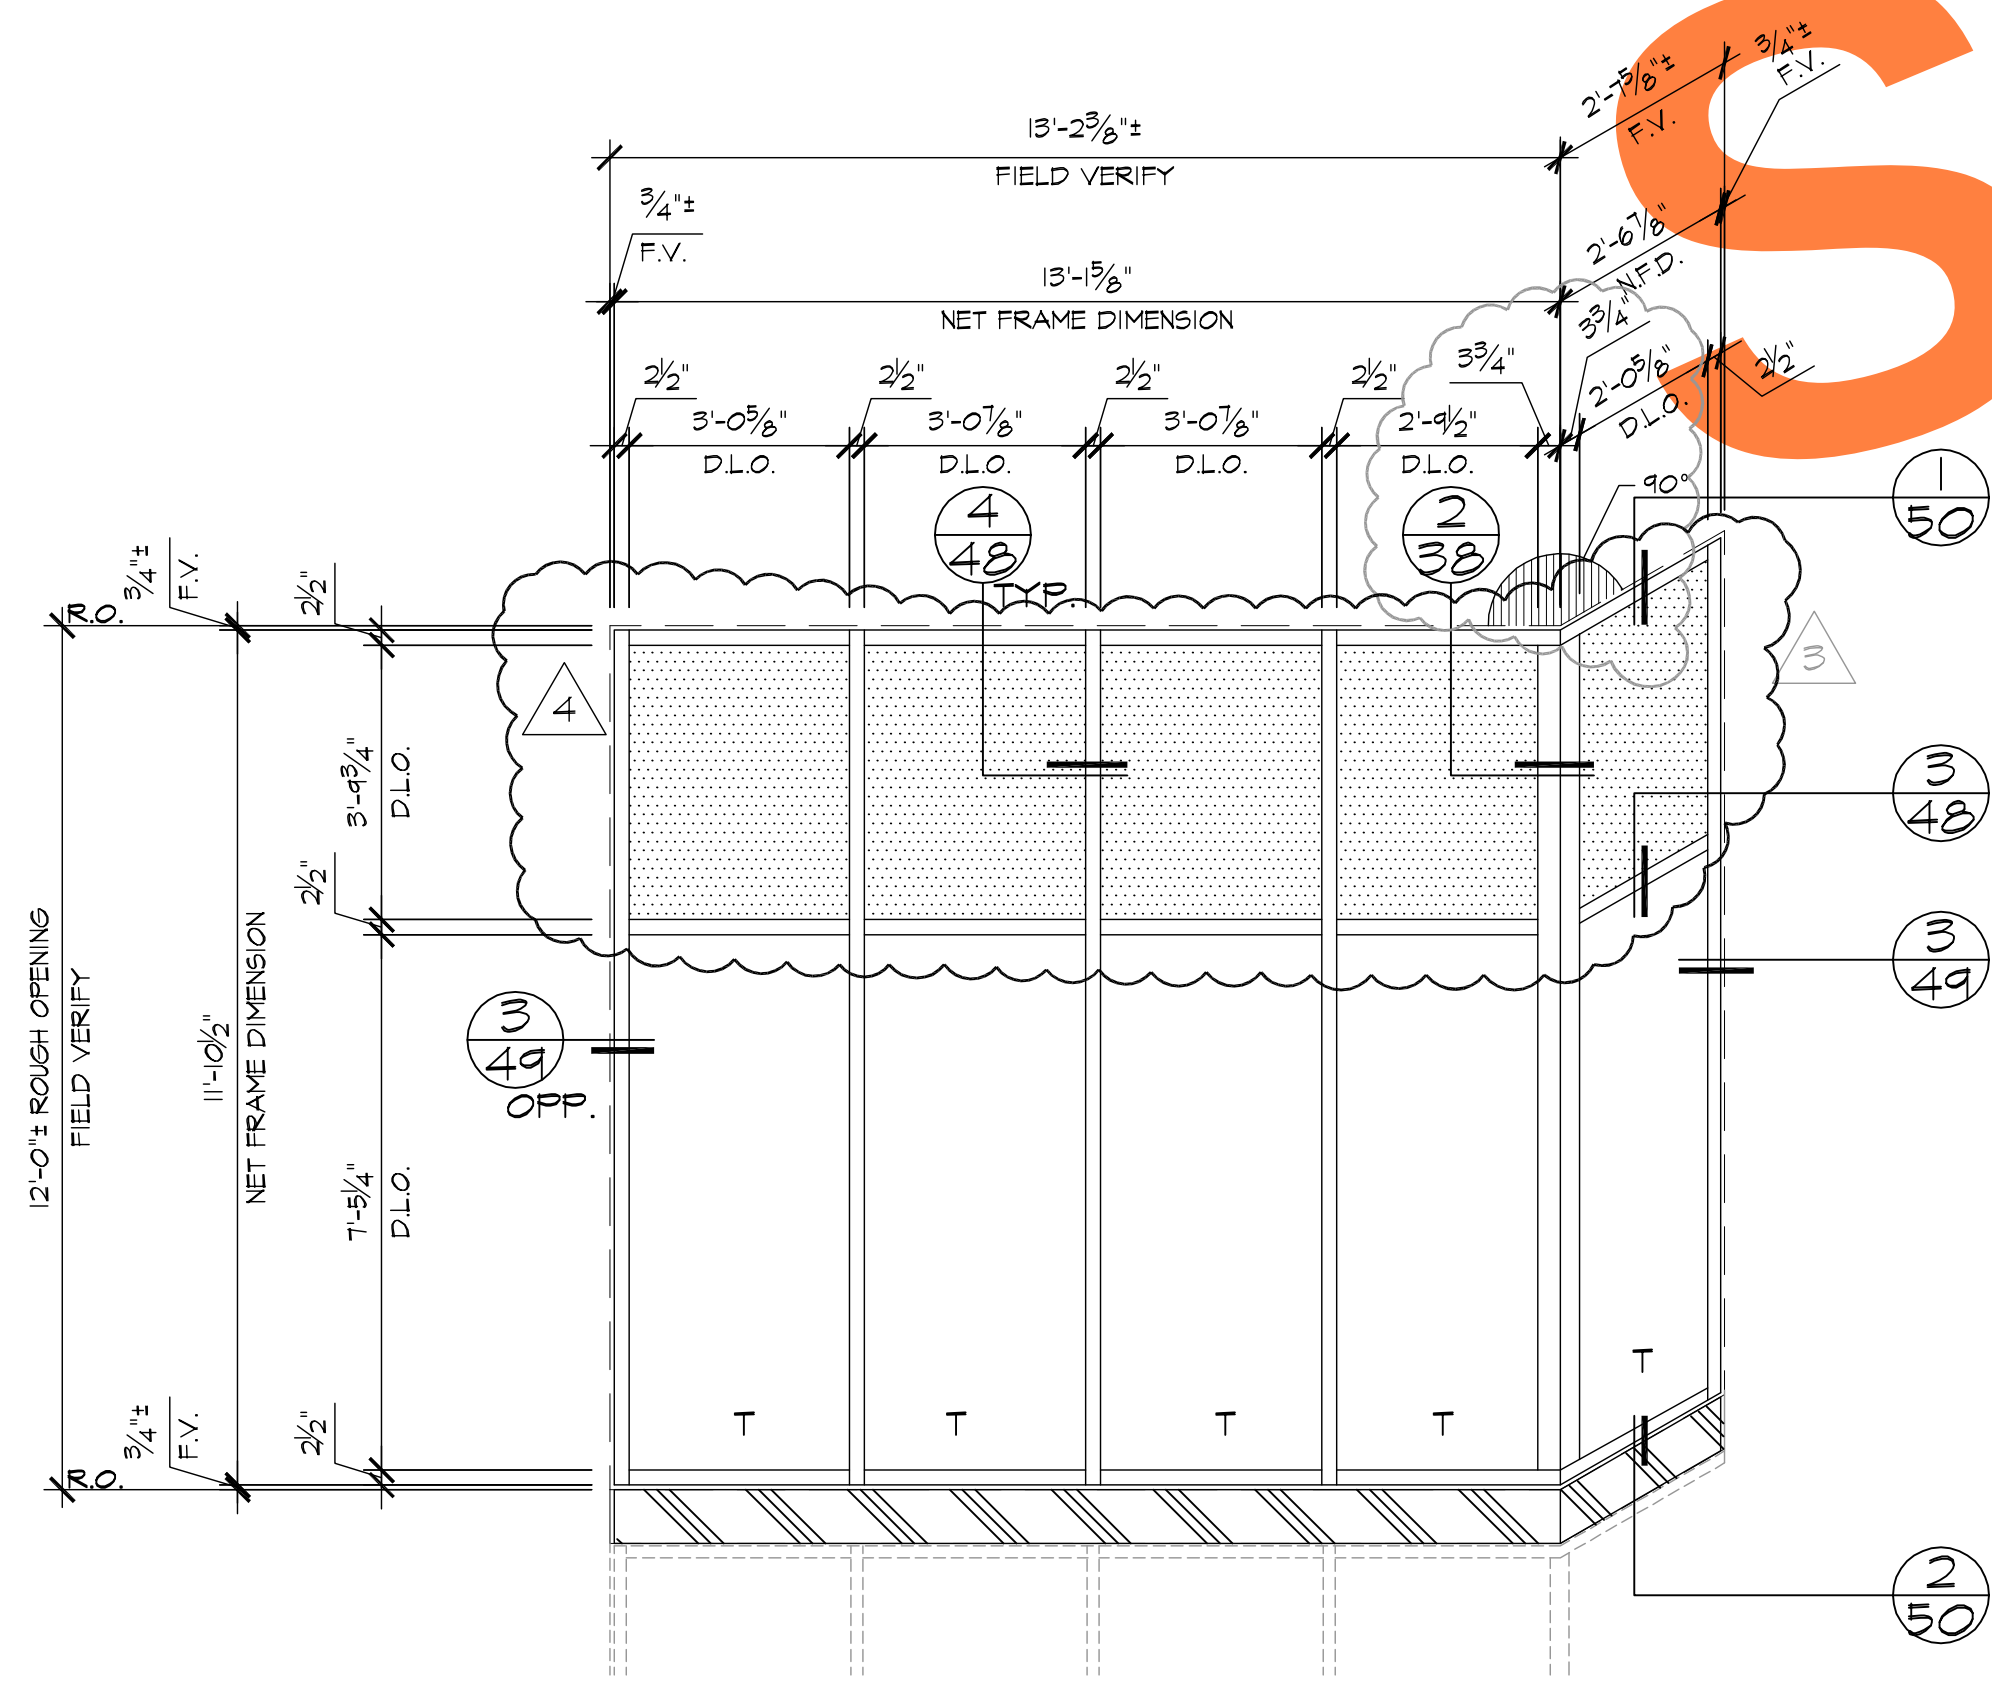

D ELEVATION (SERIES 4250T -- CURTAIN WALL SYSTEM) 
23.1 LOCATION
 AREA B 15th. FLR. ~ 1 REQ'D (WEST)
 AREA B 15th. FLR. ~ 1 REQ'D/OPP (WEST)

REVISIONS	BY
△ 4-23-07	BMR
△ 6-11-07	BMR
△ 12-17-07	CTB
△ 3/6/08	CTB
△	


BMR

DRAFTING SERVICE
 SINCE 1988
 23846 SUNNYMEAD BLVD.
 SUITE #6
 MORENO VALLEY, CA 92553
 B: (951) 243-7814
 F: (951) 243-7873


GLASS FACTORY
 26383 BASE LINE
 HIGHLAND, CA 92346

AS-BUILT DRAWINGS


JOB NAME:	AGUA CALIENTE HOTEL ADDITION
ARCHITECT:	VOA
SHEET DESCRIPTION:	ELEVATIONS
DATE:	6-11-07
SCALE:	3/8"=1'-0"
DRAWN:	BMR
JOB NO:	100-06
SHEET NO:	23.1

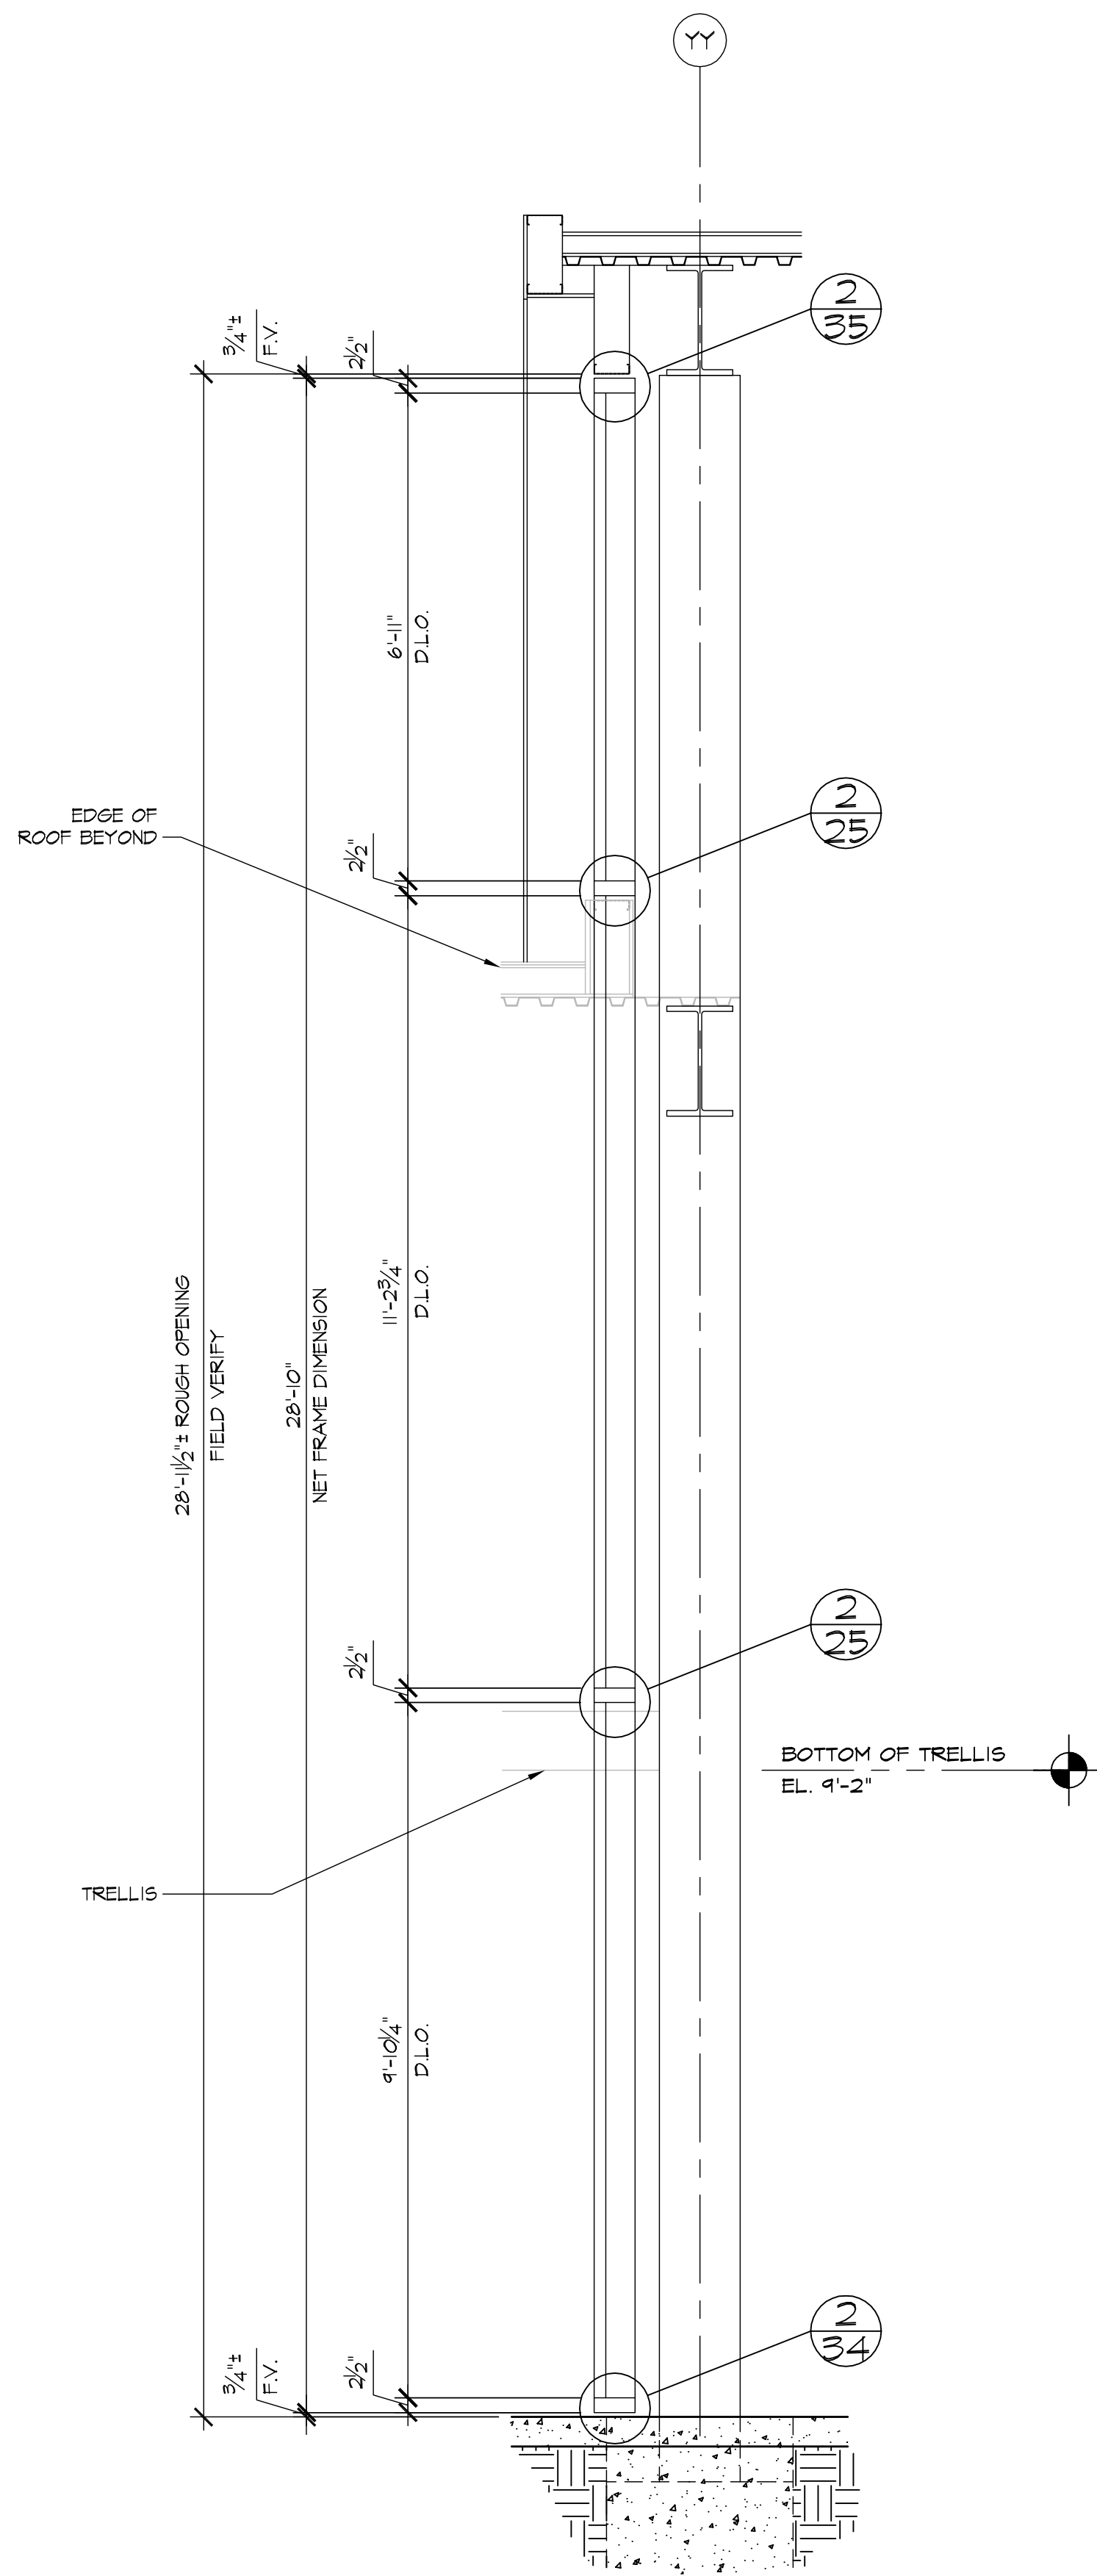


AA WALL SECTION
24 ARCH'L: 11/A301E

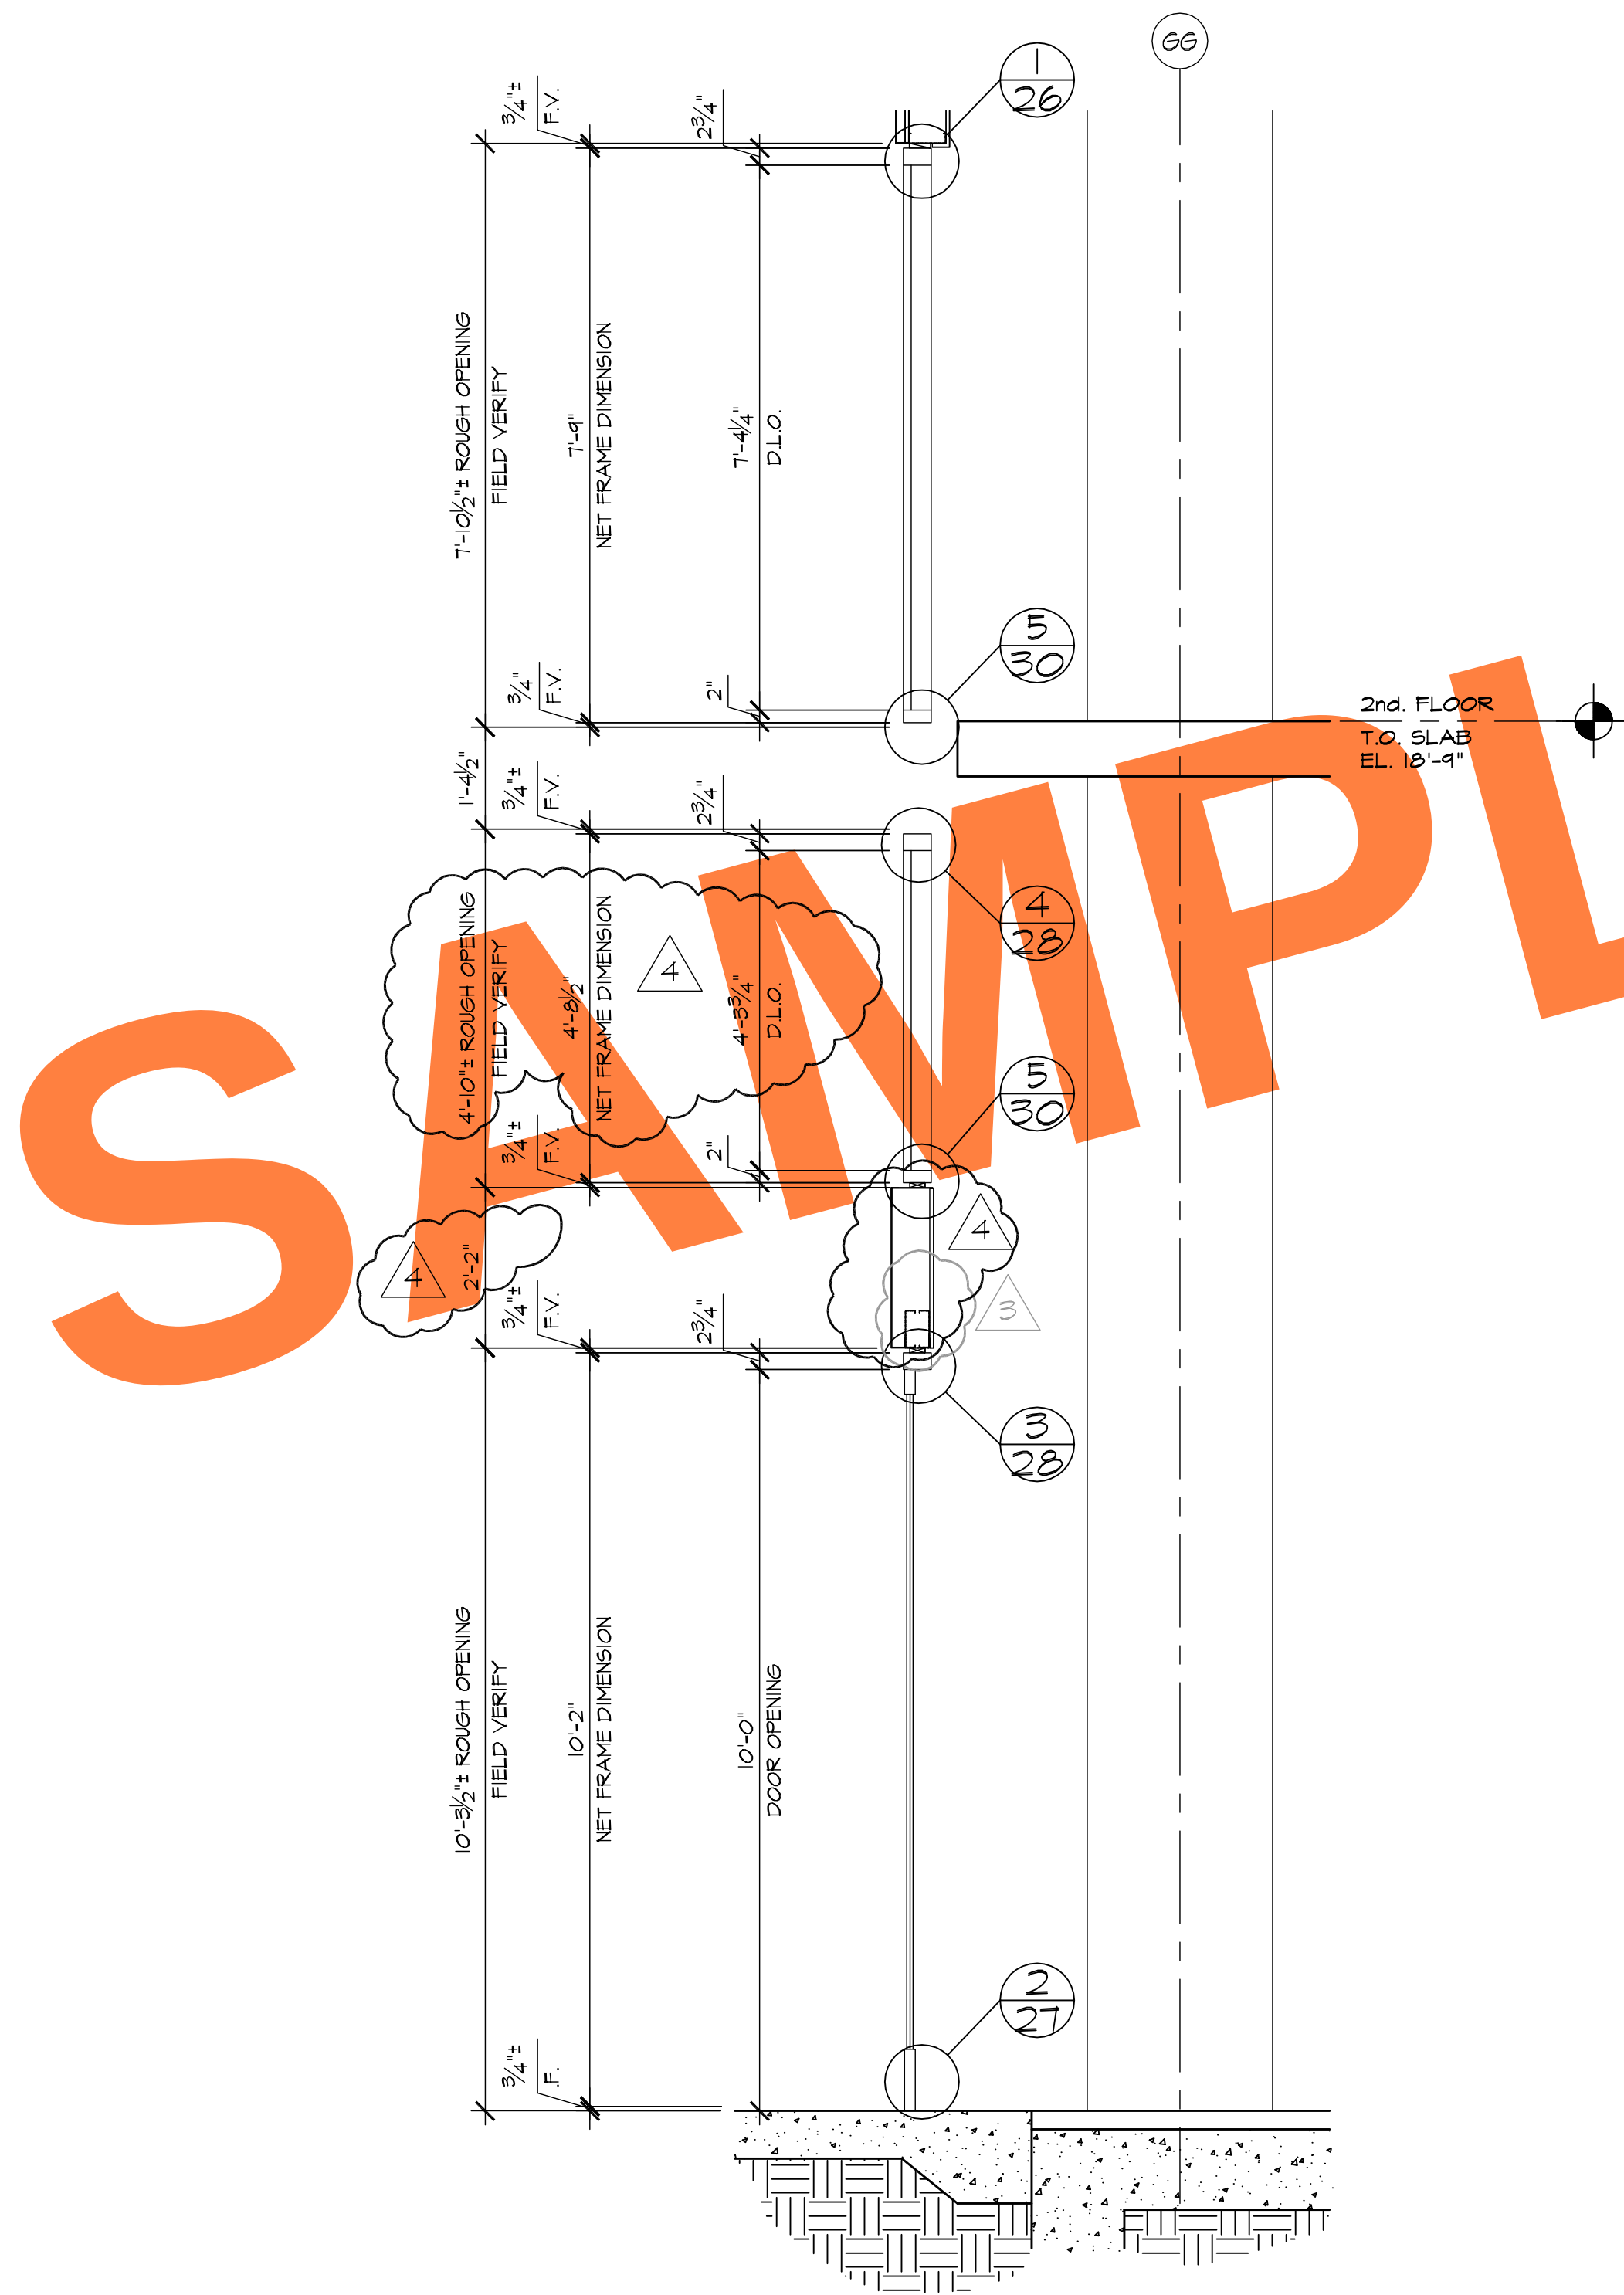


BB WALL SECTION
24 ARCH'L: 01/A313

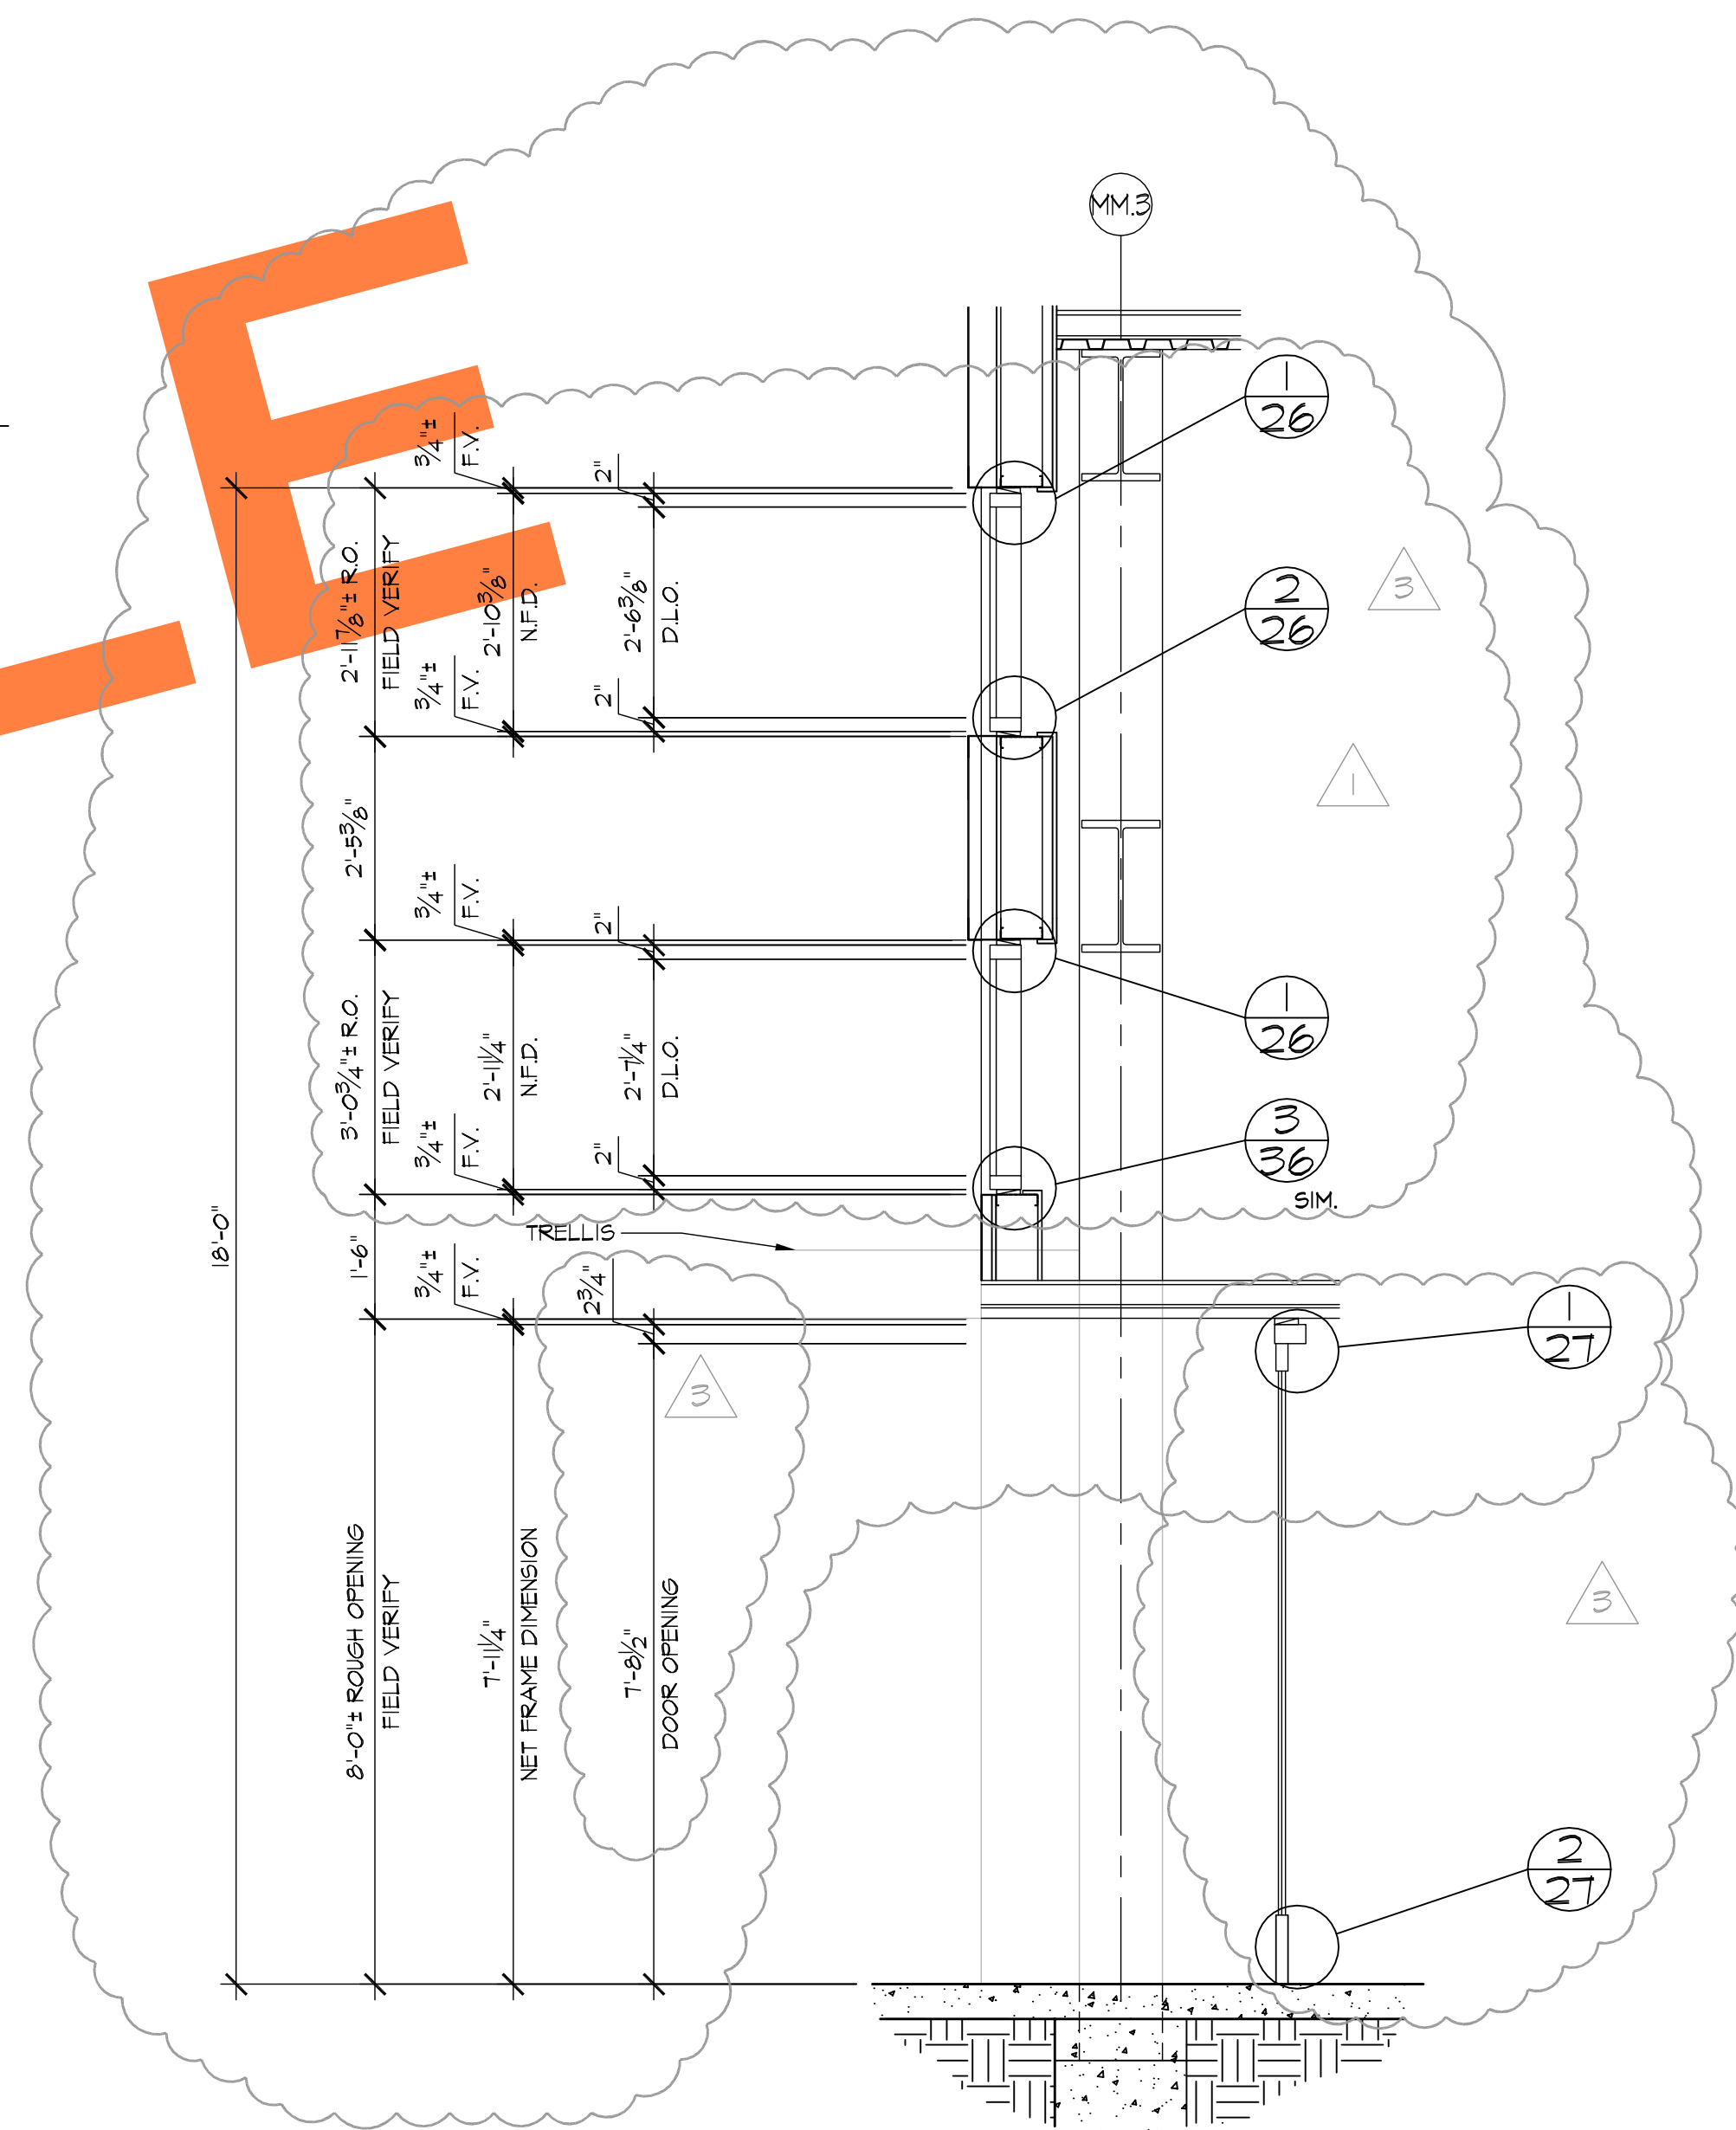


CC WALL SECTION
24 ARCH'L:

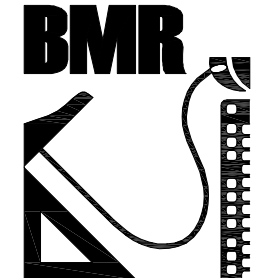REVISIONS		BY
△	4-23-07	BMR
△	6-11-07	BMR
△	12-17-07	CTB
△	3/6/08	CTB
△		
 BMR DRAFTING SERVICE SINCE 1988 23846 SUNNY MEAD BLVD. SUITE #6 MORENO VALLEY, CA 92553 B: (951) 243-7814 F: (951) 243-7873		
GLASS FACTORY 26383 BASE LINE HIGHLAND, CA 92346		AS-BUILT DRAWINGS
JOB NAME:	AGUA CALIENTE HOTEL ADDITION	
ARCHITECT:	VOA	
SHEET DESCRIPTION:	WALL SECTIONS	
DATE:	1/3/07	
SCALE:	1/2"=1'-0"	
DRAWN:	CTB	
JOB NO:	100-06	
SHEET NO:	24	

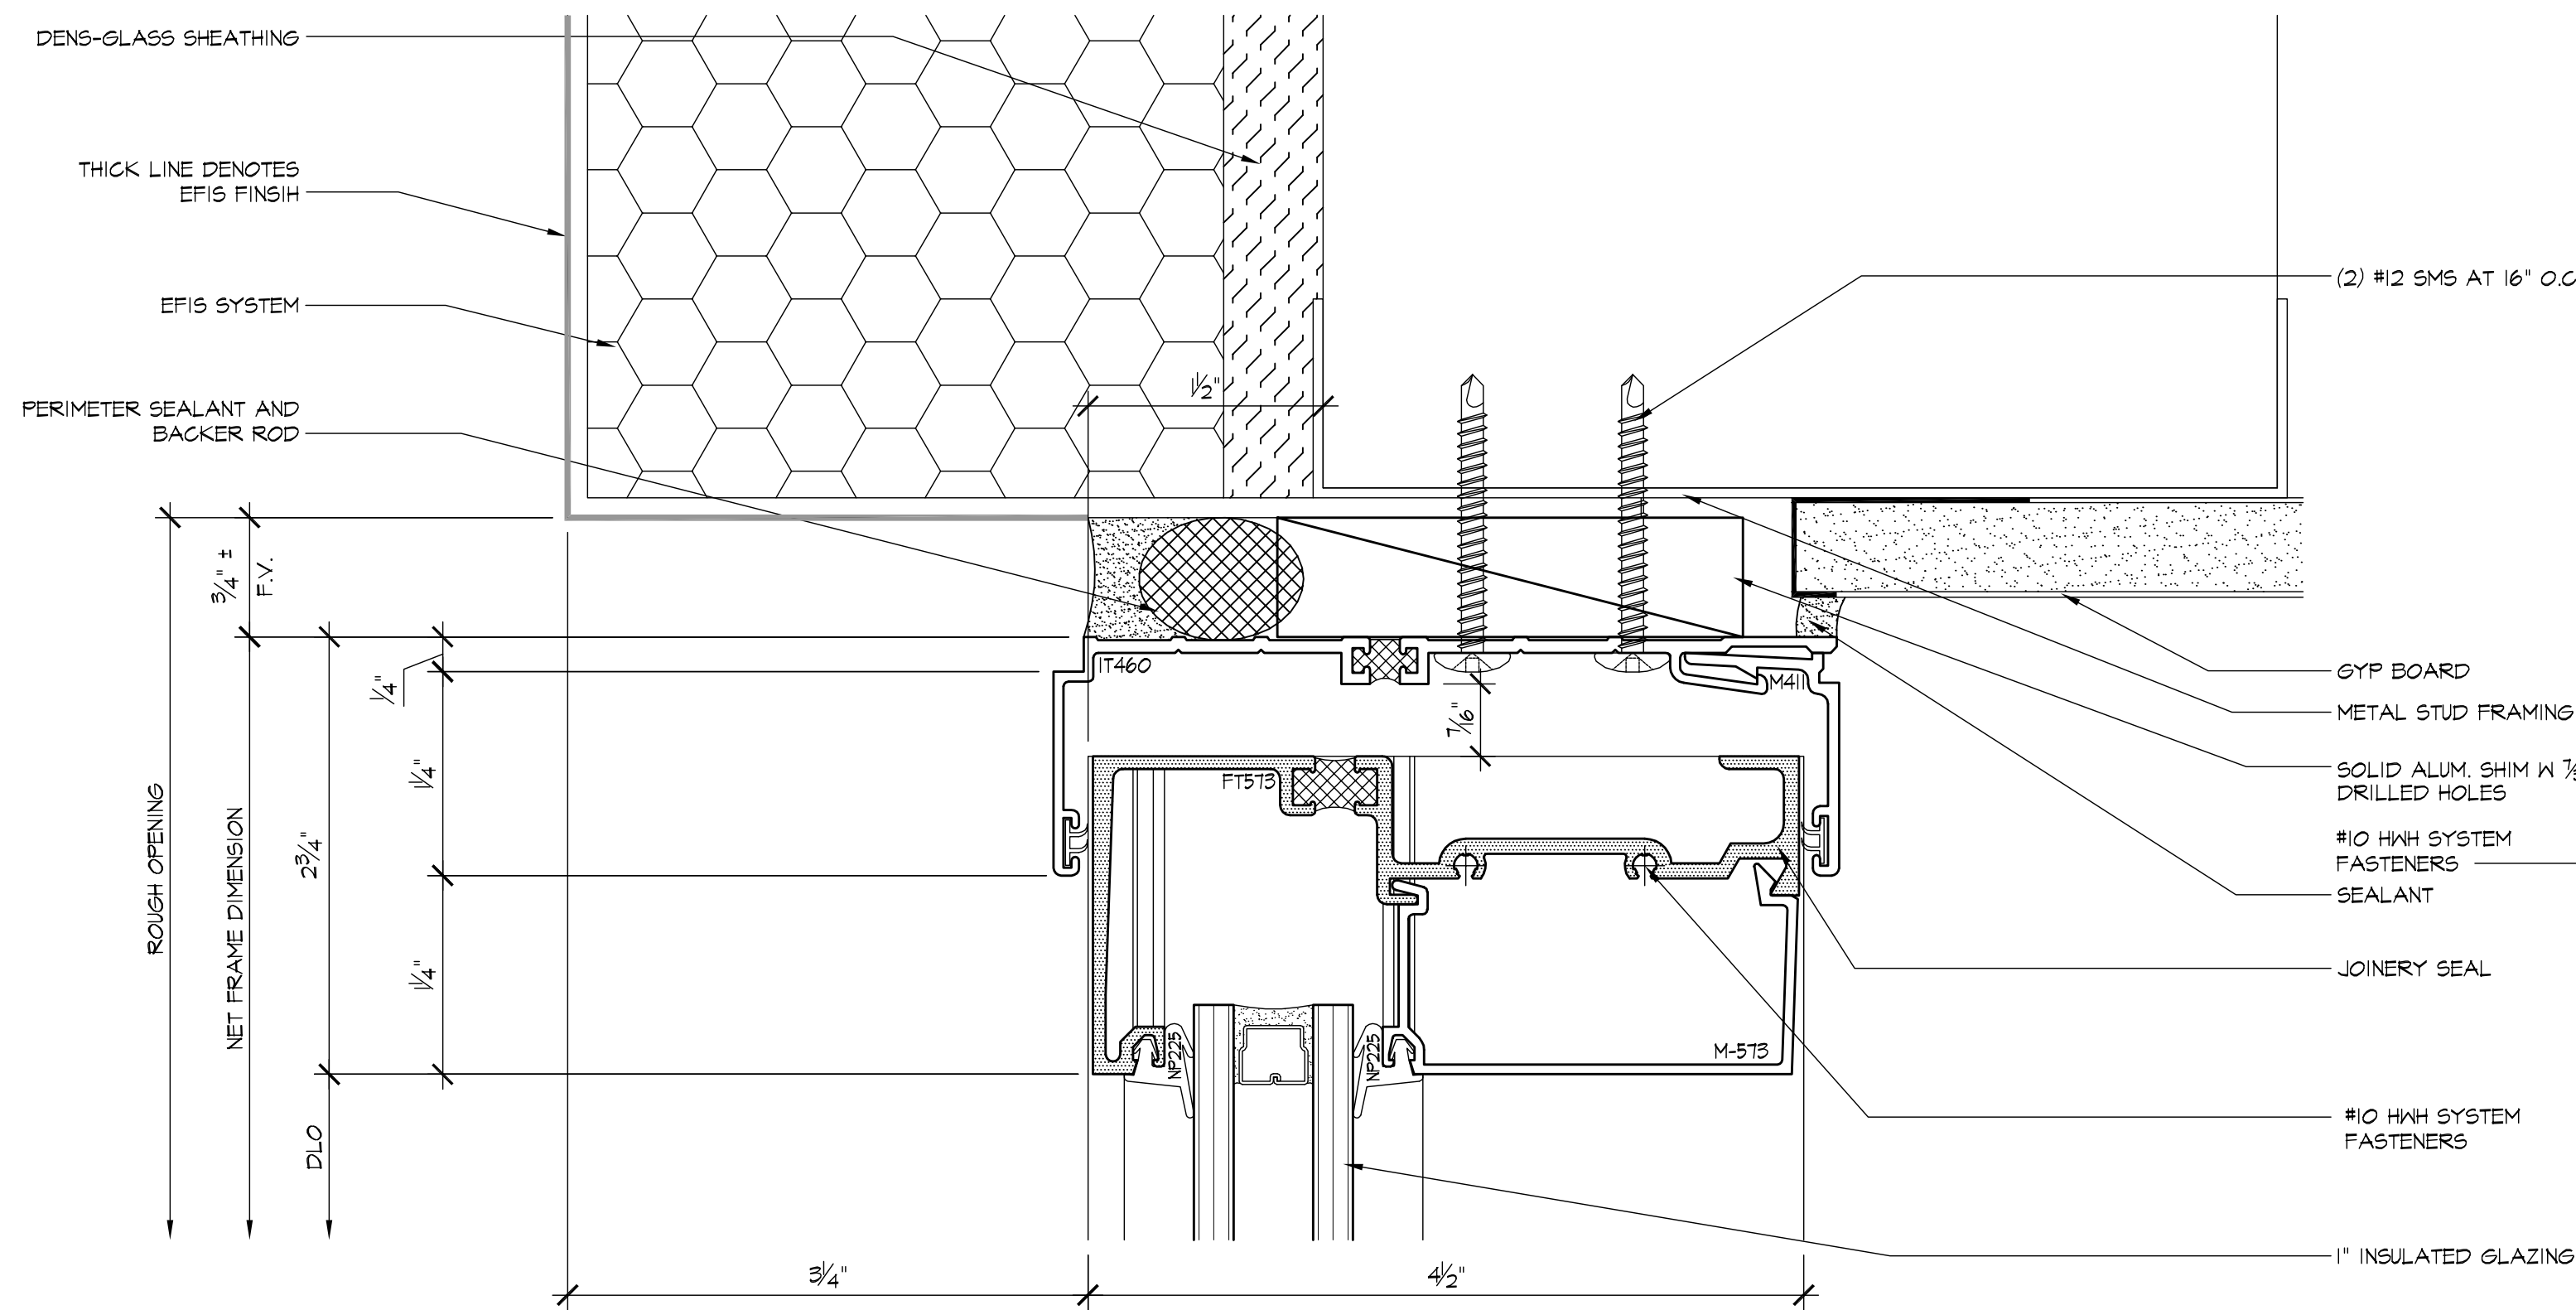

1 HEAD
26 ARCHL: 03/A620

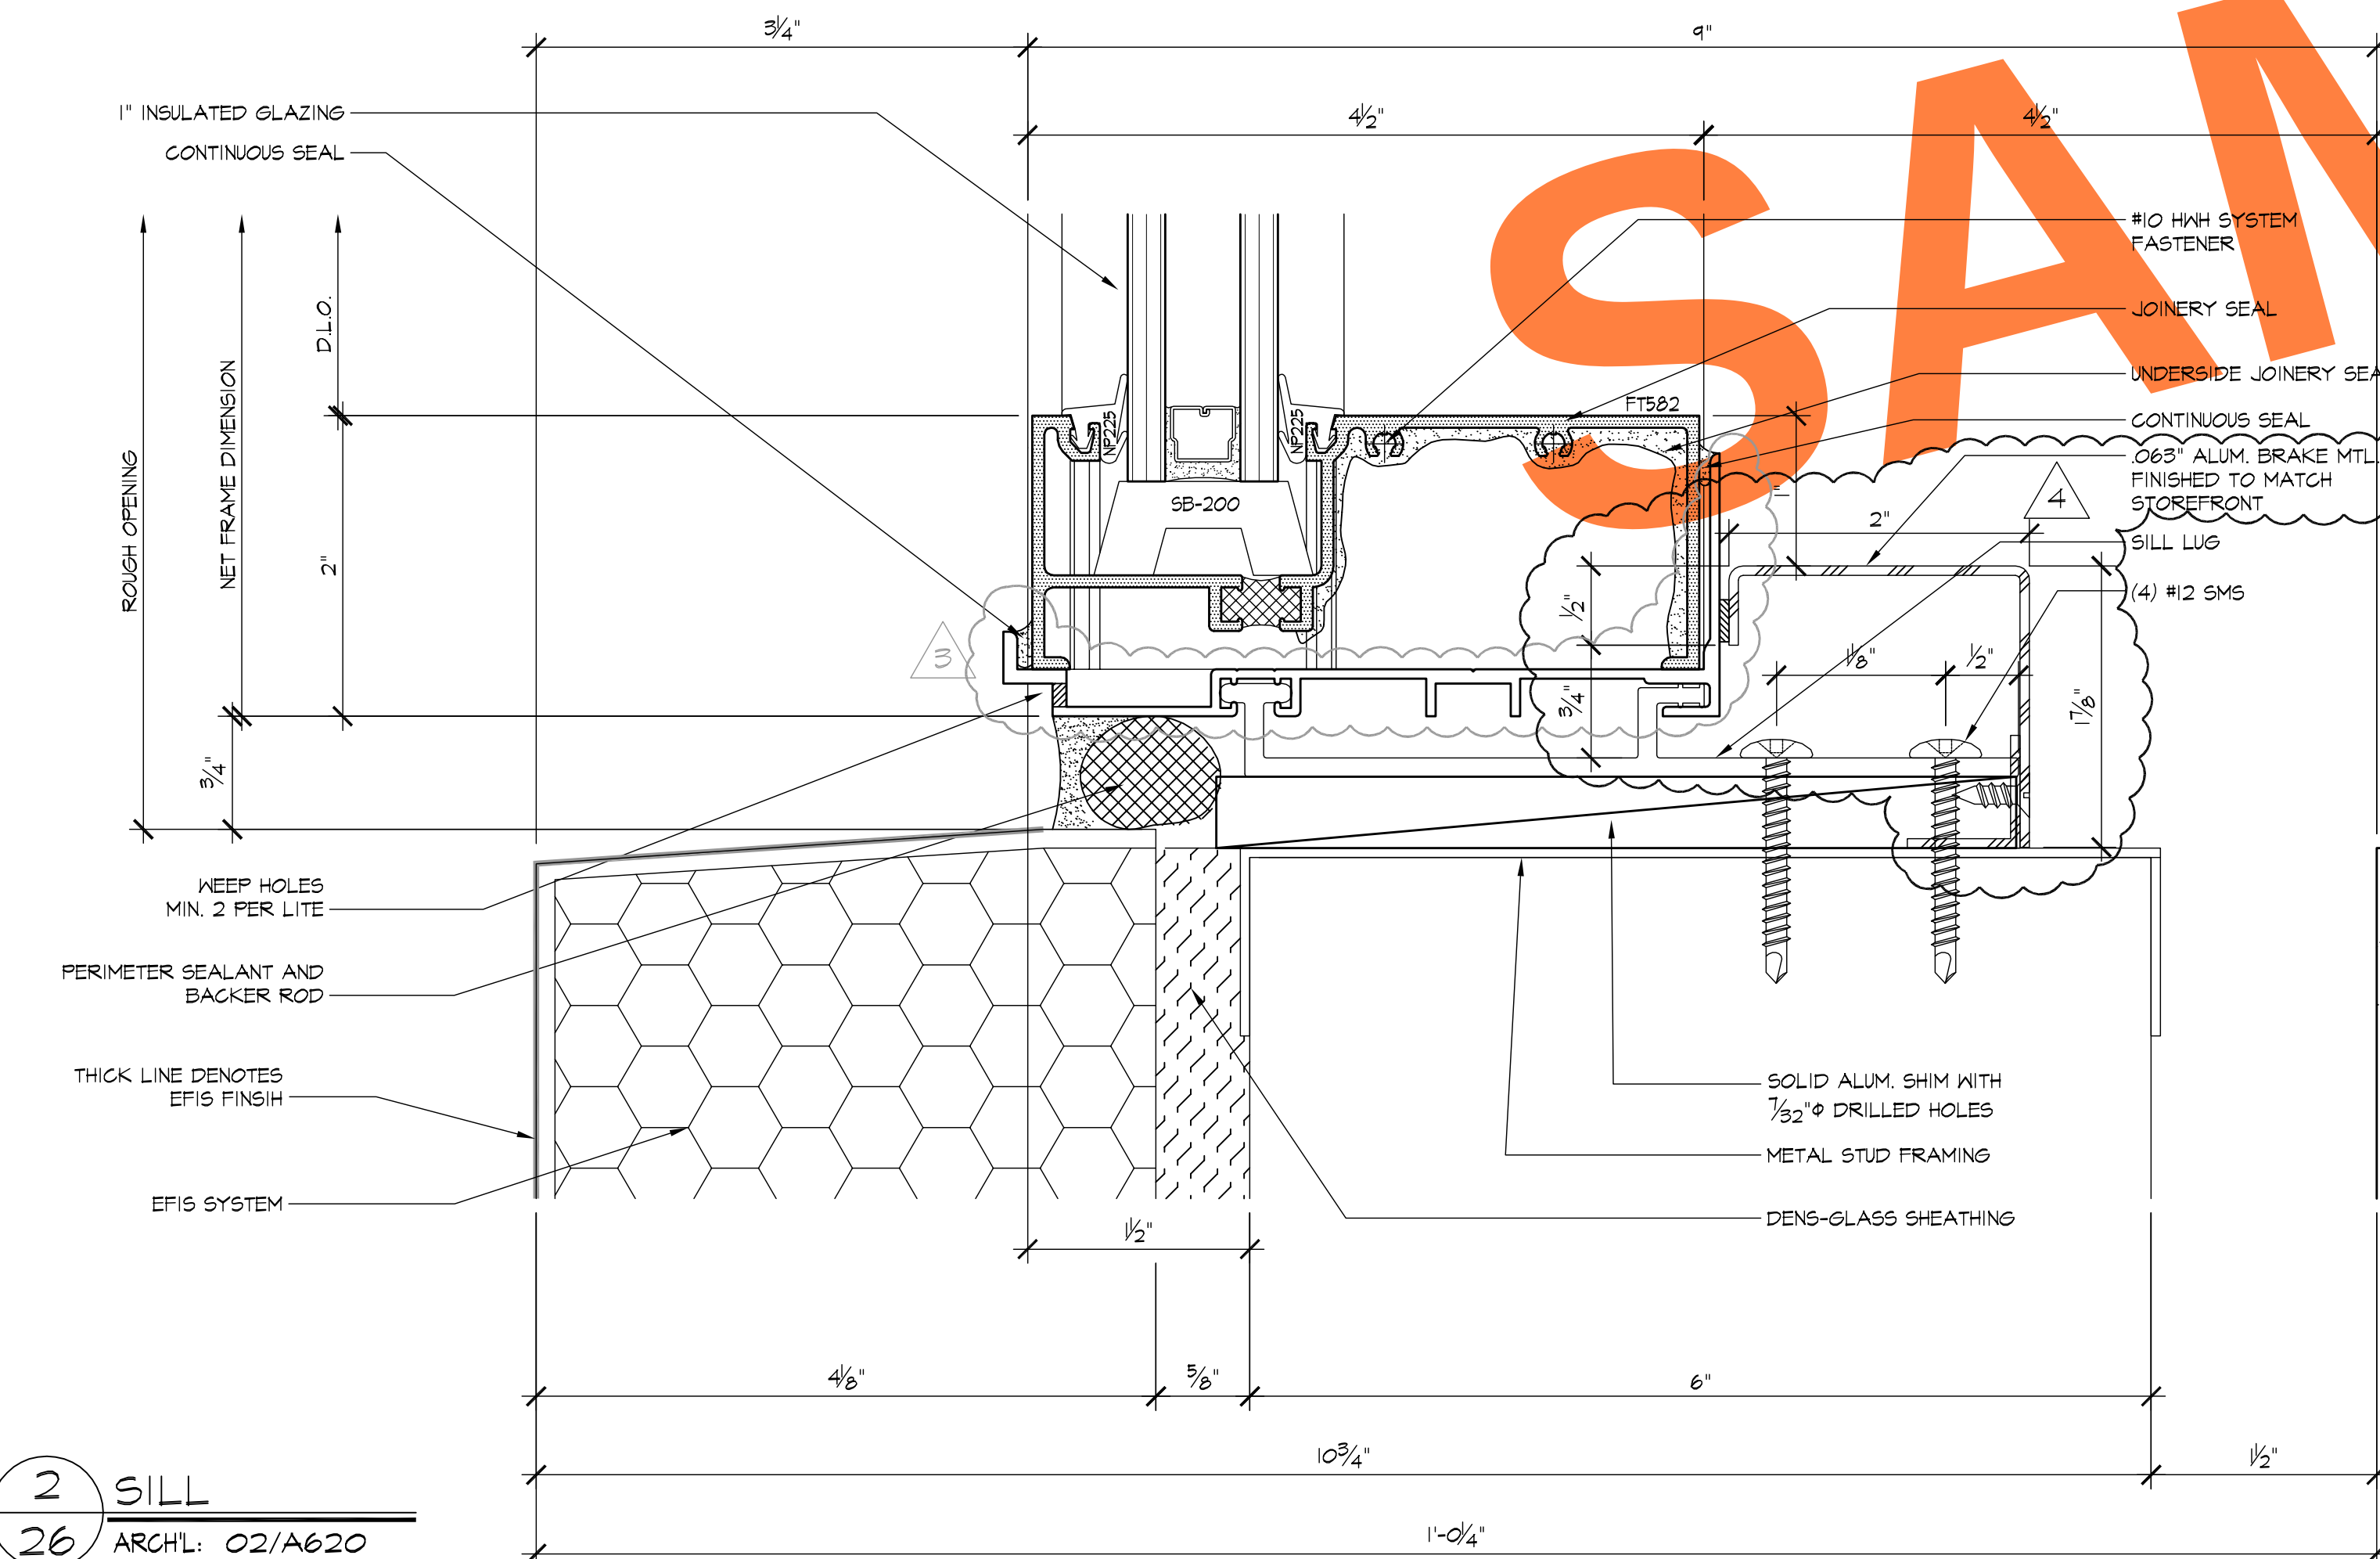

2 SILL
26 ARCHL: 02/A620

(2) #12 SMS AT 16" O.C.

GYP BOARD

METAL STUD FRAMING

SOLID ALUM. SHIM W/ 7/32\"/>

#10 HH SYSTEM FASTENERS

SEALANT

JOINERY SEAL


#10 HH SYSTEM FASTENERS

1\"/>

EDGE BLOCK

3 JAMB
26 ARCHL: 04/A620

DLO 2" 3/4" ± F.V.
NET FRAME DIMENSION
ROUGH OPENING

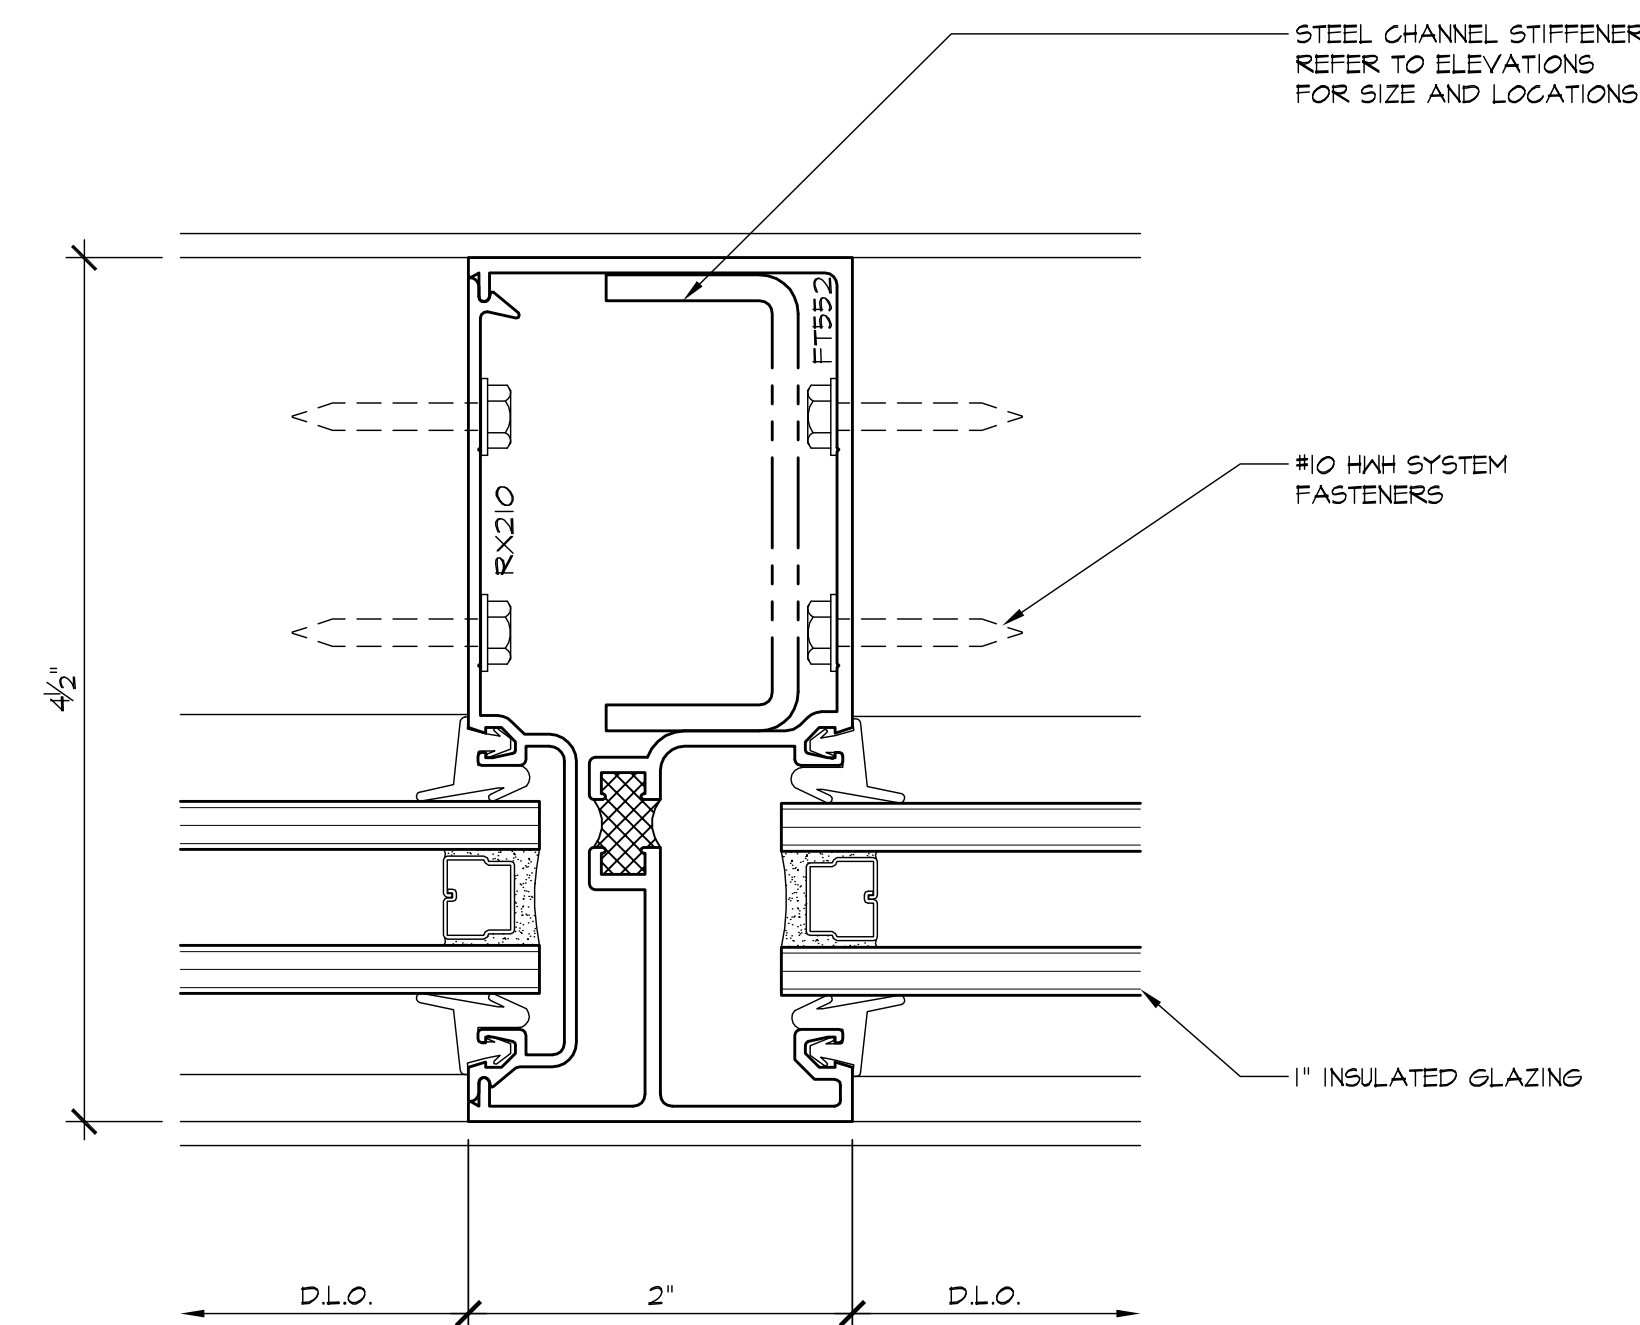

4 VERTICAL
26 ARCHL:


REVISIONS	BY
△ 4-23-07	BMR
△ 6-11-07	BMR
△ 12-17-07	CTB
△ 3/6/08	CTB
△	

BMR
DRAFTING SERVICE
SINCE 1988
23846 SUNNYMEAD BLVD.
SUITE #9
MORENO VALLEY, CA 92553
B: (951) 243-7814
F: (951) 243-7873

GLASS FACTORY
26383 BASE LINE
HIGHLAND, CA 92346

AS-BUILT DRAWINGS

JOB NAME:	AGUA CALIENTE HOTEL ADDITION
ARCHITECT:	VOA
SHEET DESCRIPTION:	DETAILS
DATE:	1/3/07
SCALE:	FULL
DRAWN:	CTB
JOB NO:	100-06
SHEET NO:	26

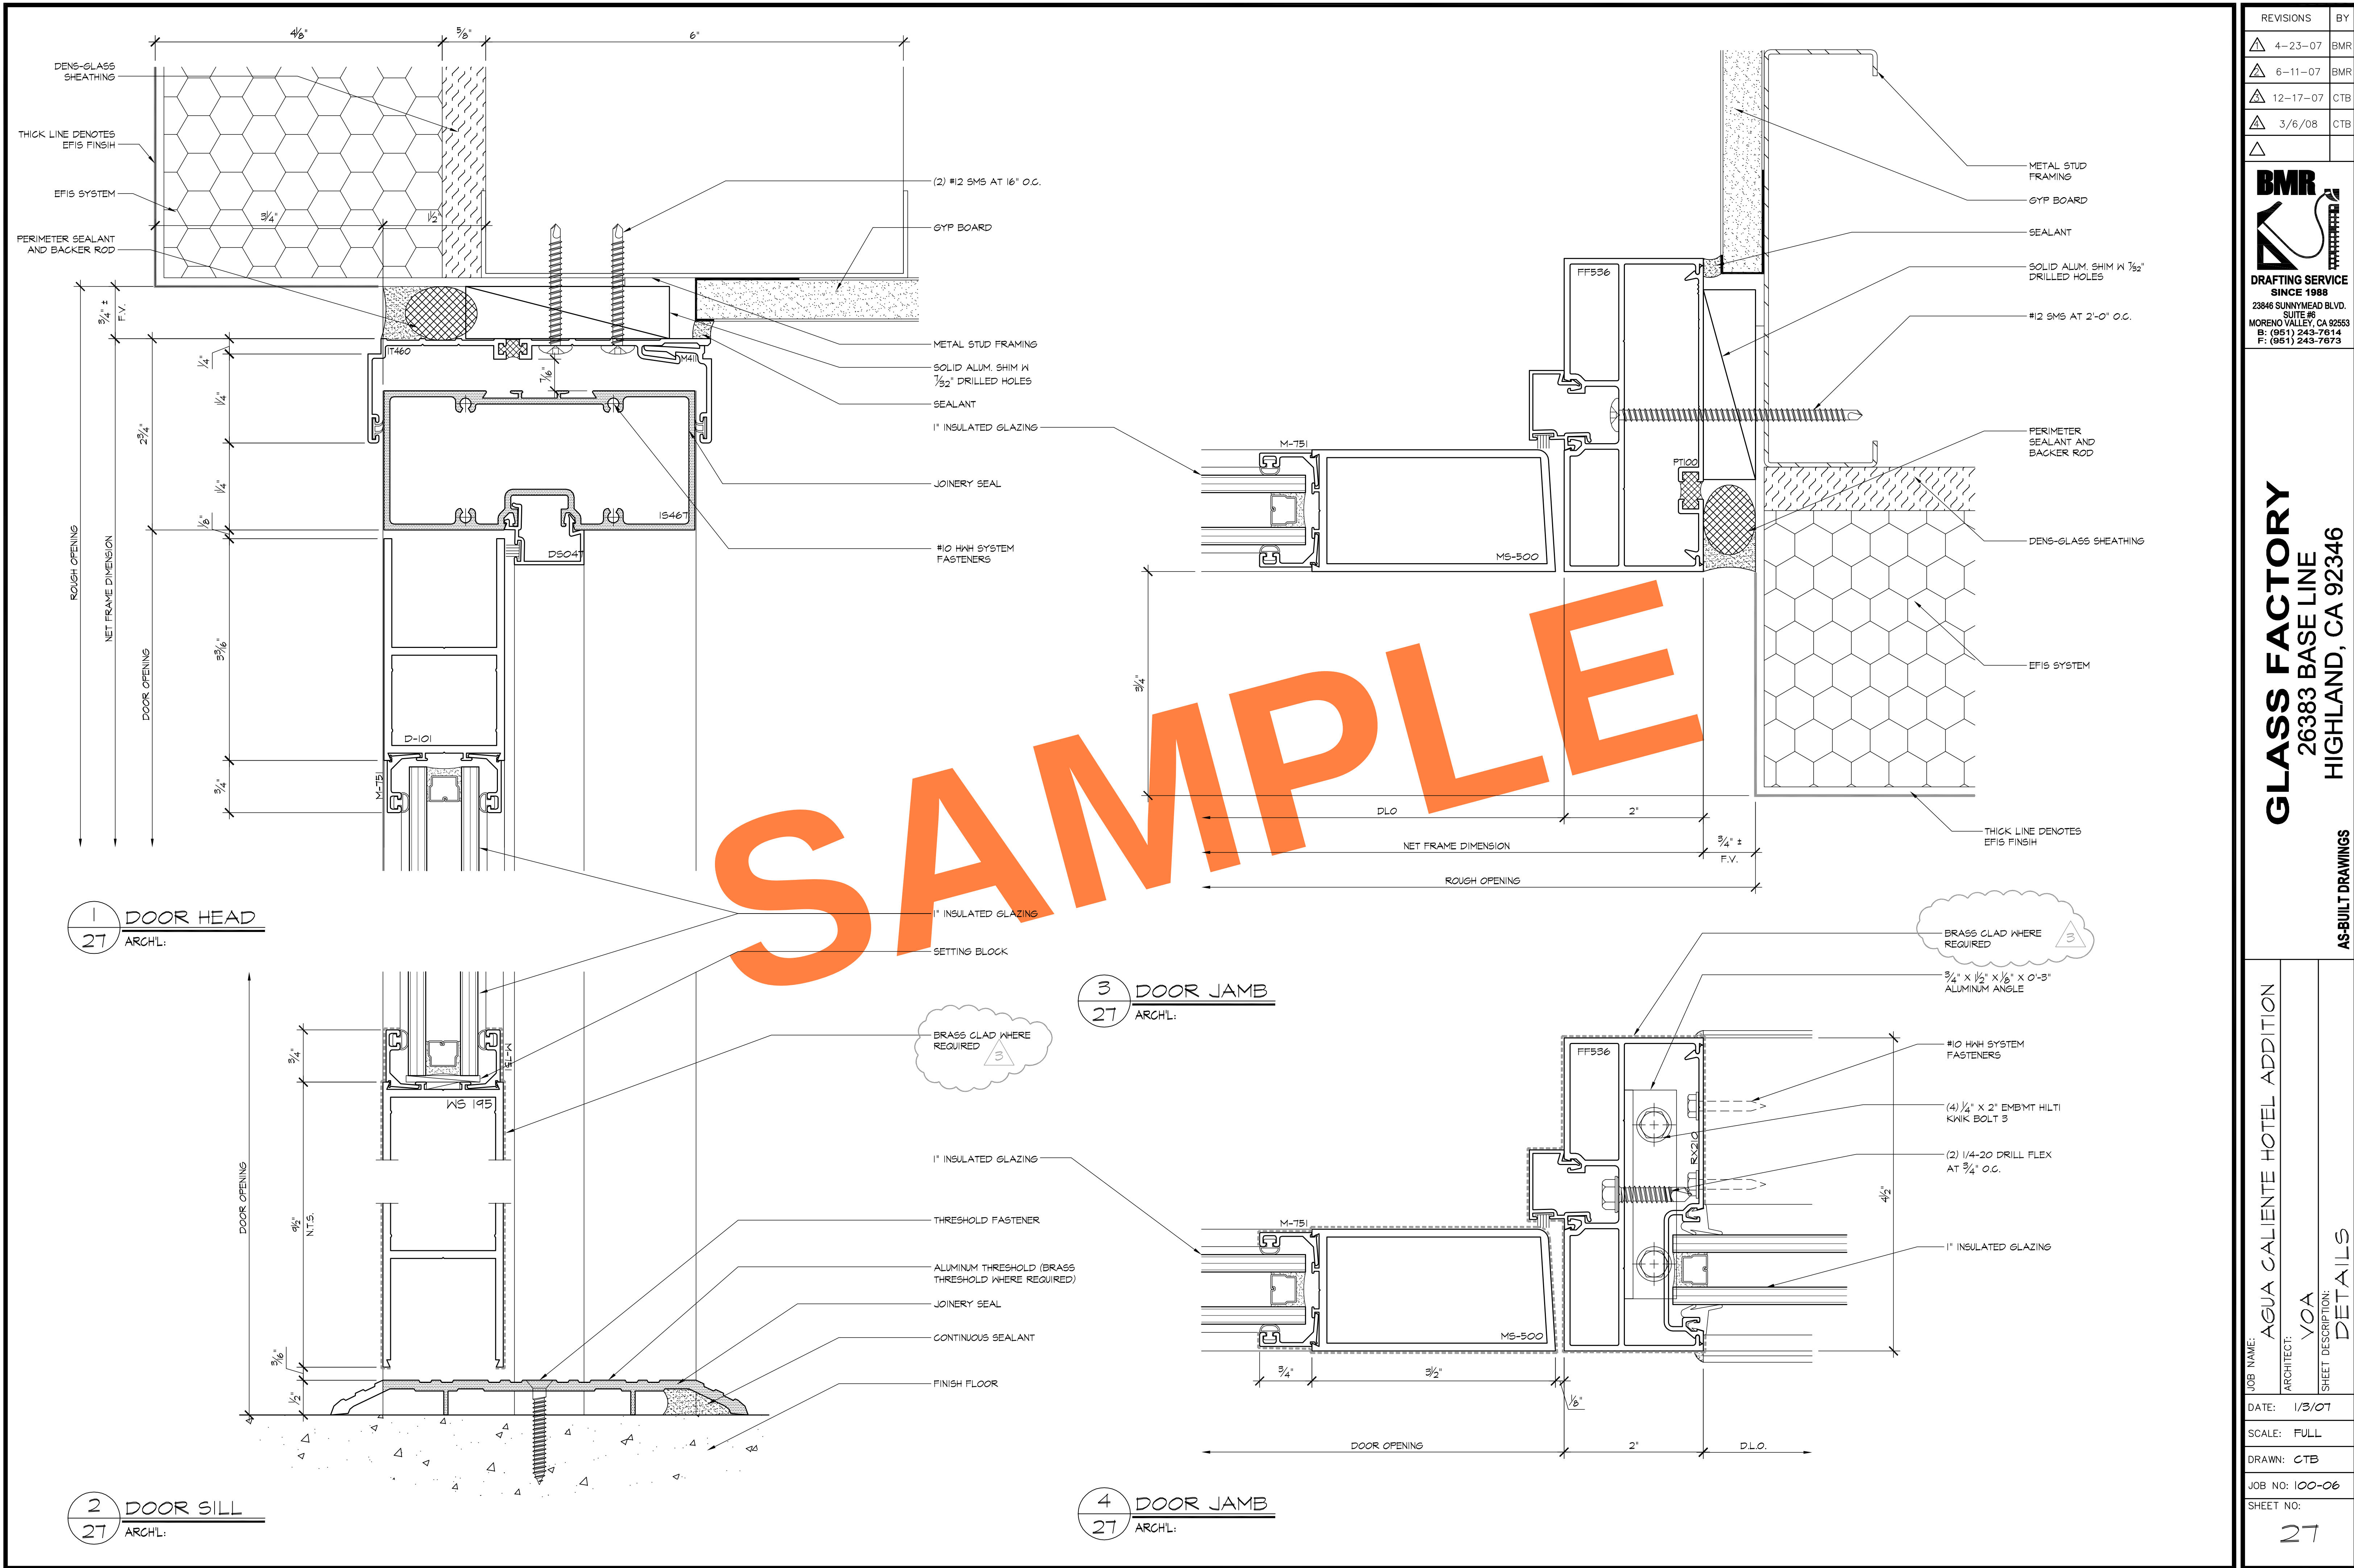

REVISIONS	BY
△ 4-23-07	BMR
△ 6-11-07	BMR
△ 12-17-07	CTB
△ 3/6/08	CTB
△	



GLASS FACTORY
26383 BASE LINE
HIGHLAND, CA 92346

AS-BUILT DRAWINGS

JOB NAME:	AGUA CALIENTE HOTEL ADDITION
ARCHITECT:	VOA
SHEET DESCRIPTION:	DETAILS
DATE:	1/3/07
SCALE:	FULL
DRAWN:	CTB
JOB NO:	100-06
SHEET NO:	27



THIS DTL. NOT USED

2 DOOR JAMB
28 ARCH'L:

REVISIONS	BY
1 4-23-07	BM
2 6-11-07	BM
3 12-17-07	CT
4 3/6/08	CT




GLASS FACTORY
26383 BASE LINE
HIGHLAND, CA 92346


AS-BUILT DRAWINGS

JOB NAME:	AGUA CALIENTE HOTEL ADDITION
ARCHITECT:	VOA
SHEET DESCRIPTION:	DETAILS
DATE:	1/31/07
SCALE:	FULL
DRAWN:	CTB
JOB NO:	100-06
SHEET NO:	


28

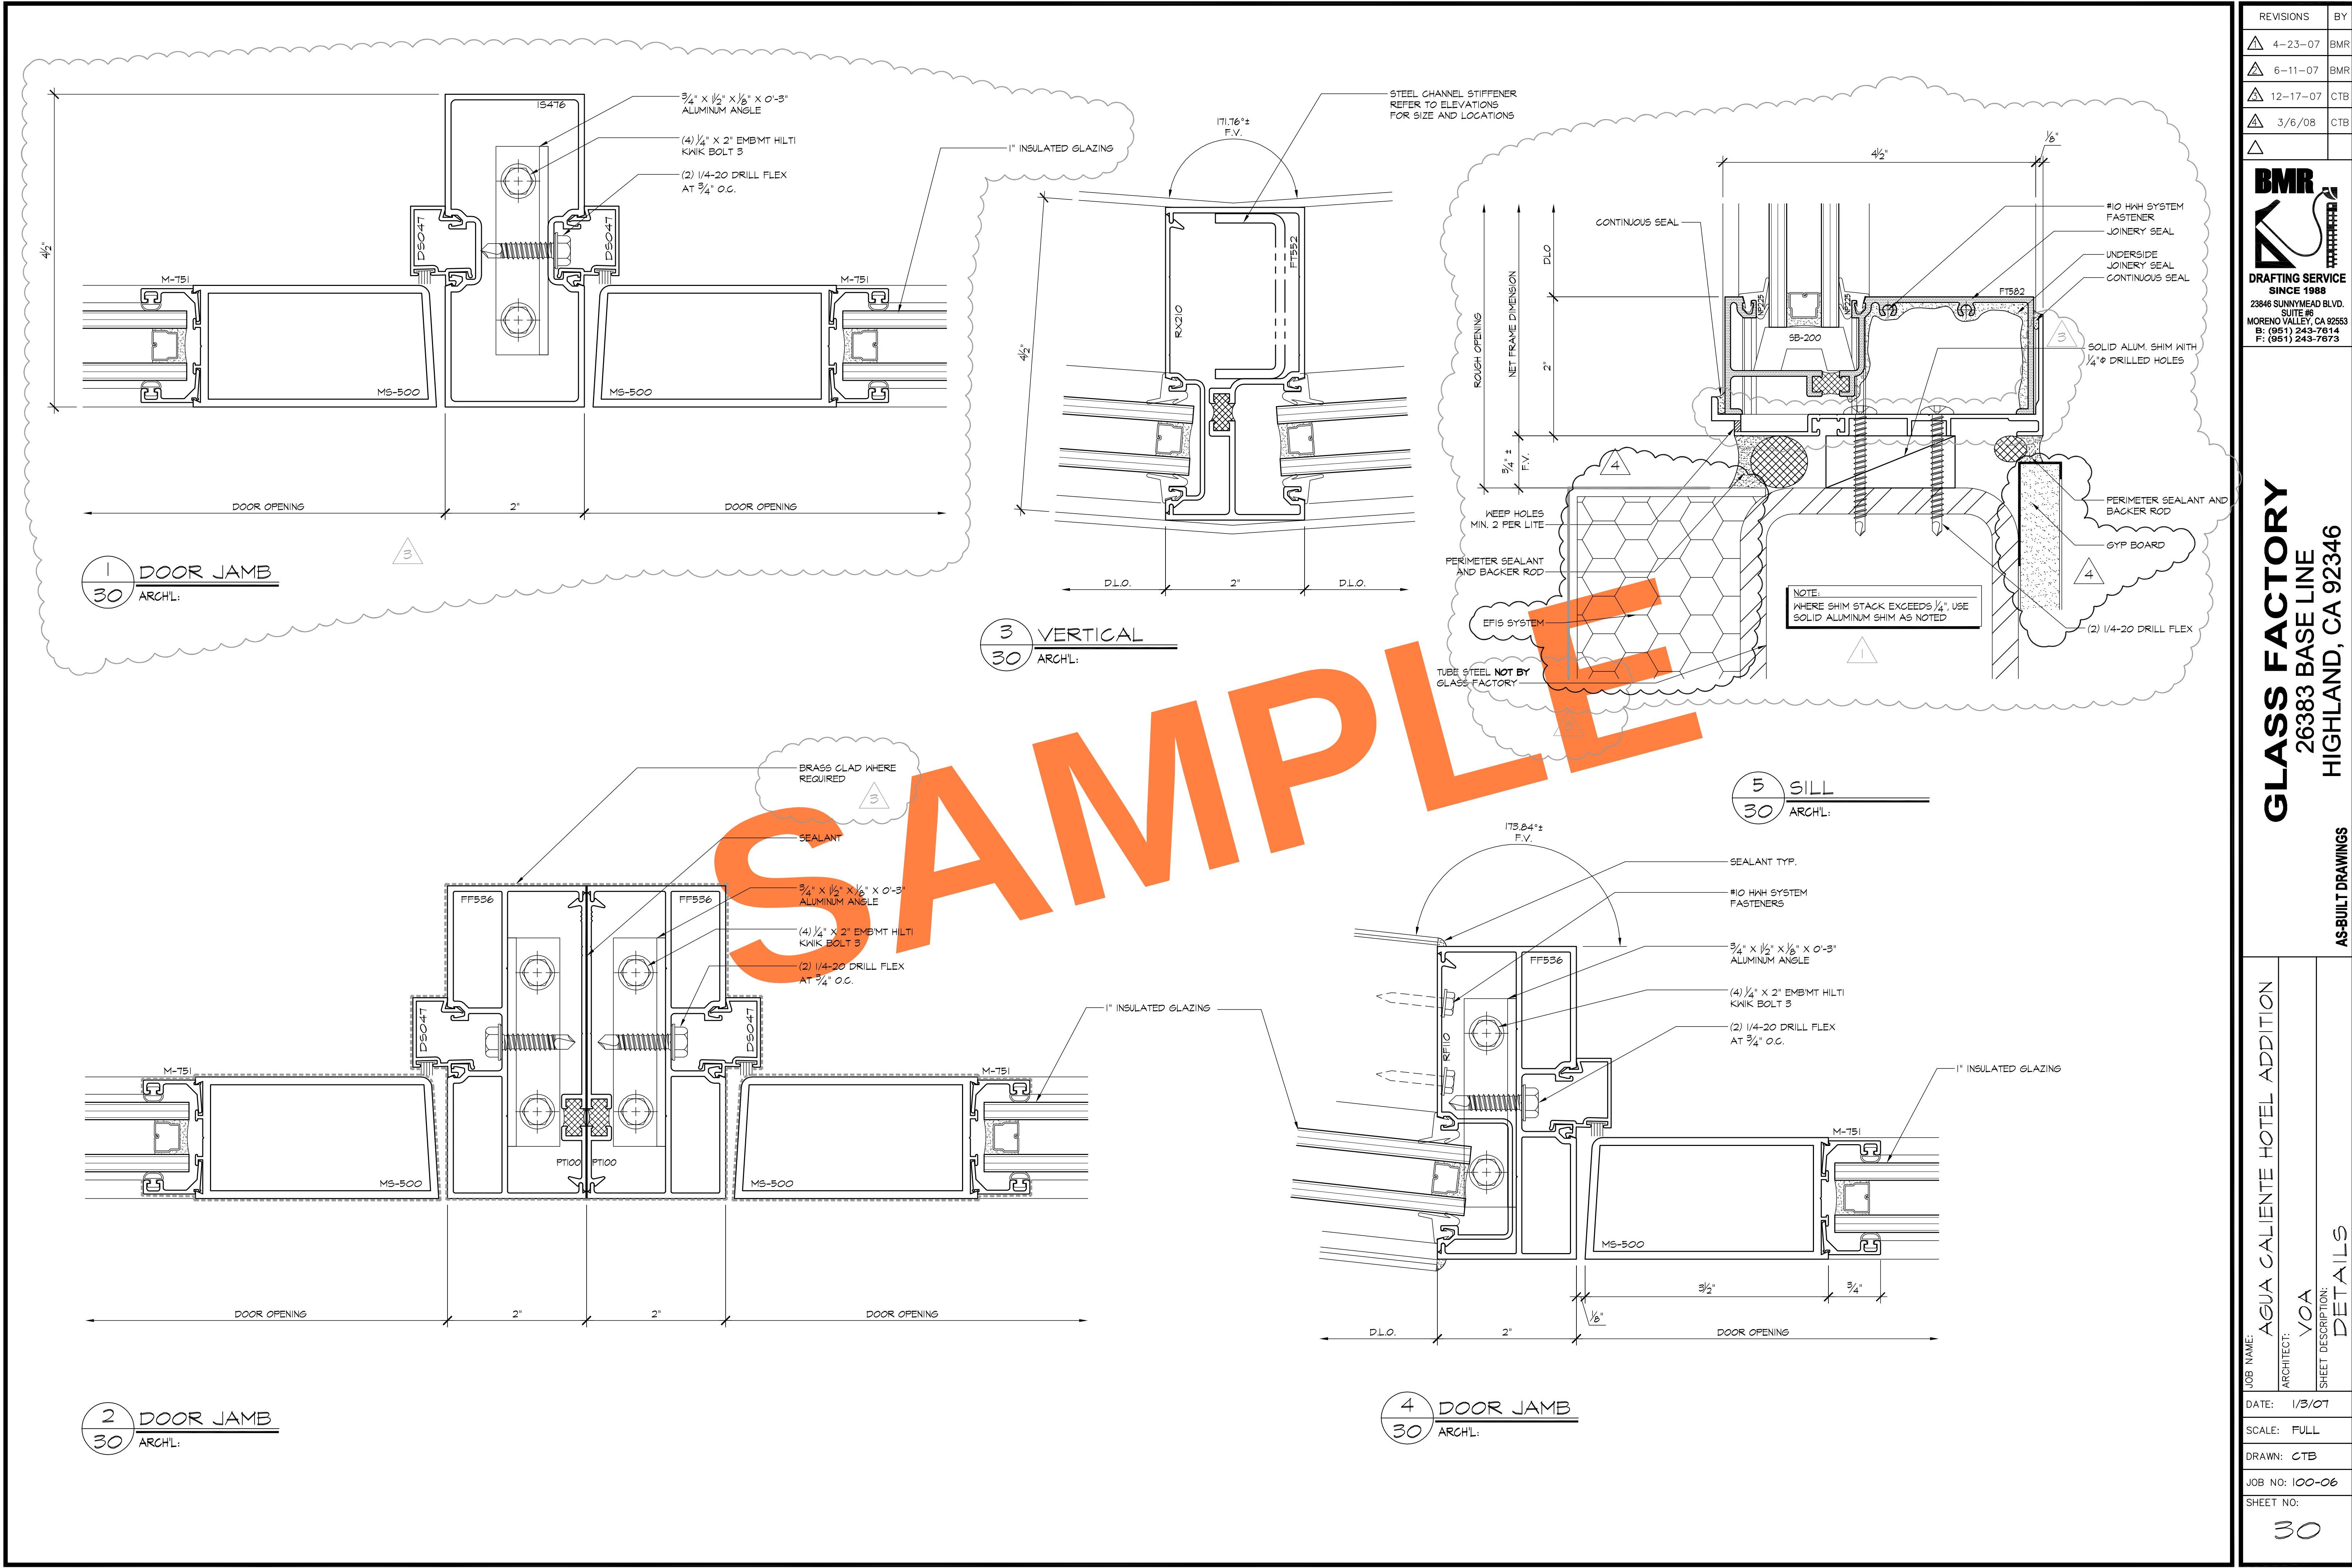

REVISIONS		BY
△	4-23-07	BMR
△	6-11-07	BMR
△	12-17-07	CTB
△	3/6/08	CTB
△		
BMR DRAFTING SERVICE SINCE 1988 23846 SUNNYMEAD BLVD. SUITE #9 MORENO VALLEY, CA 92553 P: (951) 243-7814 F: (951) 243-7873 GLASS FACTORY 26383 BASE LINE HIGHLAND, CA 92346		
AS-BUILT DRAWINGS		
JOB NAME:	AGUA CALIENTE HOTEL ADDITION	
ARCHITECT:	VOA	
SHEET DESCRIPTION:	DETAILS	
DATE:	1/3/07	
SCALE:	FULL	
DRAWN:	CTB	
JOB NO:	100-06	
SHEET NO:	30	

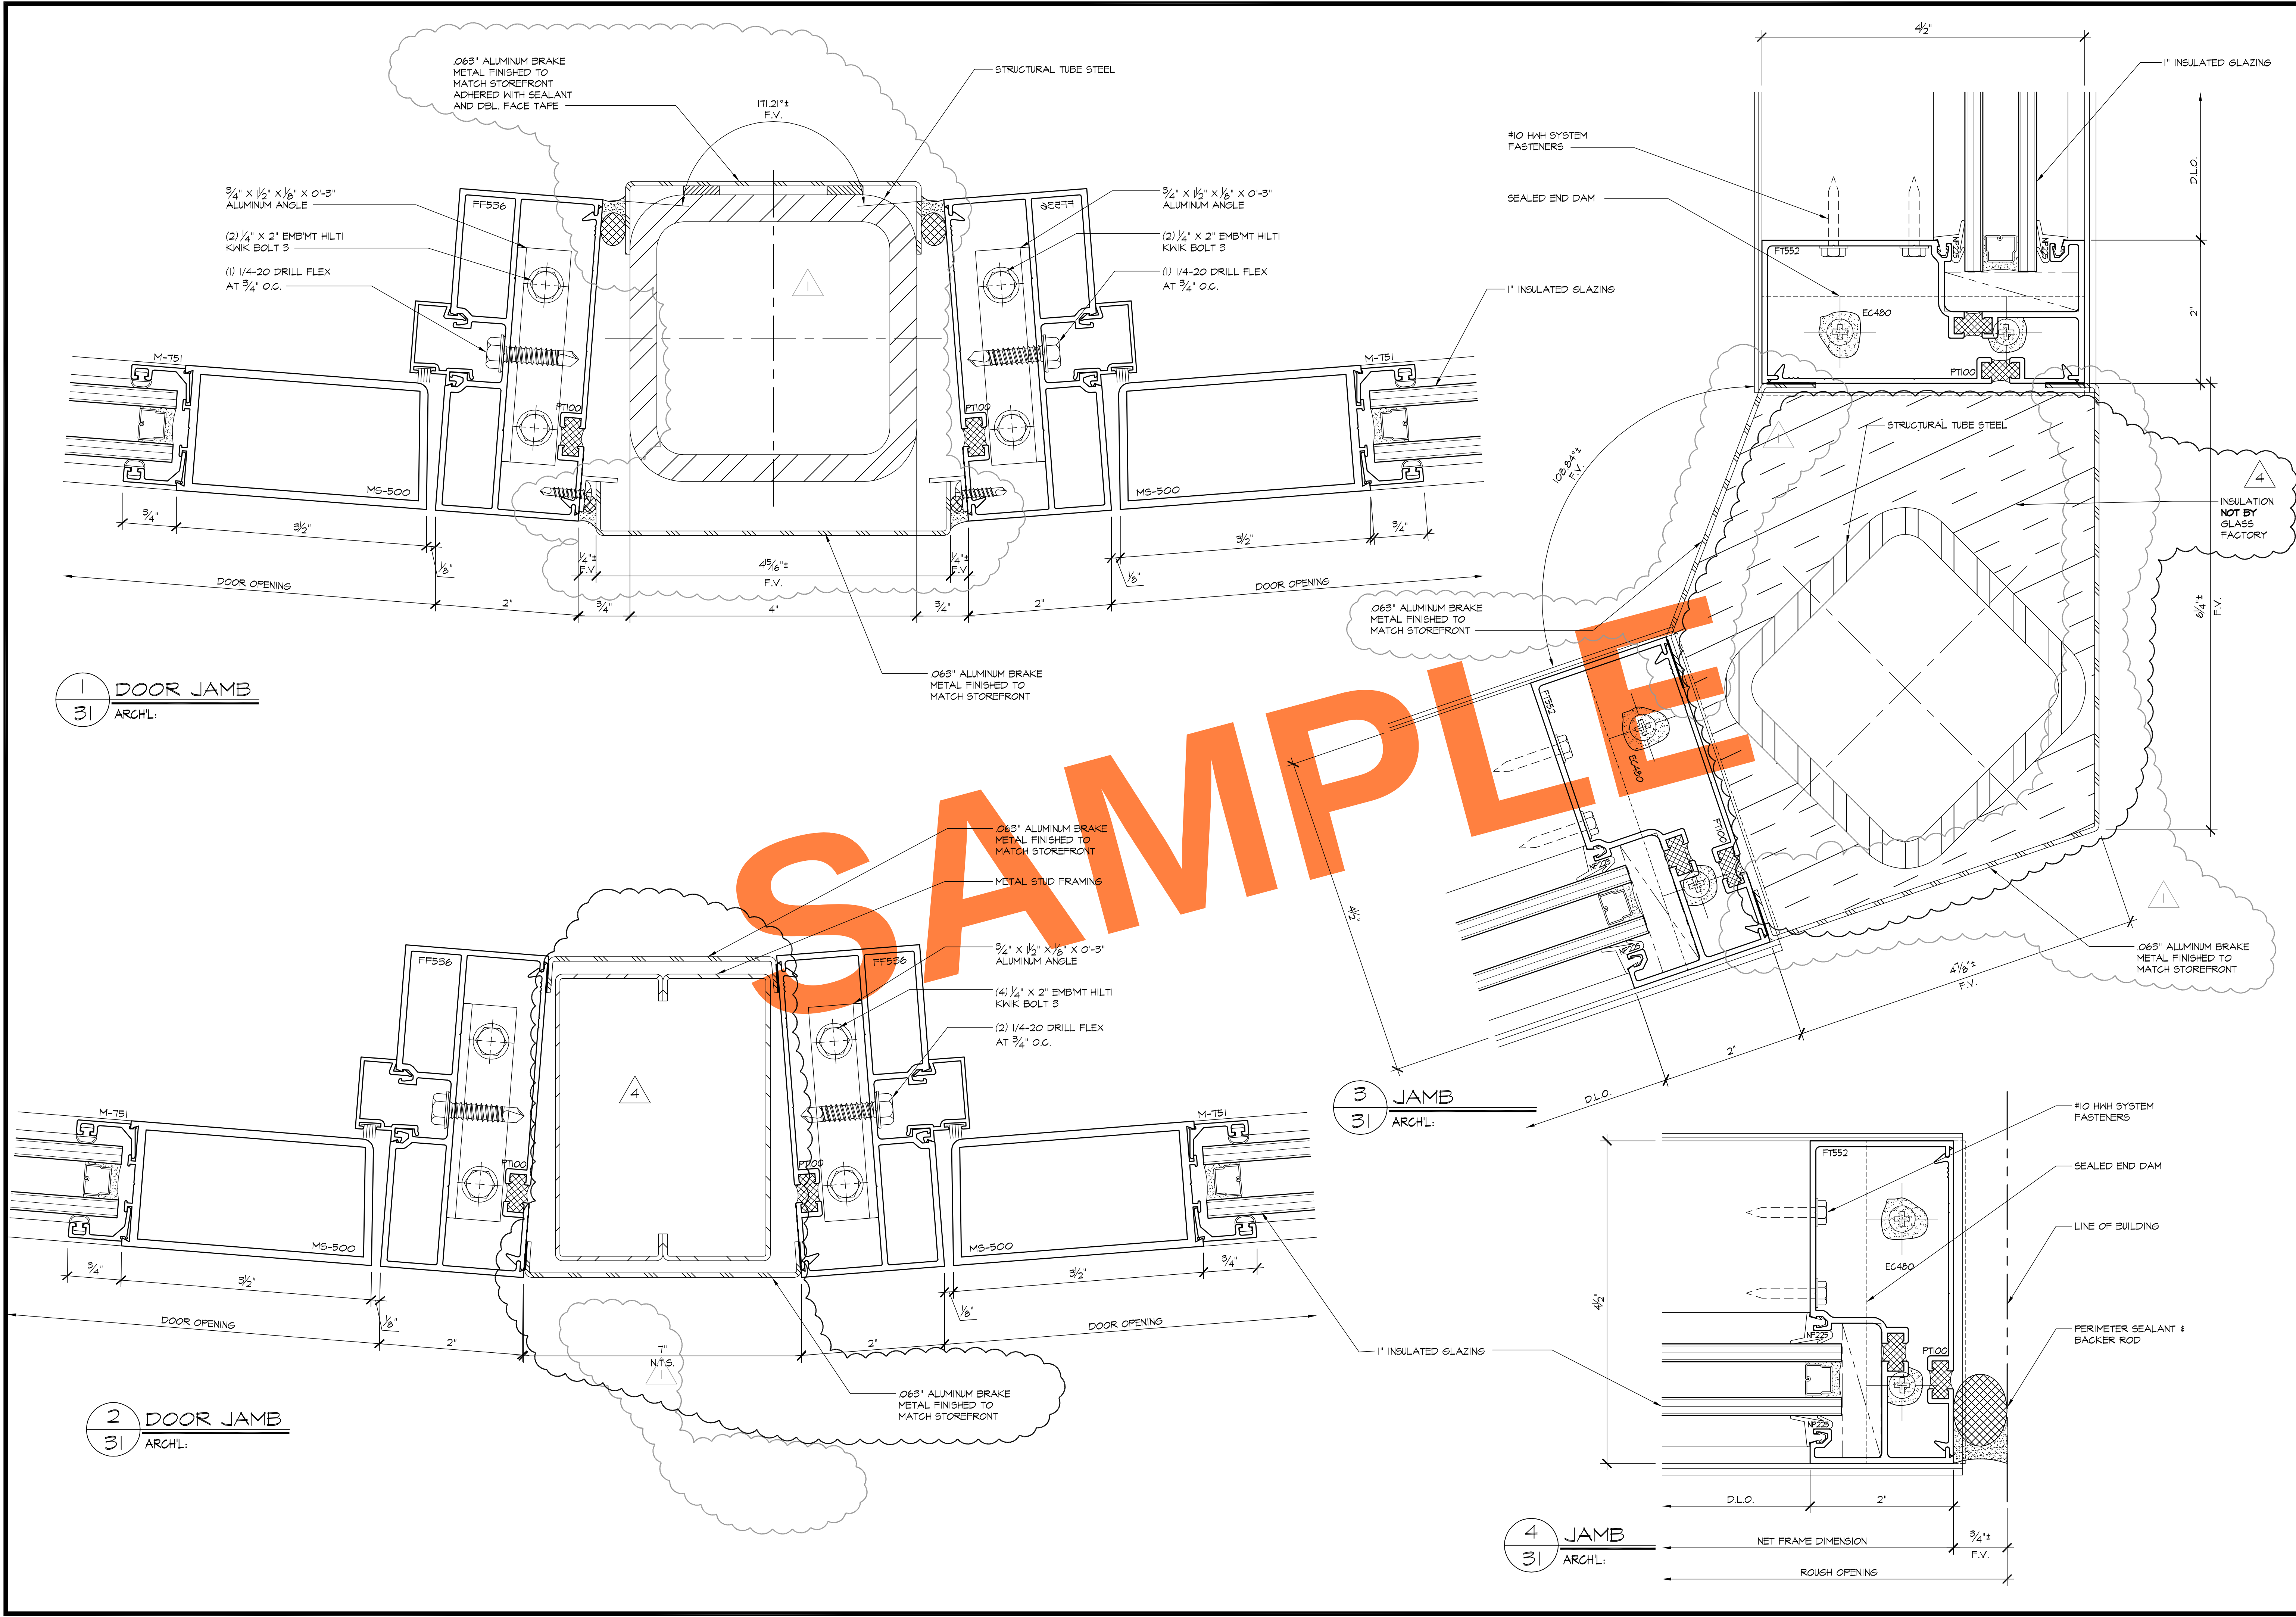

REVISIONS		BY
△	4-23-07	BMR
△	6-11-07	BMR
△	12-17-07	CTB
△	3/6/08	CTB
△		
BMR DRAFTING SERVICE SINCE 1988 23846 SUNNYMEAD BLVD. SUITE #9 MORENO VALLEY, CA 92553 P: (951) 243-7814 F: (951) 243-7873		
GLASS FACTORY 26383 BASE LINE HIGHLAND, CA 92346		
AS-BUILT DRAWINGS		
JOB NAME:	AGUA CALIENTE HOTEL ADDITION	
ARCHITECT:	VOA	
SHEET DESCRIPTION:	DETAILS	
DATE:	1/3/07	
SCALE:	FULL	
DRAWN:	CTB	
JOB NO:	100-06	
SHEET NO:	31	

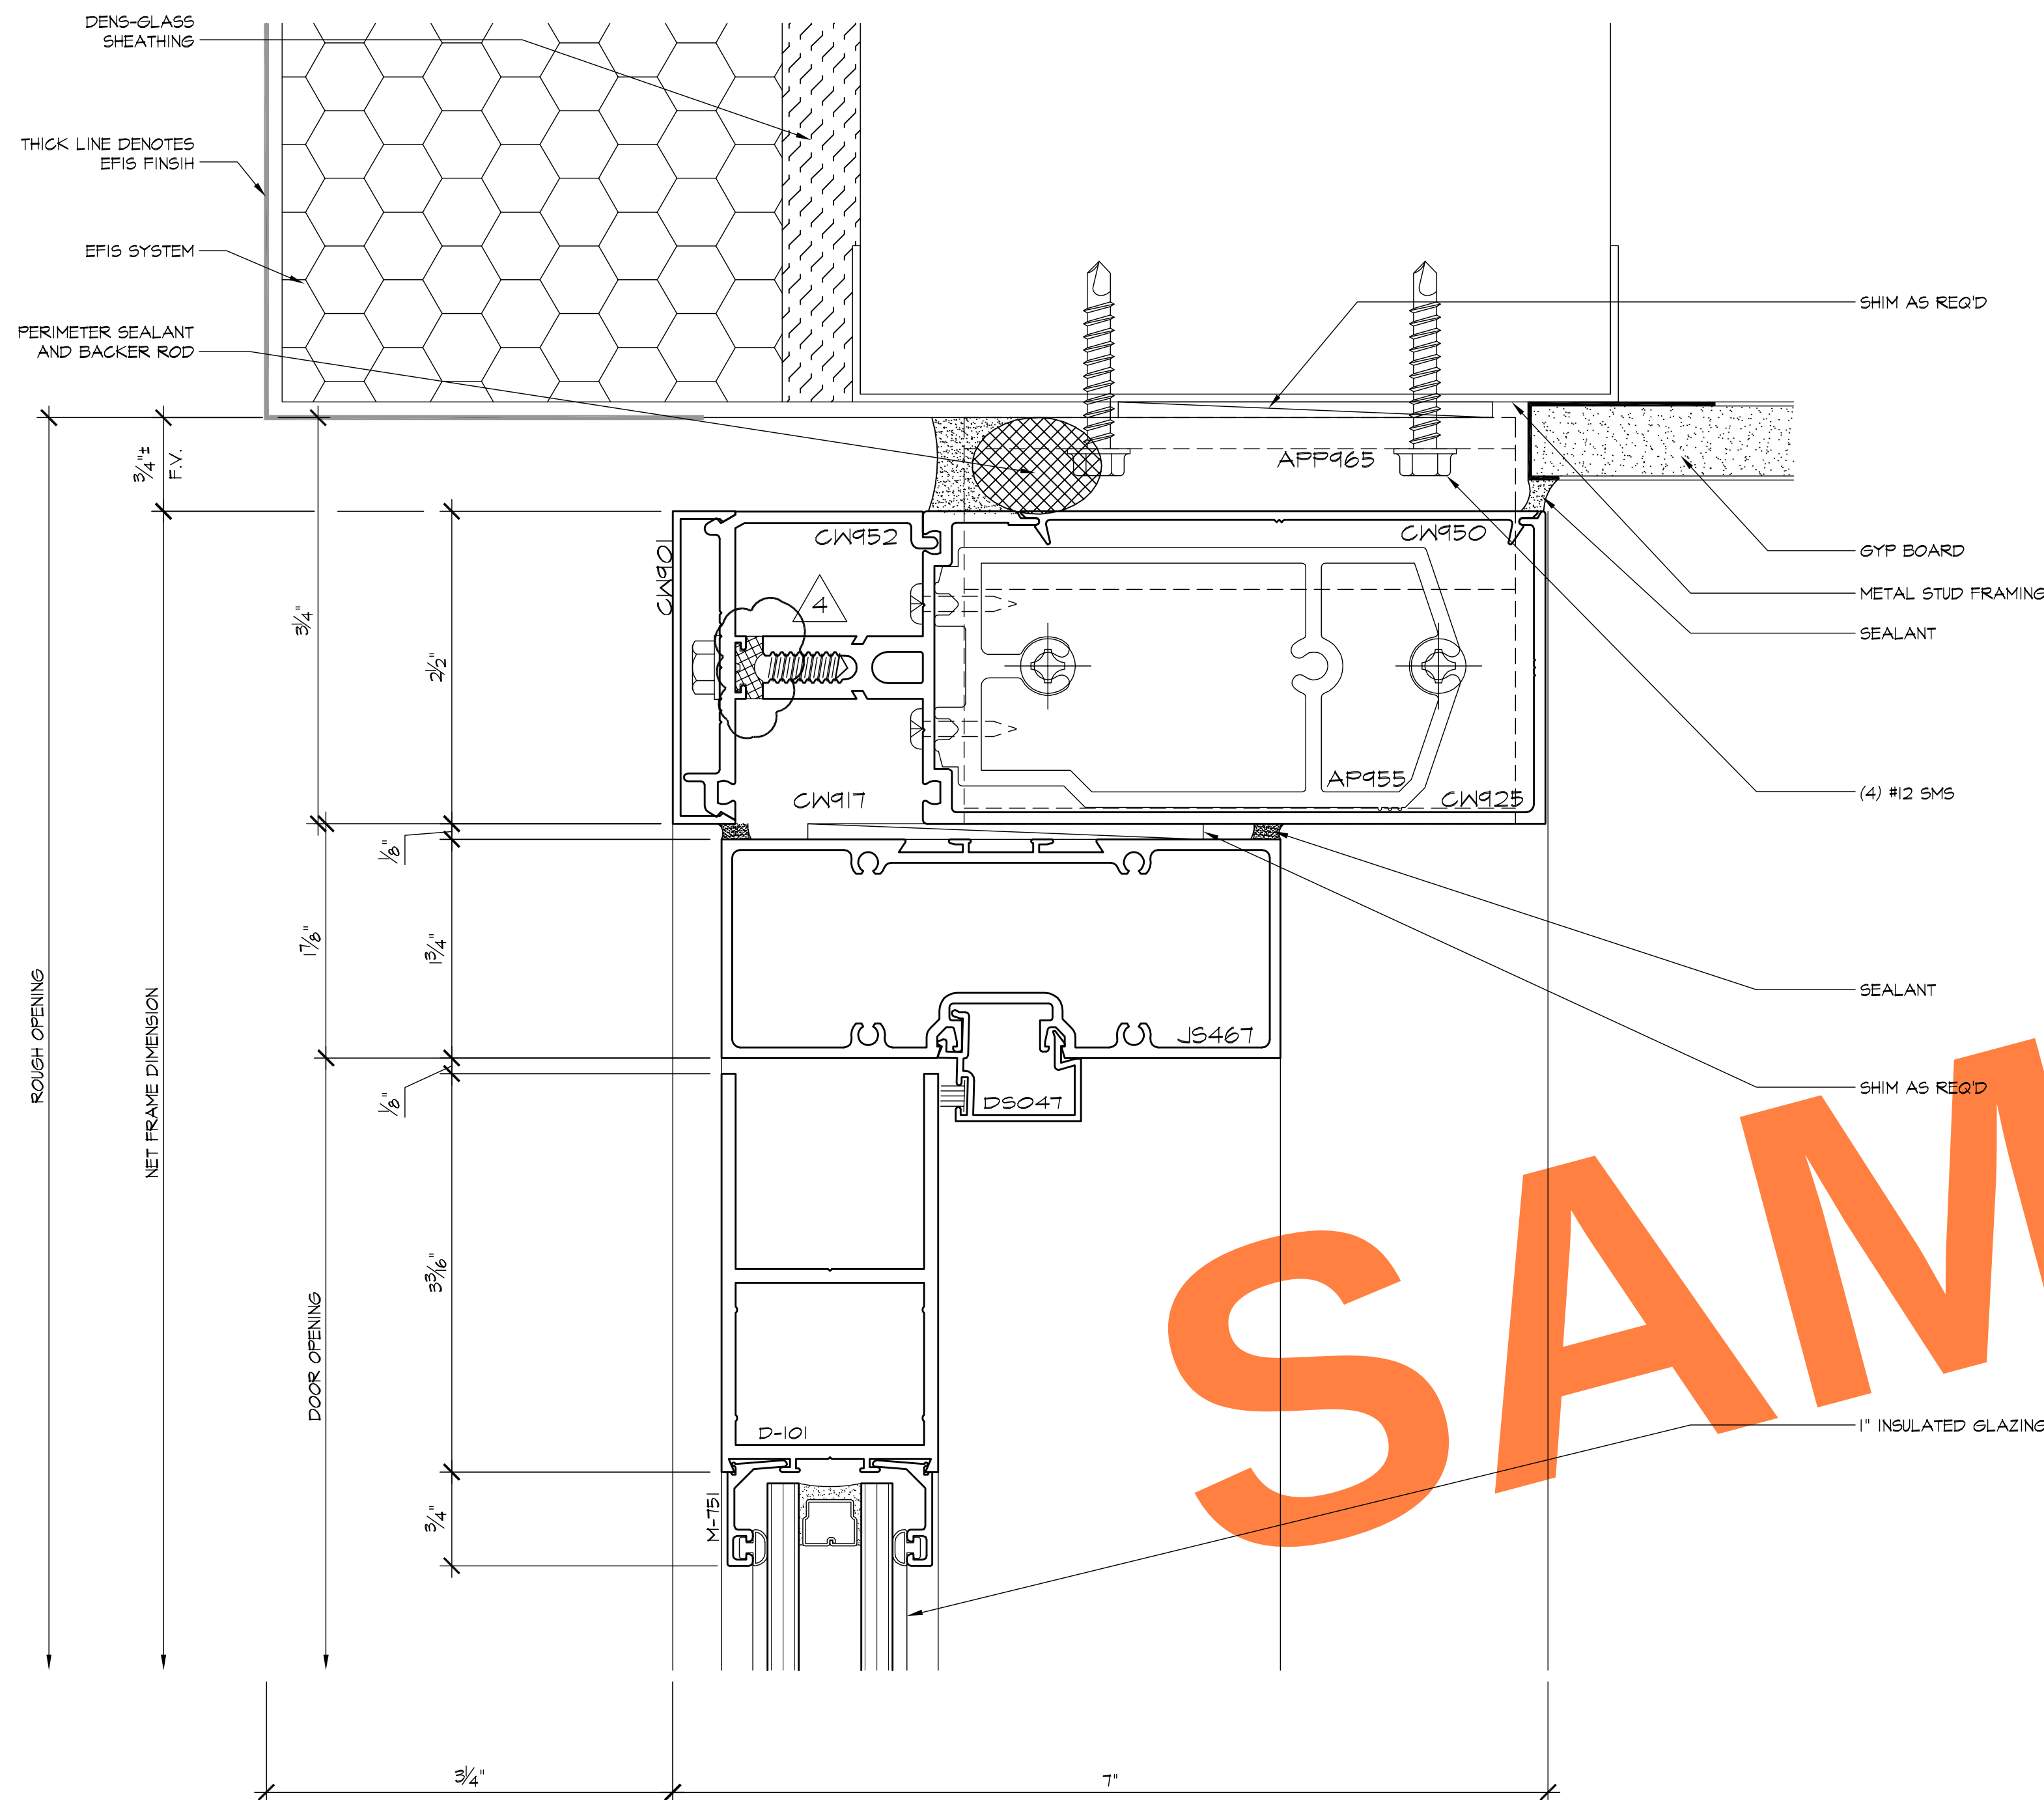


1 DOOR HEAD
32 ARCHL:

NOTE:

PLACEMENT OF ALL CURTAIN WALL SYSTEMS TO BE COORDINATED WITH KHS & S FOR PROPER PLACEMENT ON EFIS WALLS - TYPICAL



2 DOOR HEADER
32 ARCHL:

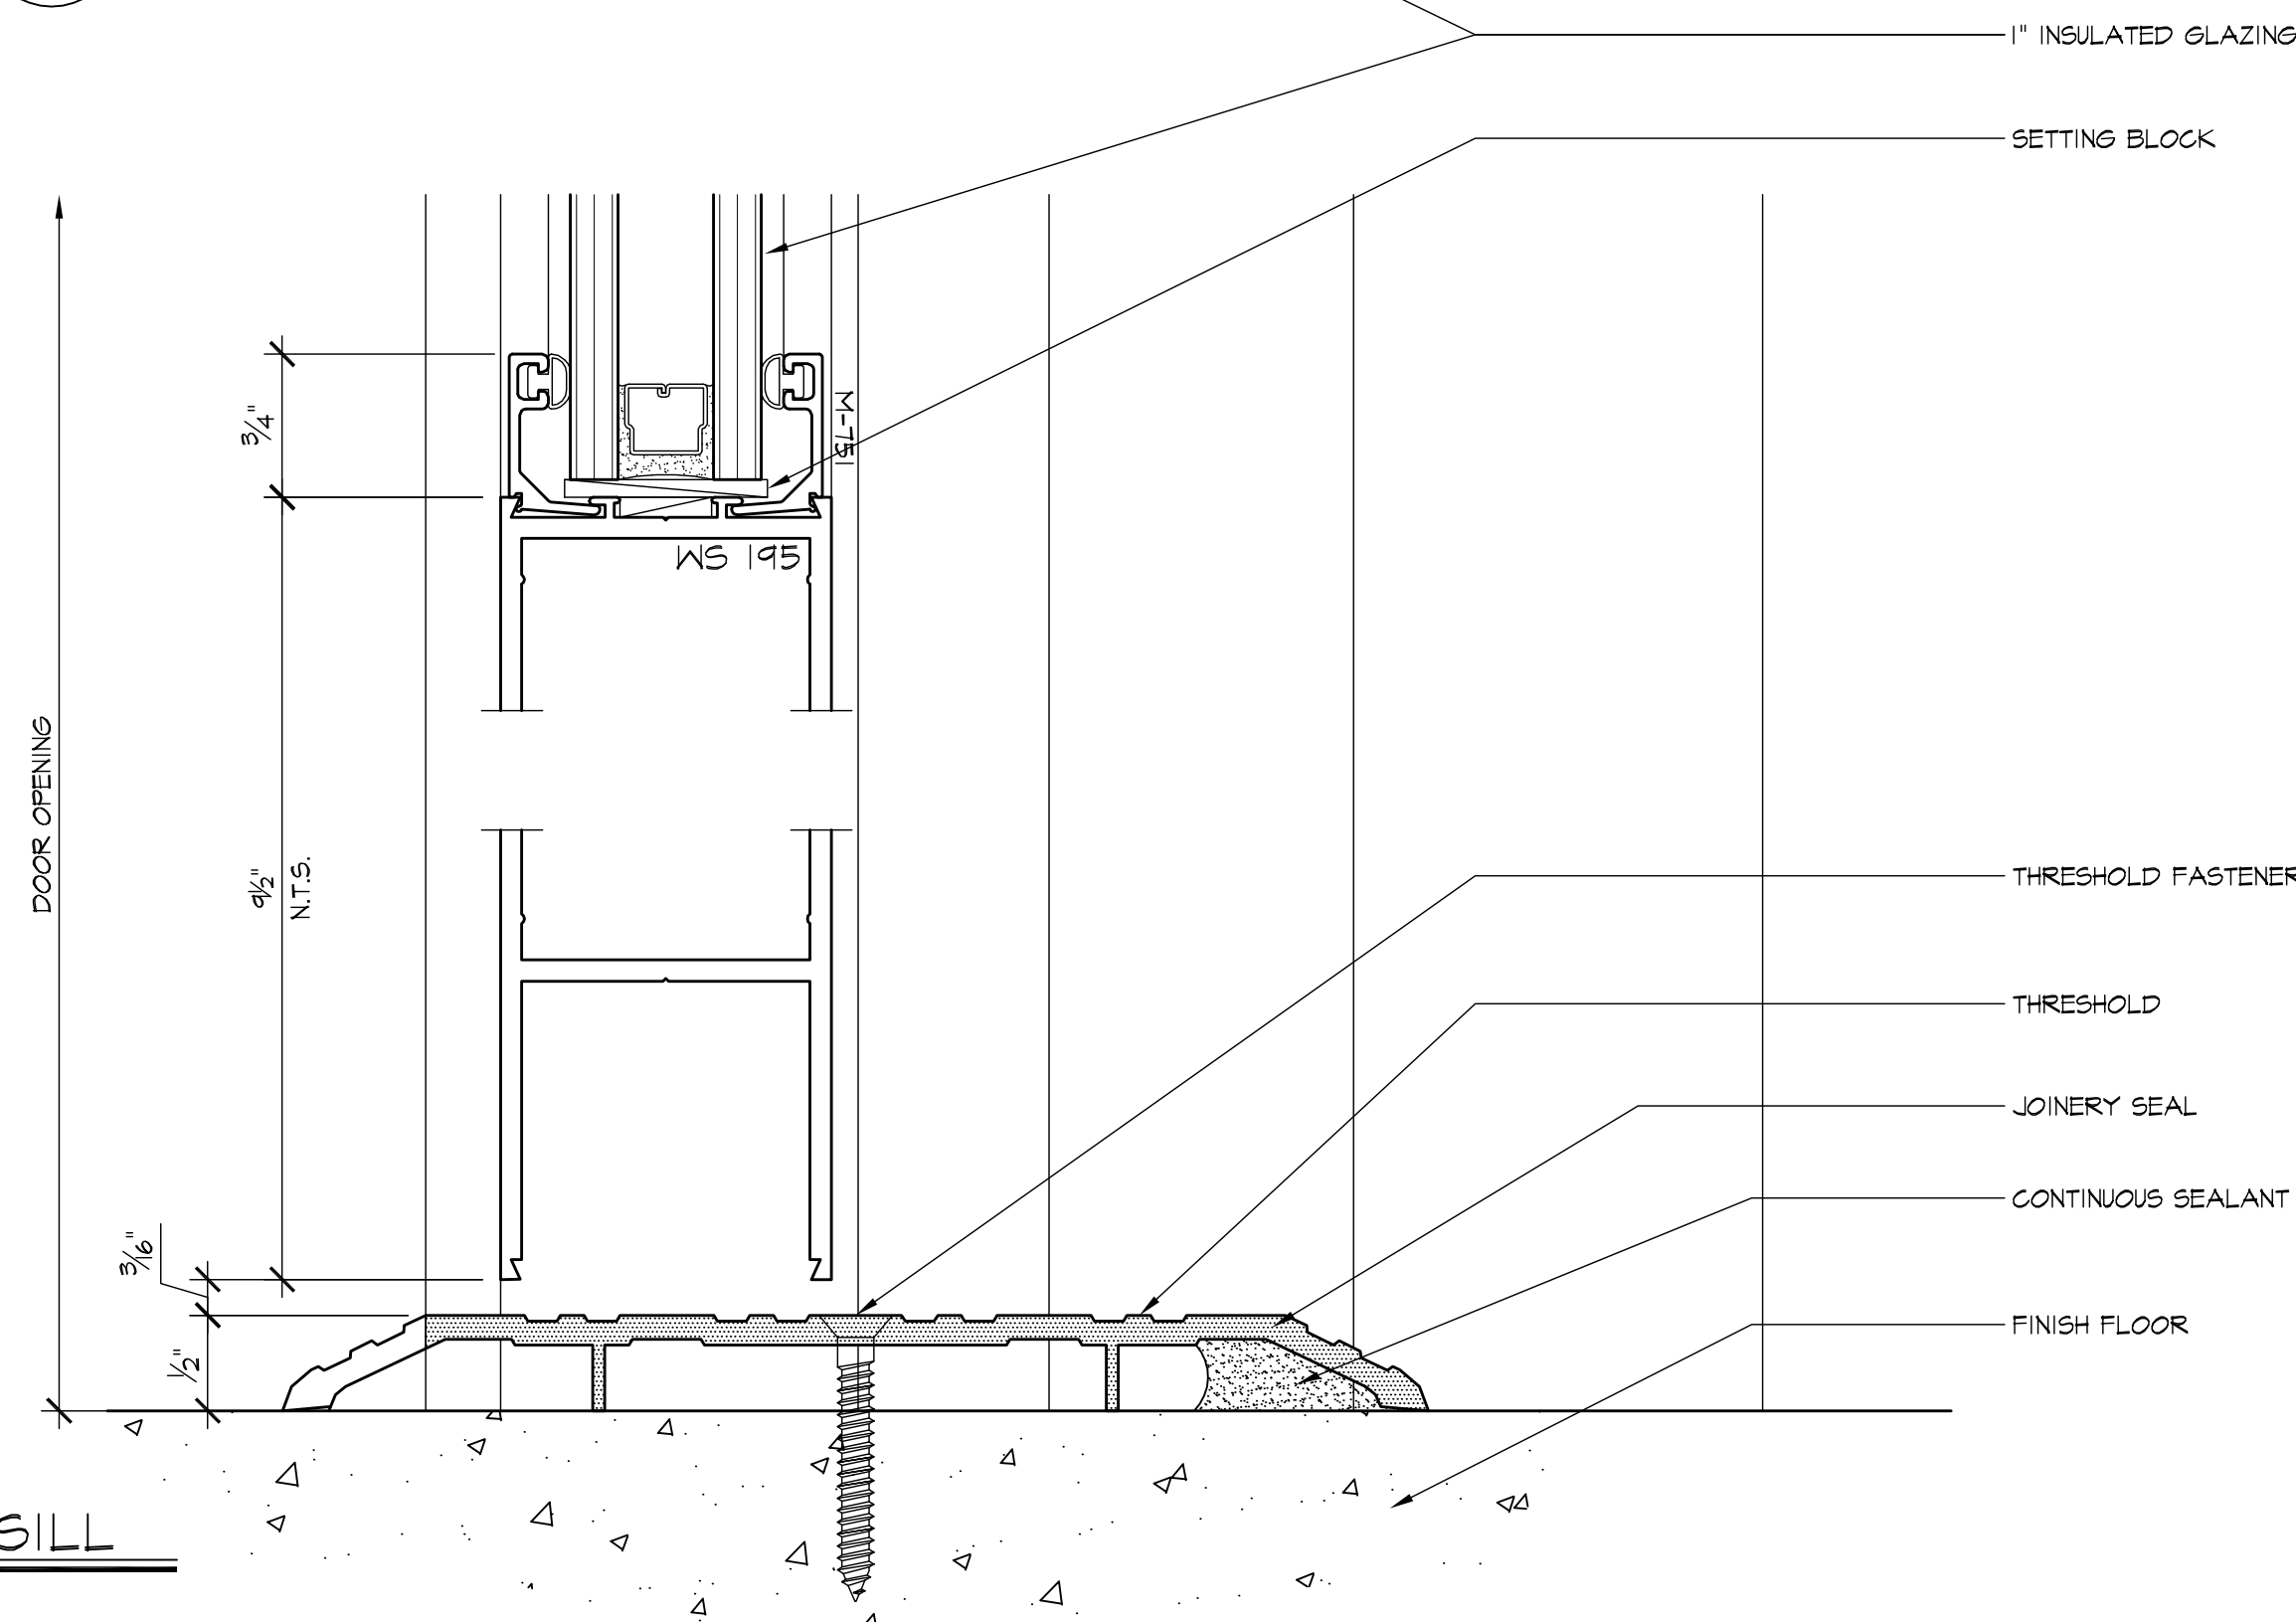

3 DOOR SILL
32 ARCHL:

REVISIONS	BY
4-23-07	BMR
6-11-07	BMR
12-17-07	CTB
3/6/08	CTB




GLASS FACTORY
26383 BASE LINE
HIGHLAND, CA 92346

AS-BUILT DRAWINGS


JOB NAME:	AGUA CALIENTE HOTEL ADDITION
ARCHITECT:	VOA
SHEET DESCRIPTION:	DETAILS

DATE:	1/3/07
SCALE:	FULL
DRAWN:	CTB
JOB NO:	100-06
SHEET NO:	


32

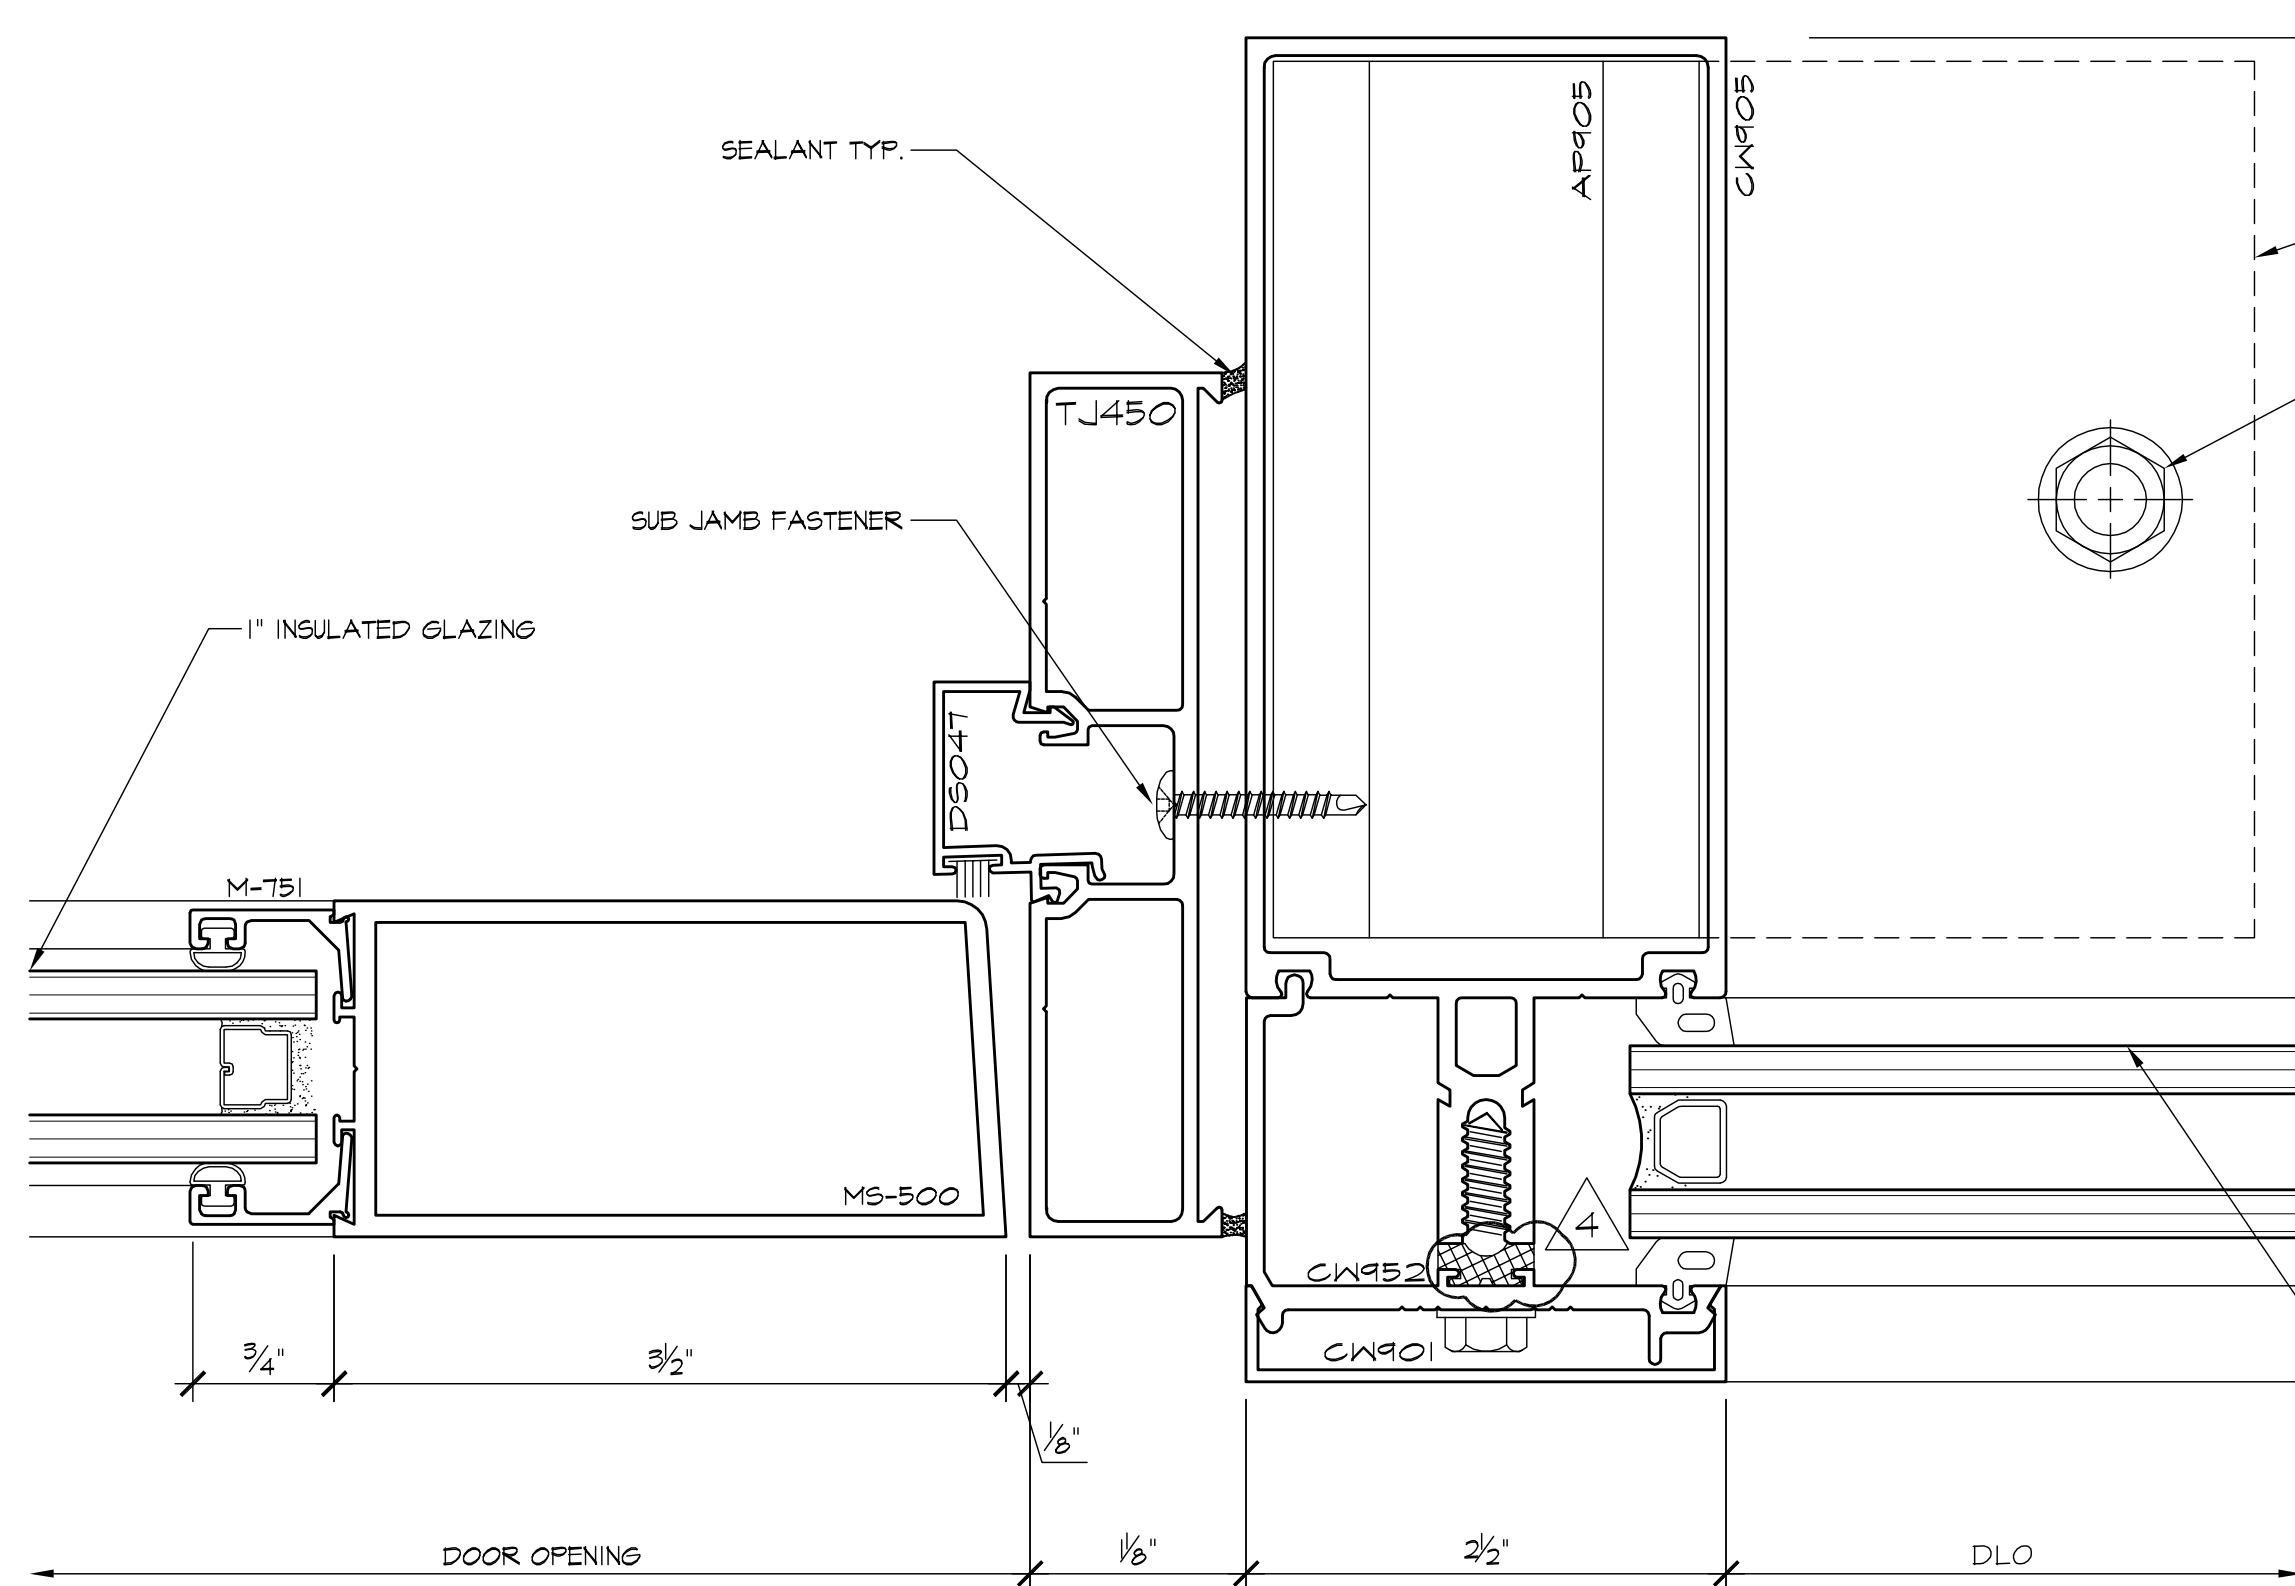

1 DOOR JAMB
33 ARCHL:

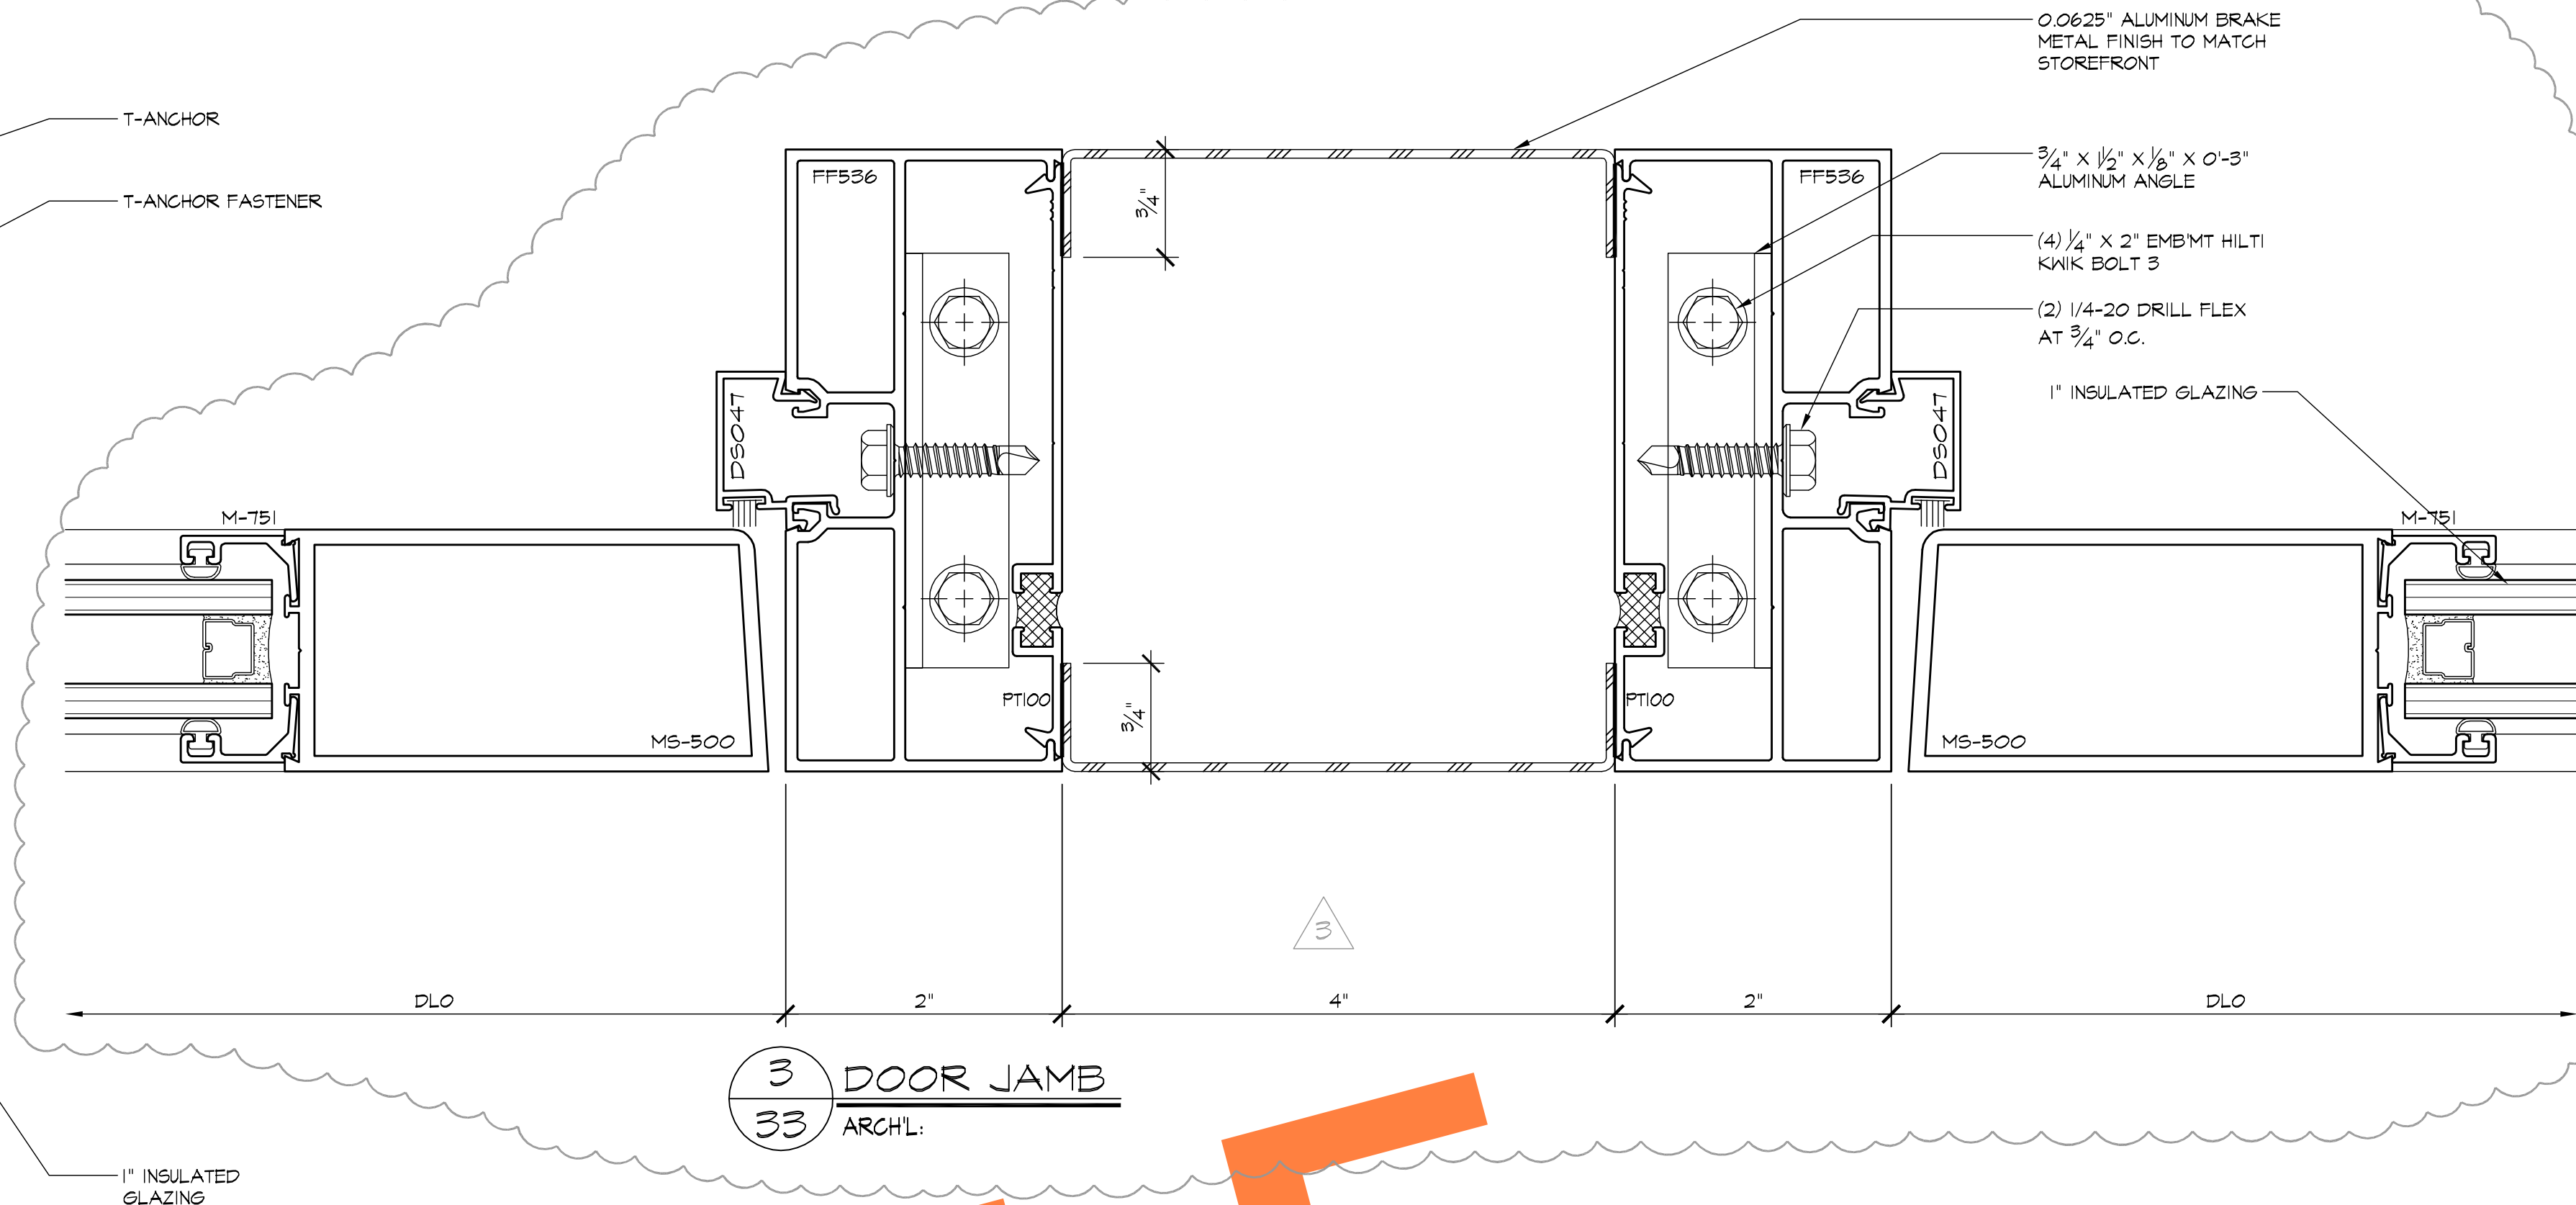


3 DOOR JAMB
33 ARCHL:

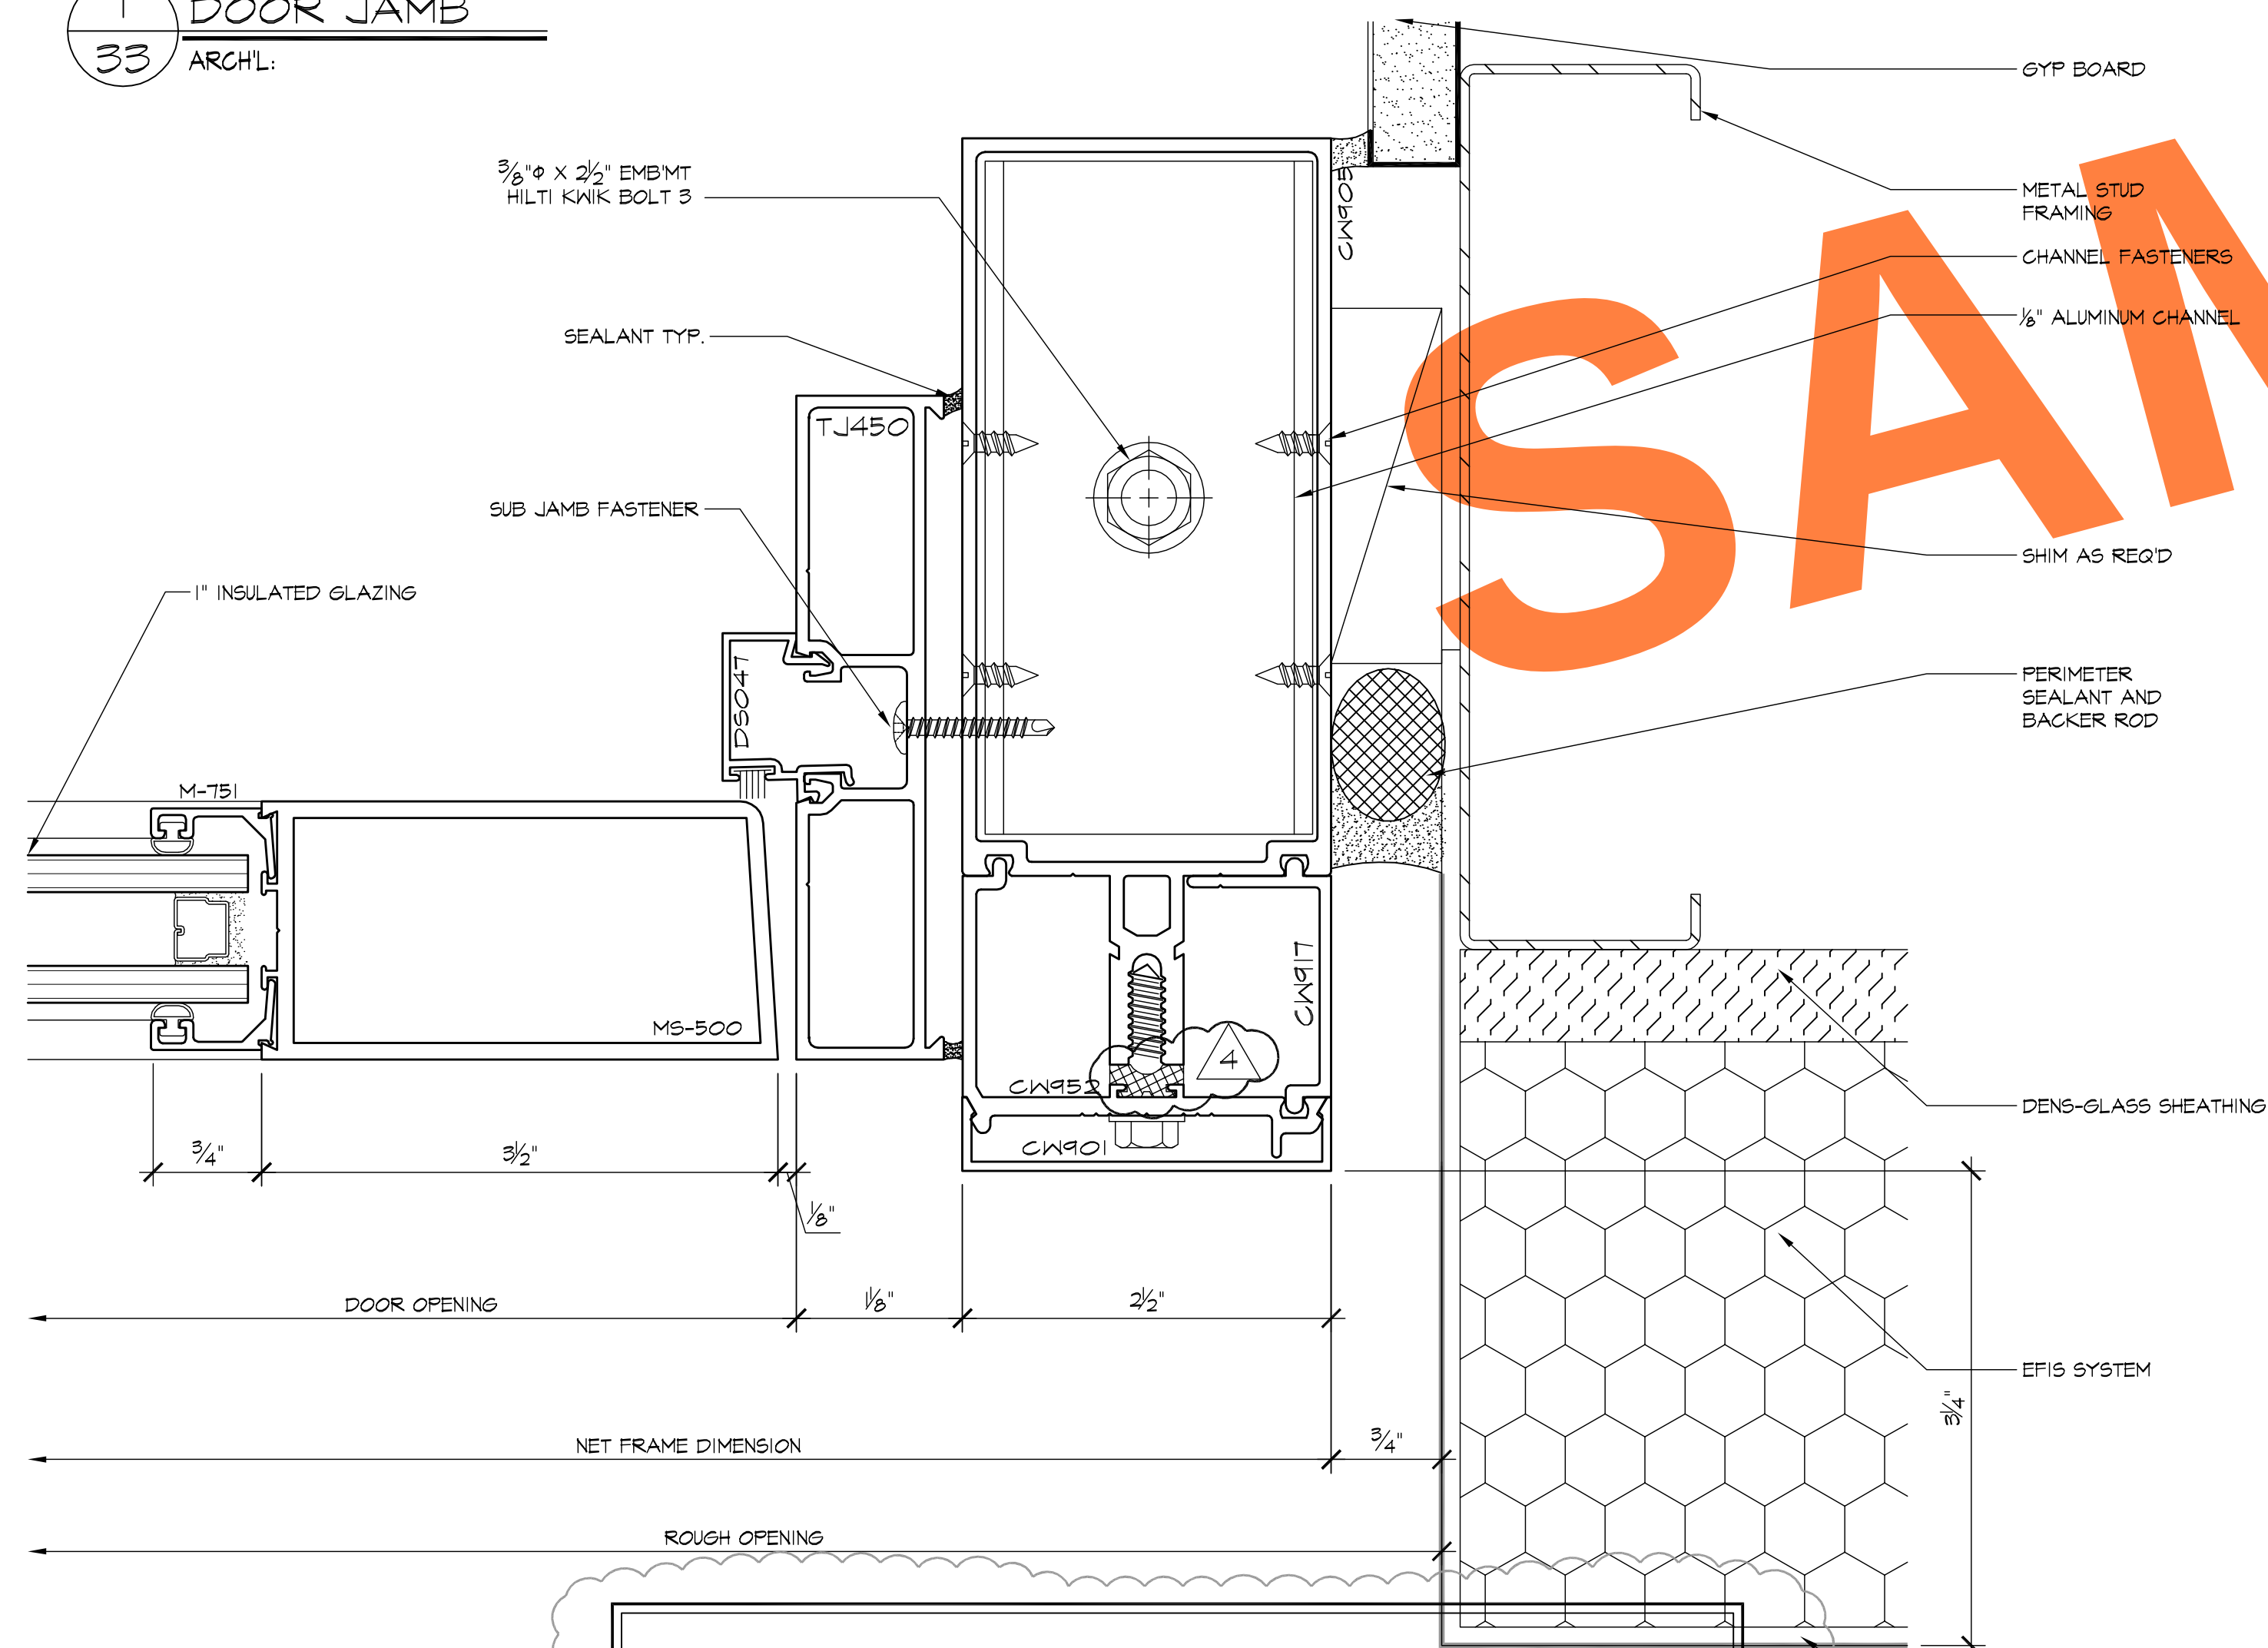

2 DOOR JAMB
33 ARCHL:

NOTE:

PLACEMENT OF ALL CURTAIN WALL SYSTEMS TO BE COORDINATED WITH KHS & S FOR PROPER PLACEMENT ON EFIS WALLS - TYPICAL

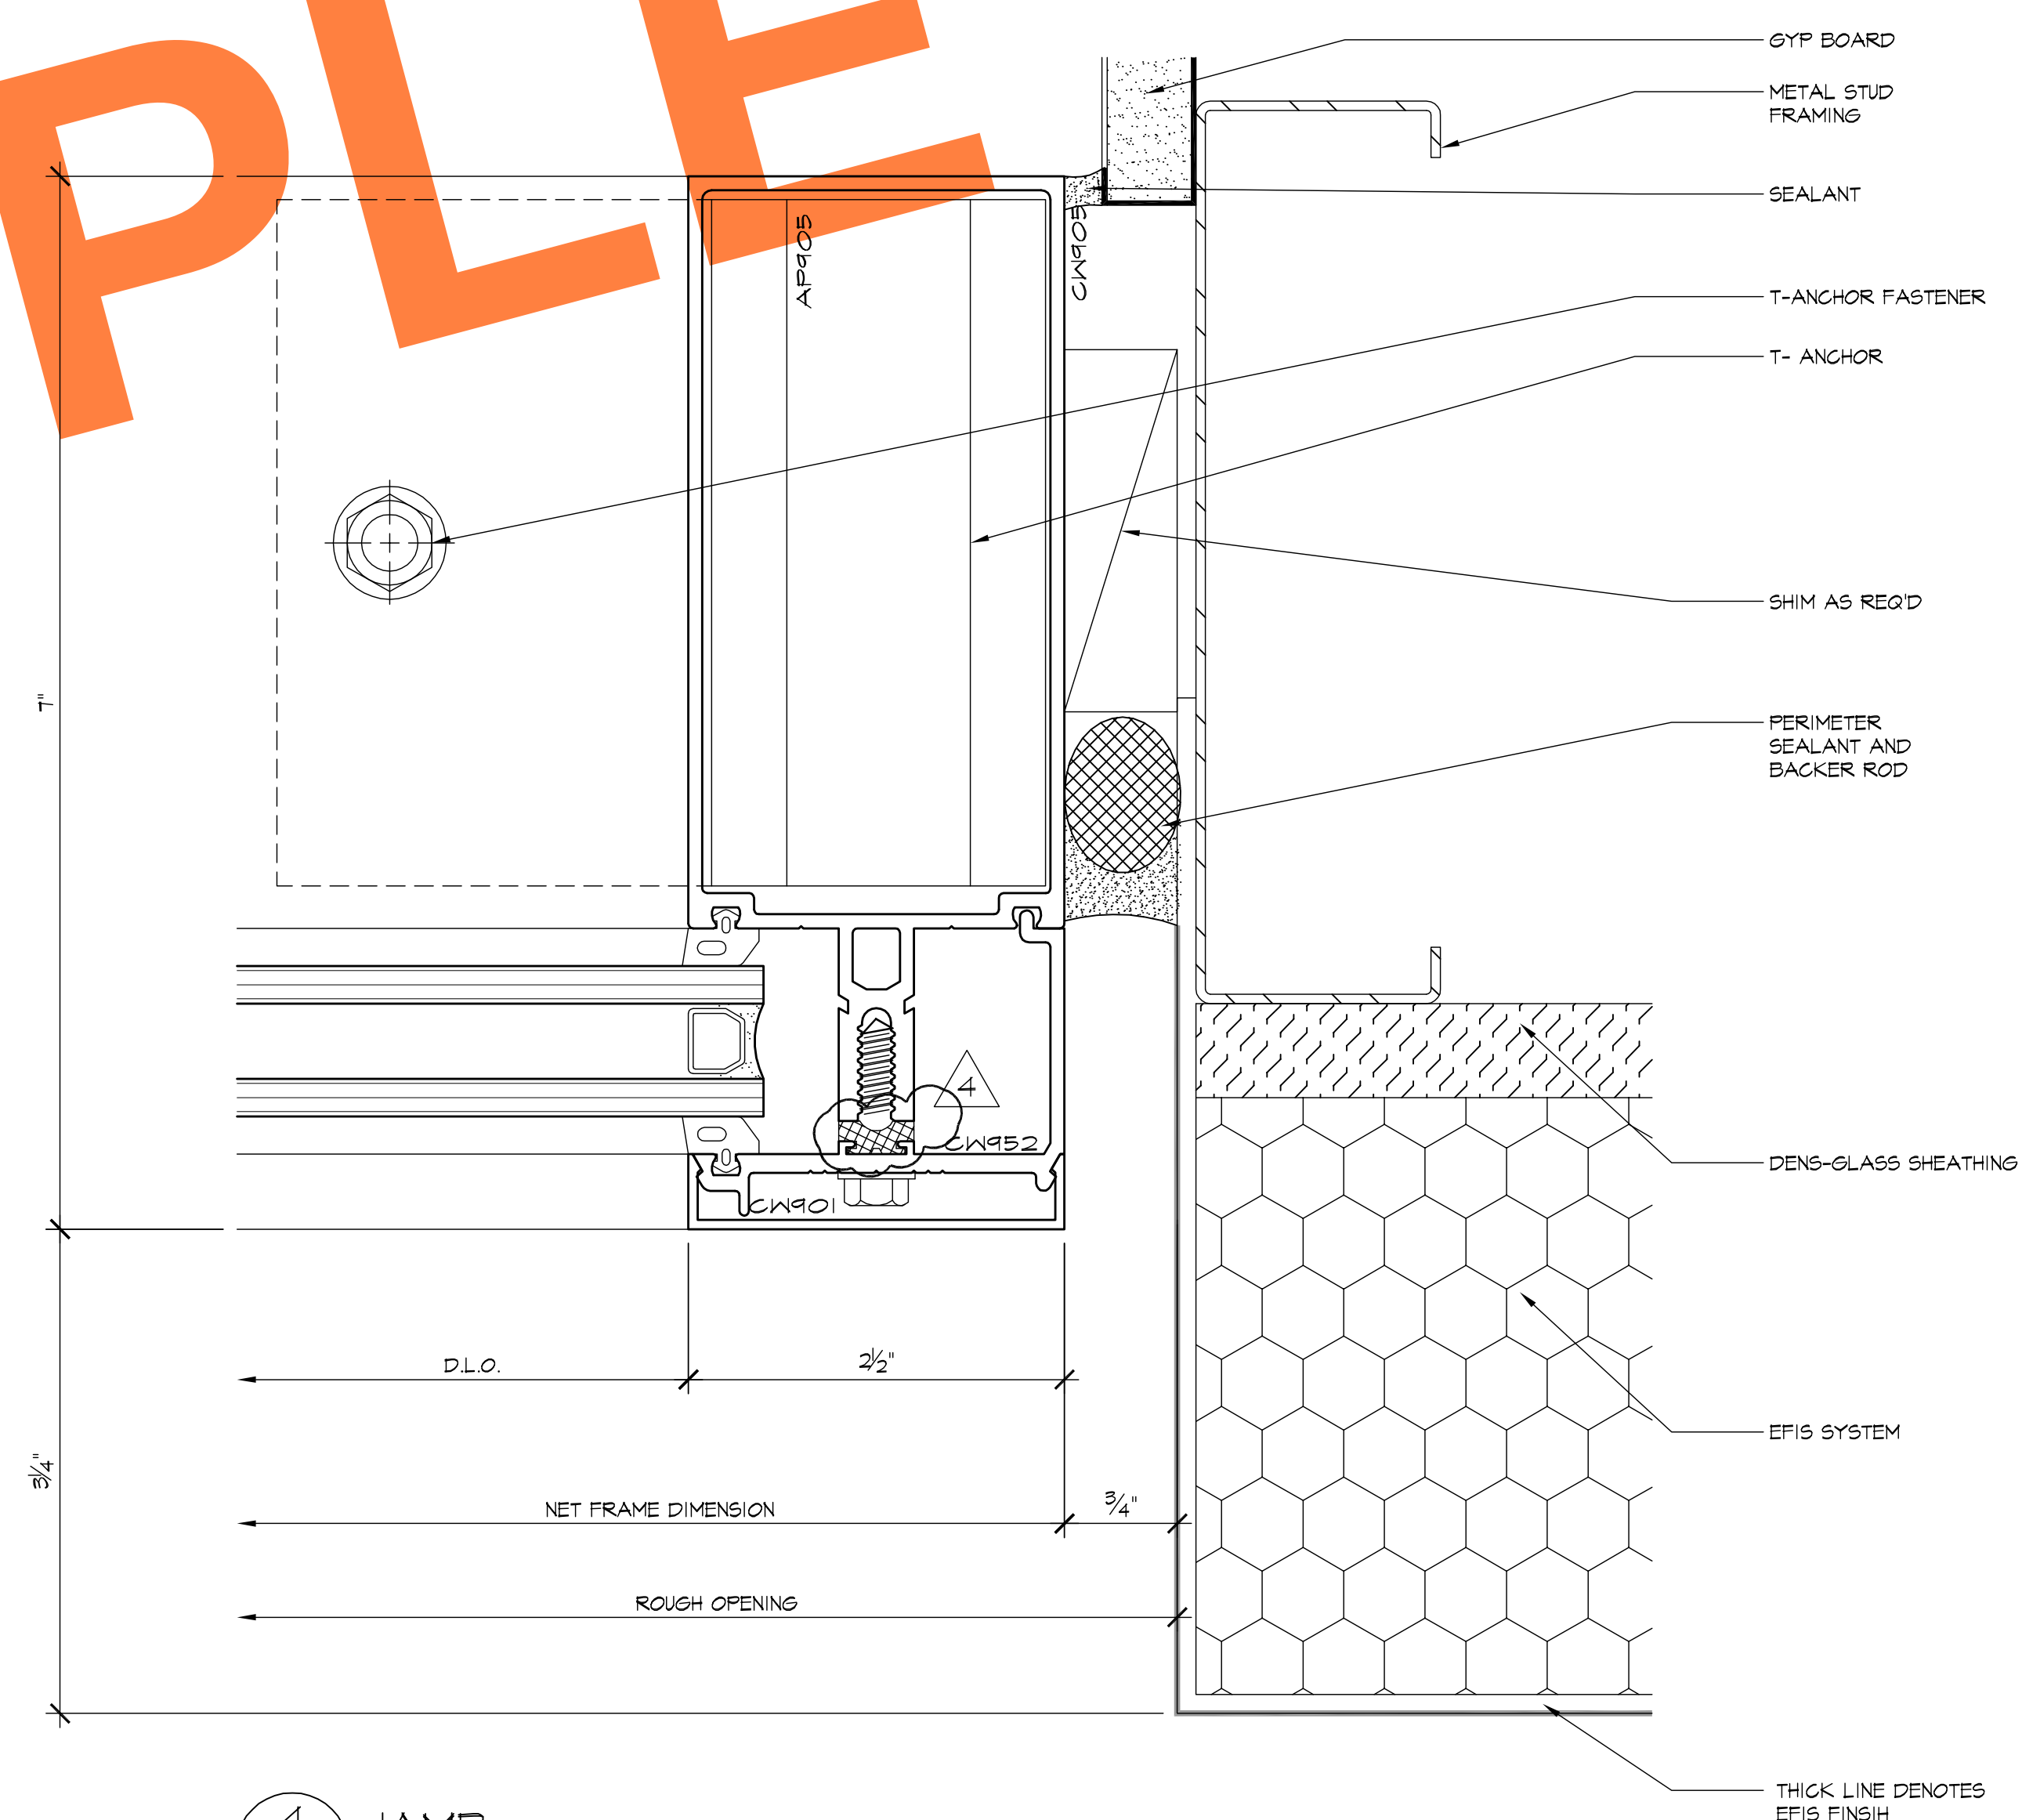

4 JAMB
33 ARCHL:

REVISIONS	BY
4-23-07	BMR
6-11-07	BMR
12-17-07	CTB
3/6/08	CTB



GLASS FACTORY
26383 BASE LINE
HIGHLAND, CA 92346

AS-BUILT DRAWINGS

JOB NAME:	AGUA CALIENTE HOTEL ADDITION
ARCHITECT:	VOA
SHEET DESCRIPTION:	DETAILS
DATE:	1/3/07
SCALE:	FULL
DRAWN:	CTB
JOB NO:	100-06
SHEET NO:	33

BMR



DRAFTING SERVICES
SINCE 1988

23846 SUNNYMEAD BLVD.
SUITE #6
MORENO VALLEY, CA 92550

B: (951) 243-7614
F: (951) 243-7673


AS-BUILT DRAWINGS

DATE:	1/3/07
SCALE:	FULL
DRAWN:	CTB
JOB NO:	100-06
SHEET NO:	


34




PLACEMENT OF ALL CURTAIN WALL SYSTEMS TO BE COORDINATED WITH KHS & S FOR PROPER PLACEMENT ON EFIS WALLS - TYPICAL

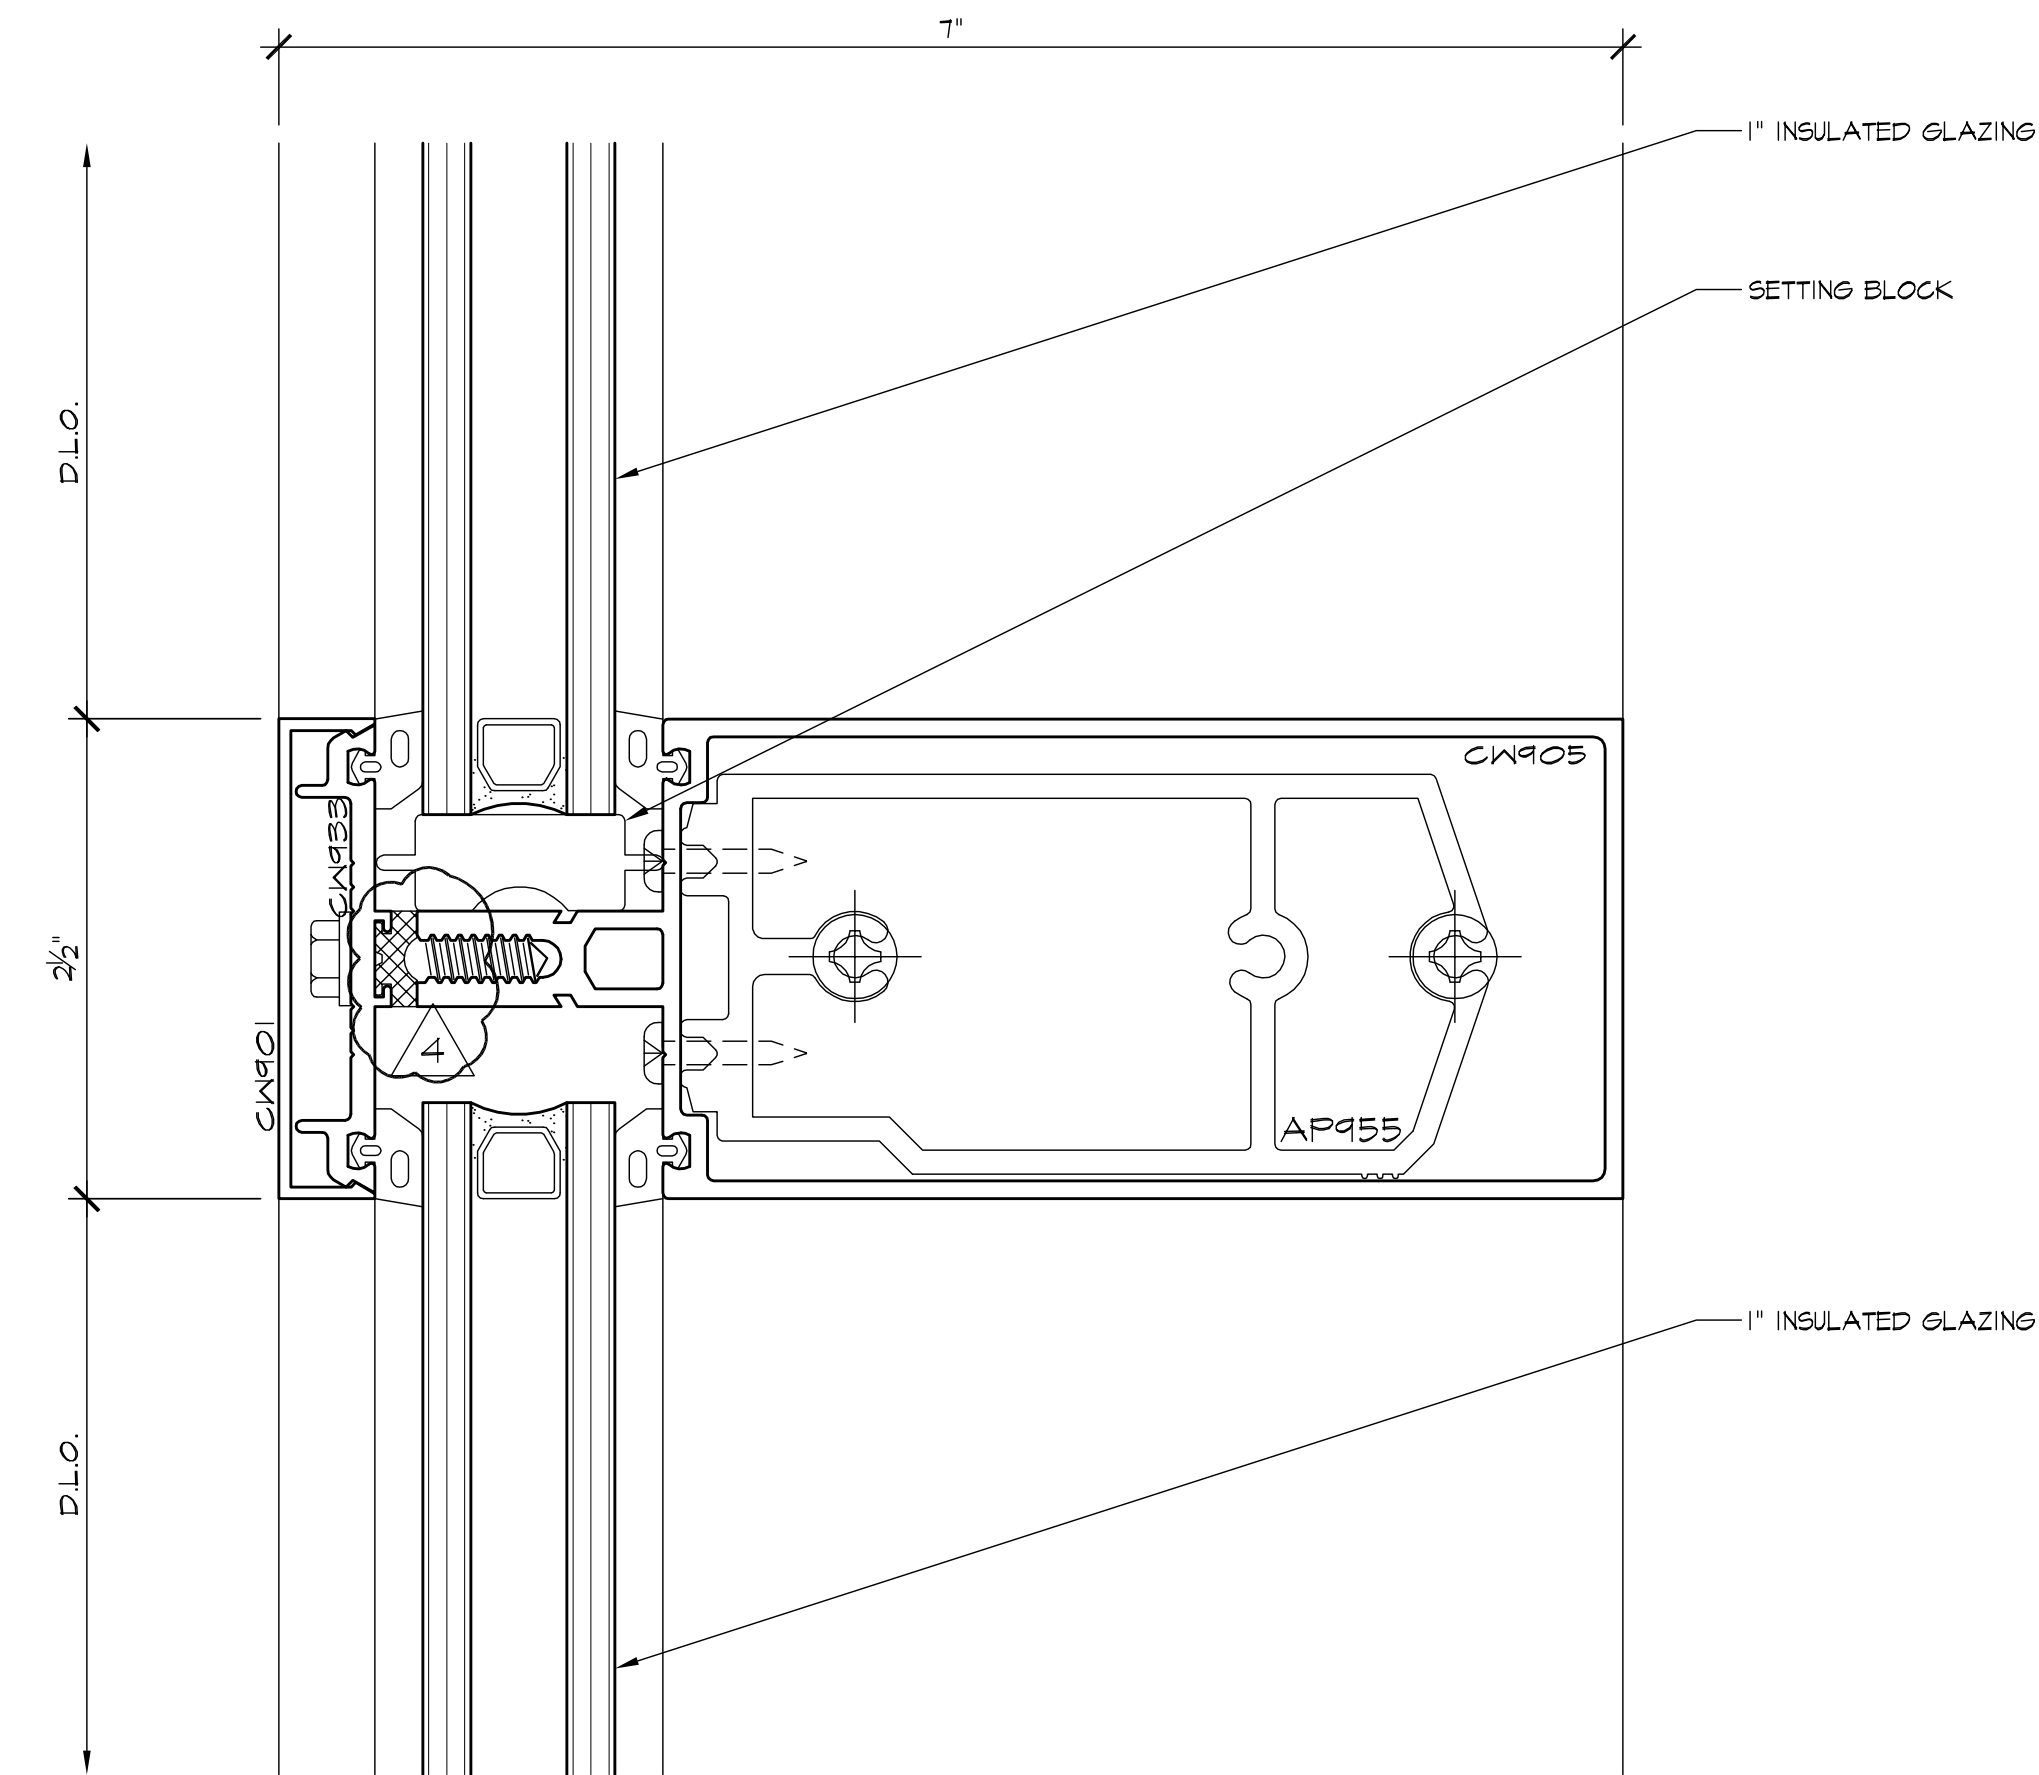


1 HORIZONTAL
35 ARCHL: 01/A500E

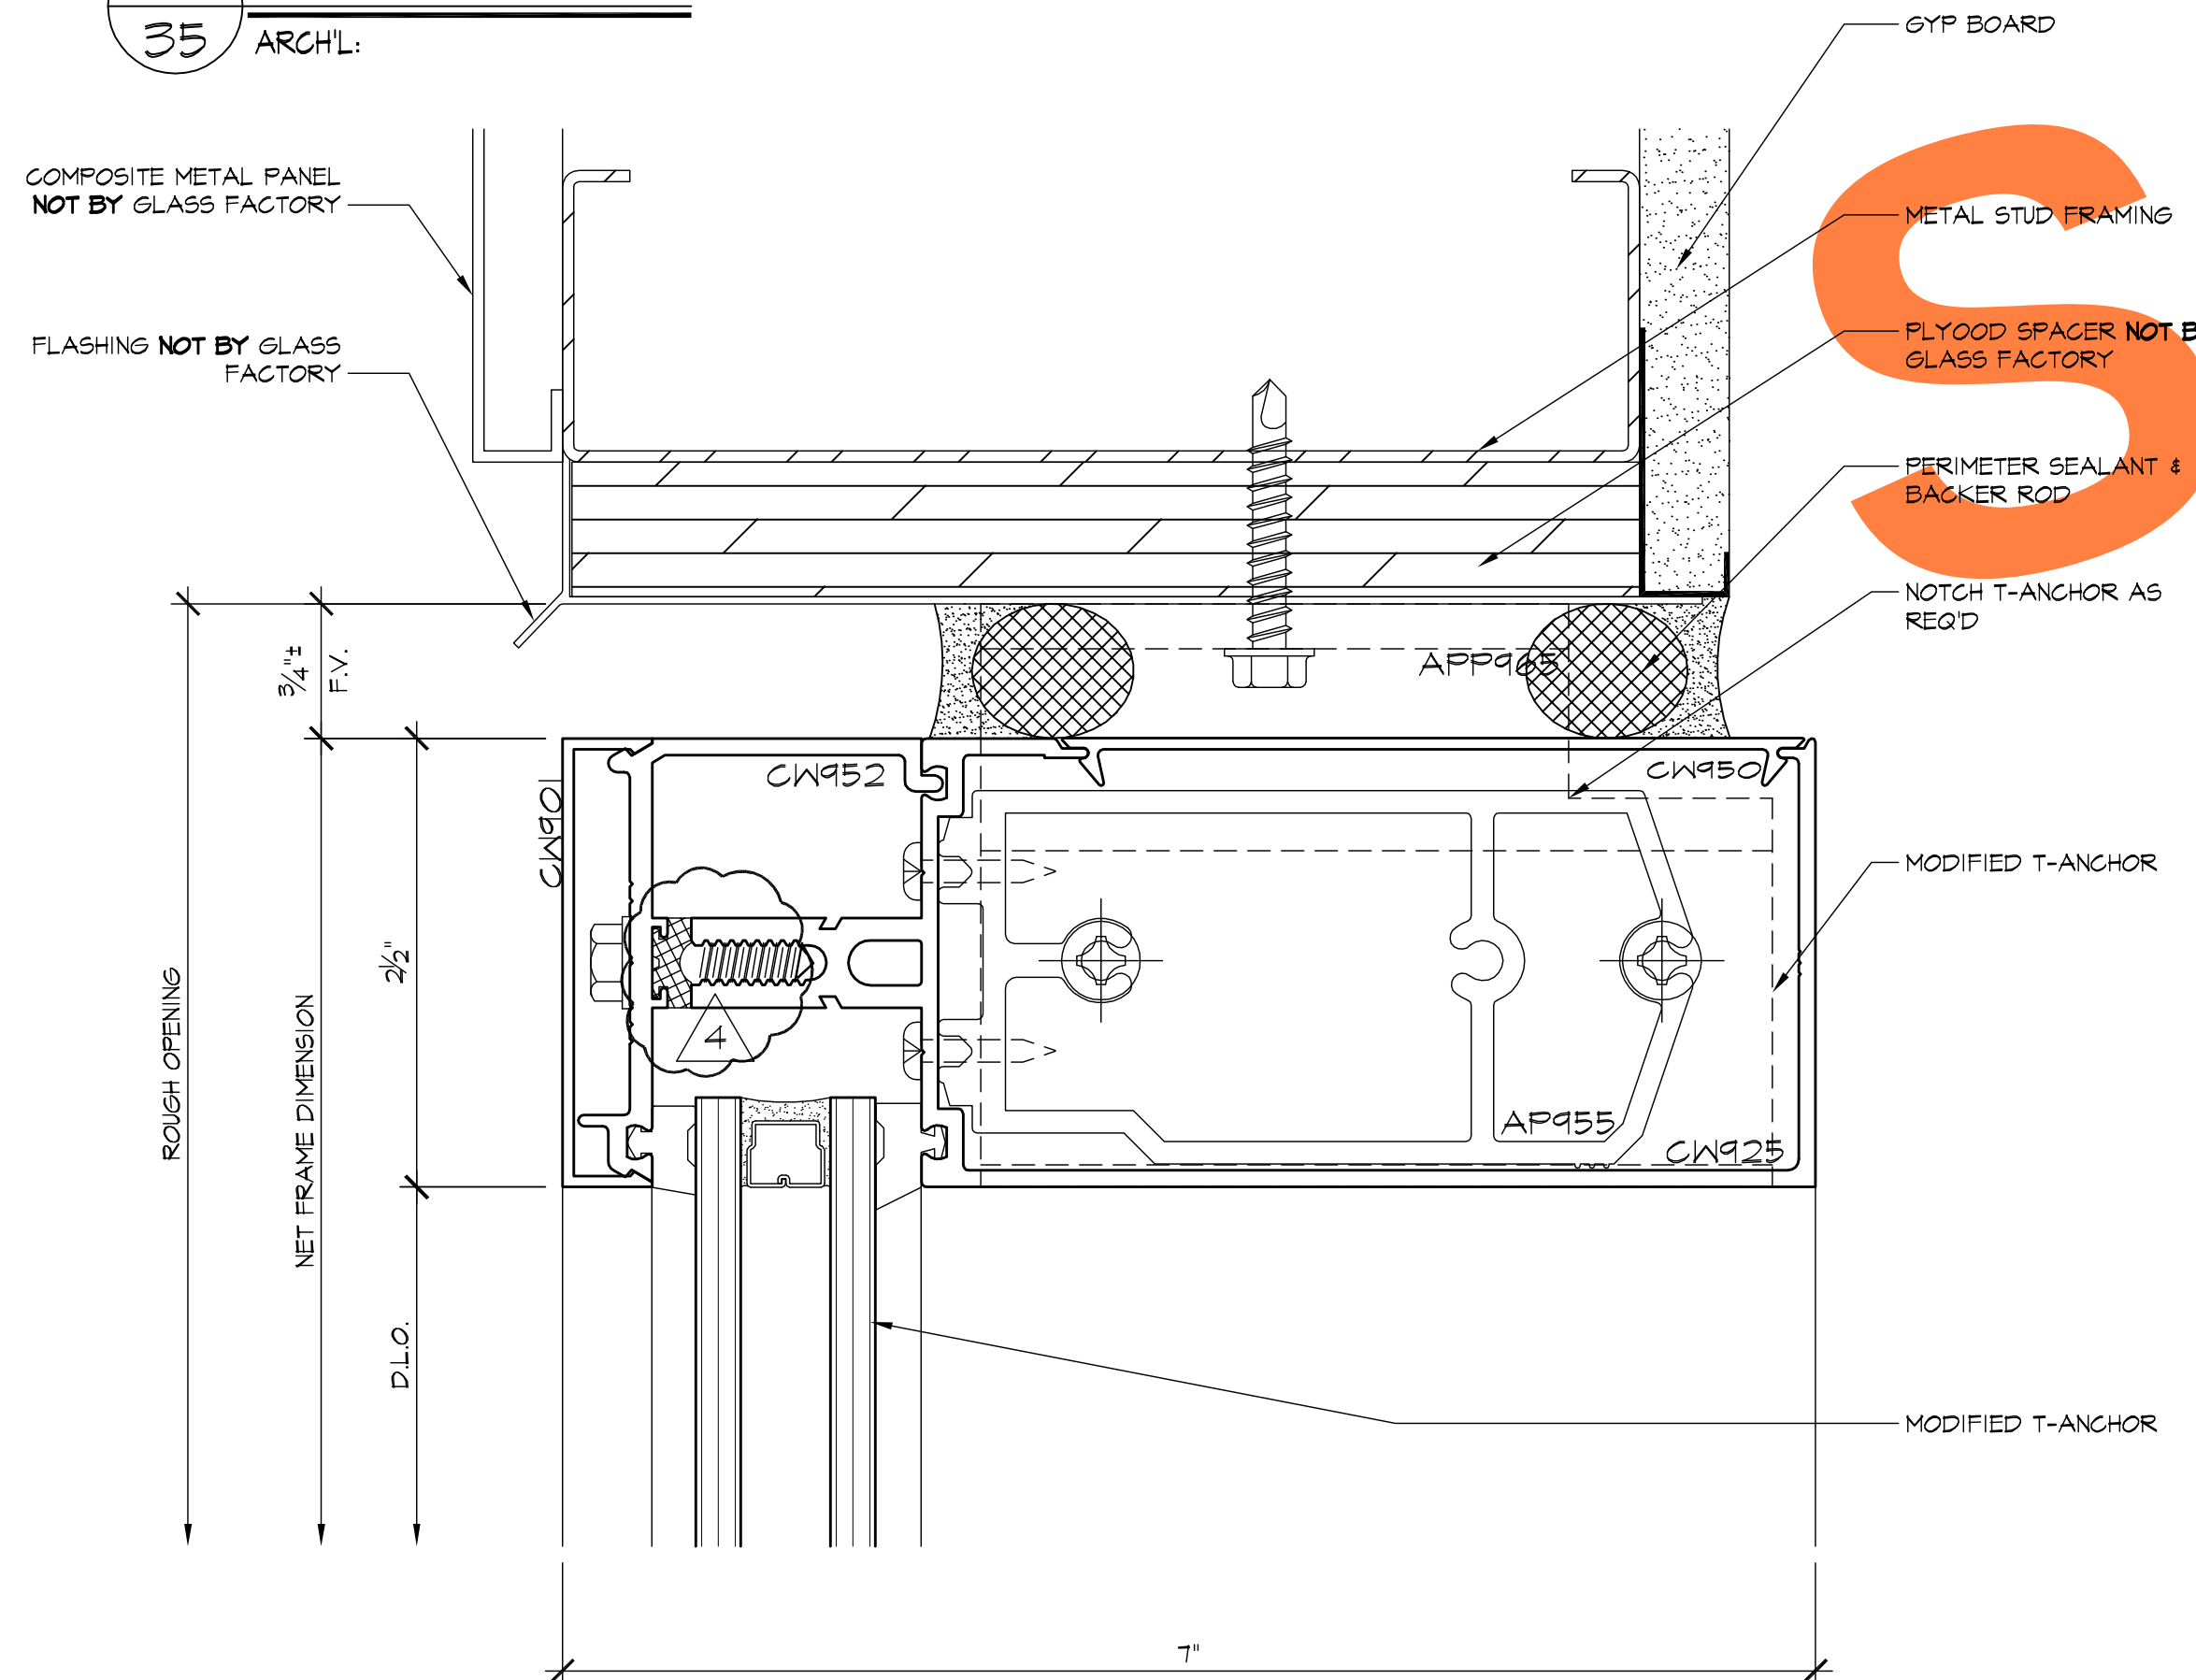

2 HEAD
35 ARCHL: 01/A500E

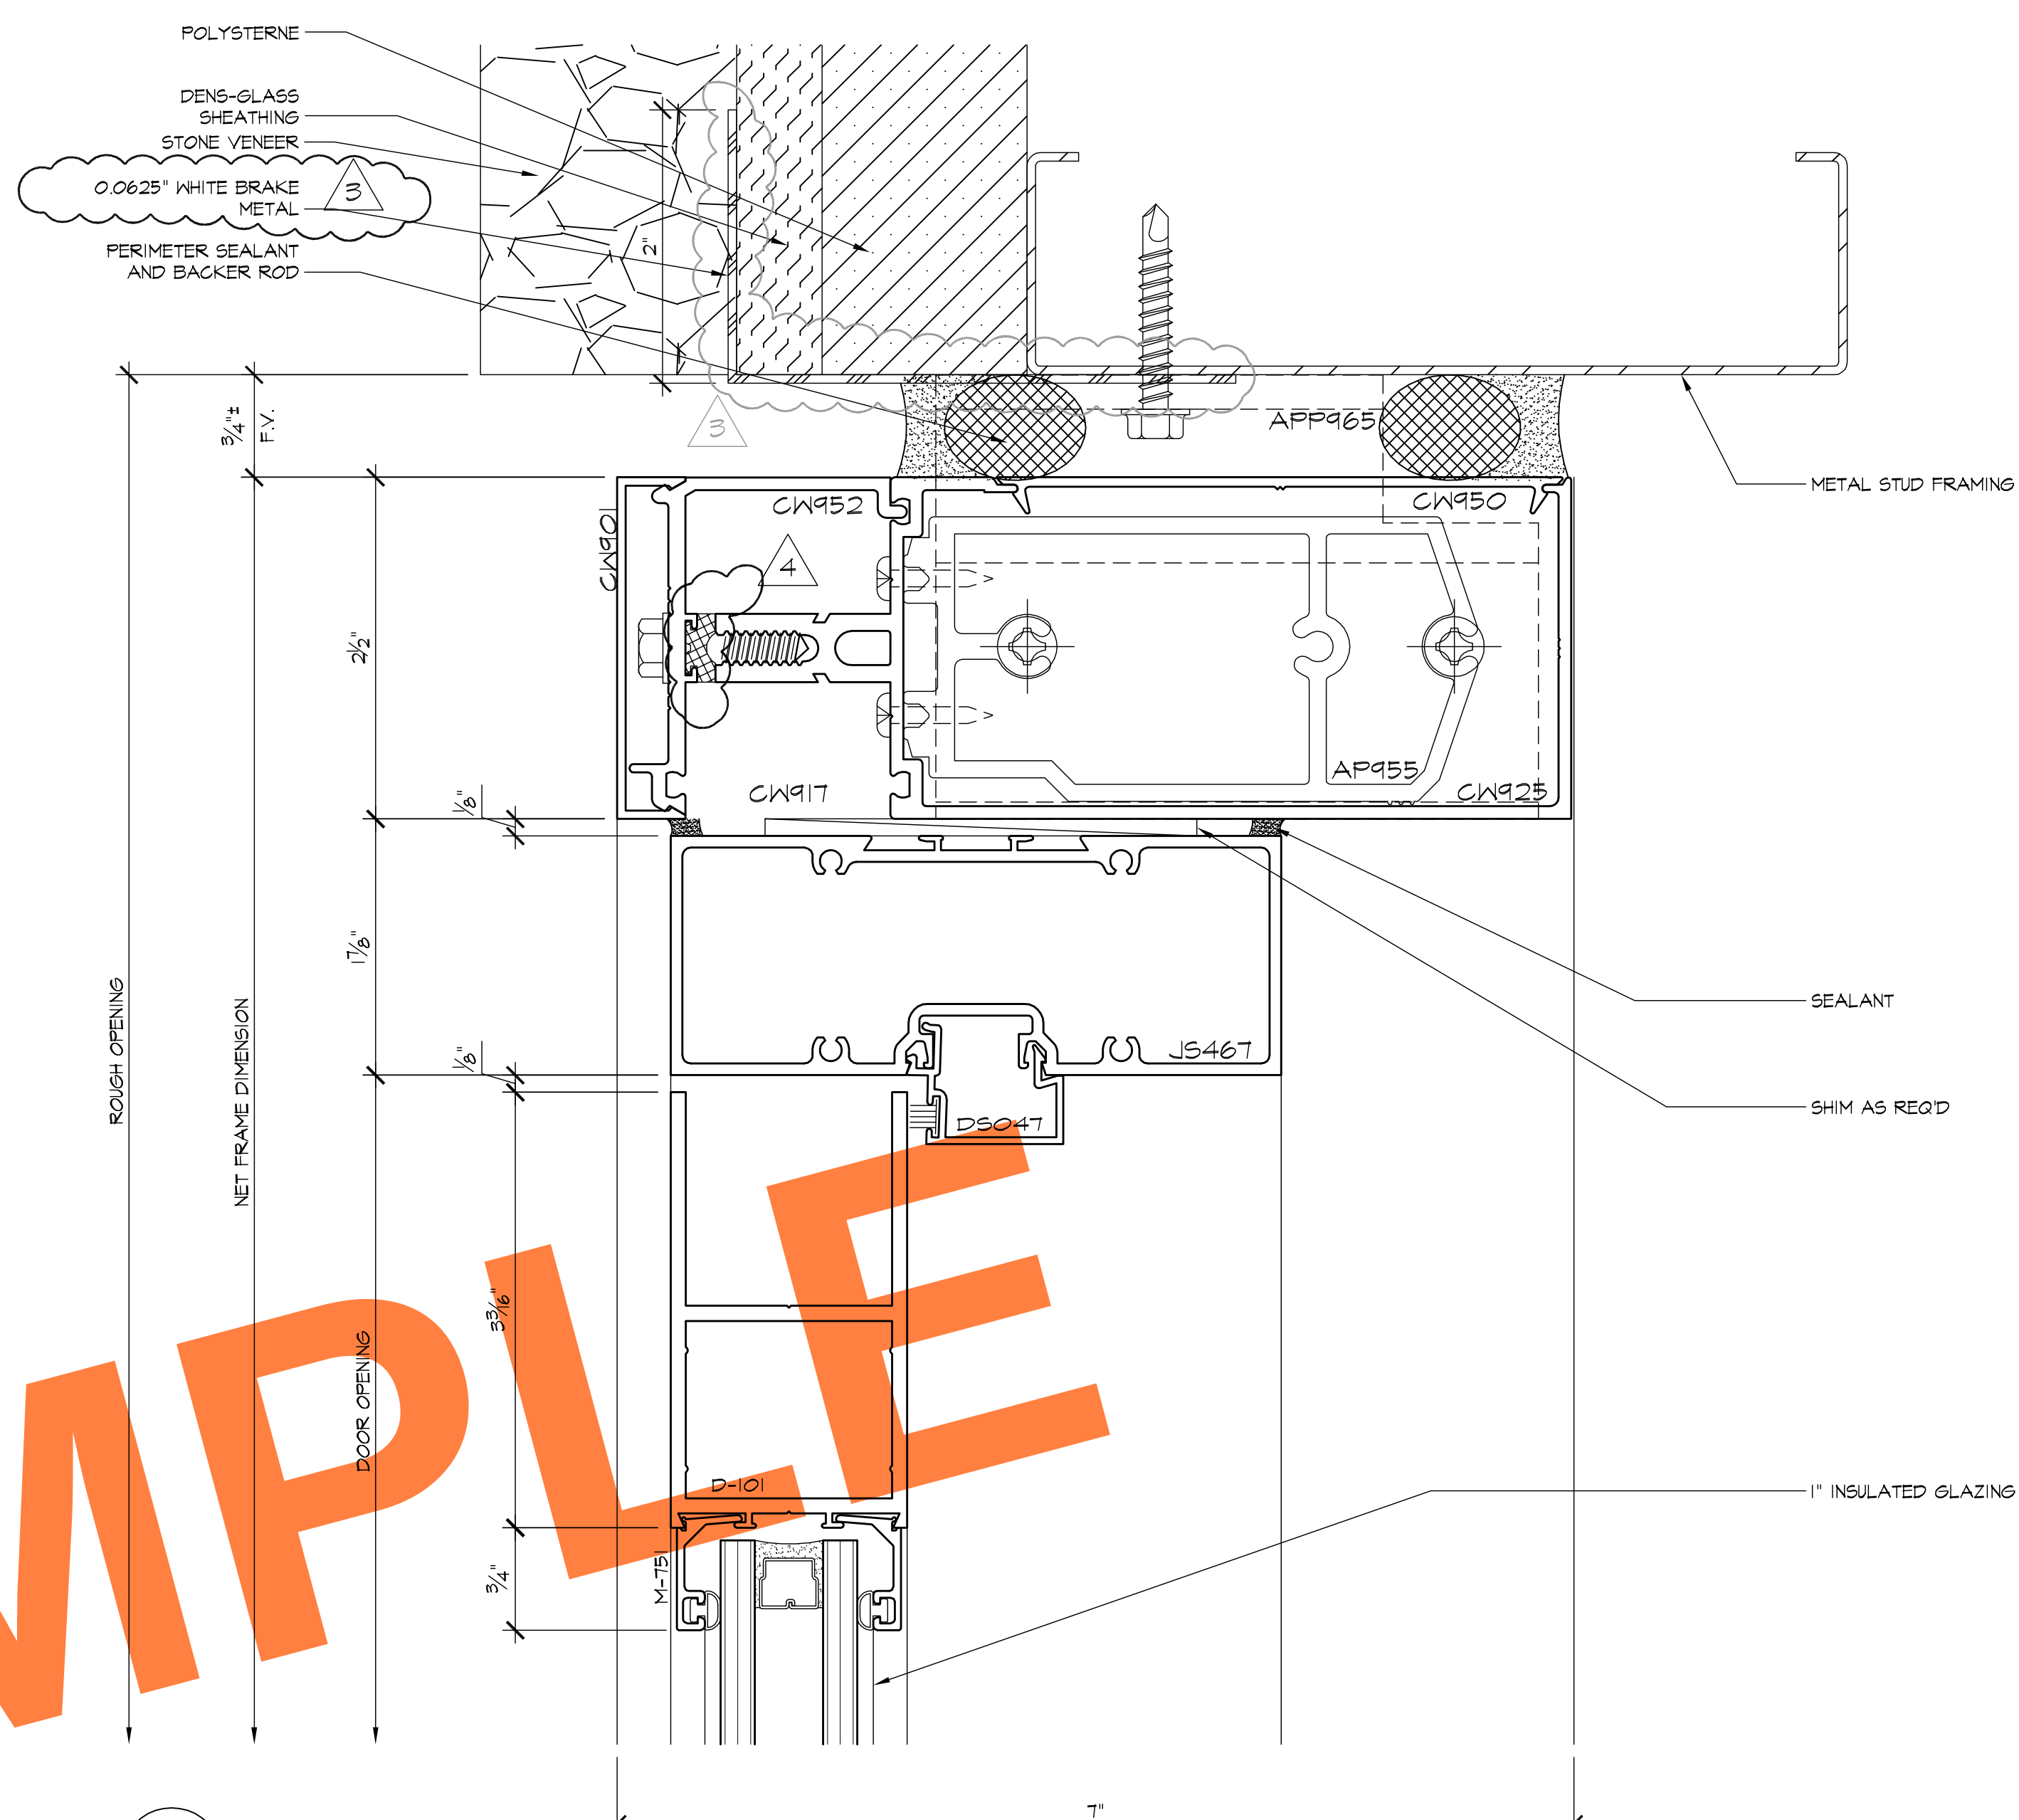

3 DOOR HEAD
35 ARCHL: 02/A500E

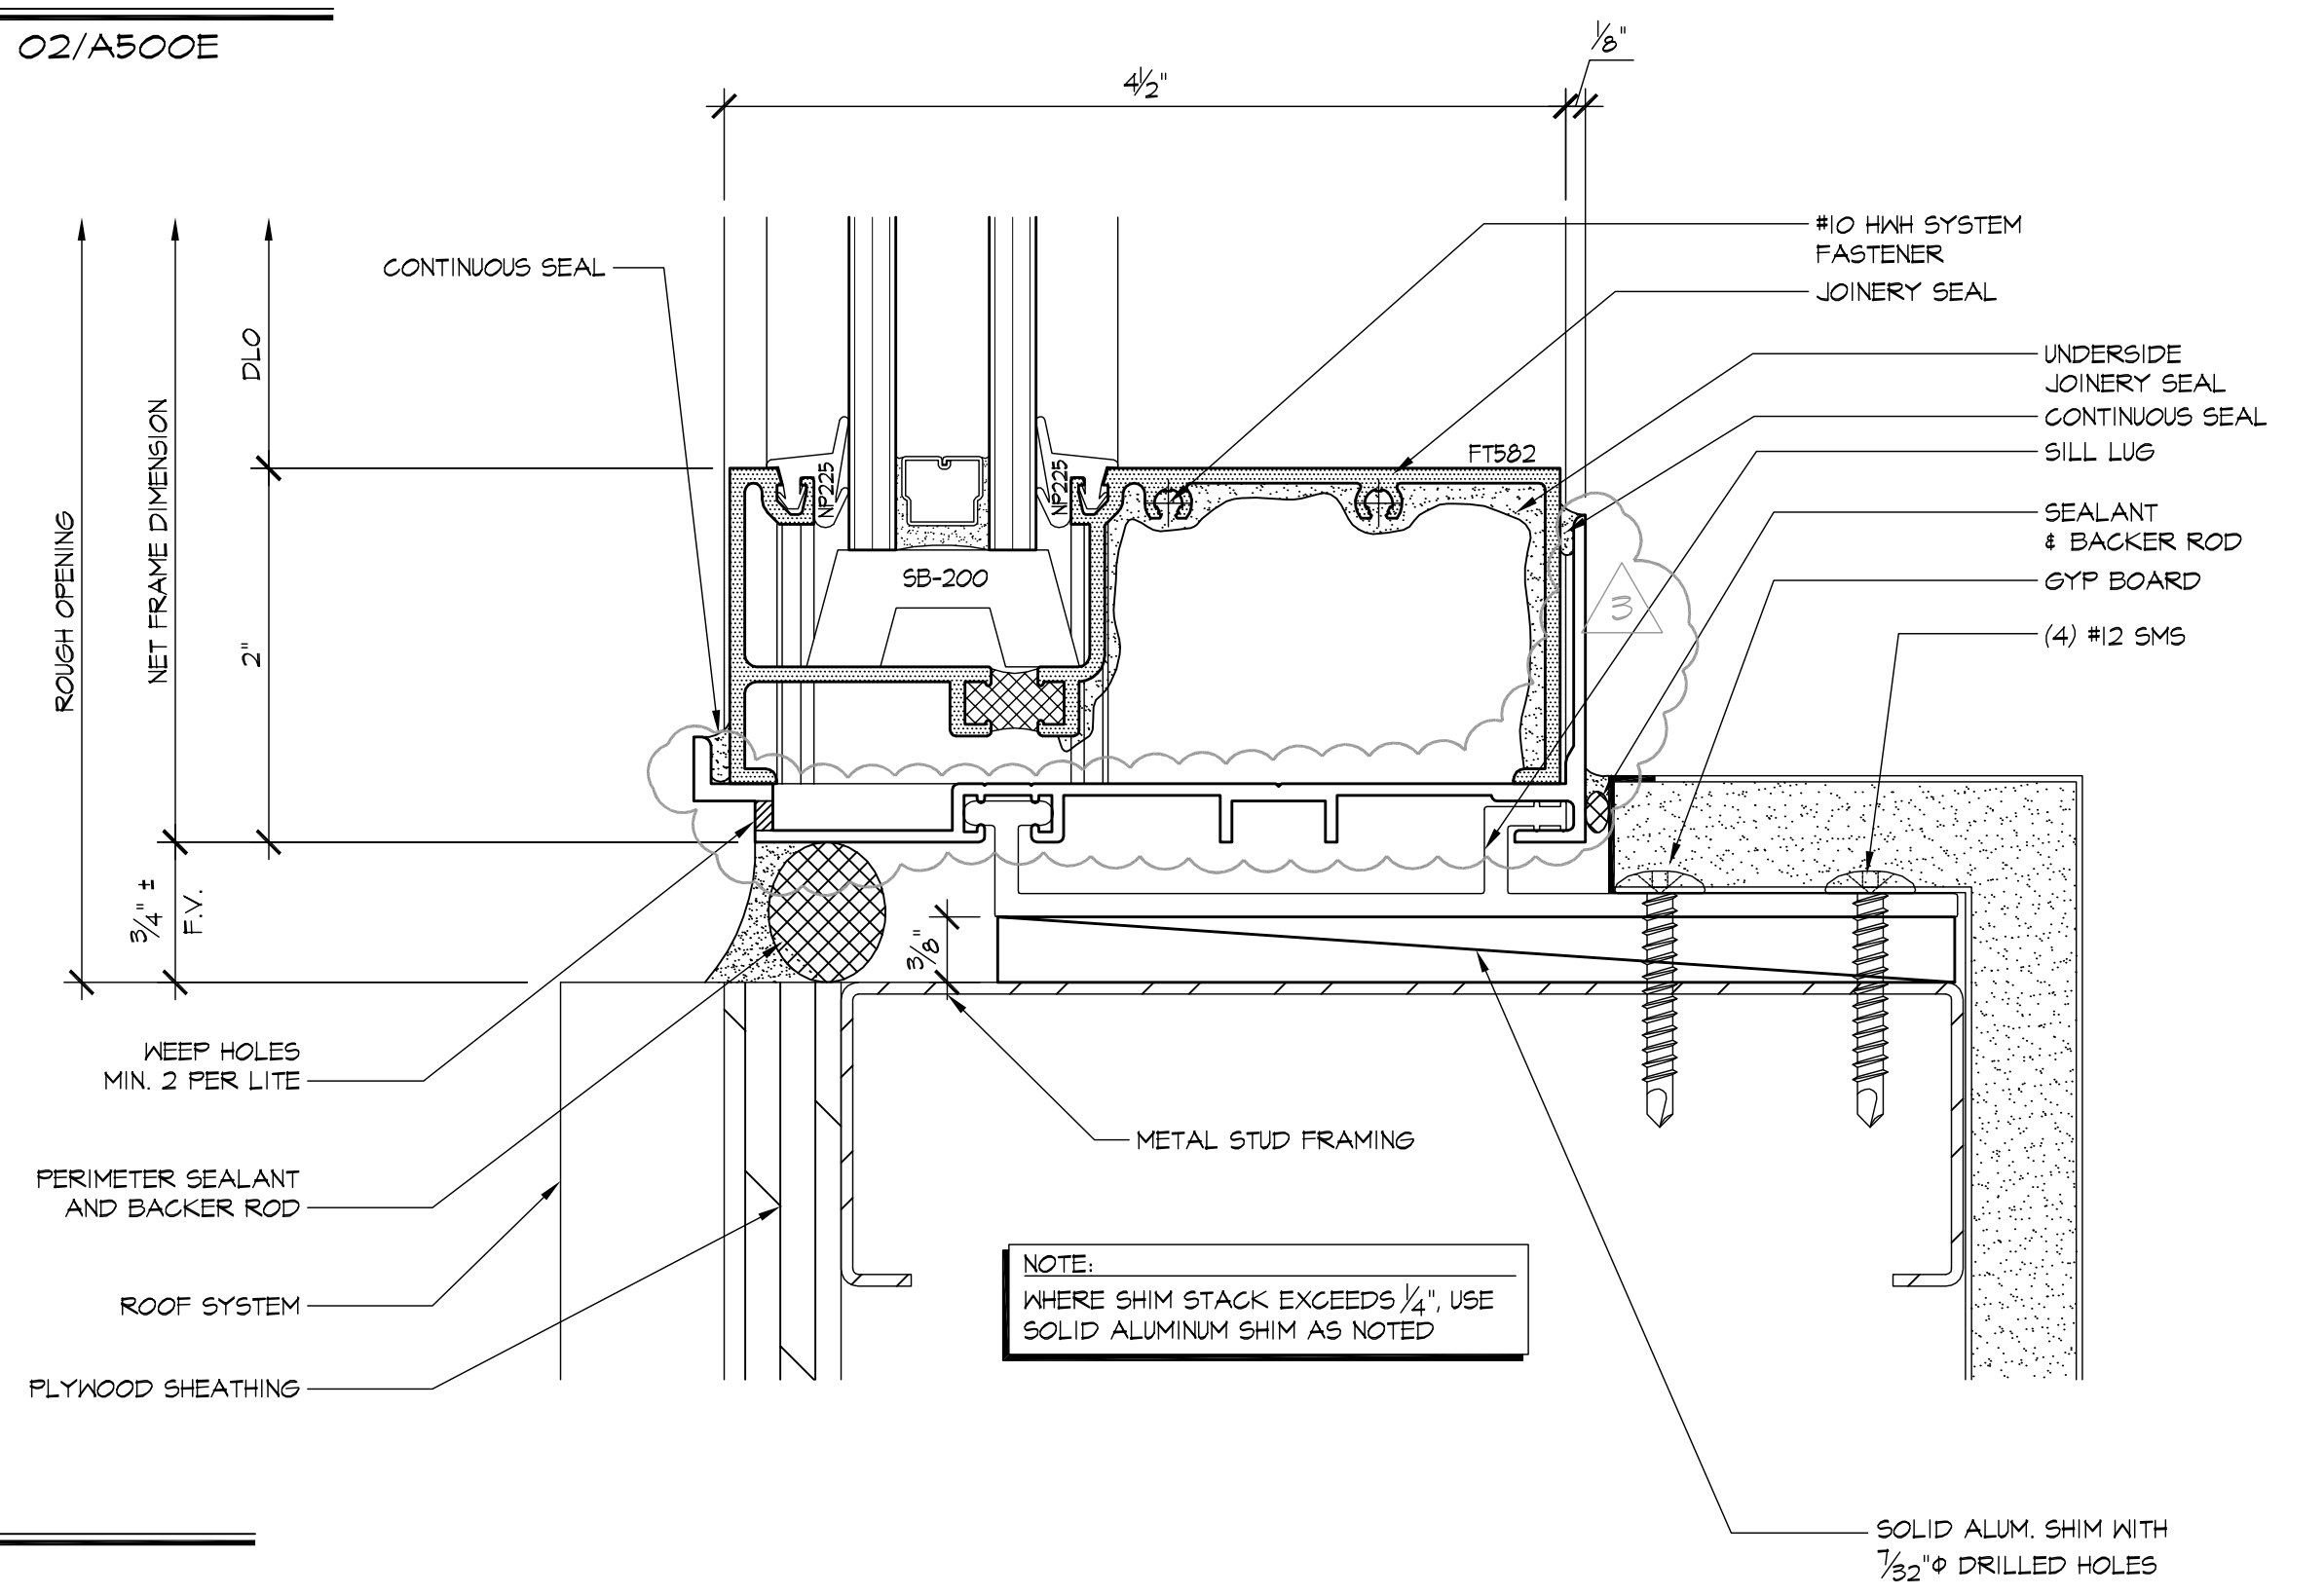

4 SILL
35 ARCHL: 02/A500E





REVISIONS	BY
△ 4-23-07	BMR
△ 6-11-07	BMR
△ 12-17-07	CTB
△ 3/6/08	CTB
△	

BMR
DRAFTING SERVICE
SINCE 1988
23846 SUNNYMEAD BLVD.
SUITE #9
MORENO VALLEY, CA 92553
B: (951) 243-7814
F: (951) 243-7873

GLASS FACTORY
26383 BASE LINE
HIGHLAND, CA 92346

AS-BUILT DRAWINGS

JOB NAME:	AGUA CALIENTE HOTEL ADDITION
ARCHITECT:	VOA
SHEET DESCRIPTION:	DETAILS
DATE:	1/3/07
SCALE:	FULL
DRAWN:	CTB
JOB NO:	100-06
SHEET NO:	35

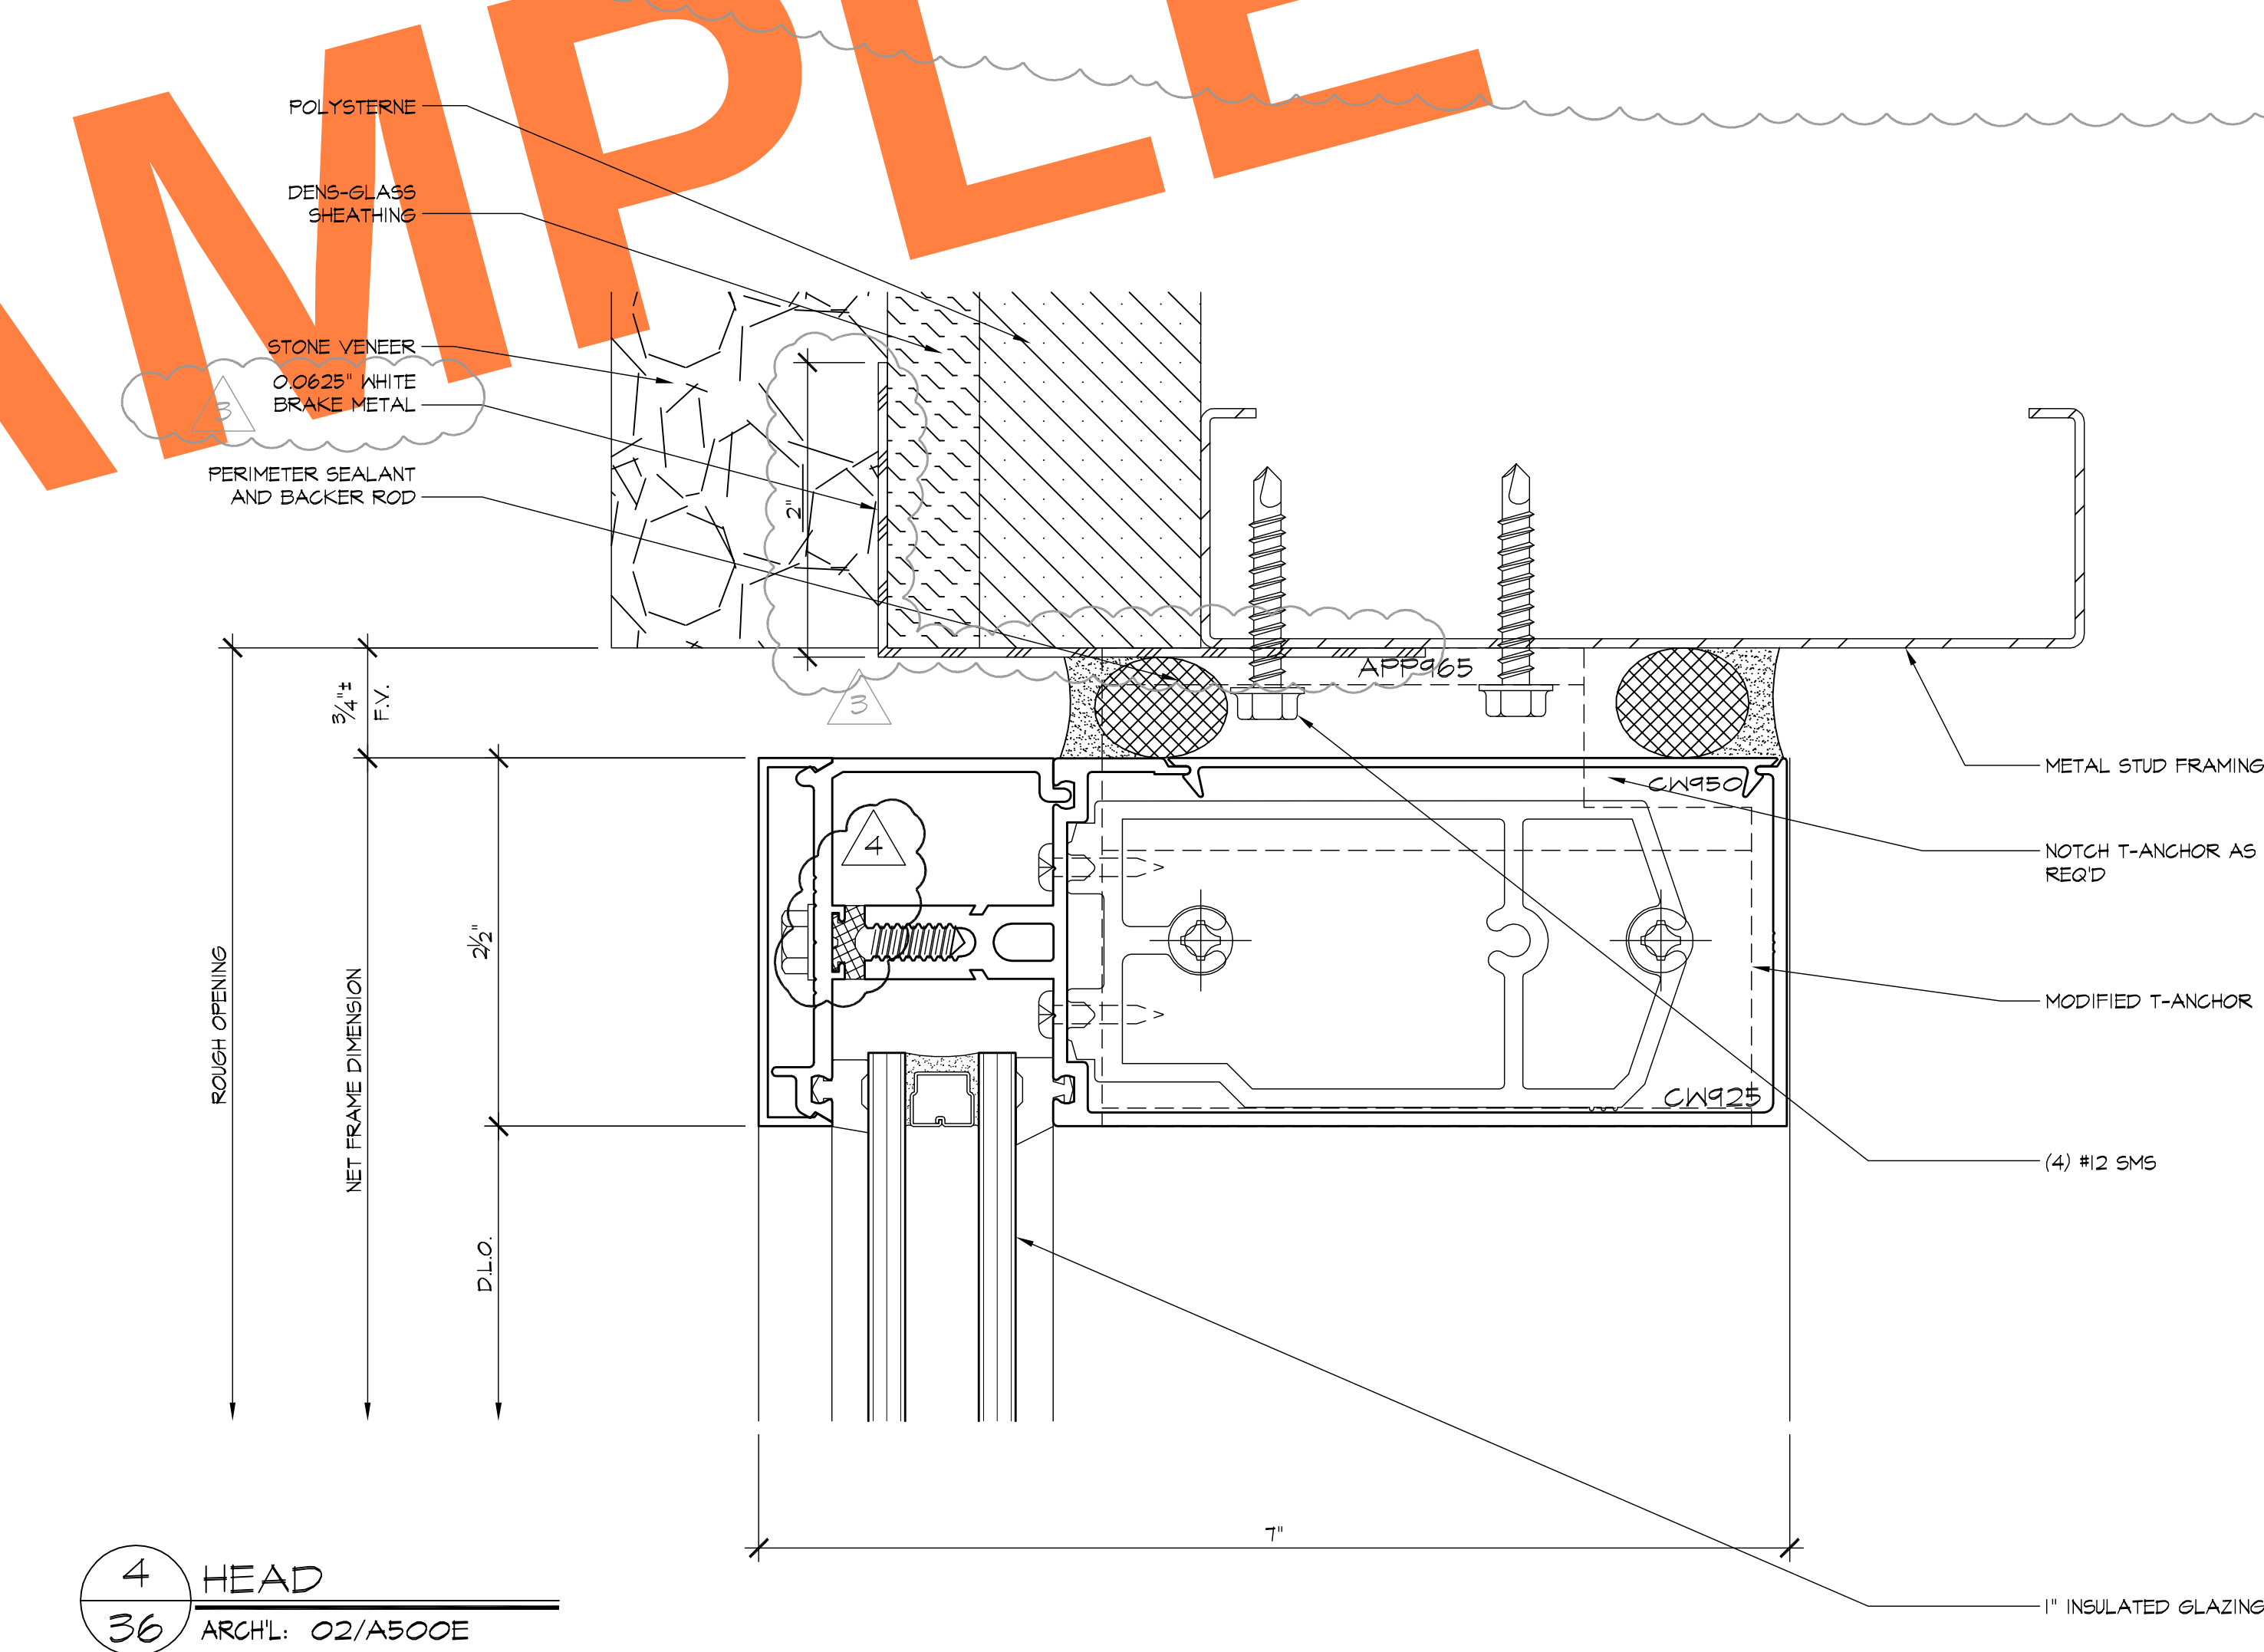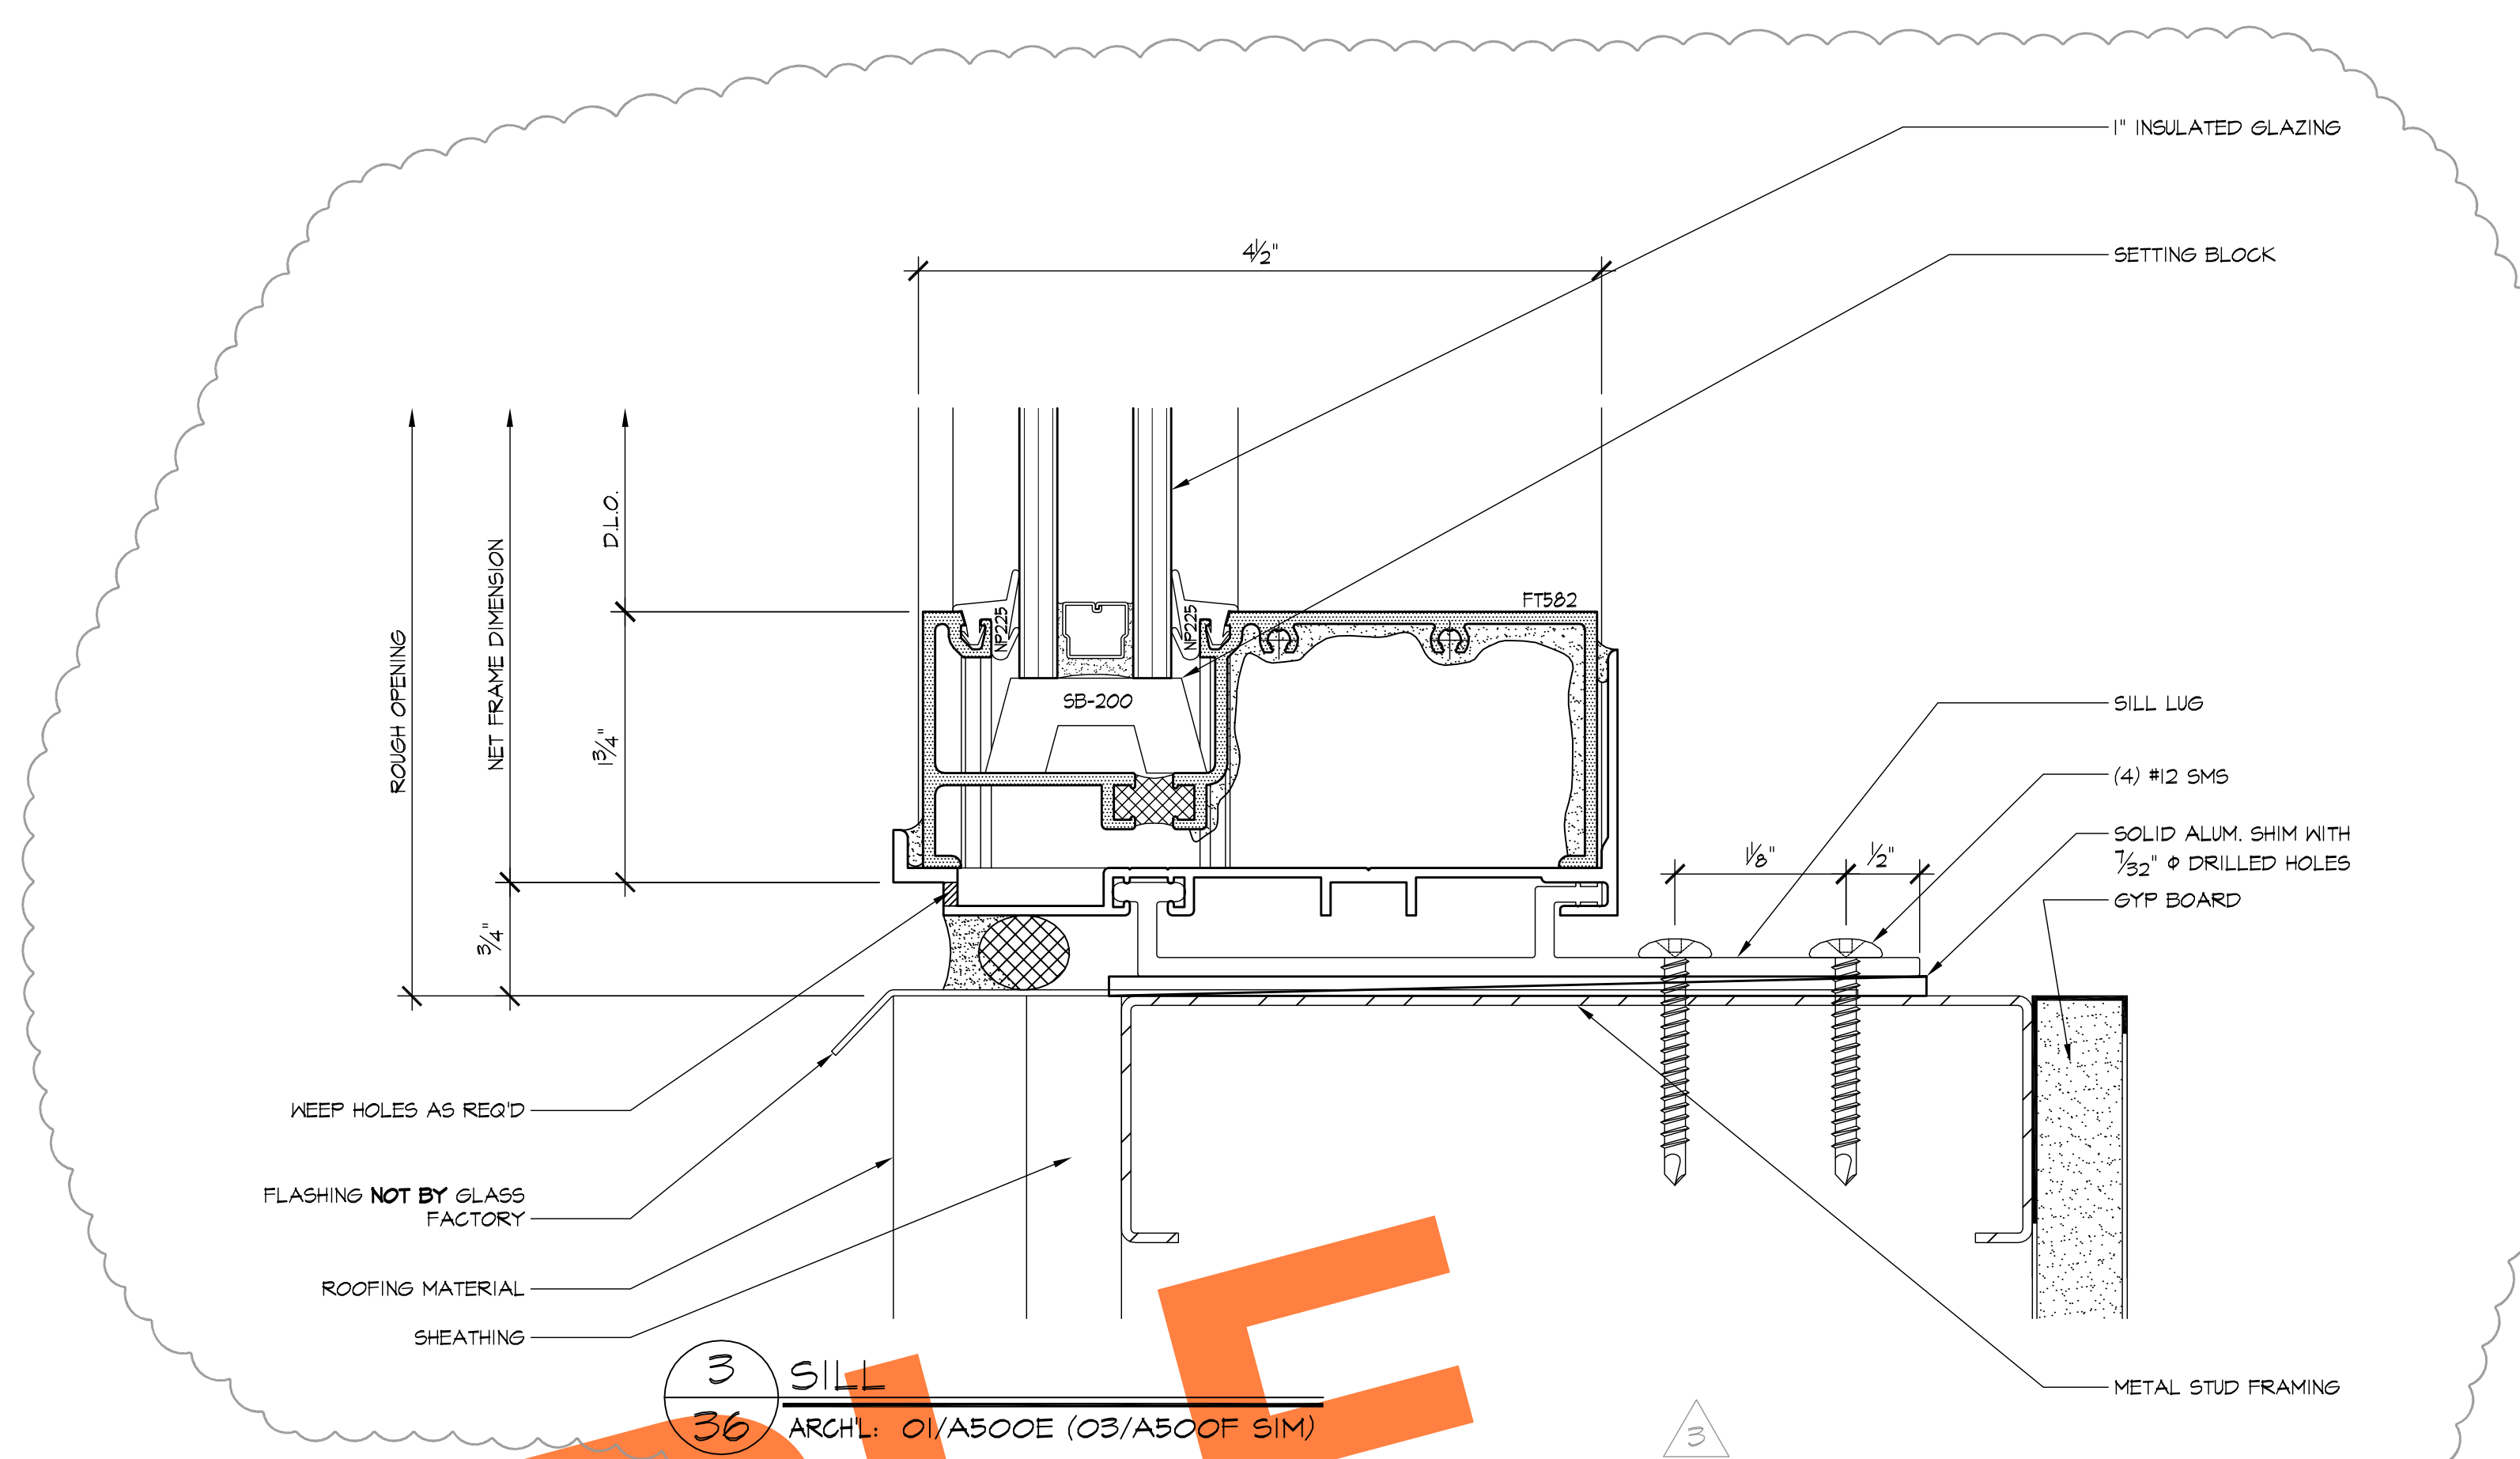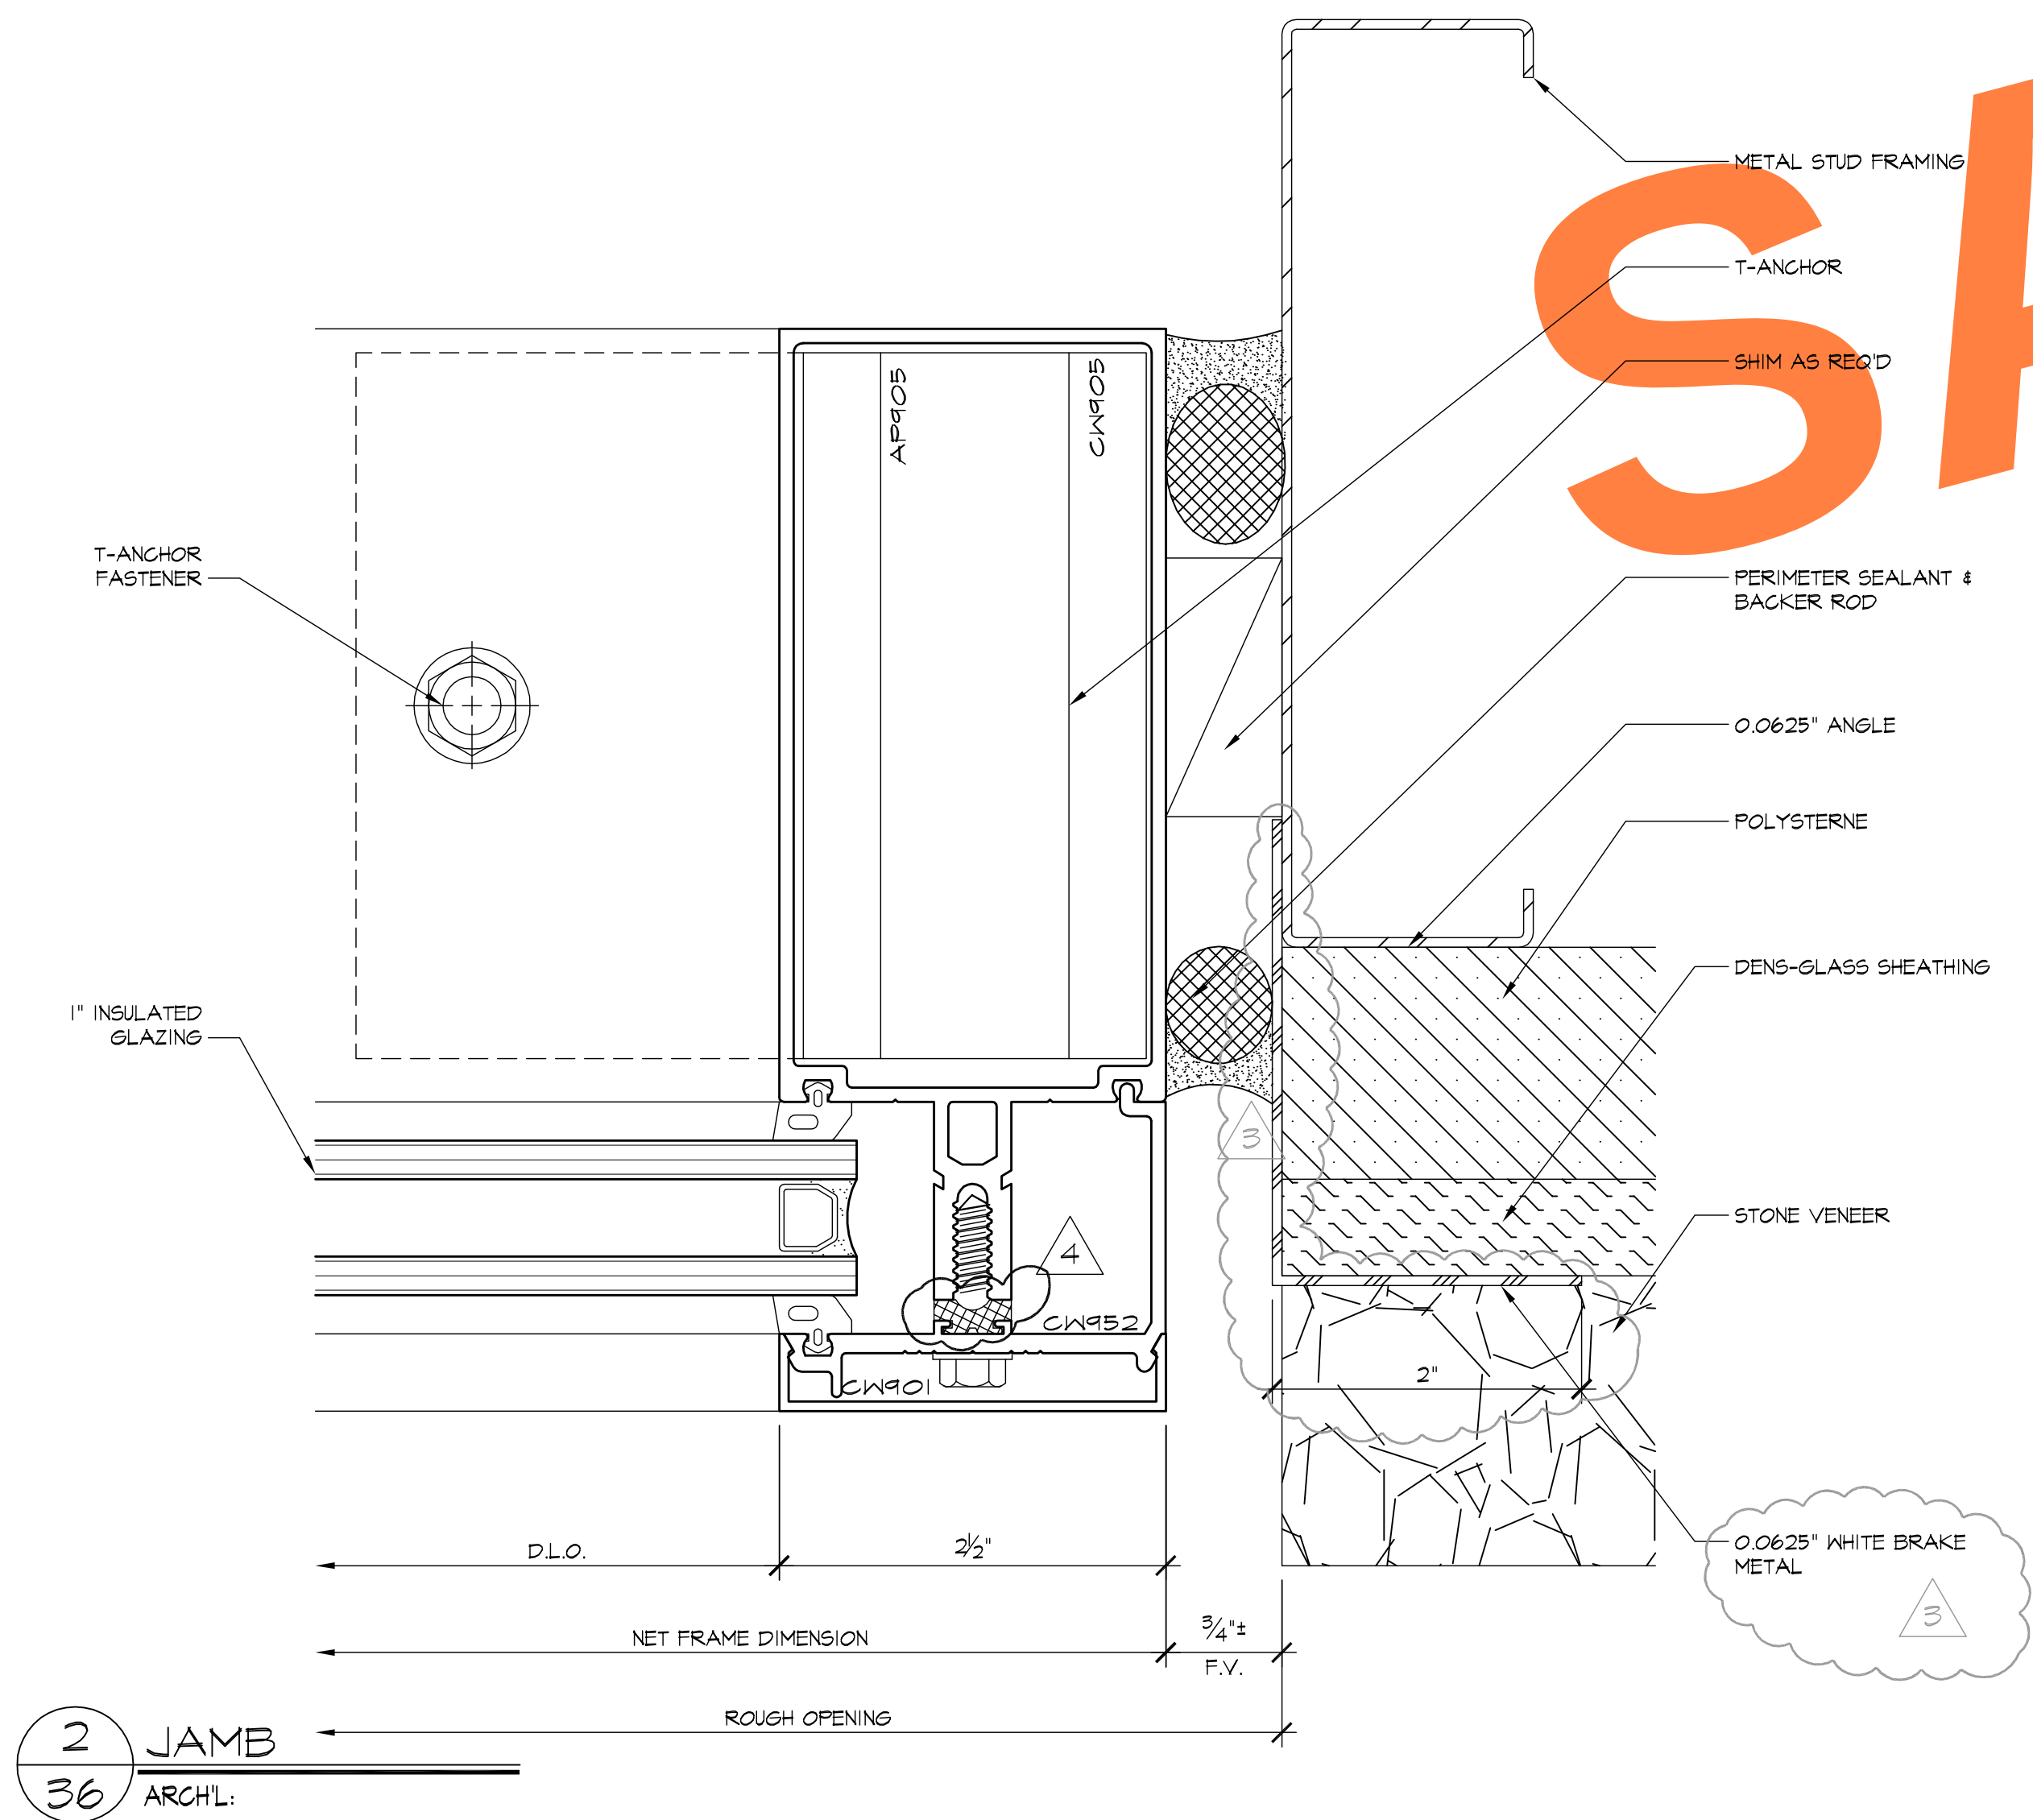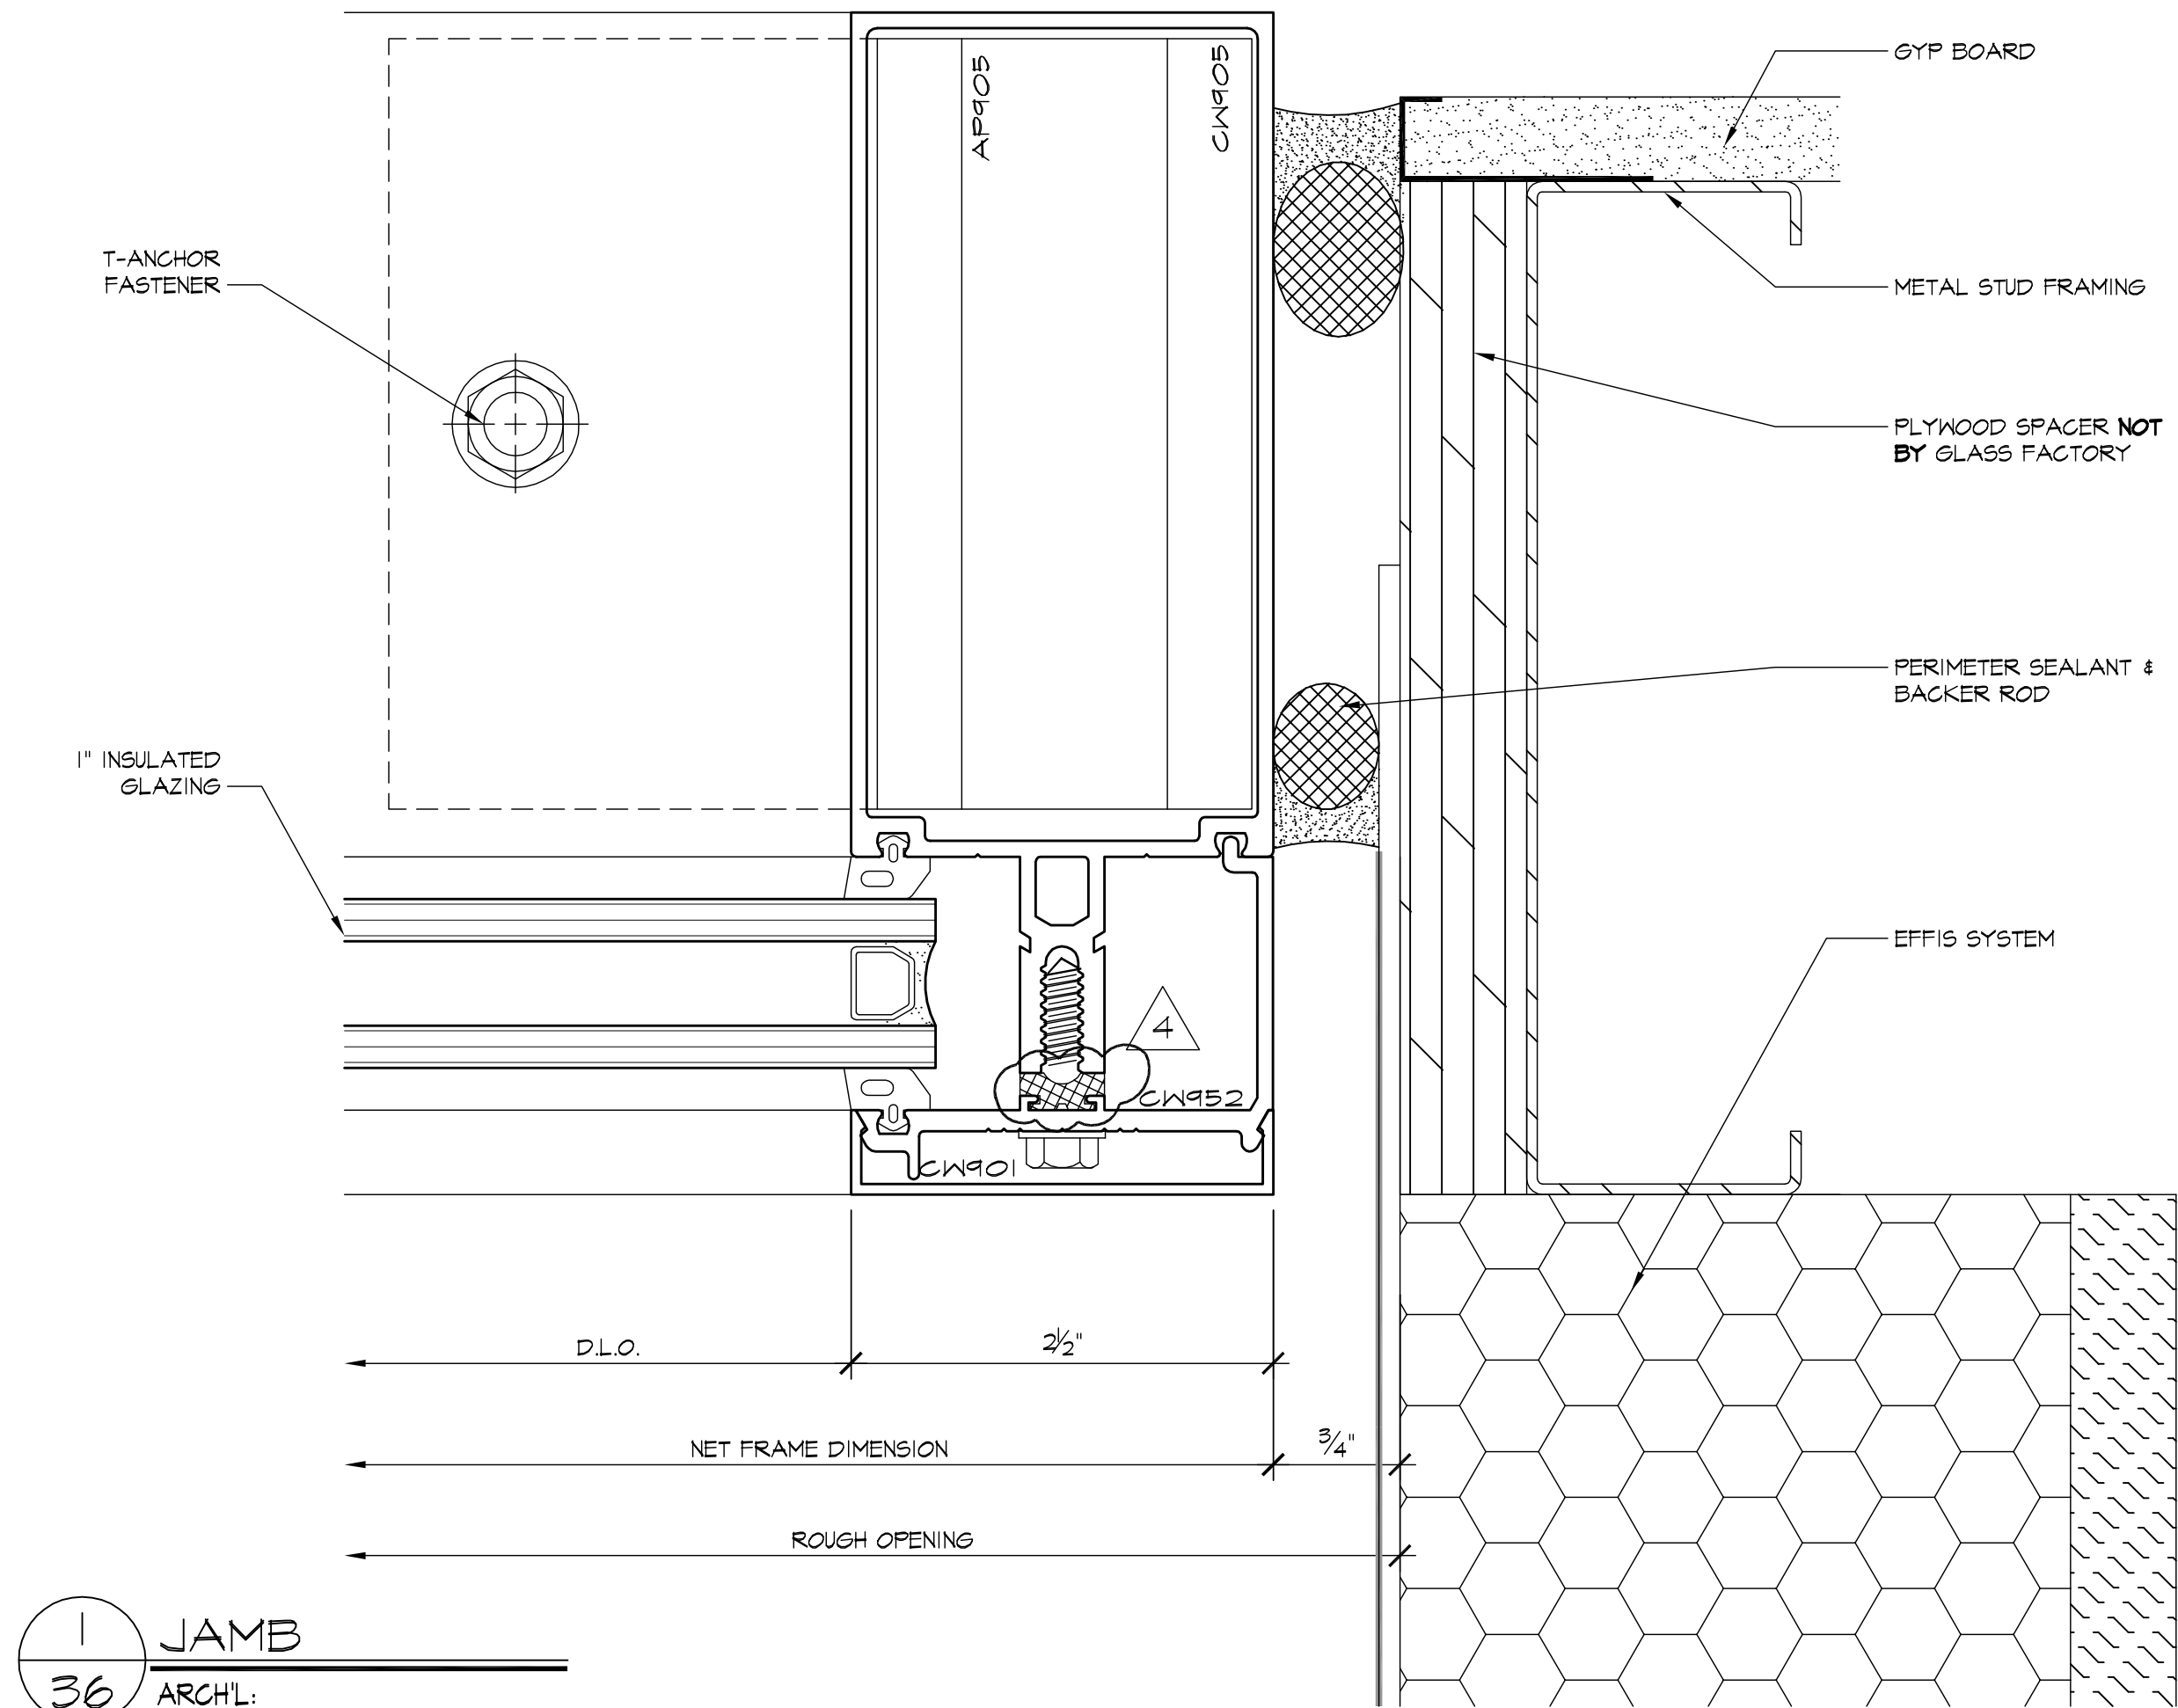

REVISIONS		BY
△	4-23-07	BMR
△	6-11-07	BMR
△	12-17-07	CTB
△	3/6/08	CTB
△		


BMR DRAFTING SERVICE SINCE 1988 23846 SUNNYMEAD BLVD. SUITE #9 MORENO VALLEY, CA 92553 P: (951) 243-7814 F: (951) 243-7873	
GLASS FACTORY 26383 BASE LINE HIGHLAND, CA 92346	
AS-BUILT DRAWINGS	

JOB NAME:	AGUA CALIENTE HOTEL ADDITION
ARCHITECT:	VOA
SHEET DESCRIPTION:	DETAILS
DATE:	1/3/07
SCALE:	FULL
DRAWN:	CTB
JOB NO:	100-06
SHEET NO:	36

THIS DTL. NOT USED

1 CORNER
38 ARCHL:

2 CORNER
38 ARCHL:

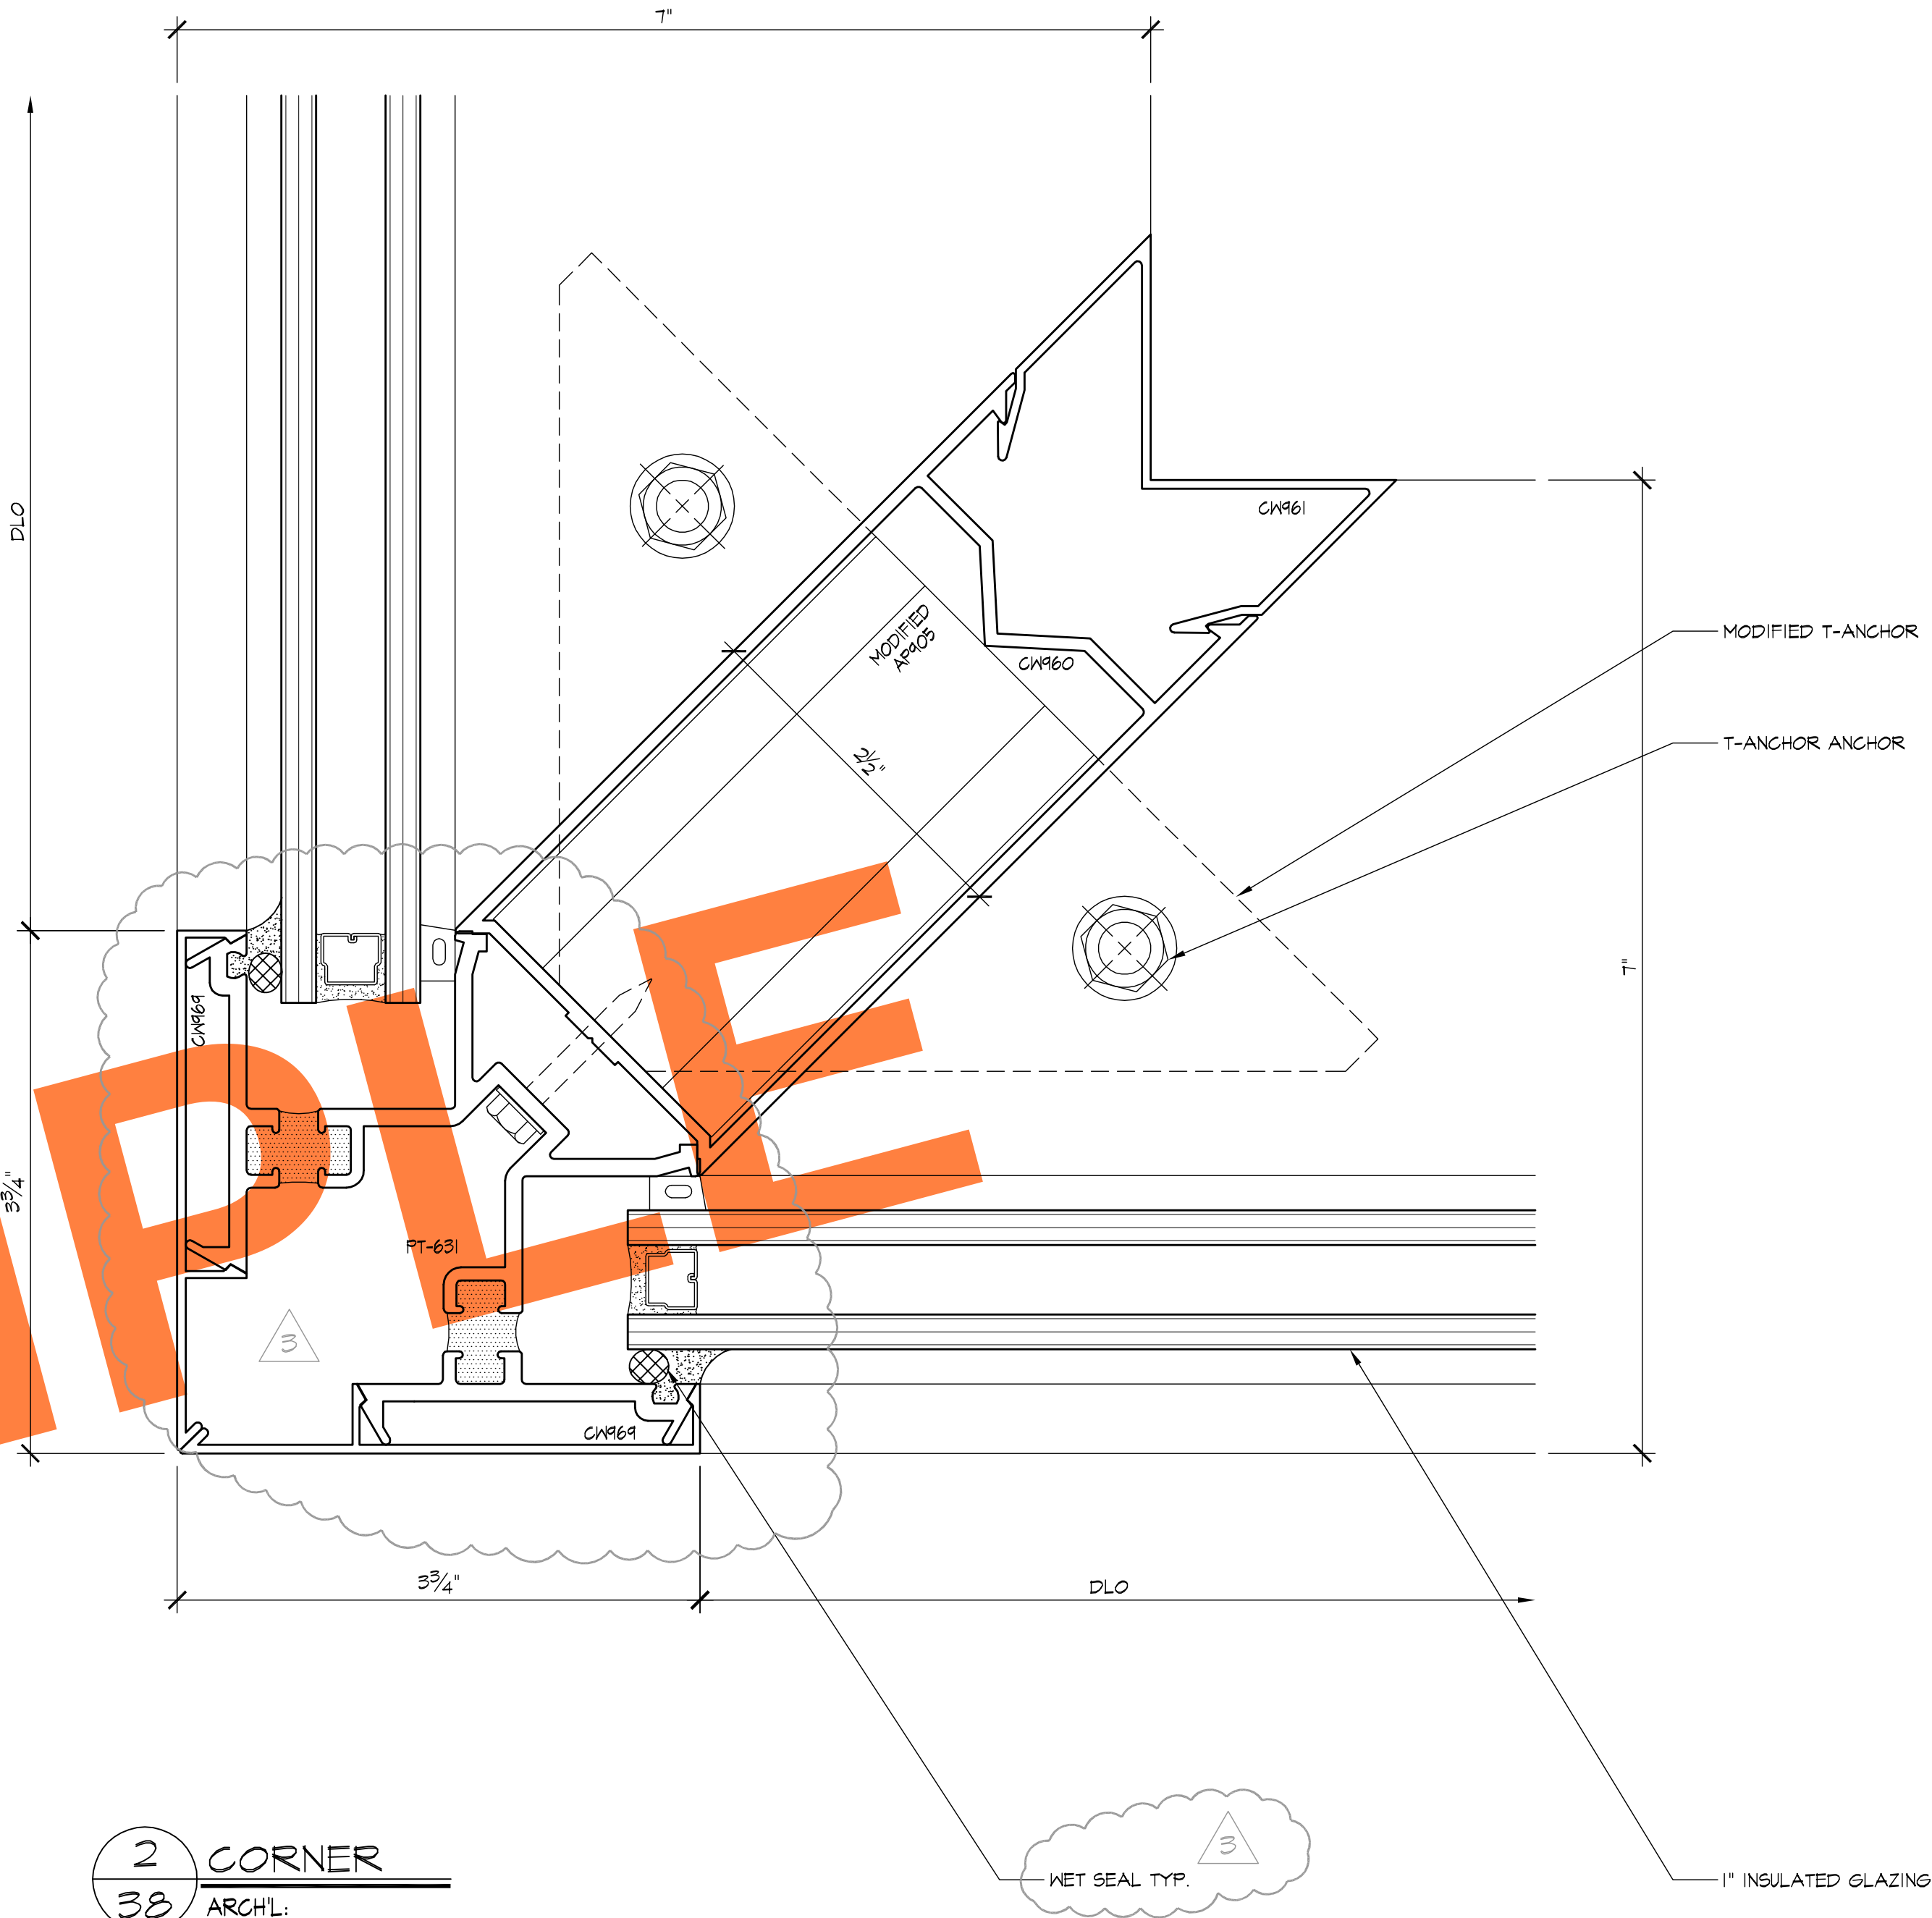


REVISIONS	BY
△ 4-23-07	BMR
△ 6-11-07	BMR
△ 12-17-07	CTB
△ 3/6/08	CTB
△	

BMR
DRAFTING SERVICE
SINCE 1988
23846 SUNNYMEAD BLVD.
SUITE #9
MORENO VALLEY, CA 92553
B: (951) 243-7814
F: (951) 243-7873

GLASS FACTORY
26383 BASE LINE
HIGHLAND, CA 92346


AS-BUILT DRAWINGS

JOB NAME:	AGUA CALIENTE HOTEL ADDITION
ARCHITECT:	VOA
SHEET DESCRIPTION:	DETAILS
DATE:	1/3/07
SCALE:	FULL
DRAWN:	CTB
JOB NO:	100-06
SHEET NO:	38

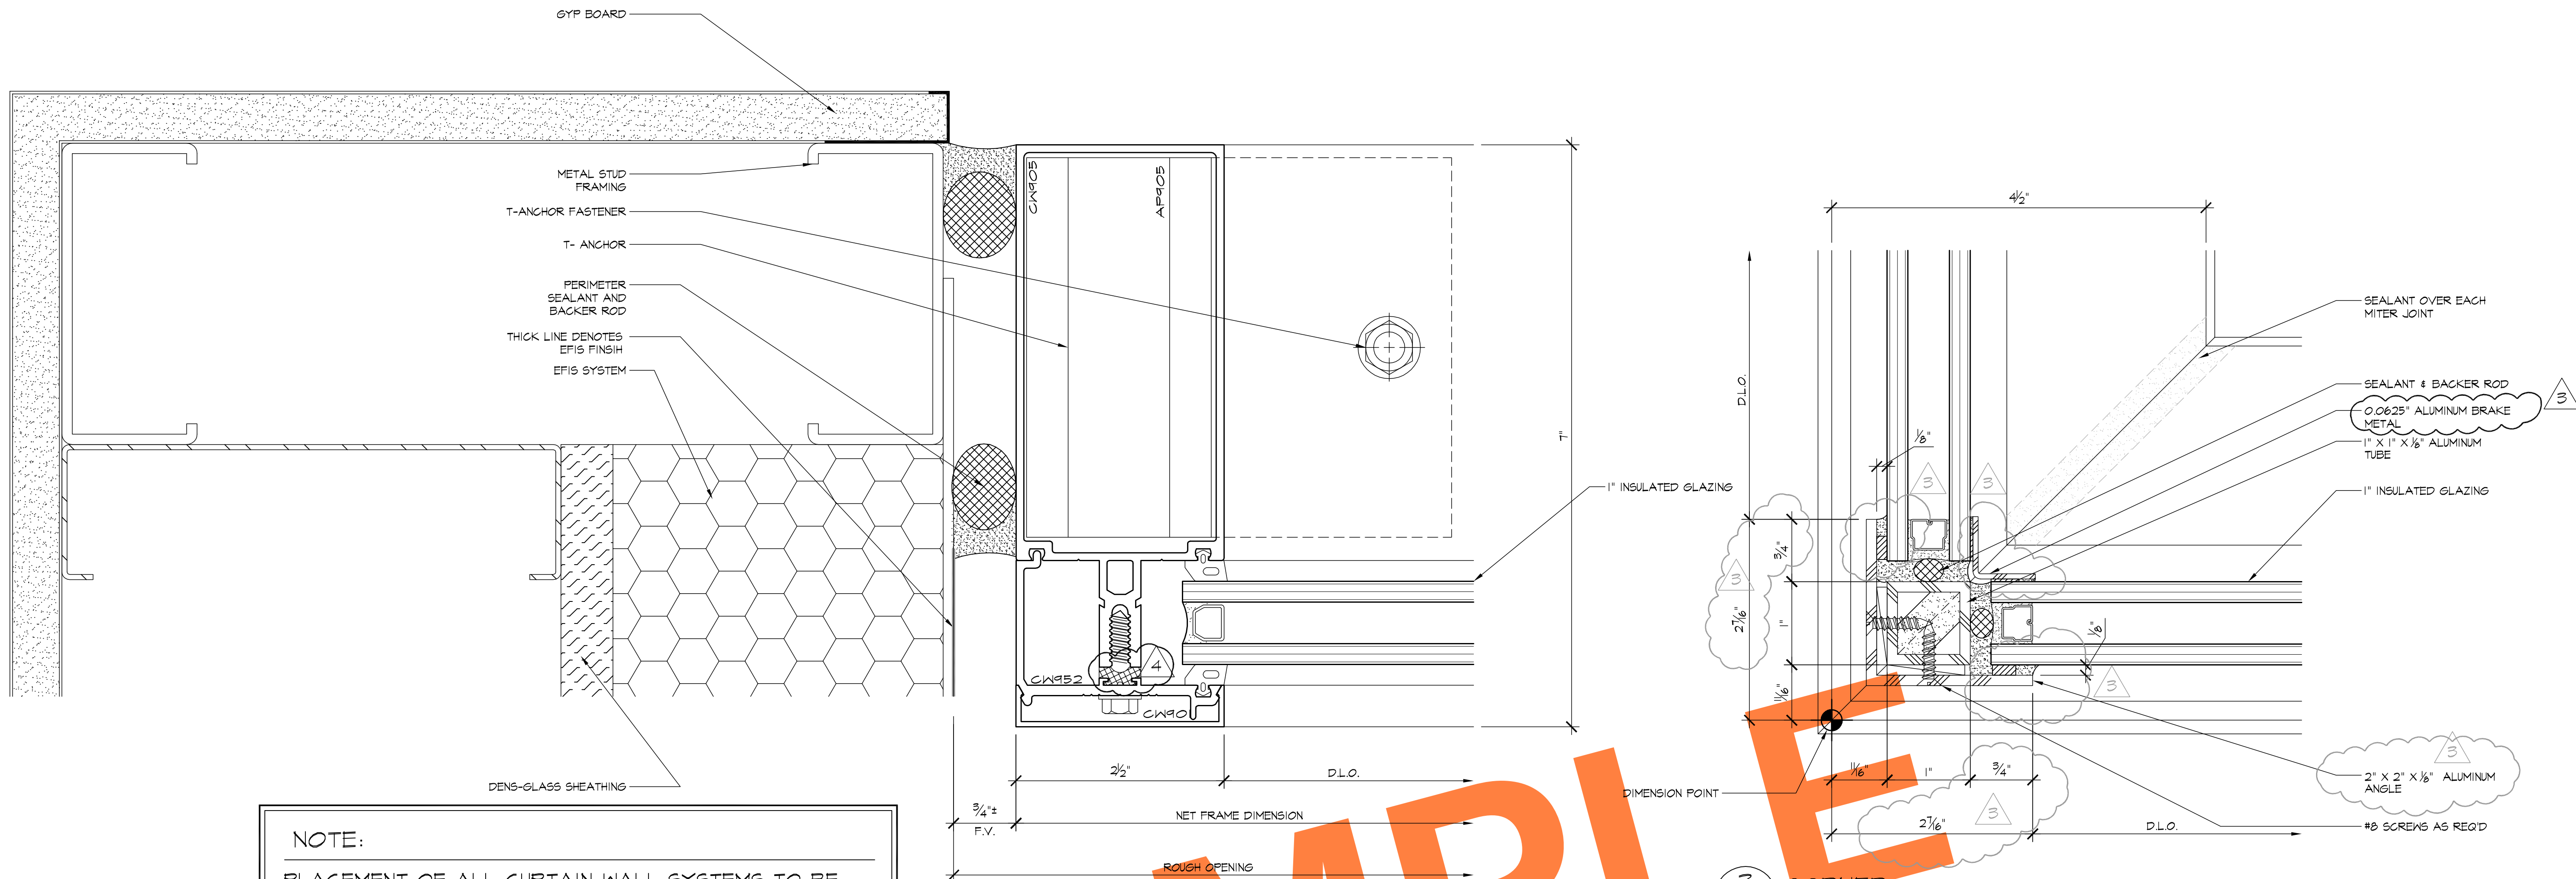

NOTE:
PLACEMENT OF ALL CURTAIN WALL SYSTEMS TO BE COORDINATED WITH KHS & S FOR PROPER PLACEMENT ON EFIS WALLS - TYPICAL

1 JAMB
39 ARCH'L:

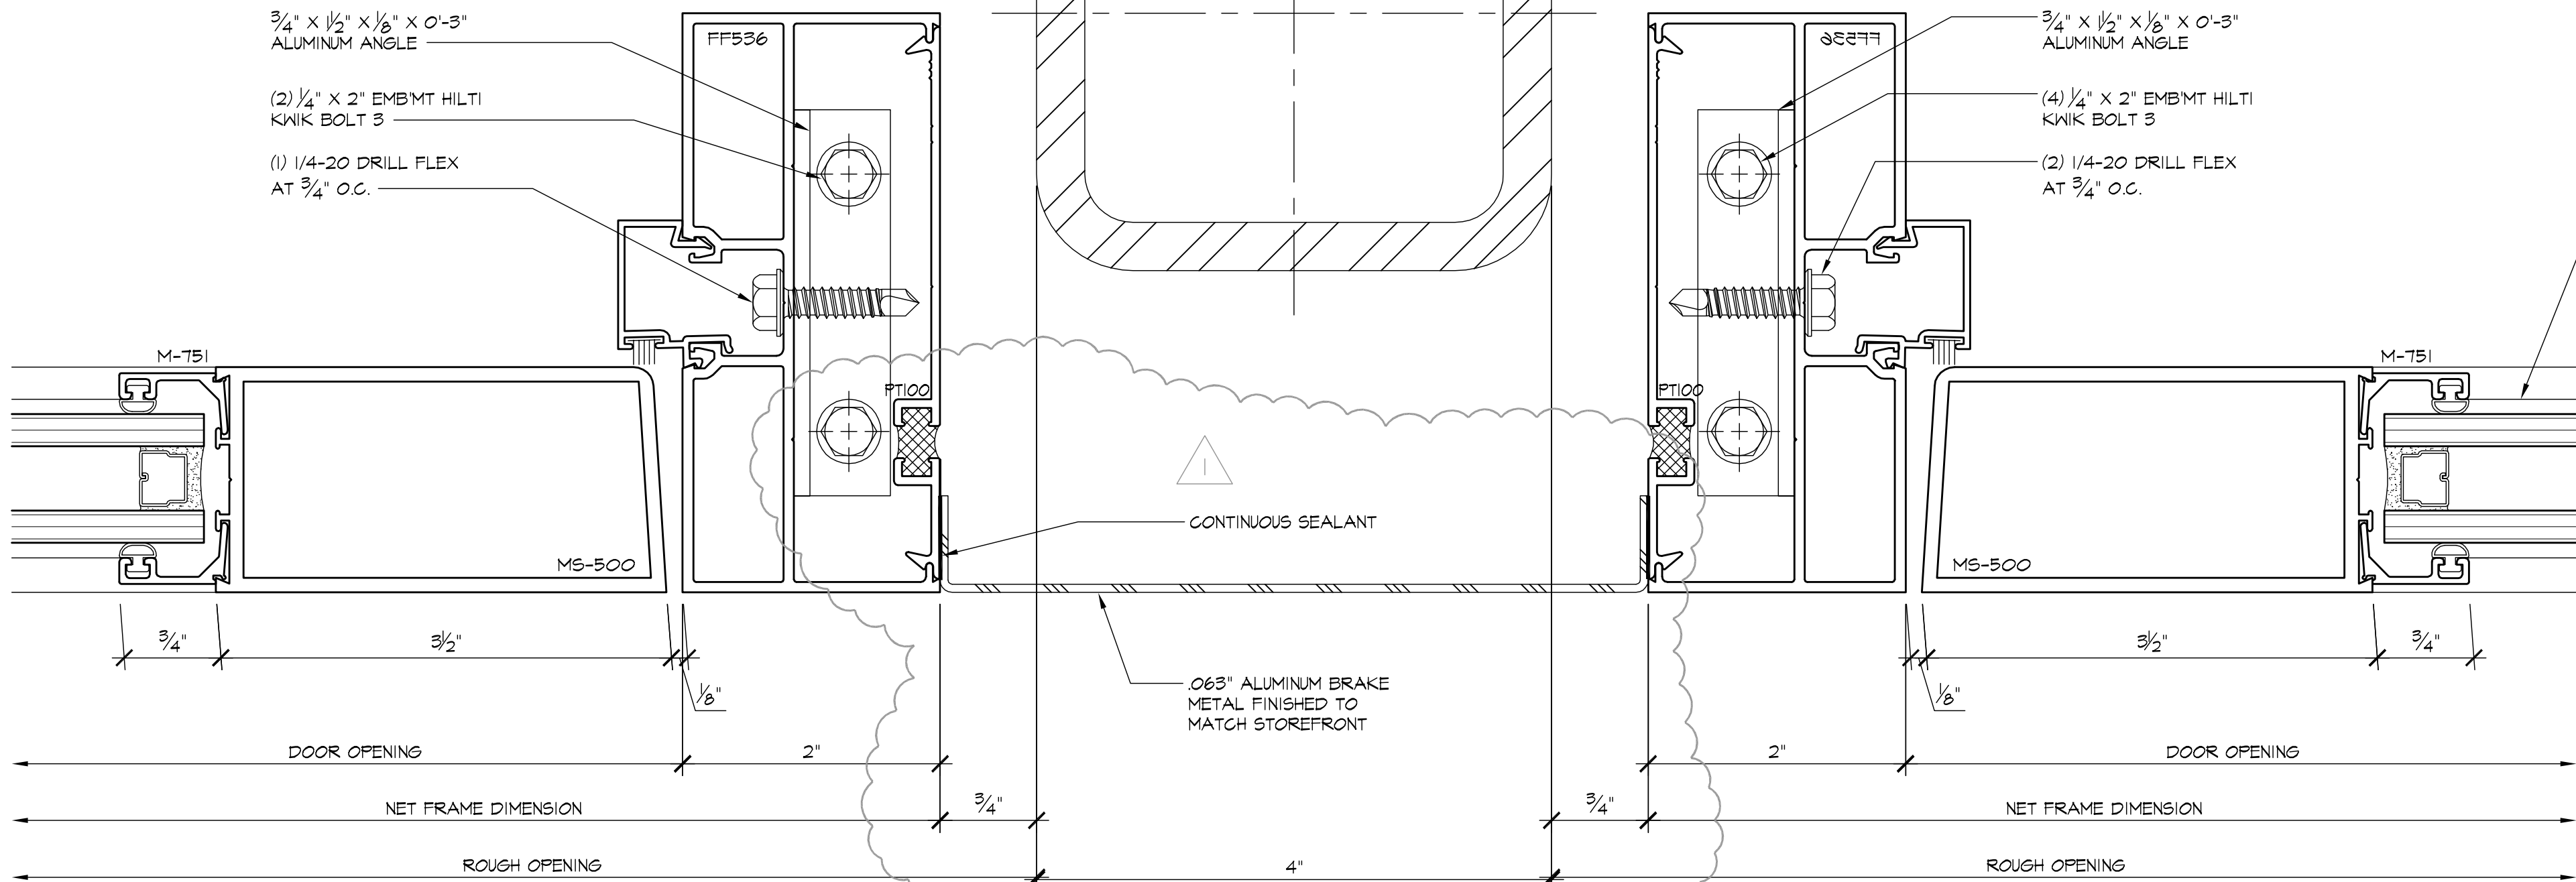

2 DOOR JAMB
39 ARCH'L:


REVISIONS	BY
4-23-07	BMR
6-11-07	BMR
12-17-07	CTB
3/6/08	CTB

BMR
DRAFTING SERVICE
SINCE 1988
23846 SUNNYMEAD BLVD.
SUITE #9
MORENO VALLEY, CA 92553
P: (951) 243-7814
F: (951) 243-7873

GLASS FACTORY
26383 BASE LINE
HIGHLAND, CA 92346

AS-BUILT DRAWINGS

JOB NAME:	AGUA CALIENTE HOTEL ADDITION
ARCHITECT:	VOA
SHEET DESCRIPTION:	DETAILS
DATE:	1/3/07
SCALE:	FULL
DRAWN:	CTB
JOB NO:	100-06
SHEET NO:	39

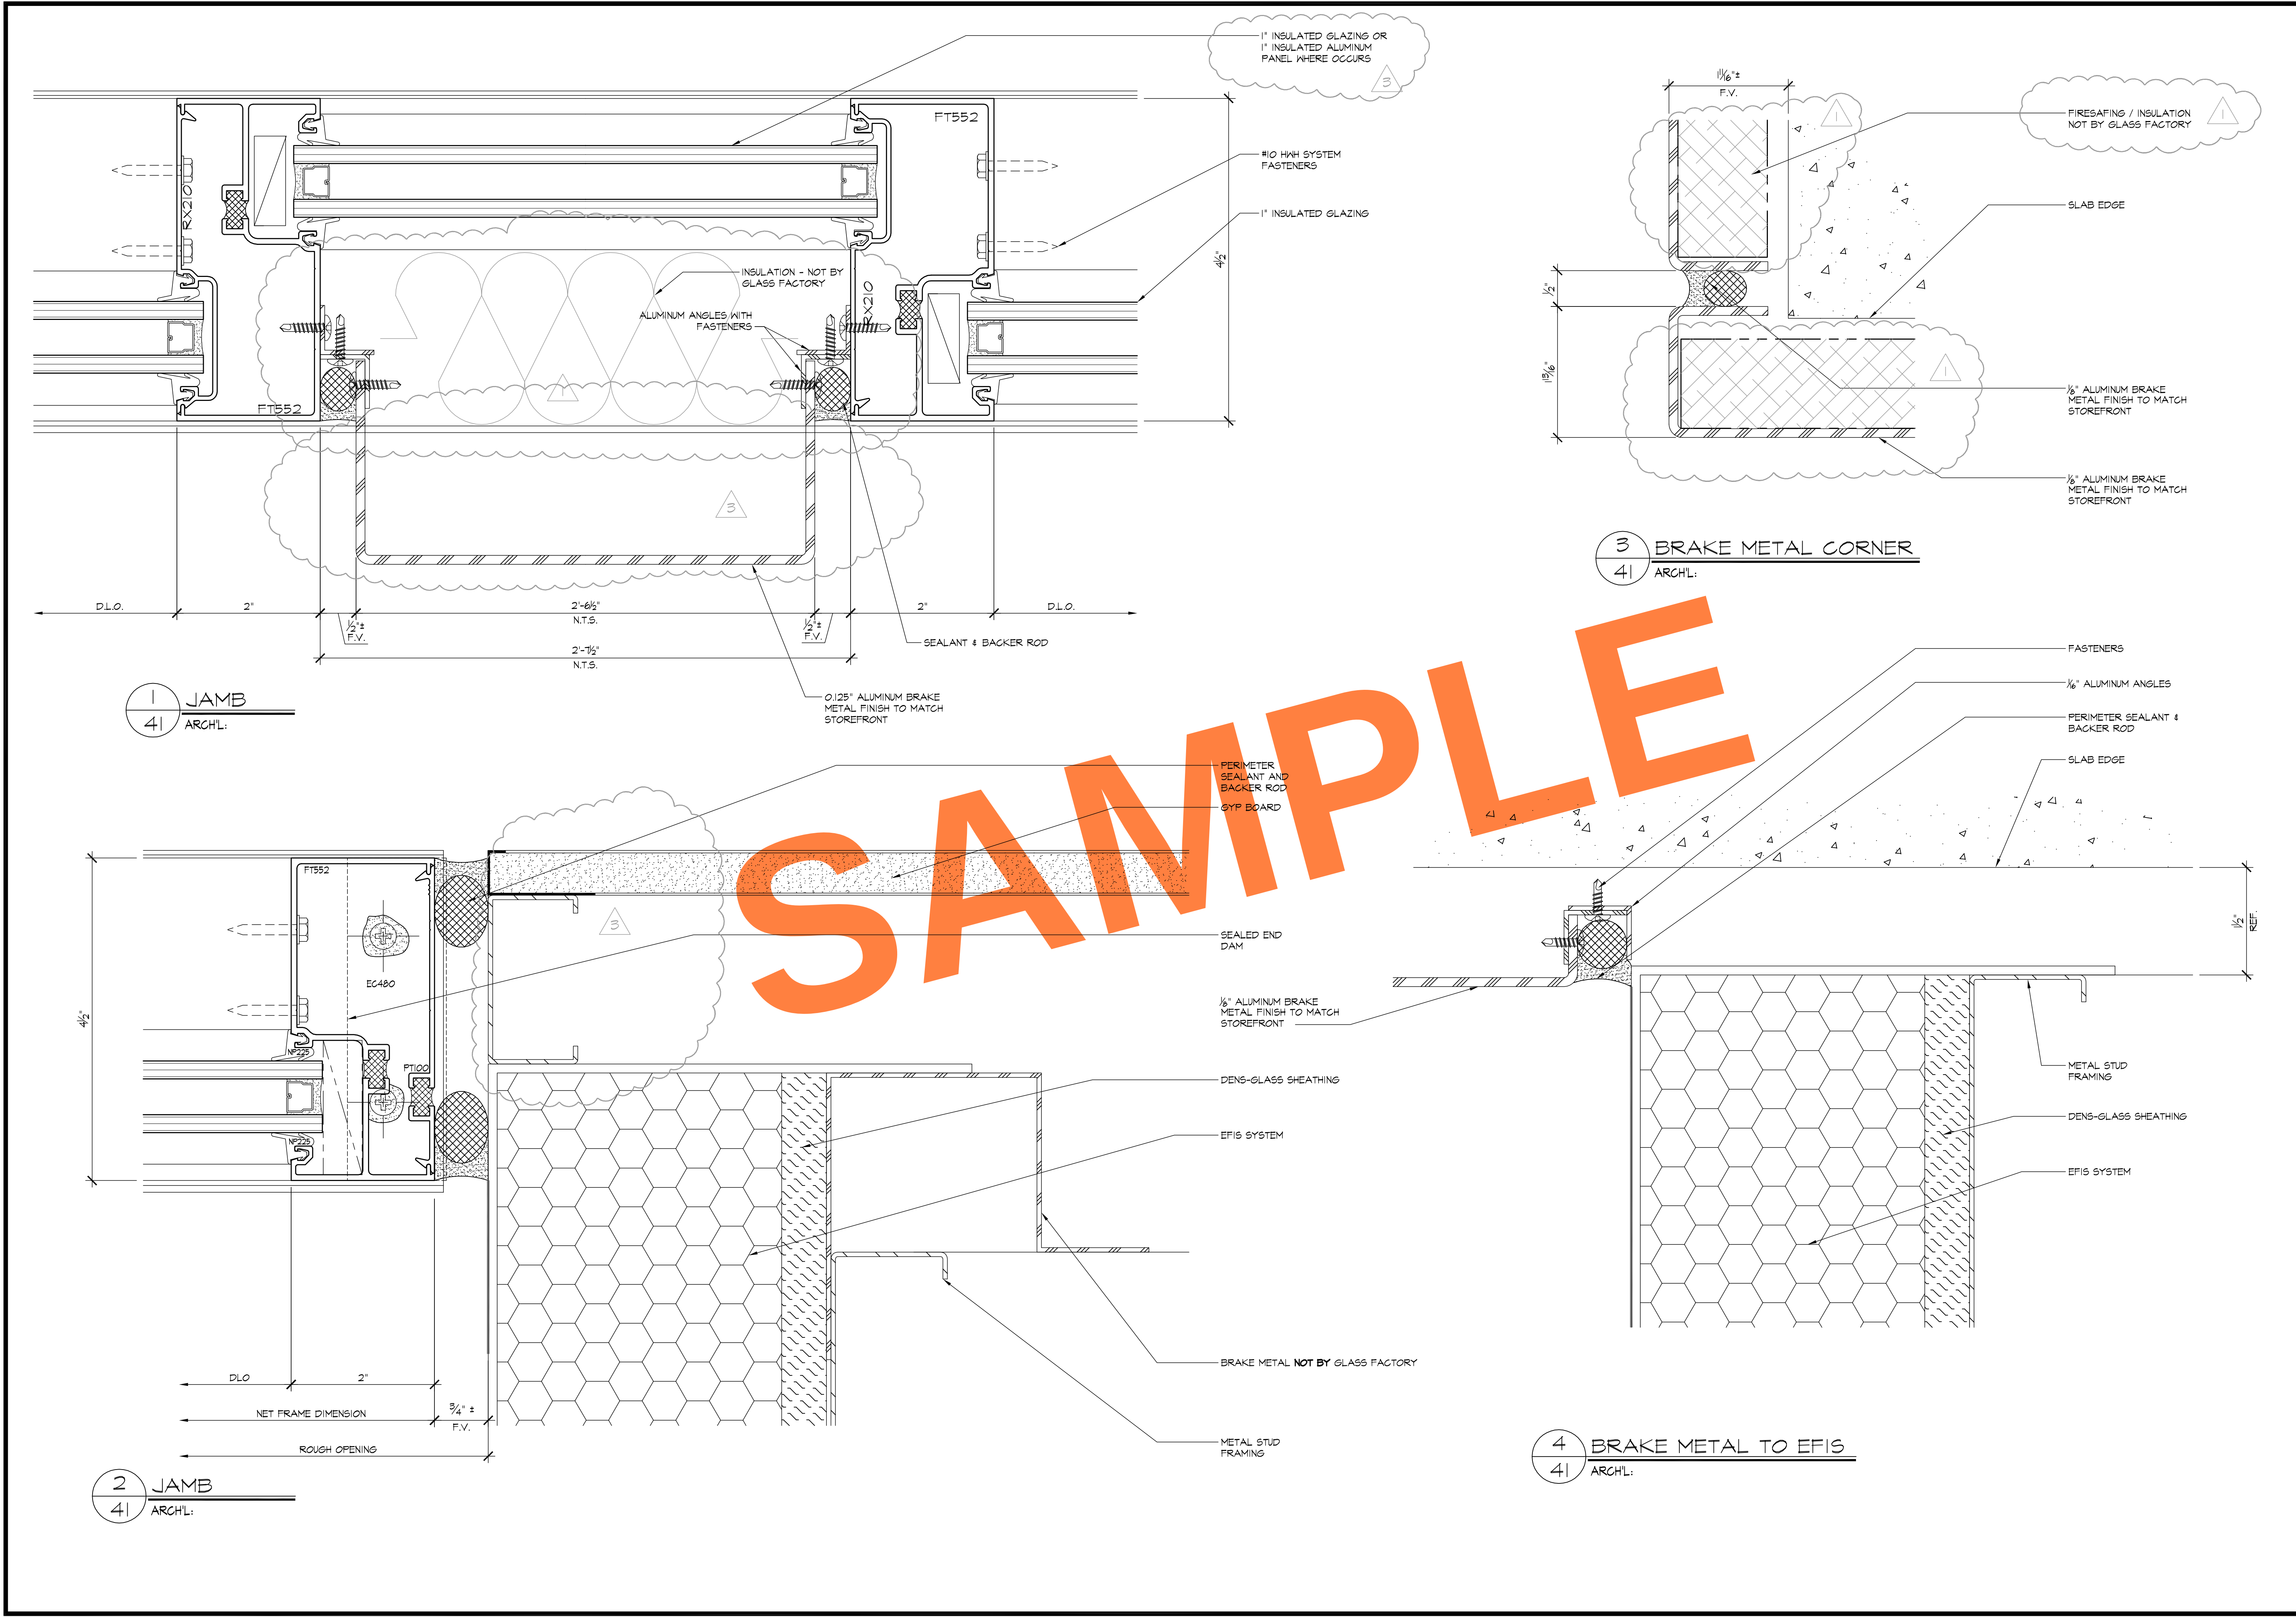


REVISIONS	BY
△ 4-23-07	BMR
△ 6-11-07	BMR
△ 12-17-07	CTB
△ 3/6/08	CTB
△	

BMR
DRAFTING SERVICE
SINCE 1988
23846 SUNNYMEAD BLVD.
SUITE #9
MORENO VALLEY, CA 92553
B: (951) 243-7814
F: (951) 243-7873

GLASS FACTORY
26383 BASE LINE
HIGHLAND, CA 92346

AS-BUILT DRAWINGS

JOB NAME:	AGUA CALIENTE HOTEL ADDITION
ARCHITECT:	VOA
SHEET DESCRIPTION:	DETAILS
DATE:	1/3/07
SCALE:	FULL
DRAWN:	CTB
JOB NO:	100-06
SHEET NO:	41

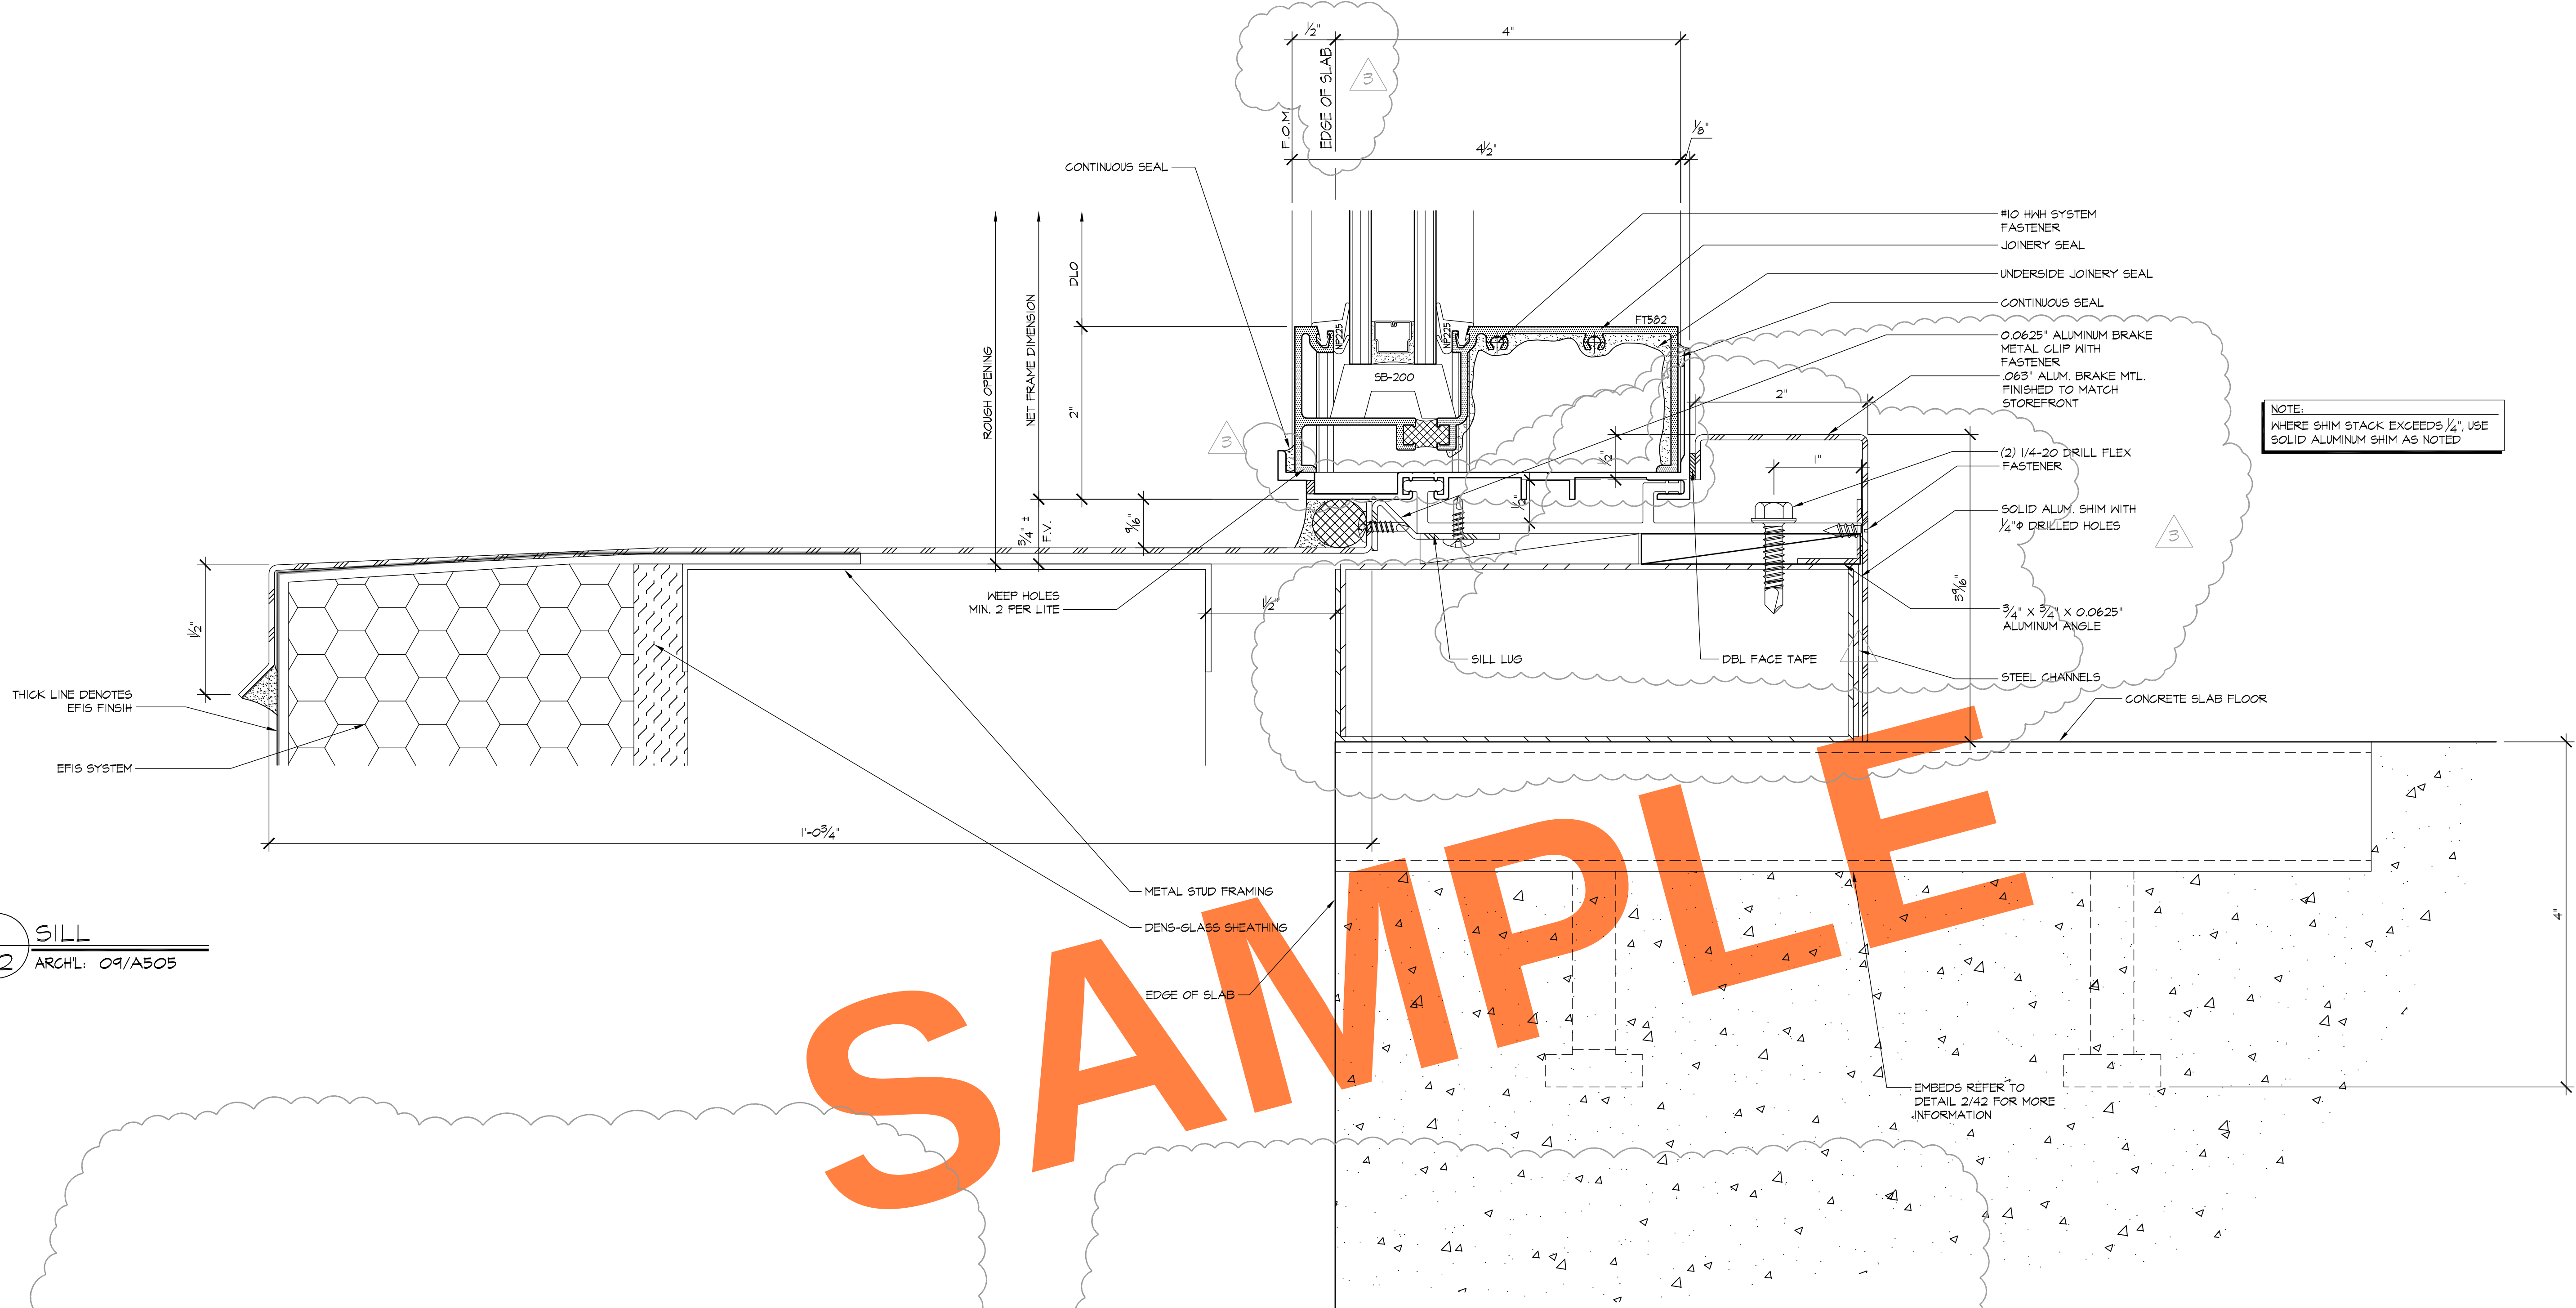

1 SILL
42 ARCH'L: 09/A505

2 HORIZONTAL
42 ARCH'L:

3 HORIZONTAL
42 ARCH'L:

4 SPLICE
42 ARCH'L:

REVISIONS	BY
△ 4-23-07	BMR
△ 6-11-07	BMR
△ 12-17-07	CTB
△ 3/6/08	CTB
△	

BMR
DRAFTING SERVICE
SINCE 1988
23846 SUNNYMEAD BLVD.
SUITE #9
MORENO VALLEY, CA 92553
B: (951) 243-7814
F: (951) 243-7873


GLASS FACTORY
26383 BASE LINE
HIGHLAND, CA 92346

AS-BUILT DRAWINGS


JOB NAME: AGUA CALIENTE HOTEL ADDITION
ARCHITECT: VOA
SHEET DESCRIPTION: DETAILS

DATE: 1/3/07
SCALE: FULL
DRAWN: CTB
JOB NO: 100-06
SHEET NO:


42

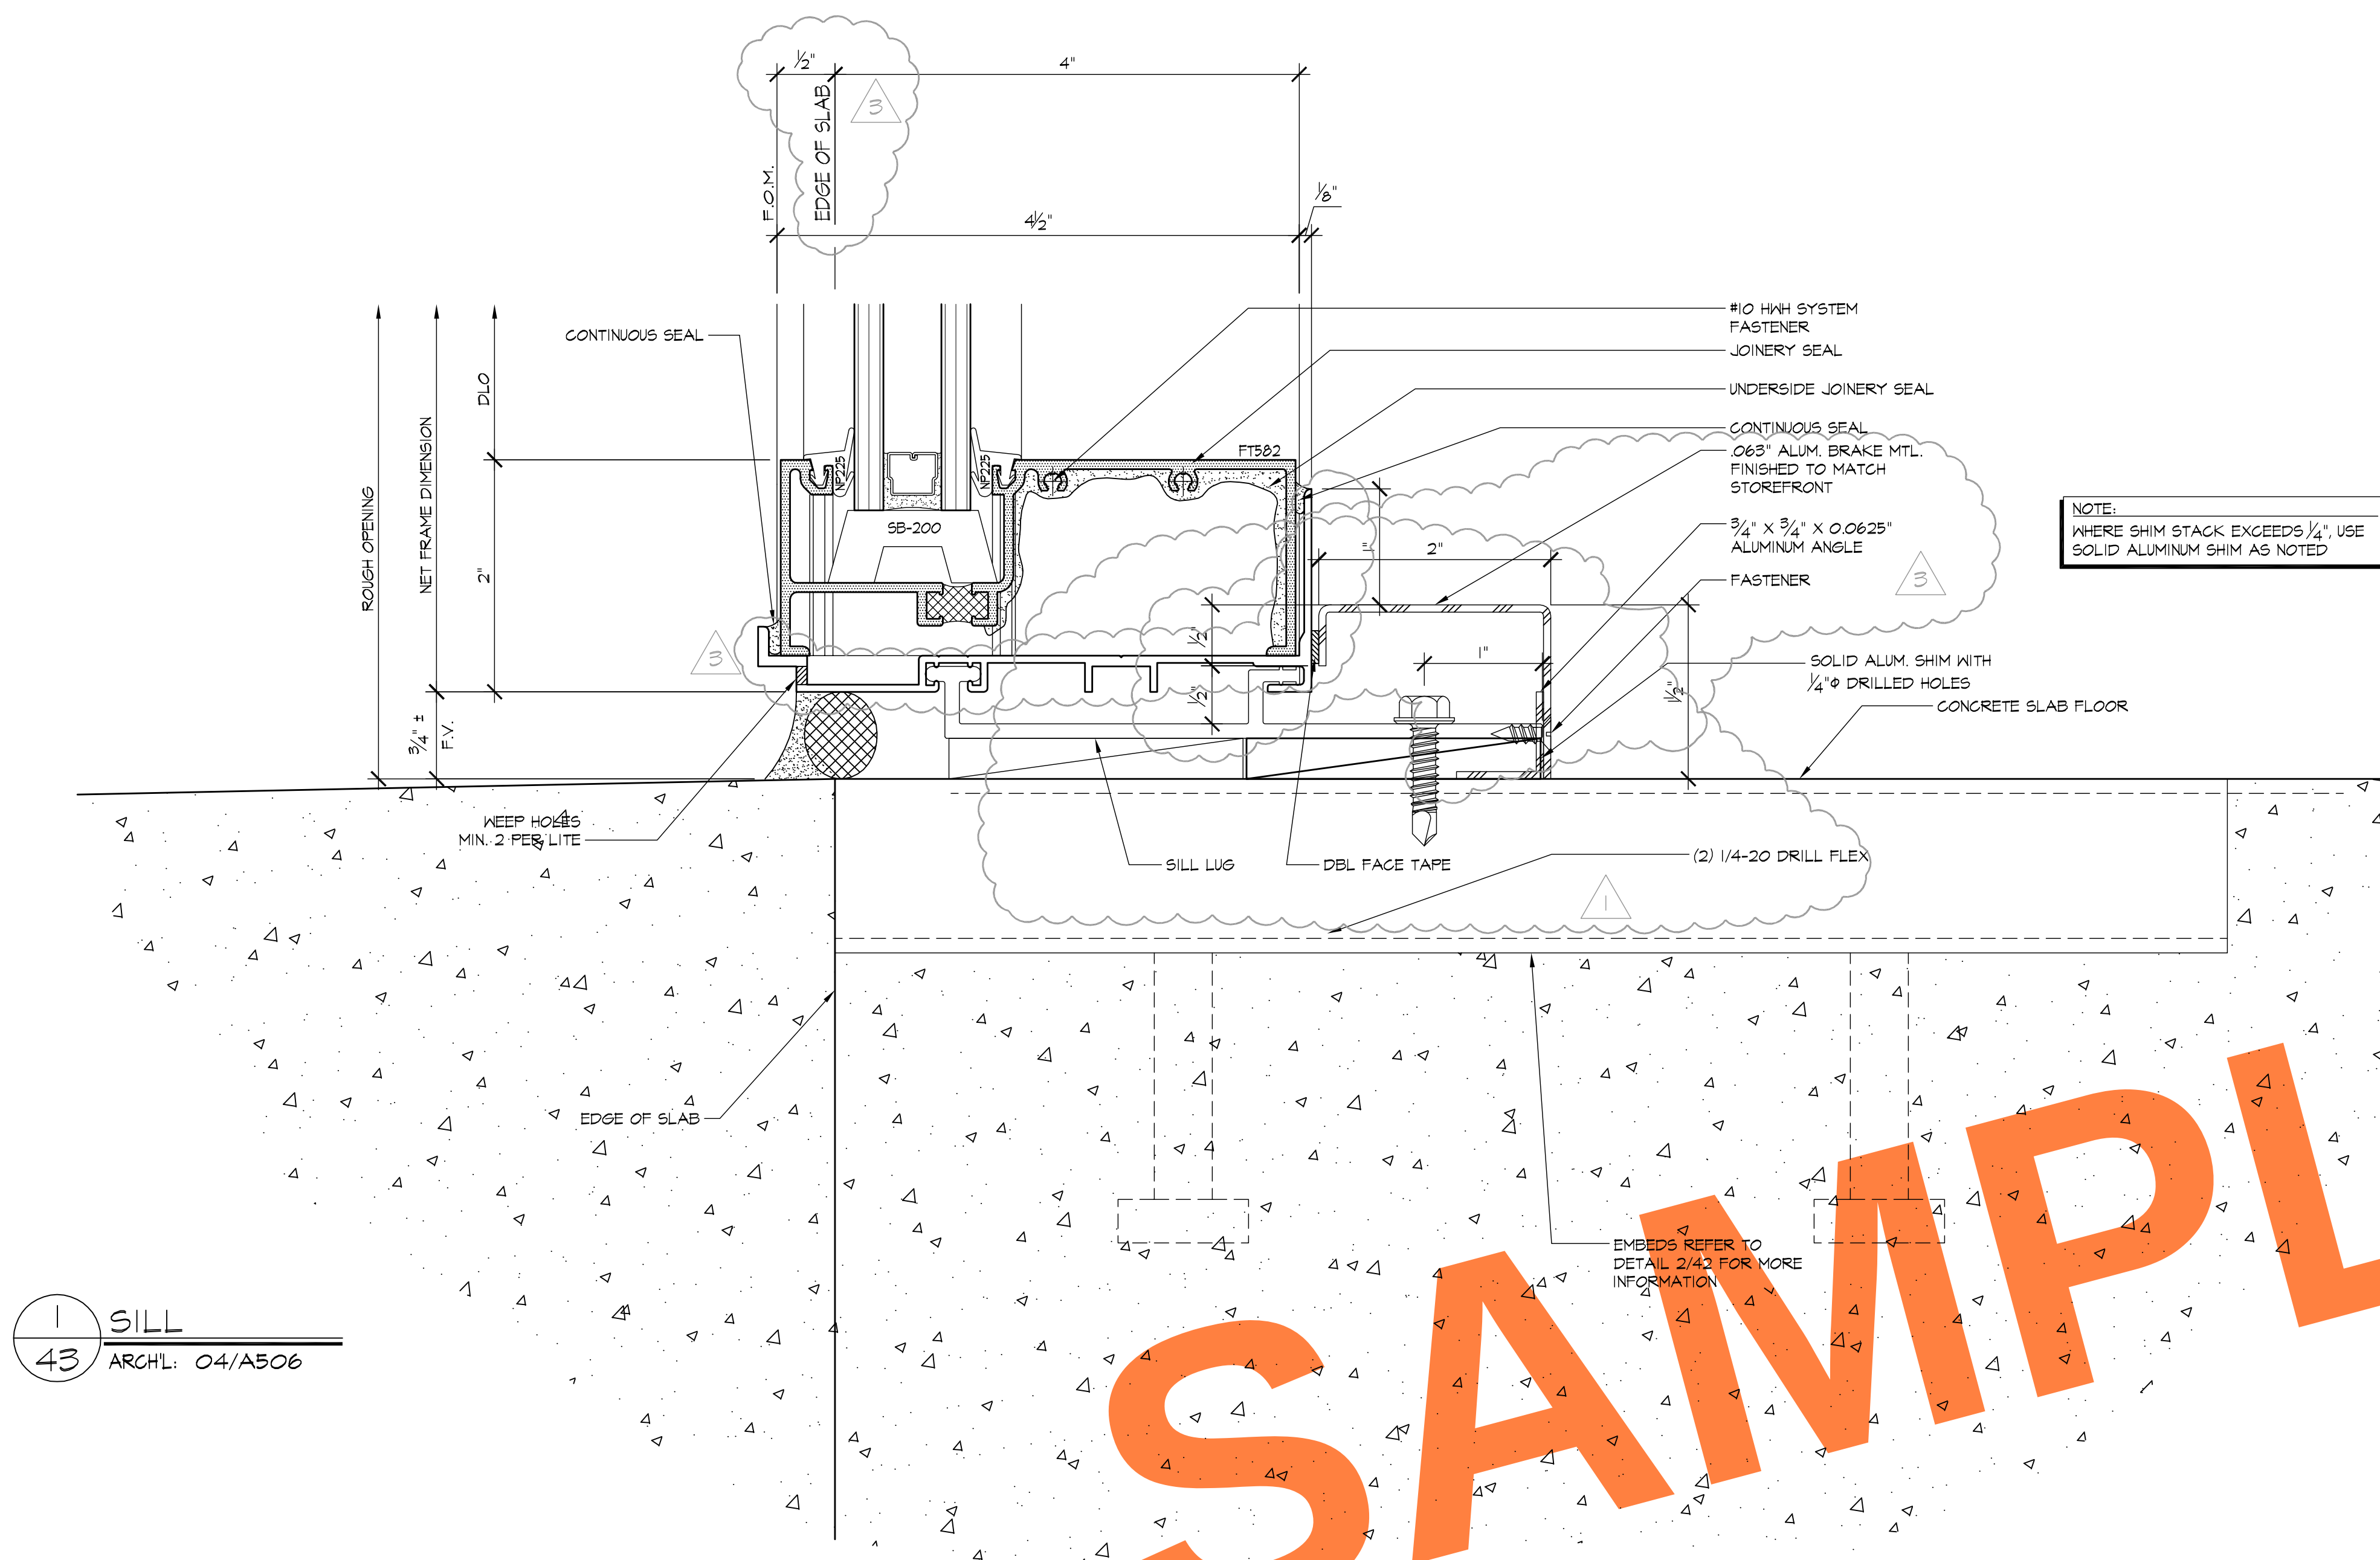

1 SILL
43 ARCH'L: 04/A506

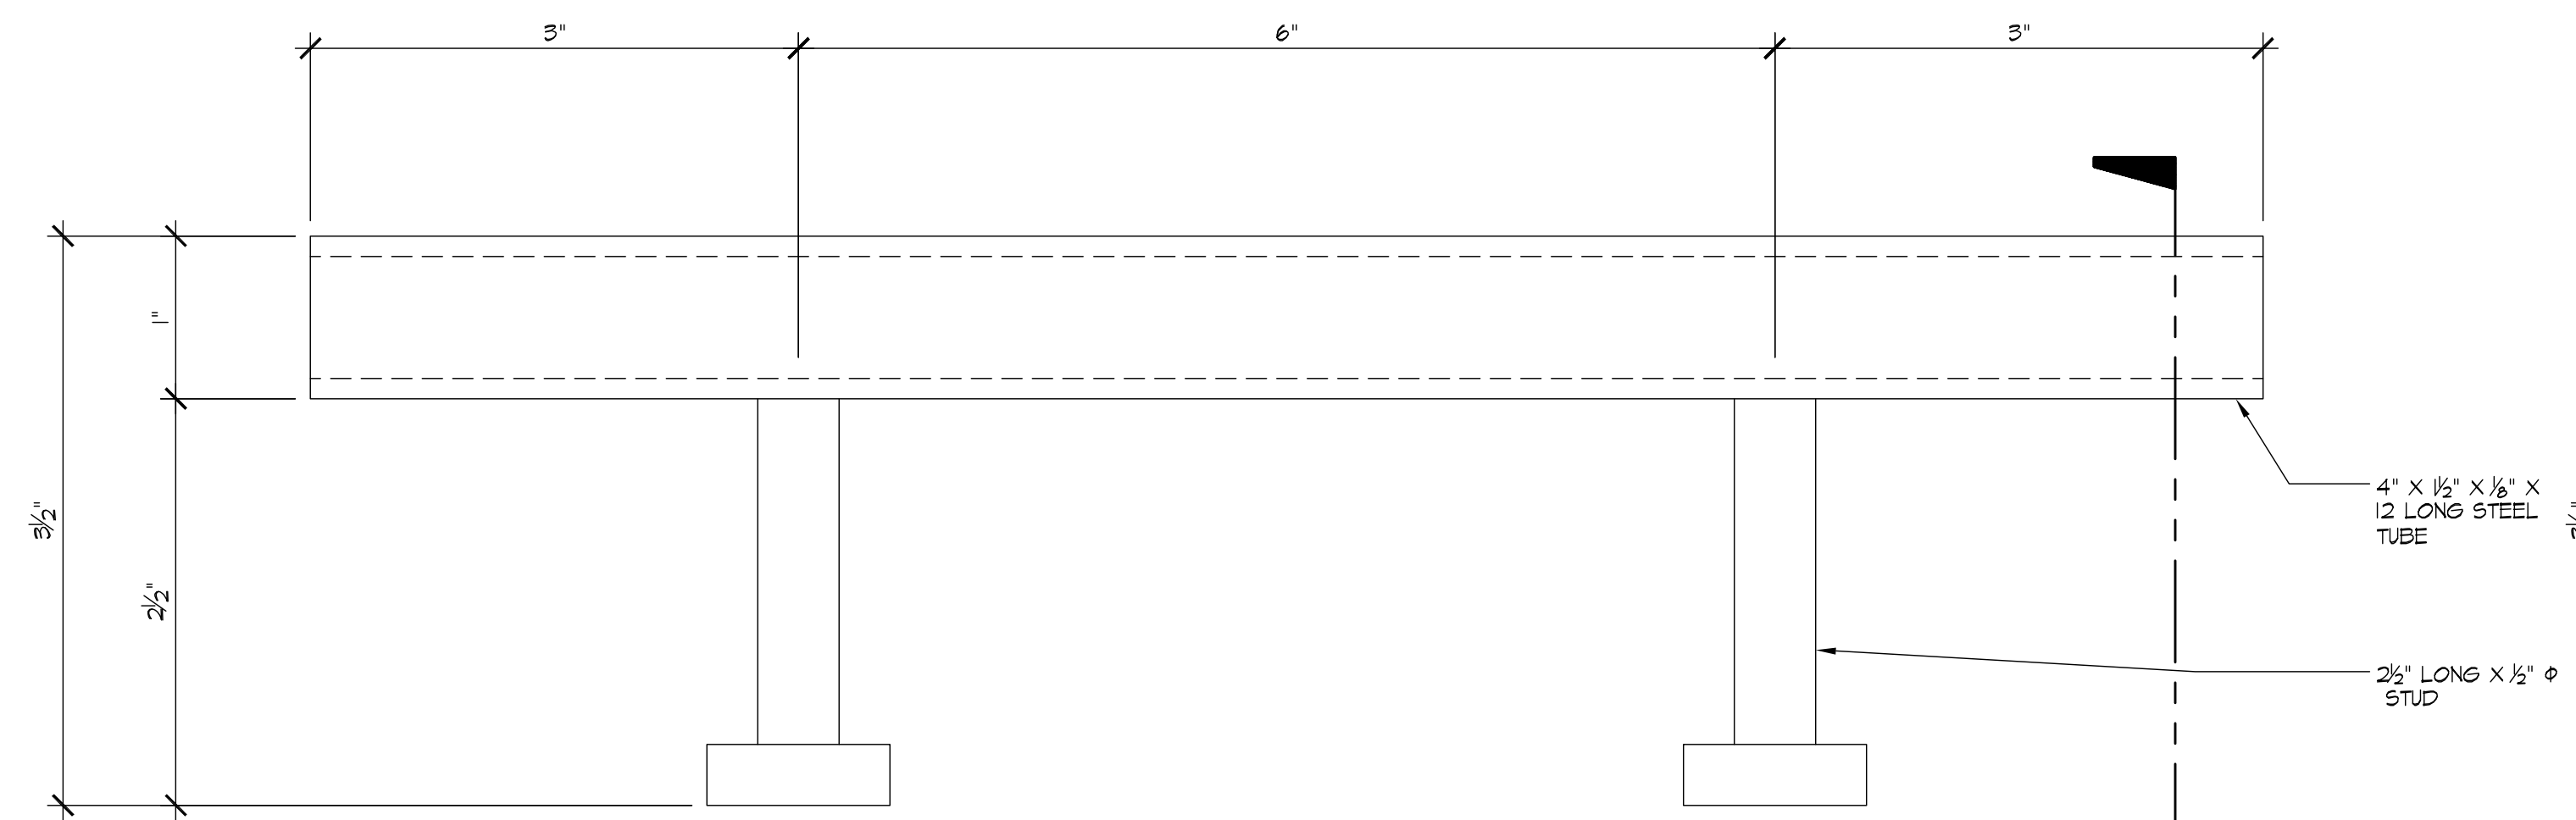

2 EMBED ANCHOR
43 ARCH'L:

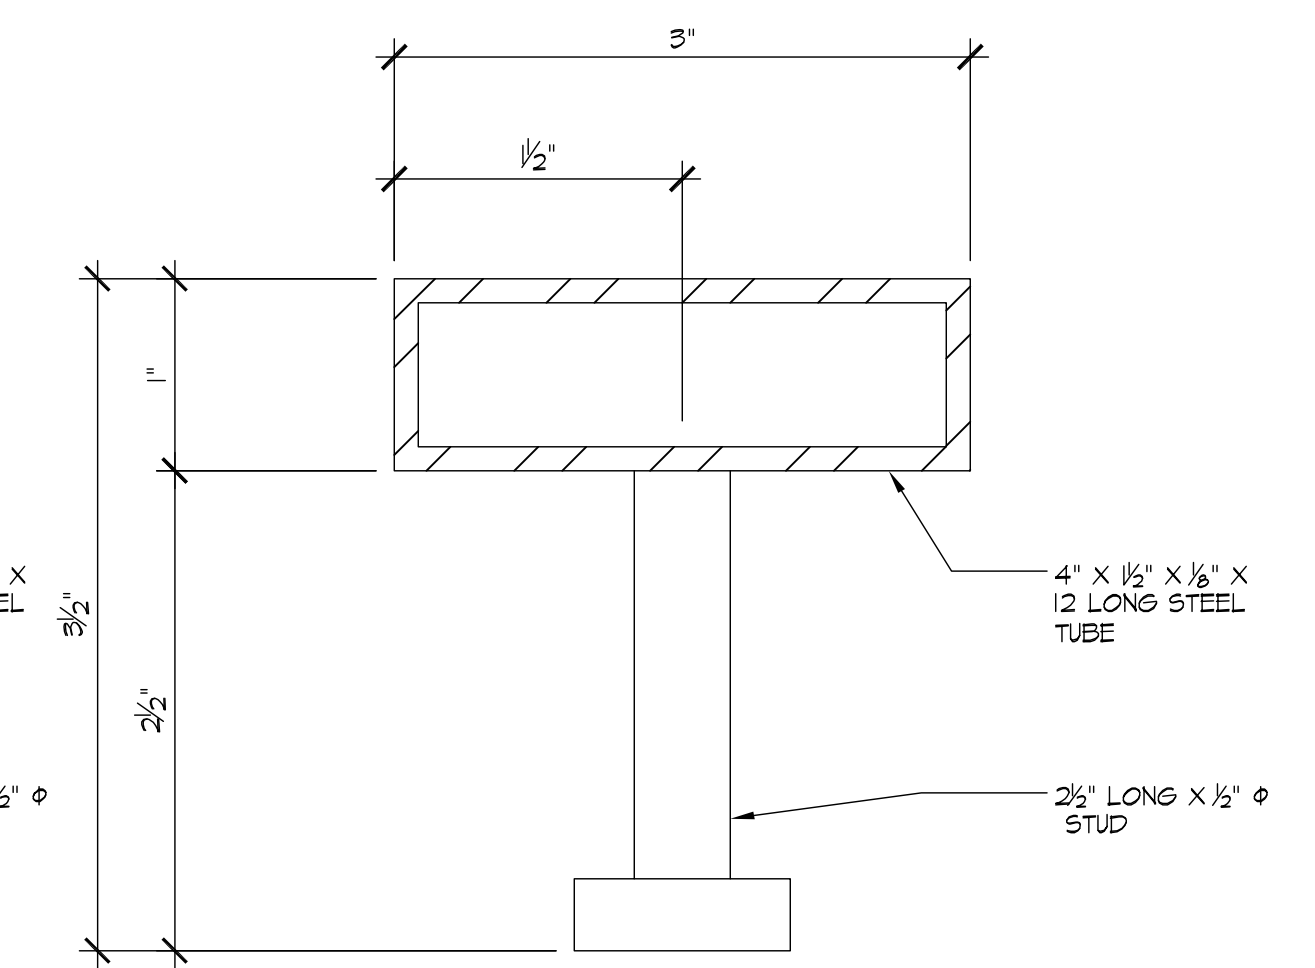


3 EMBED ANCHOR
43 ARCH'L:

REVISIONS	BY
△ 4-23-07	BMR
△ 6-11-07	BMR
△ 12-17-07	CTB
△ 3/6/08	CTB
△	

BMR
DRAFTING SERVICE
SINCE 1988
23846 SUNNYMEAD BLVD.
SUITE #9
MORENO VALLEY, CA 92553
B: (951) 243-7814
F: (951) 243-7873

GLASS FACTORY
26383 BASE LINE
HIGHLAND, CA 92346
AS-BUILT DRAWINGS


JOB NAME:	AGUA CALIENTE HOTEL ADDITION
ARCHITECT:	VOA
SHEET DESCRIPTION:	DETAILS
DATE:	1/3/07
SCALE:	FULL
DRAWN:	CTB
JOB NO:	100-06
SHEET NO:	43

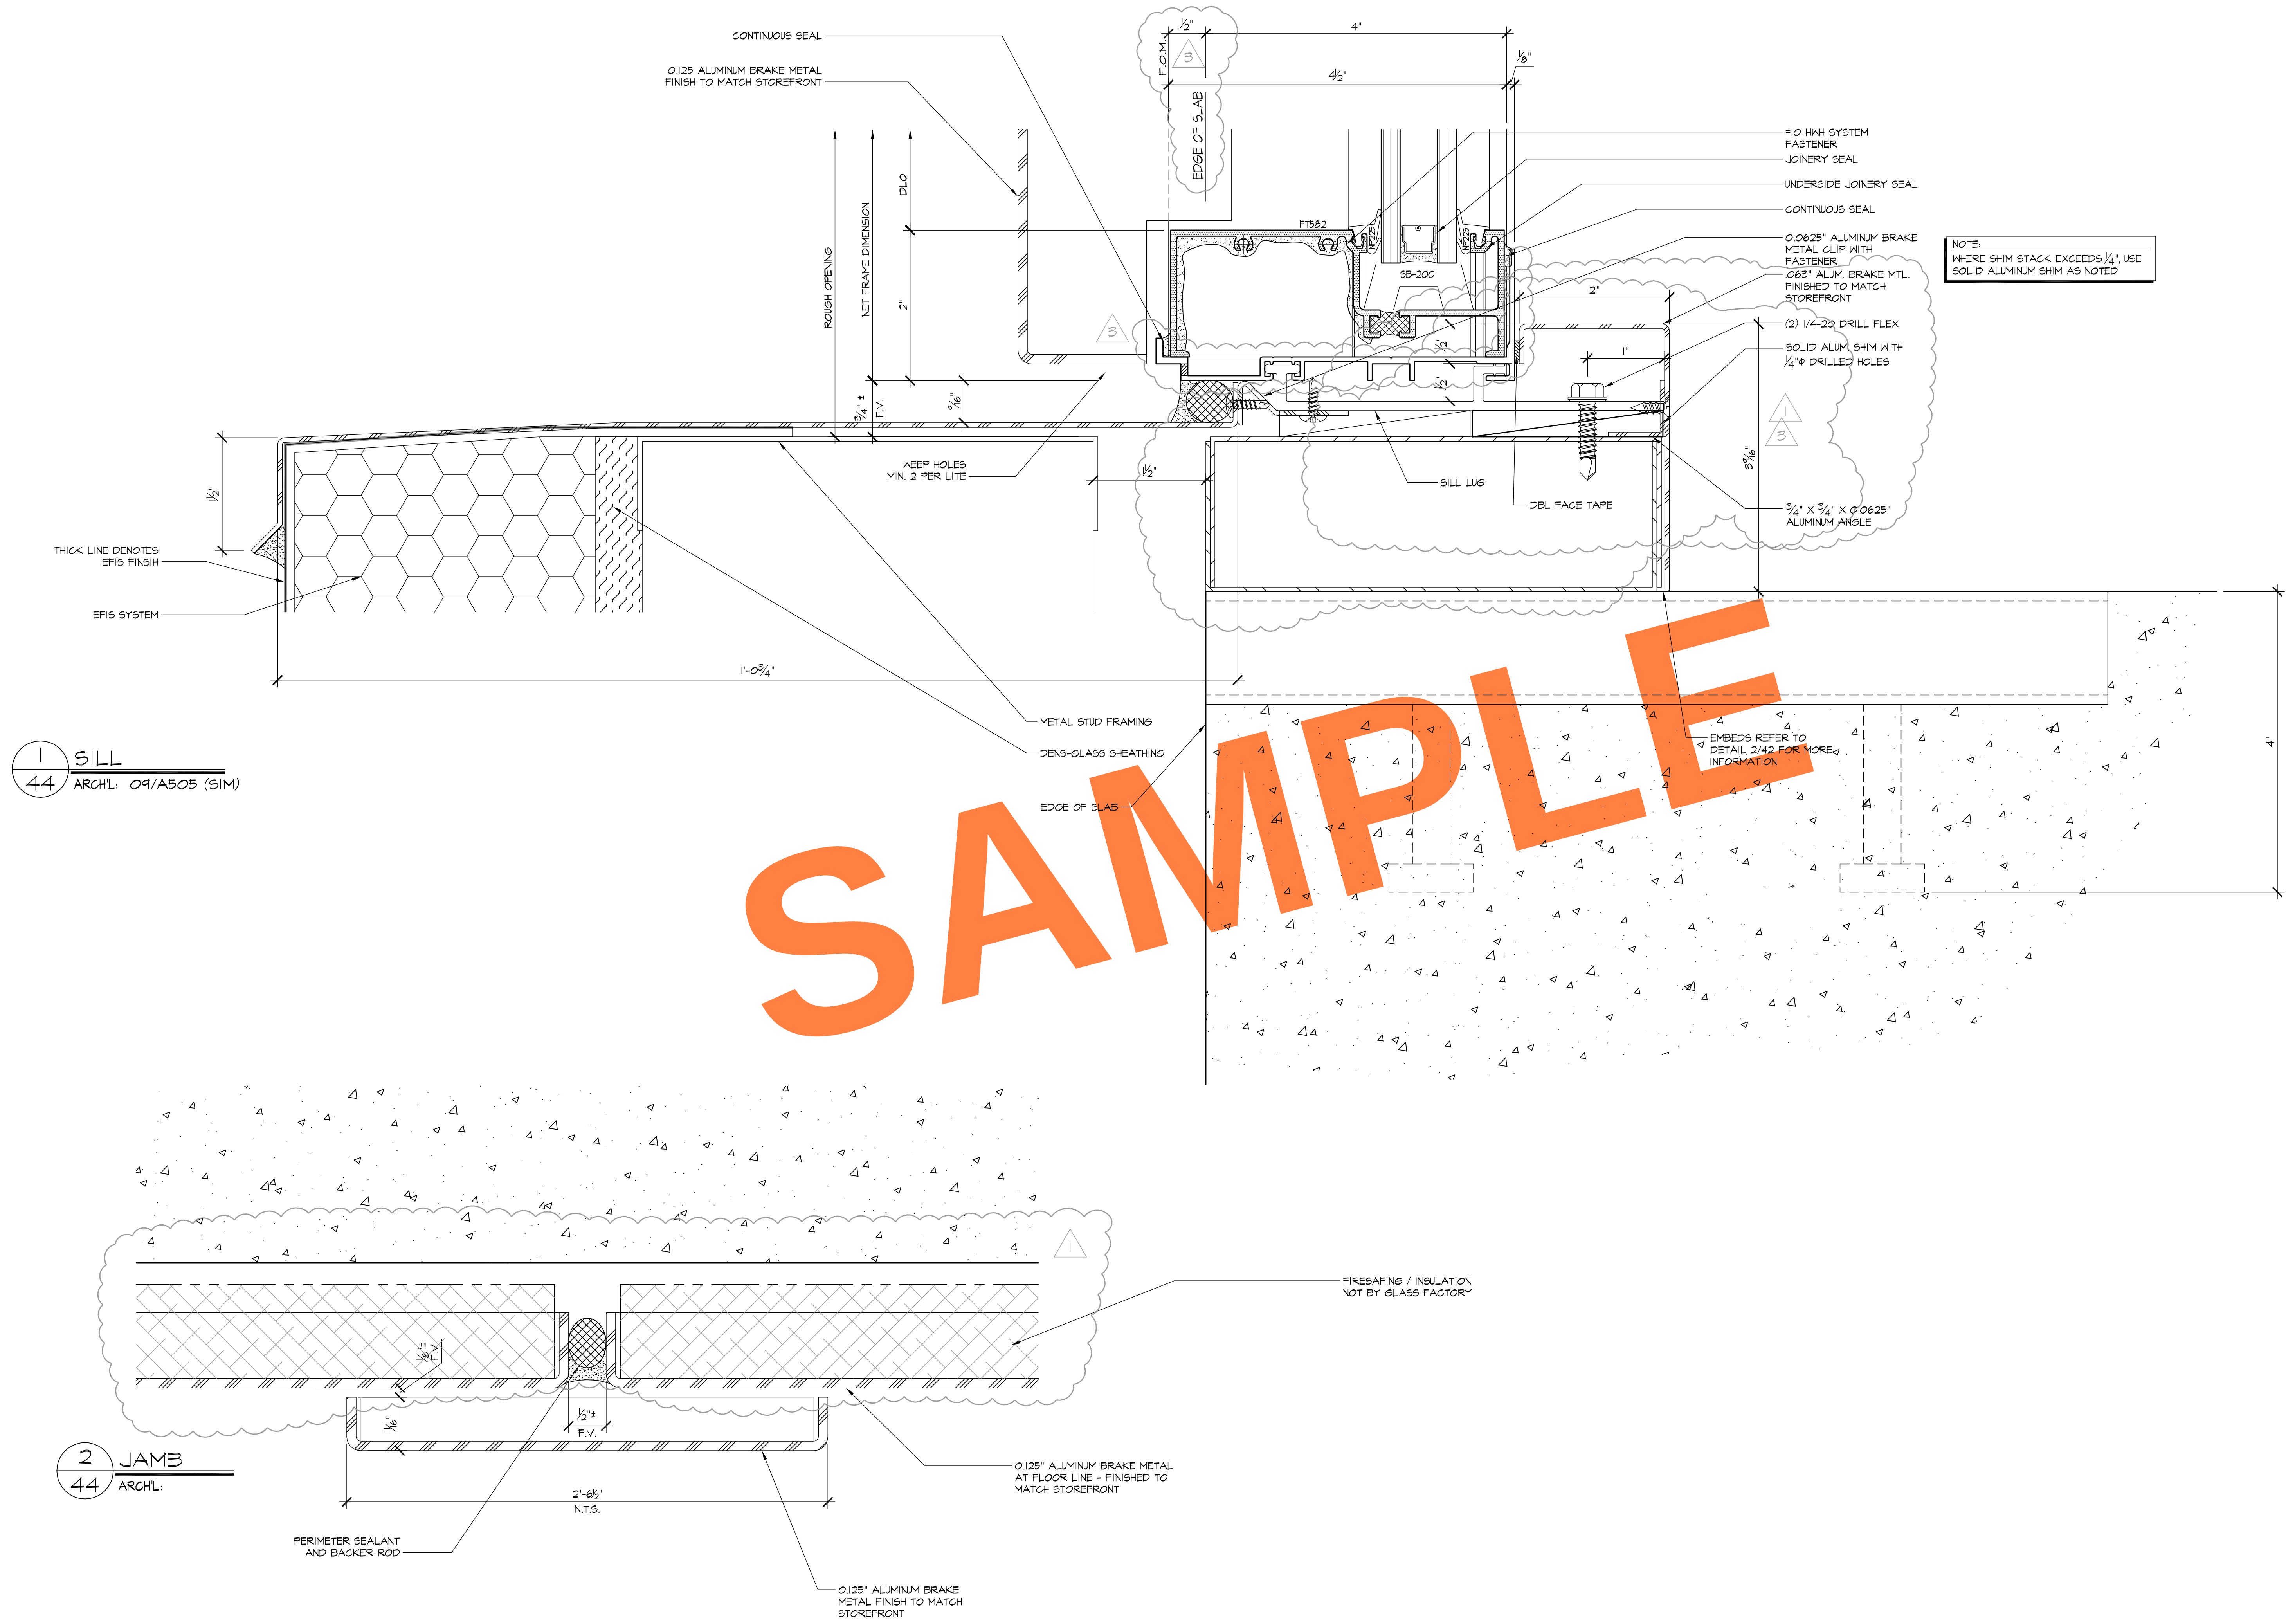

1 SILL
44 ARCH'L: 09/A305 (SIM)

2 JAMB
44 ARCH'L:

REVISIONS		BY
△	4-23-07	BMR
△	6-11-07	BMR
△	12-17-07	CTB
△	3/6/08	CTB
△		
BMR DRAFTING SERVICE SINCE 1988 23846 SUNNYMEAD BLVD. SUITE #9 MORENO VALLEY, CA 92553 P: (951) 243-7814 F: (951) 243-7873		
GLASS FACTORY 26383 BASE LINE HIGHLAND, CA 92346		
AS-BUILT DRAWINGS		
JOB NAME:	AGUA CALIENTE HOTEL ADDITION	
ARCHITECT:	VOA	
SHEET DESCRIPTION:	DETAILS	
DATE:	1/3/07	
SCALE:	FULL	
DRAWN:	CTB	
JOB NO:	100-06	
SHEET NO:	44	

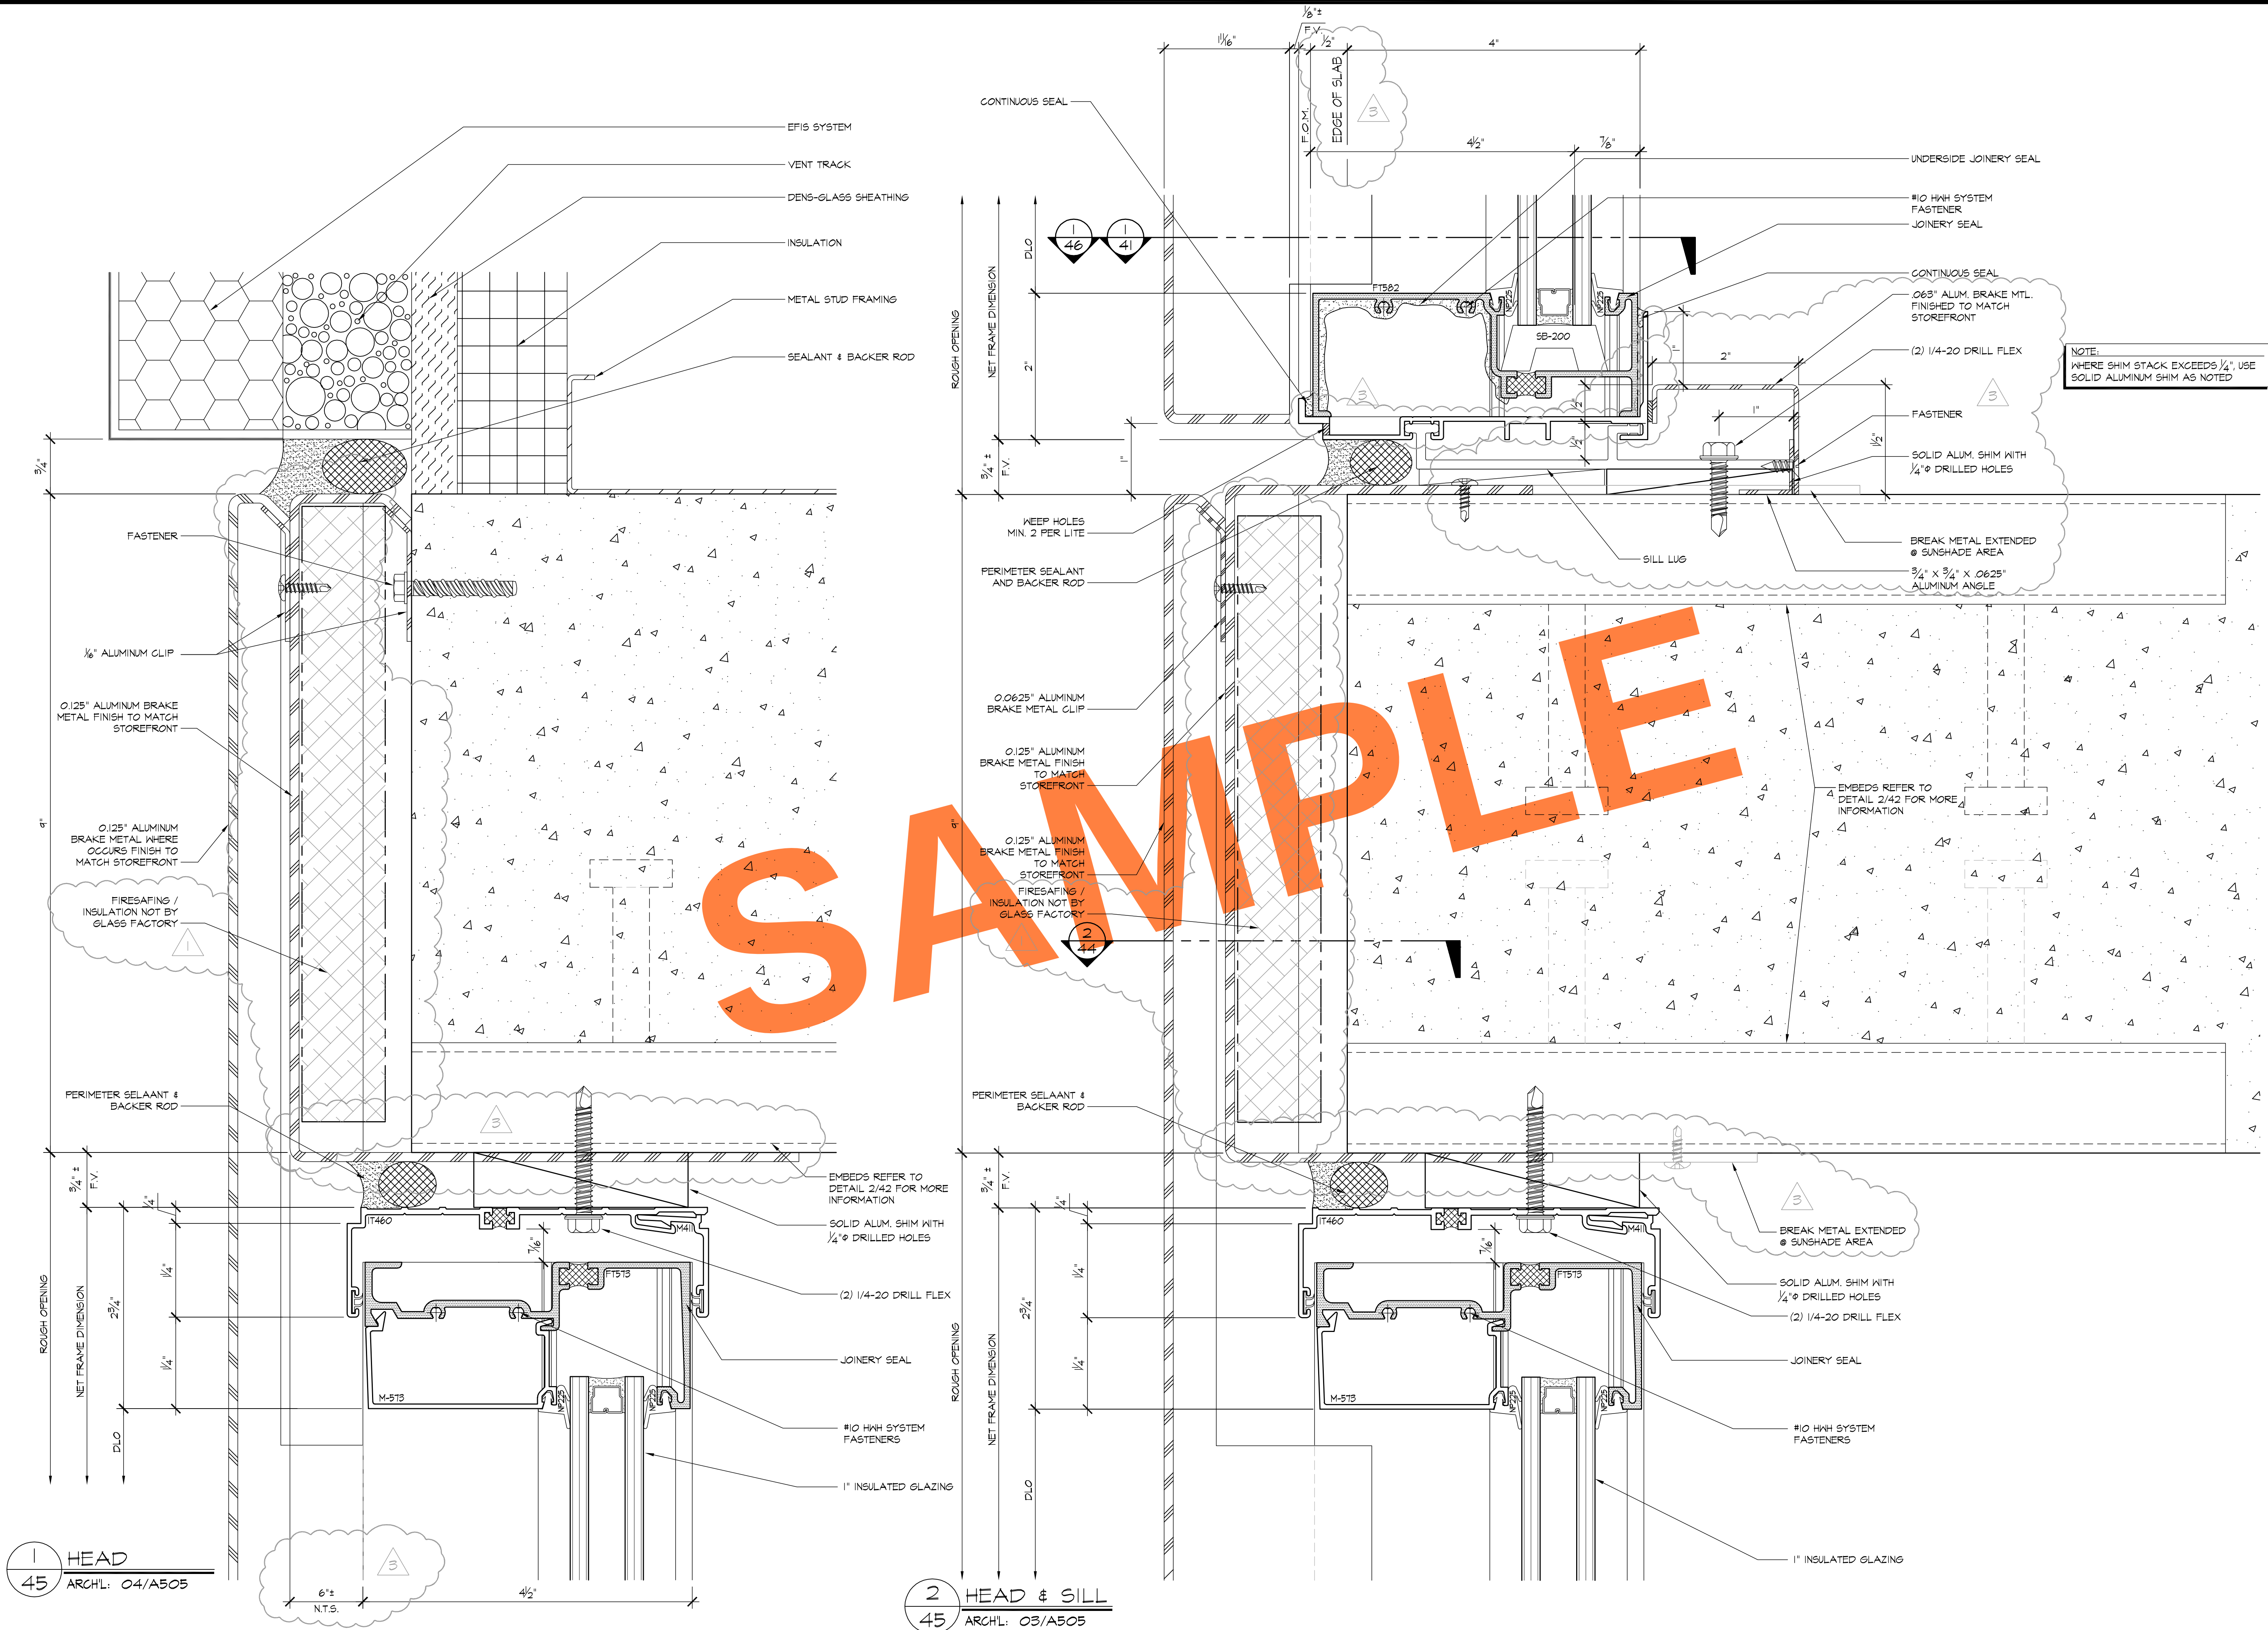


REVISIONS		BY
△	4-23-07	BMR
△	6-11-07	BMR
△	12-17-07	CTB
△	3/6/08	CTB
△		

BMR DRAFTING SERVICE SINCE 1988 23846 SUNNYMEAD BLVD. SUITE #9 MORENO VALLEY, CA 92553 P: (951) 243-7814 F: (951) 243-7873
--


GLASS FACTORY 26383 BASE LINE HIGHLAND, CA 92346
AS-BUILT DRAWINGS

JOB NAME: AGUA CALIENTE HOTEL ADDITION	ARCHITECT: VOA
DATE: 1/3/07	SHEET DESCRIPTION: DETAILS
SCALE: FULL	
DRAWN: CTB	
JOB NO: 100-06	
SHEET NO:	


45

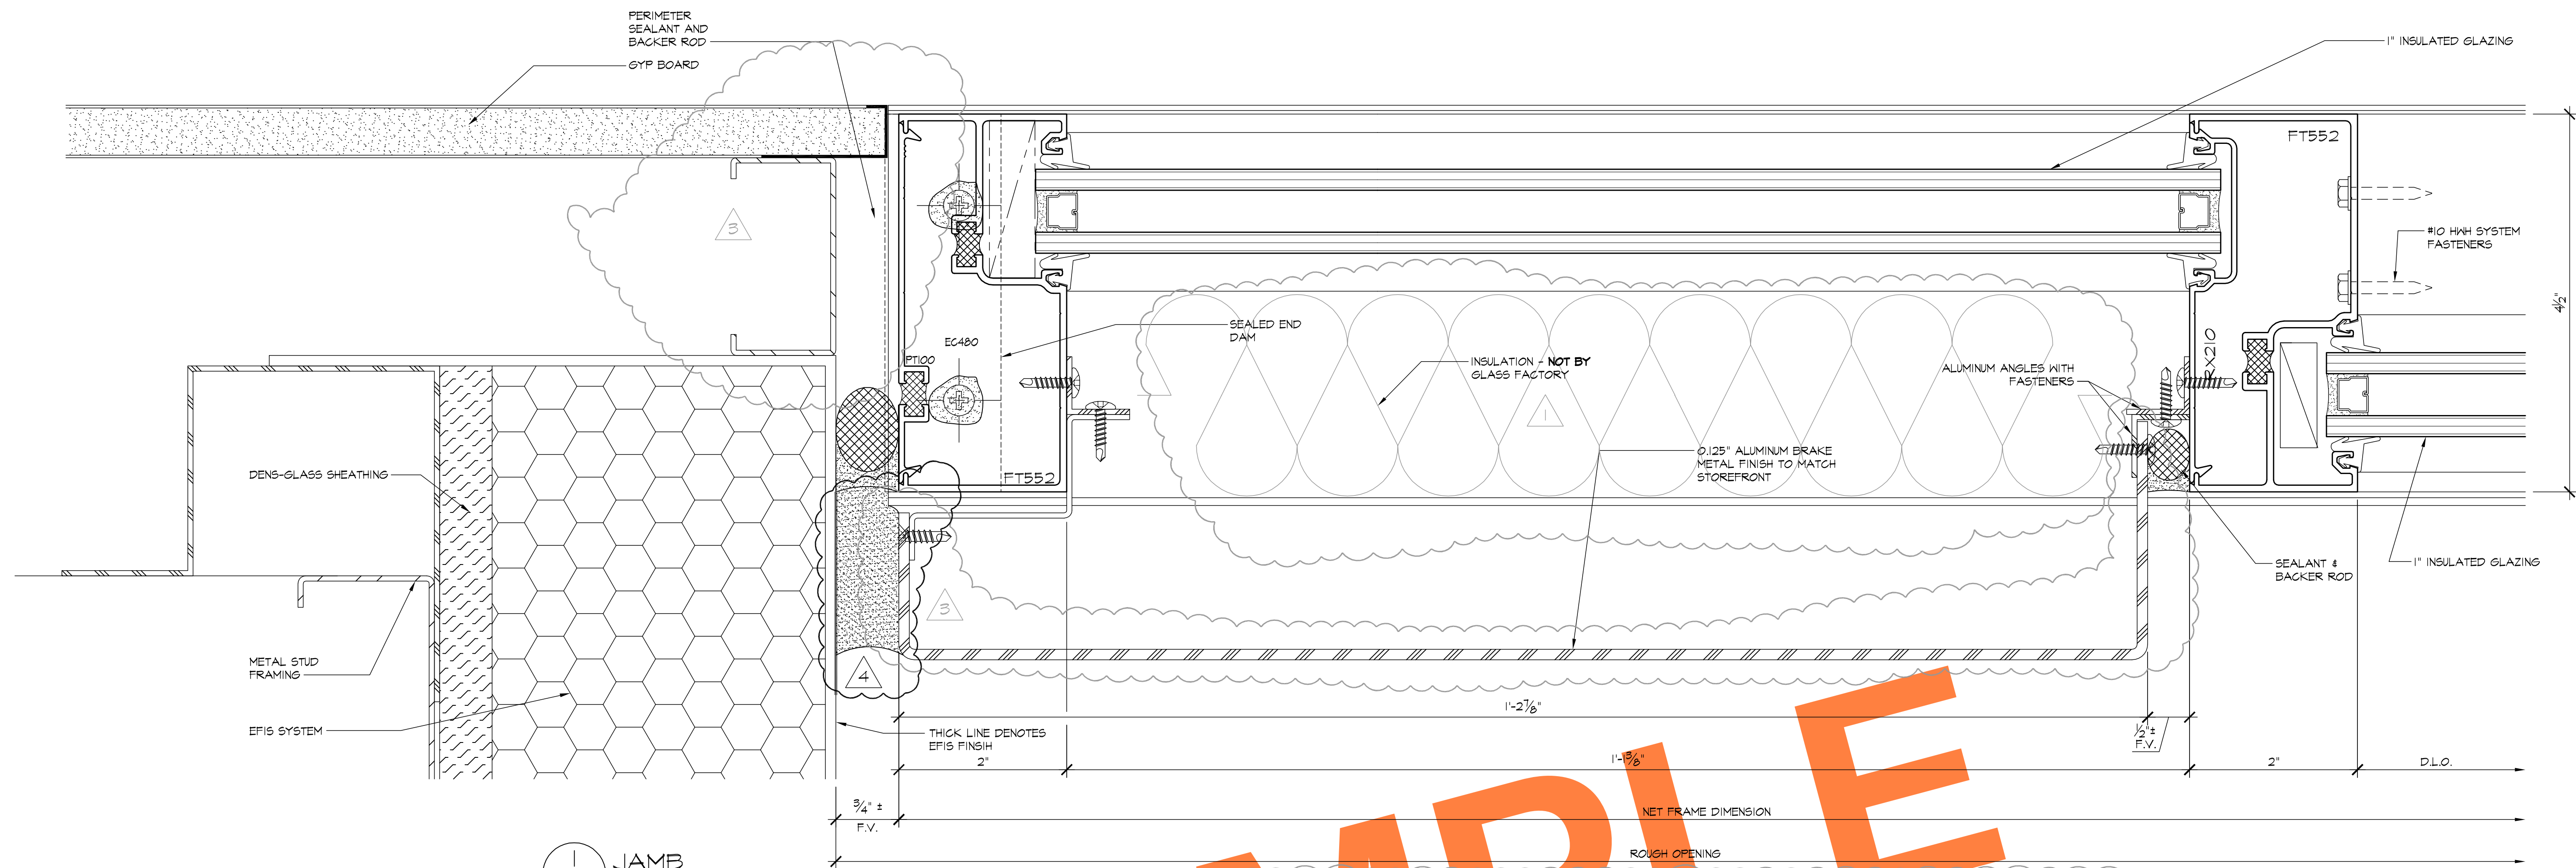

1 JAMB
46 ARCH'L:

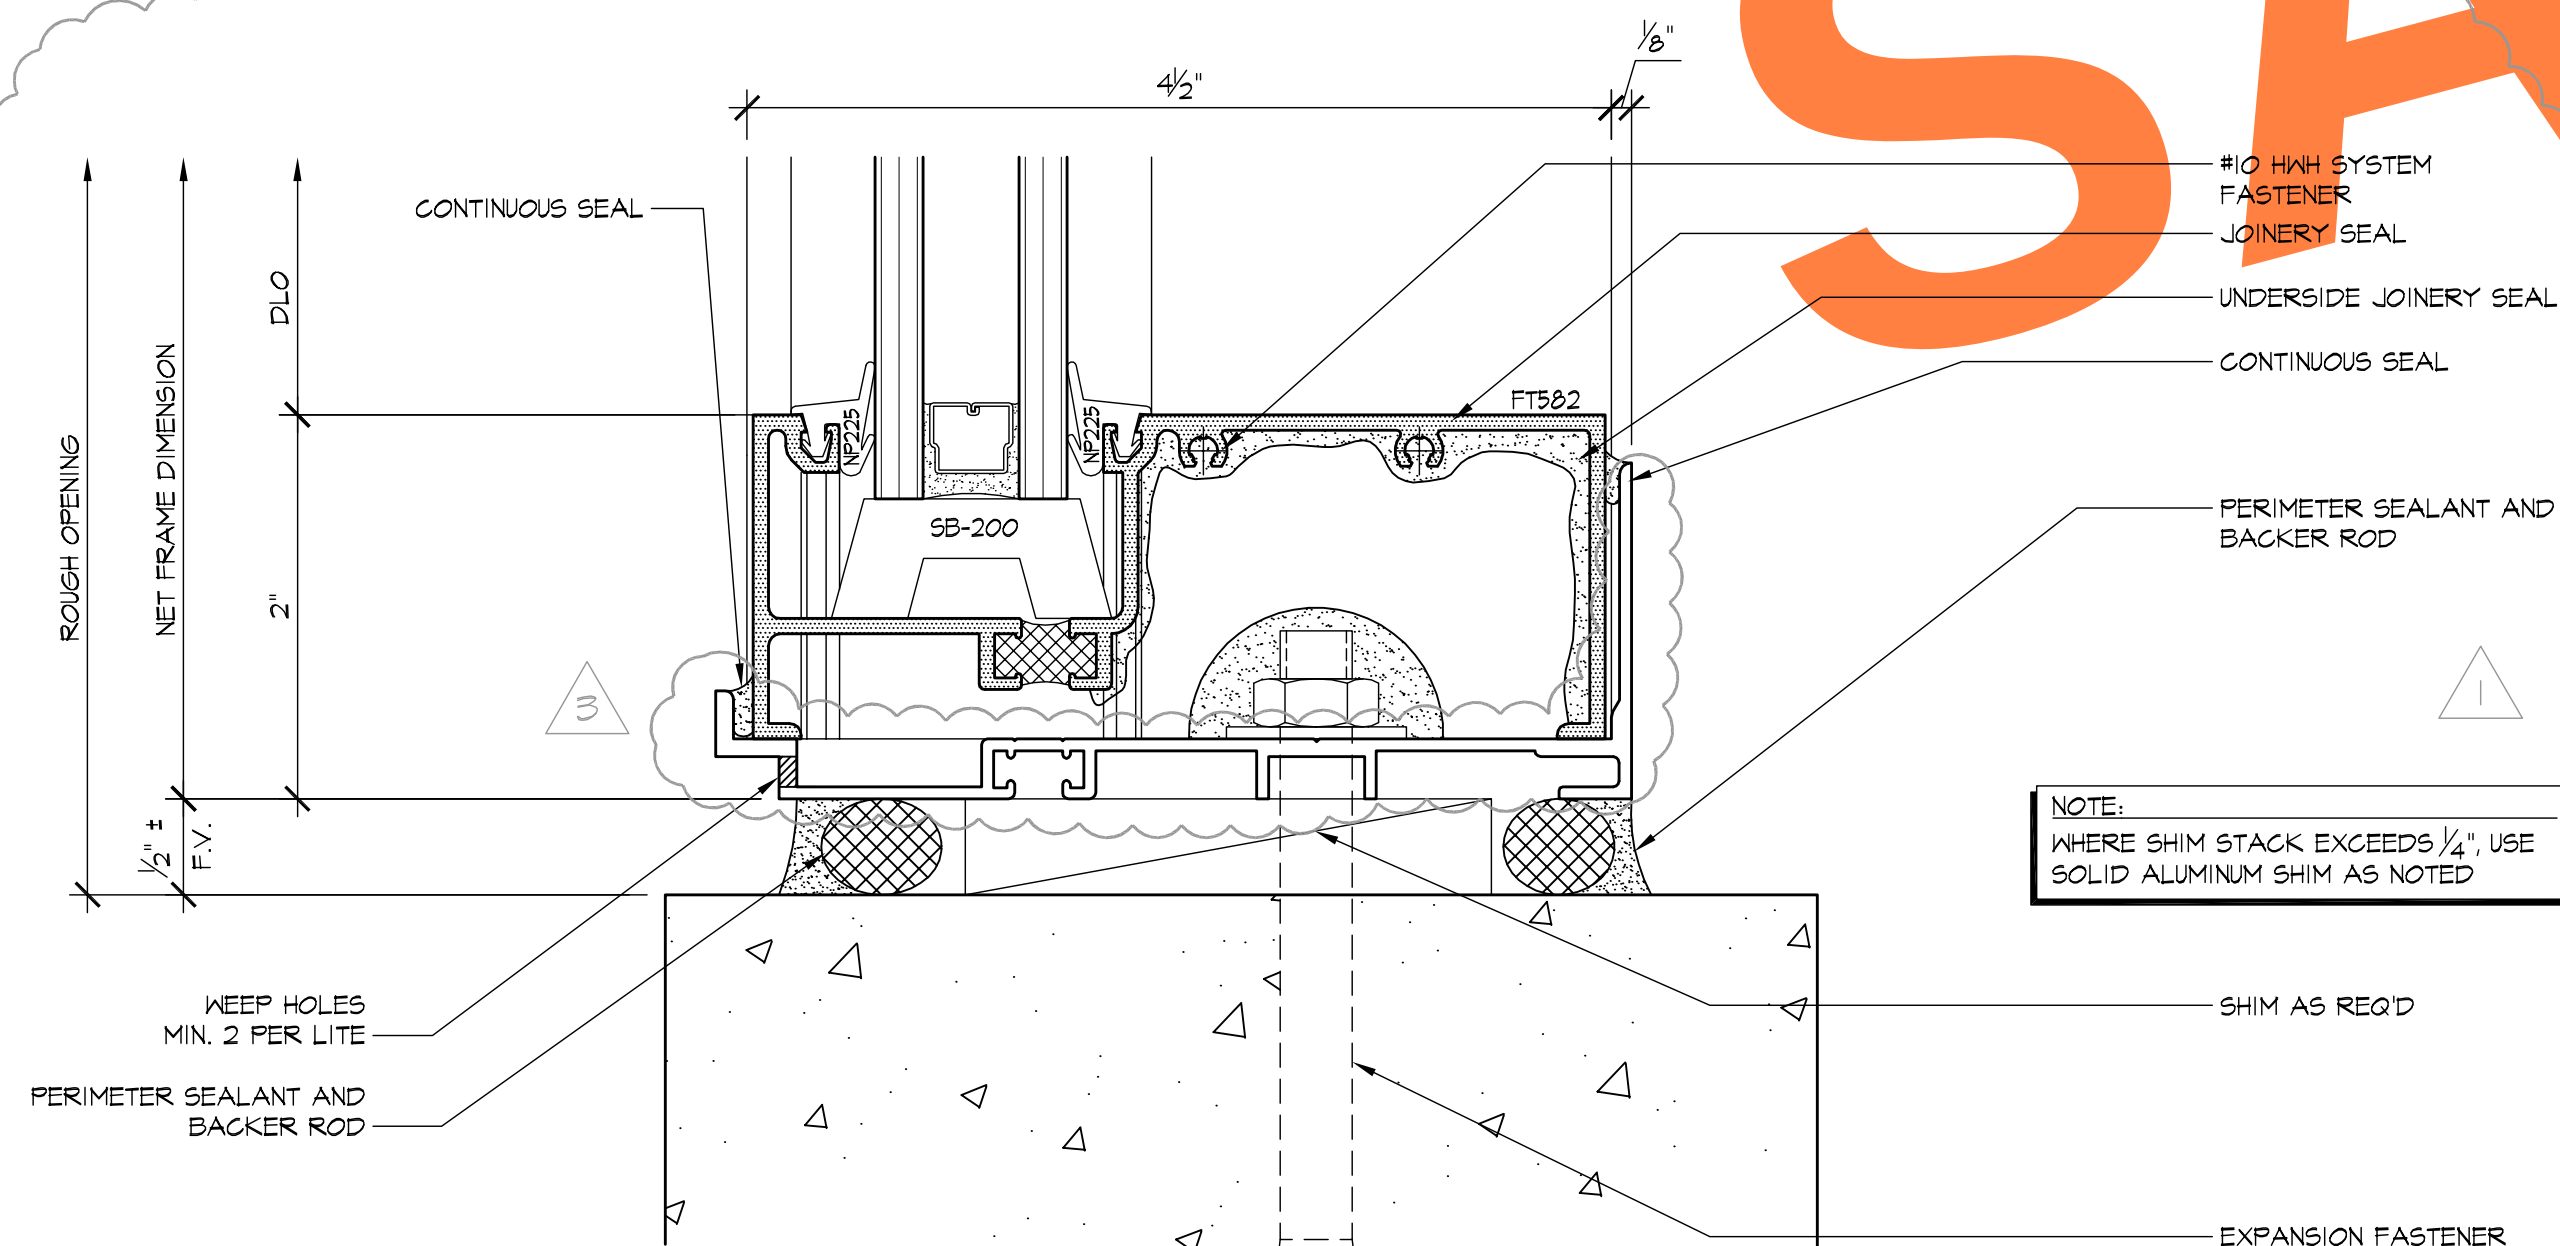

2 SILL
46 ARCH'L:

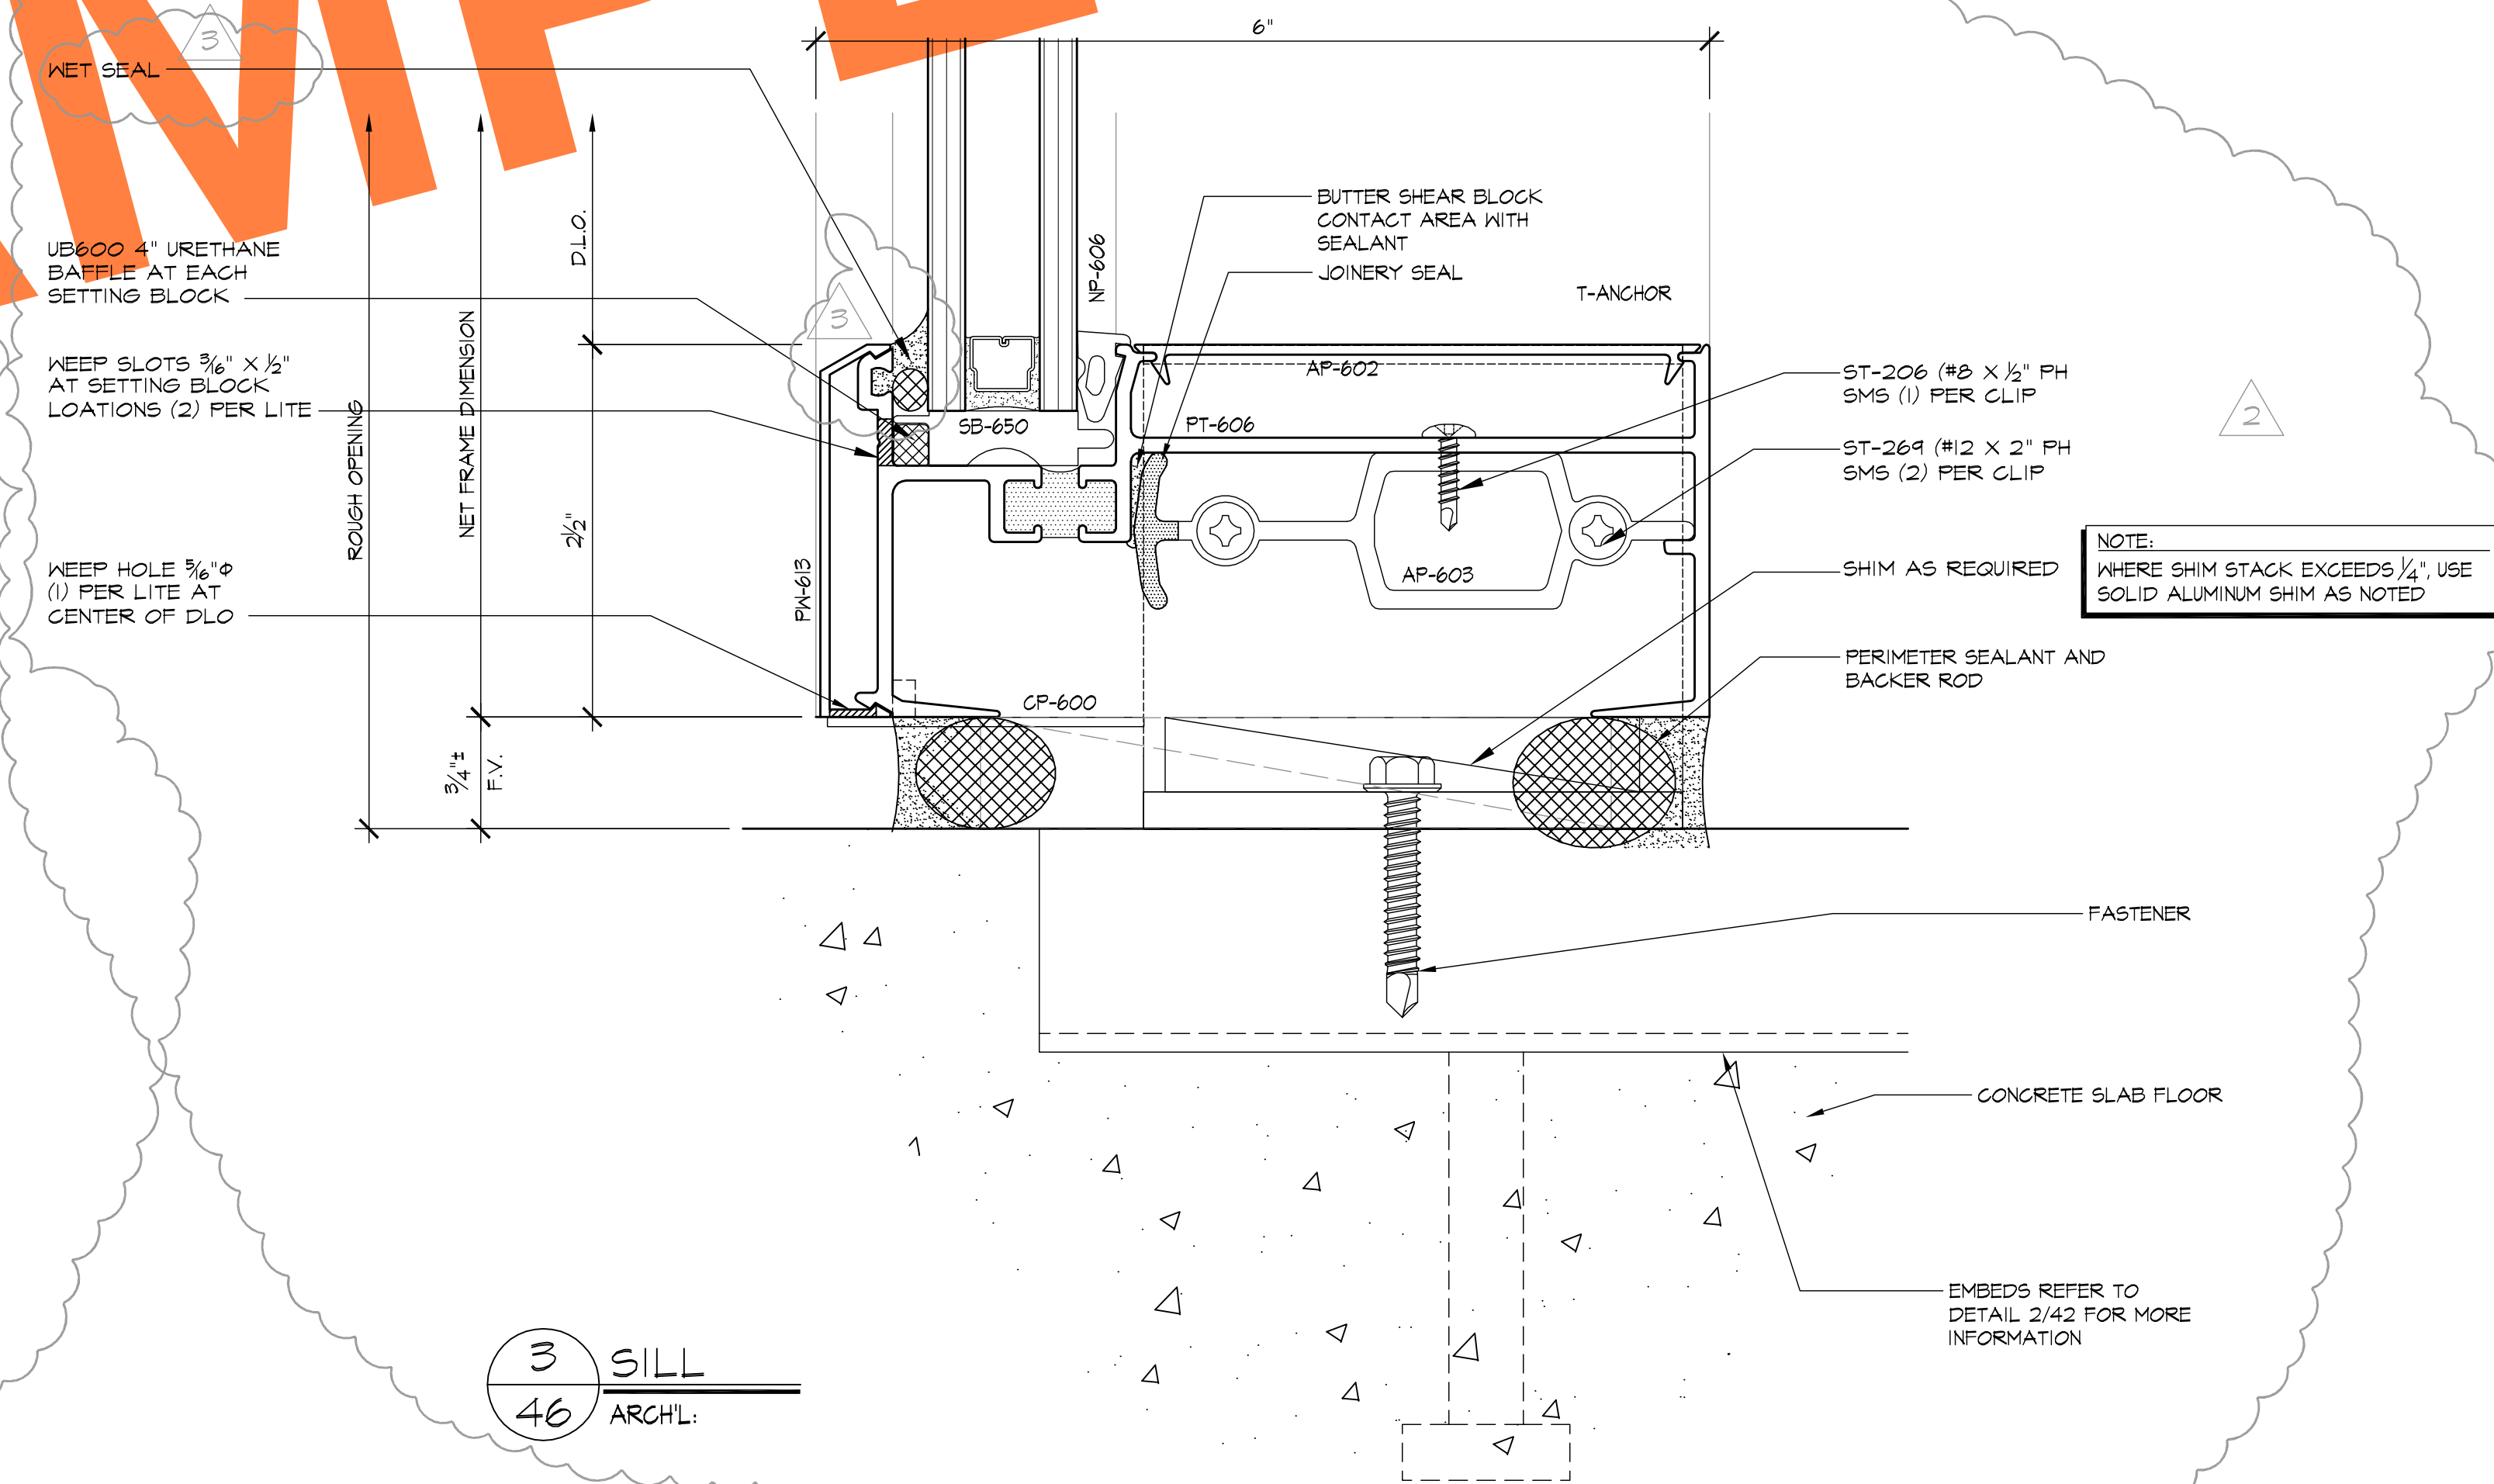

3 SILL
46 ARCH'L:


REVISIONS	BY
△ 4-23-07	BMR
△ 6-11-07	BMR
△ 12-17-07	CTB
△ 3/6/08	CTB
△	

BMR
DRAFTING SERVICE
SINCE 1988
23846 SUNNYMEAD BLVD.
SUITE #9
MORENO VALLEY, CA 92553
B: (951) 243-7814
F: (951) 243-7873


GLASS FACTORY
26383 BASE LINE
HIGHLAND, CA 92346

AS-BUILT DRAWINGS

JOB NAME:	AGUA CALIENTE HOTEL ADDITION
ARCHITECT:	VOA
SHEET DESCRIPTION:	DETAILS
DATE:	1/3/07
SCALE:	FULL
DRAWN:	CTB
JOB NO:	100-06
SHEET NO:	46

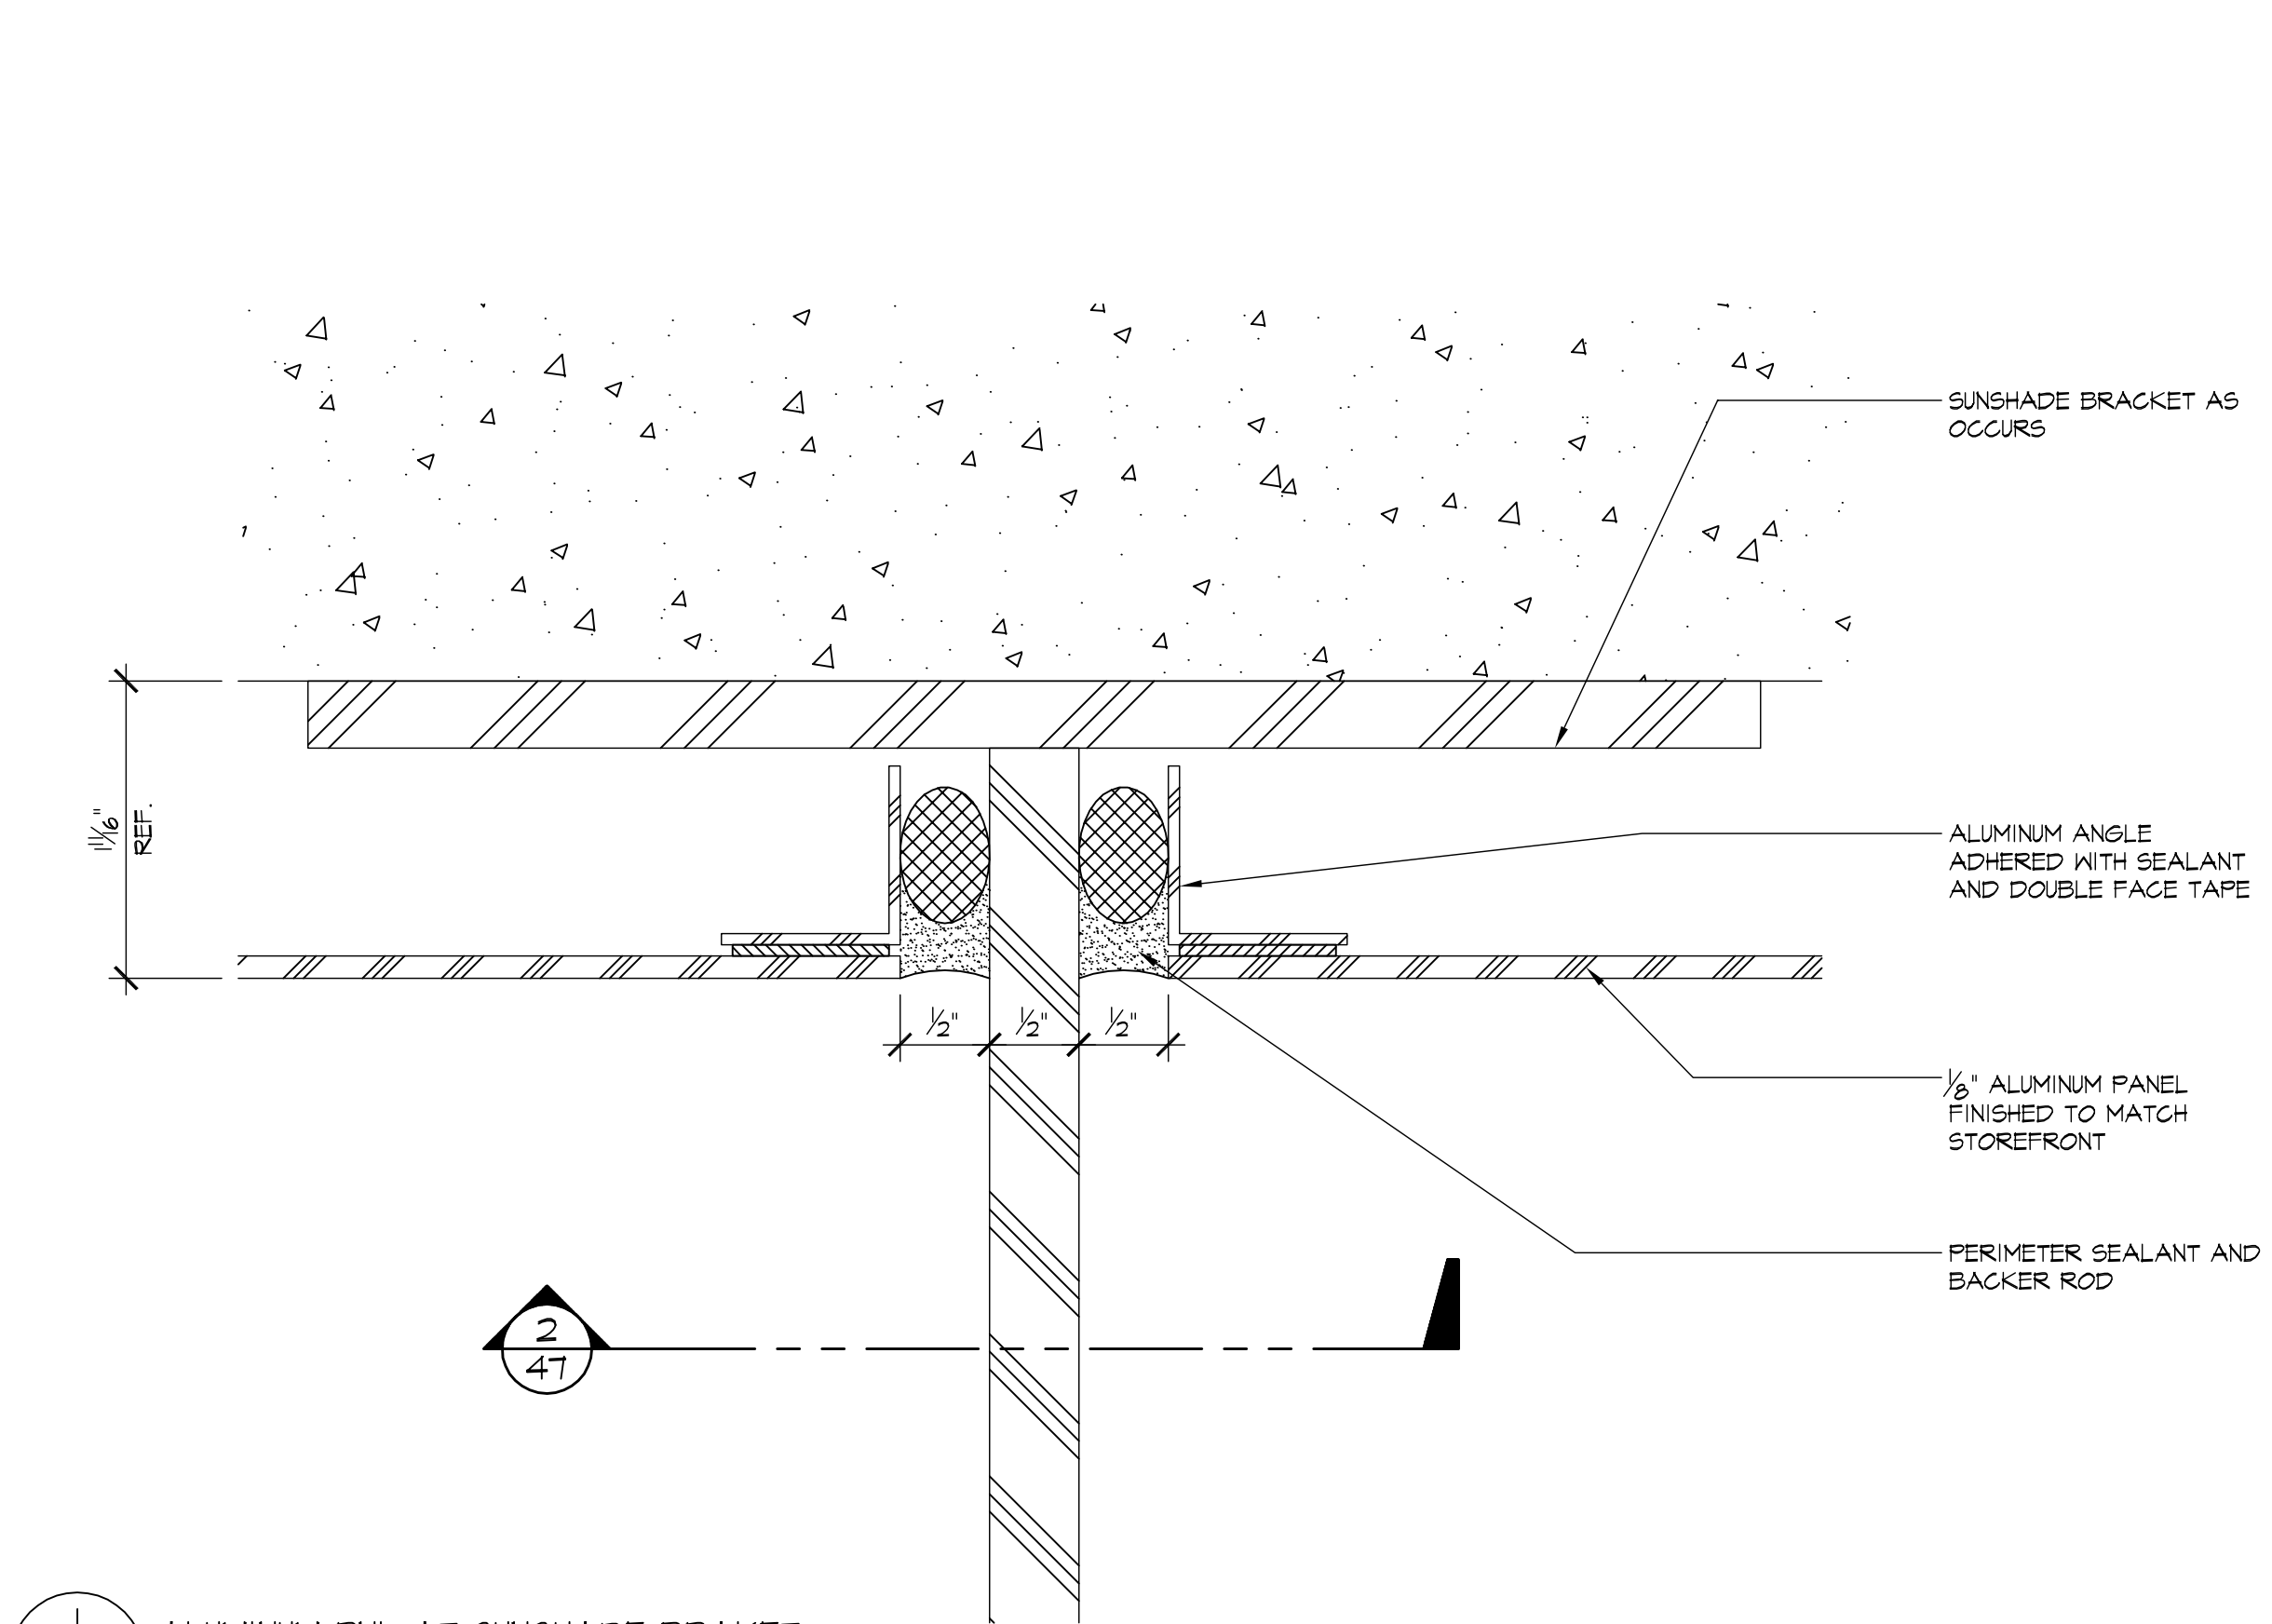

1
47 ALUMINUM PNL AT SUNSHADE BRACKET
ARCH'L:

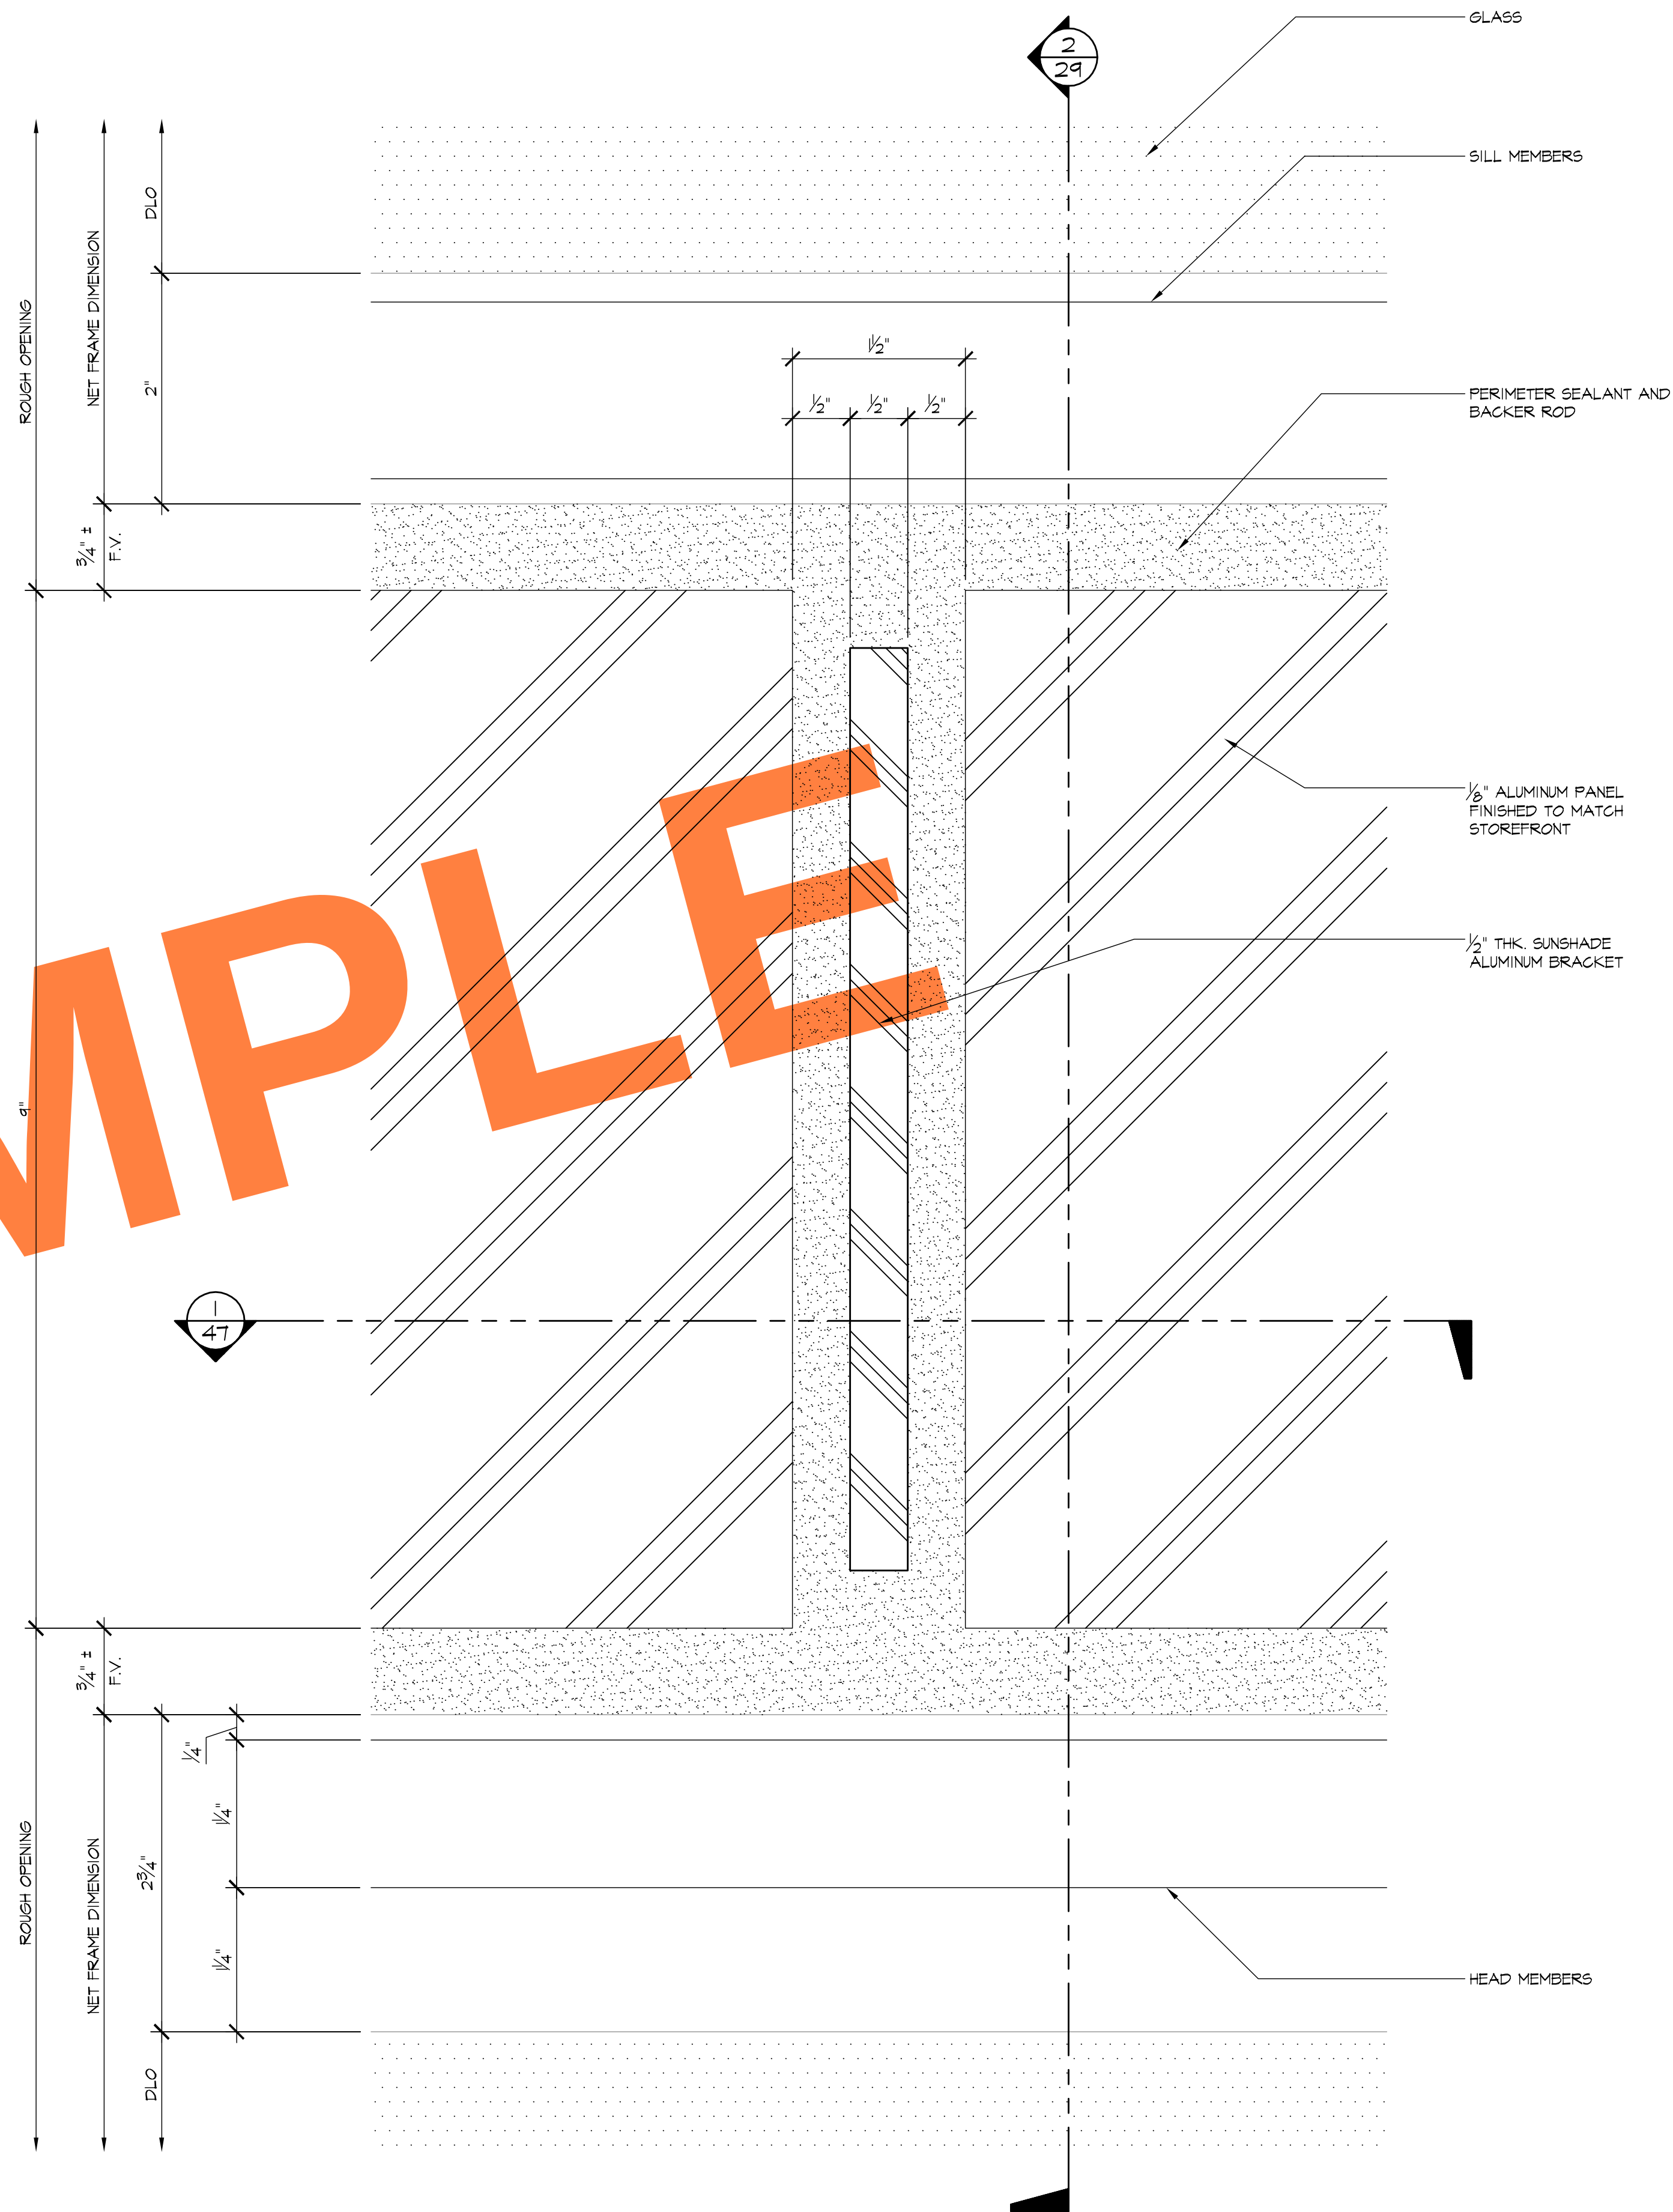

2
47 ALUMINUM PNL AT SUNSHADE BRACKET
ARCH'L:

REVISIONS	BY
△ 4-23-07	BMR
△ 6-11-07	BMR
△ 12-17-07	CTB
△ 3/6/08	CTB
△	






GLASS FACTORY
26383 BASE LINE
HIGHLAND, CA 92346

AS-BUILT DRAWINGS

JOB NAME:	AGUA CALIENTE HOTEL ADDITION
ARCHITECT:	VOA
SHEET DESCRIPTION:	DETAILS
DATE:	1/3/07
SCALE:	FULL
DRAWN:	CTB
JOB NO:	100-06
SHEET NO:	


47

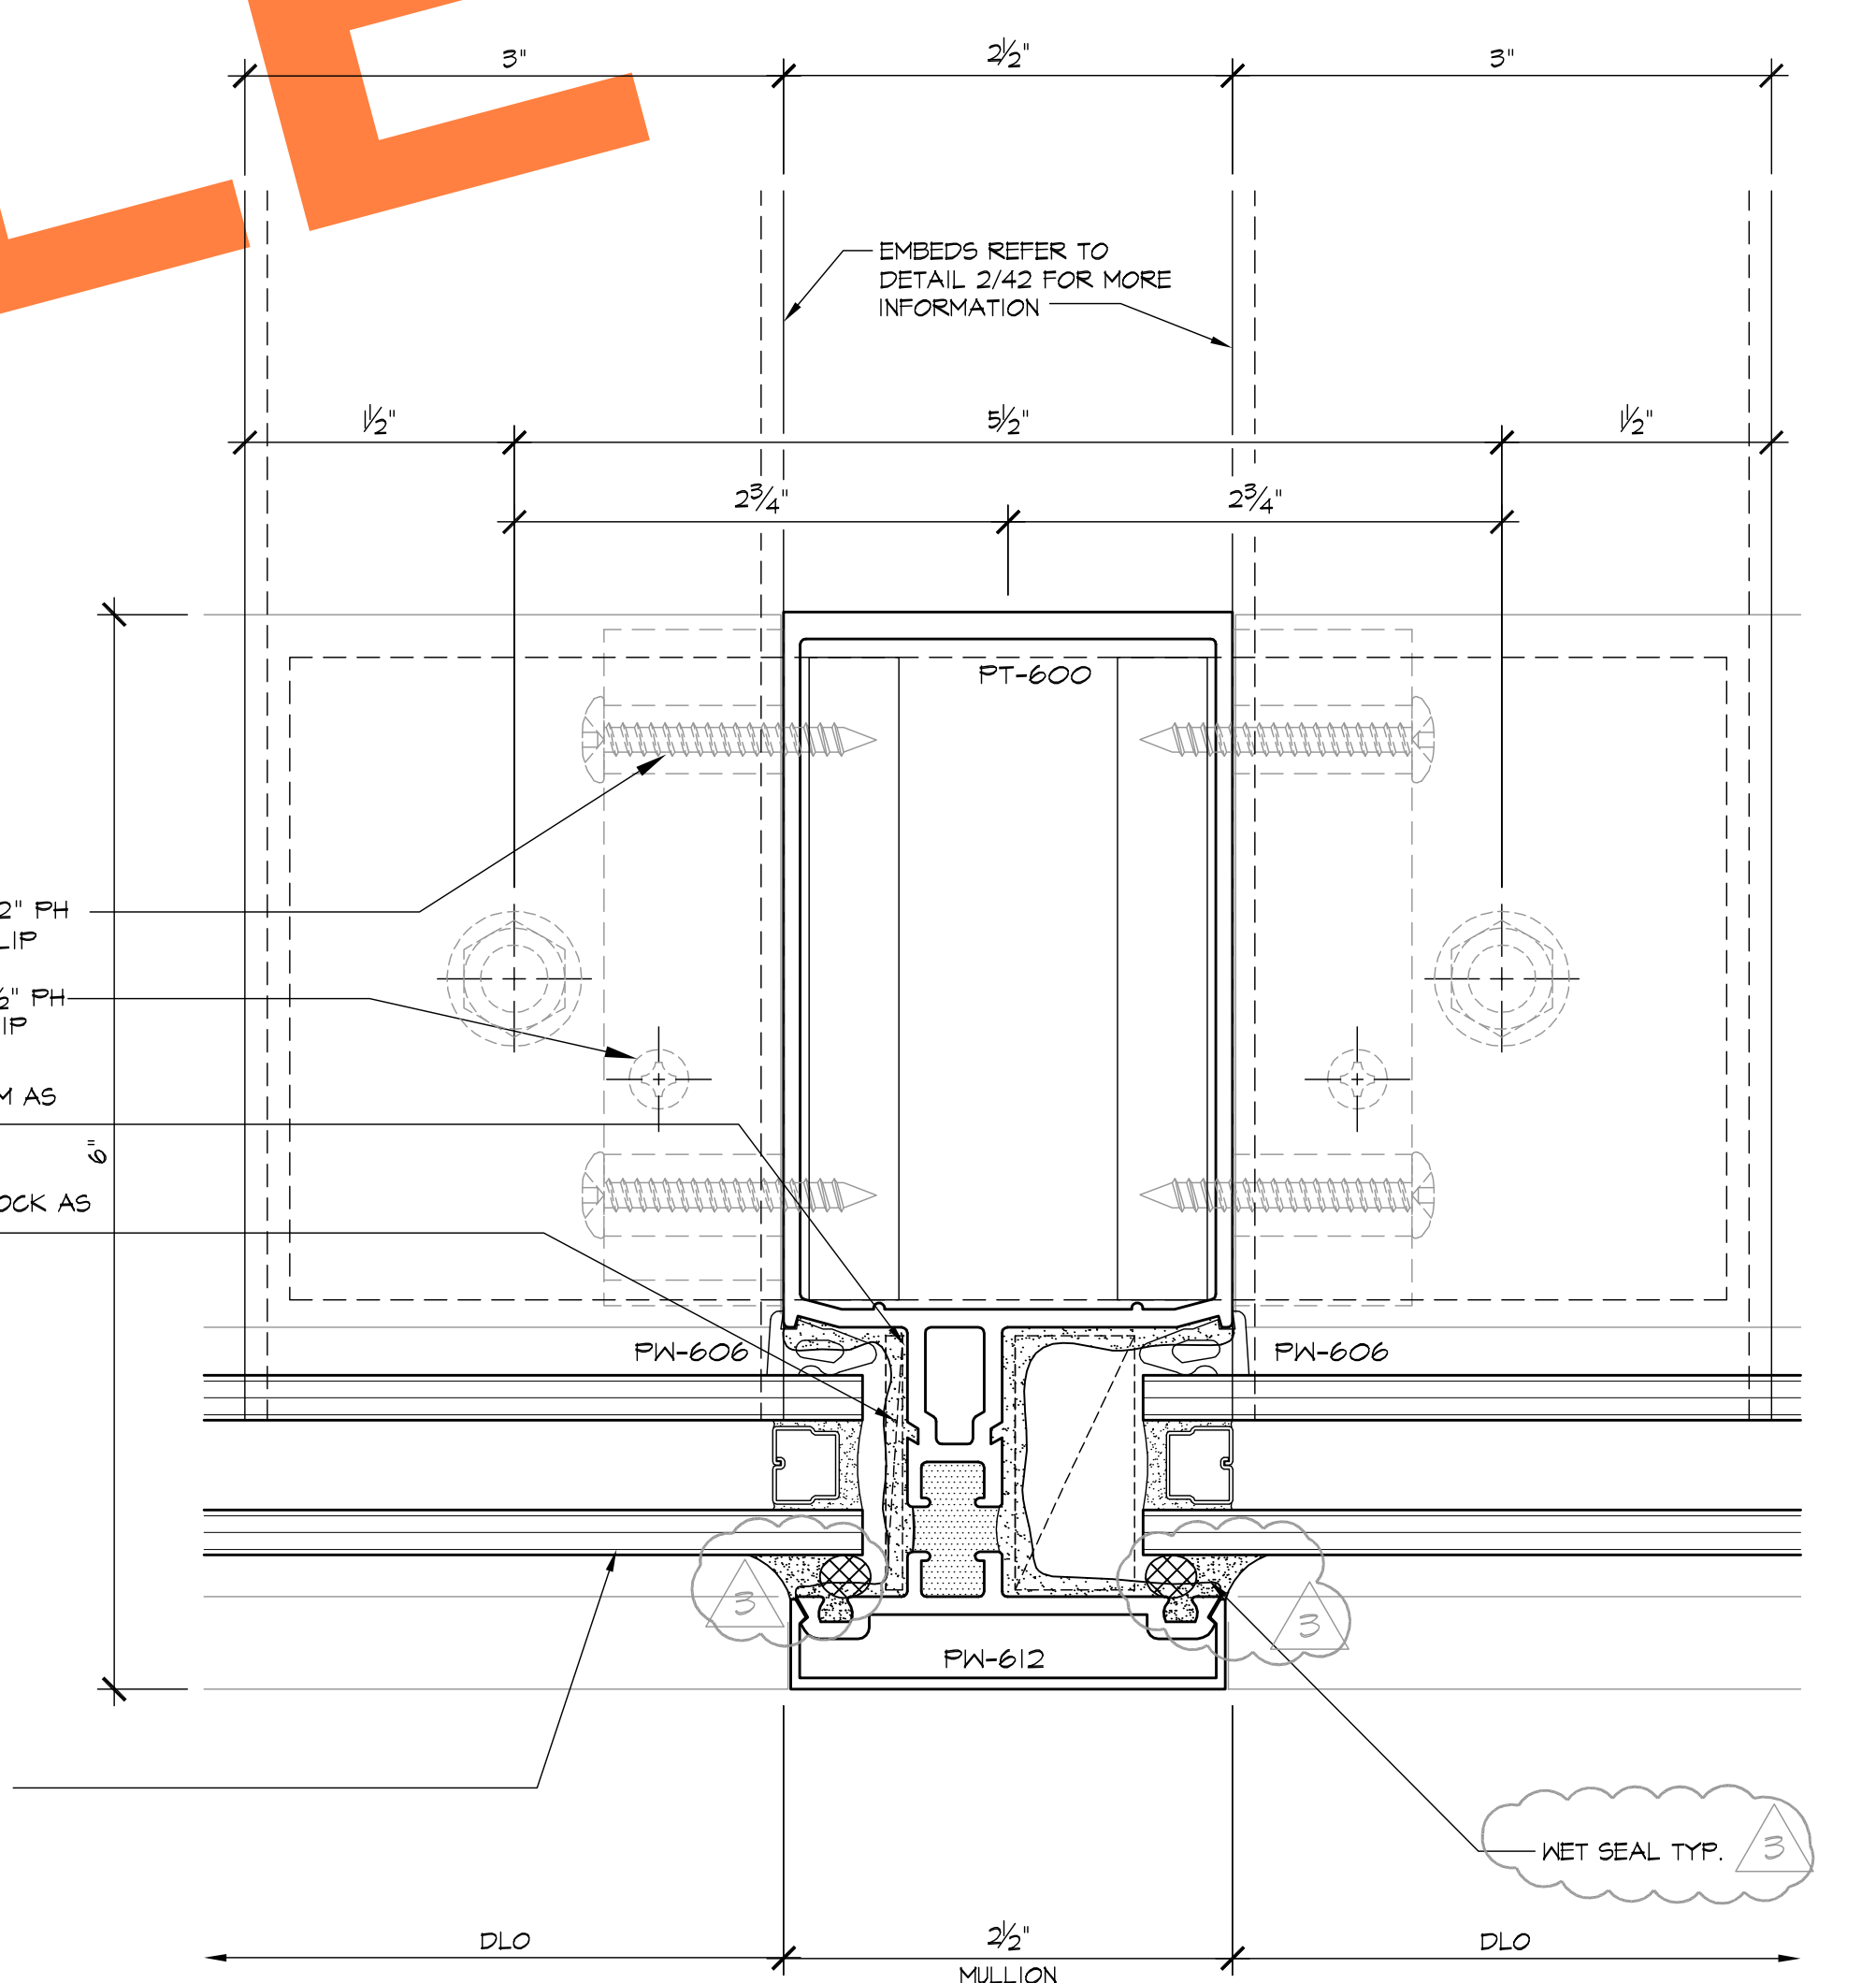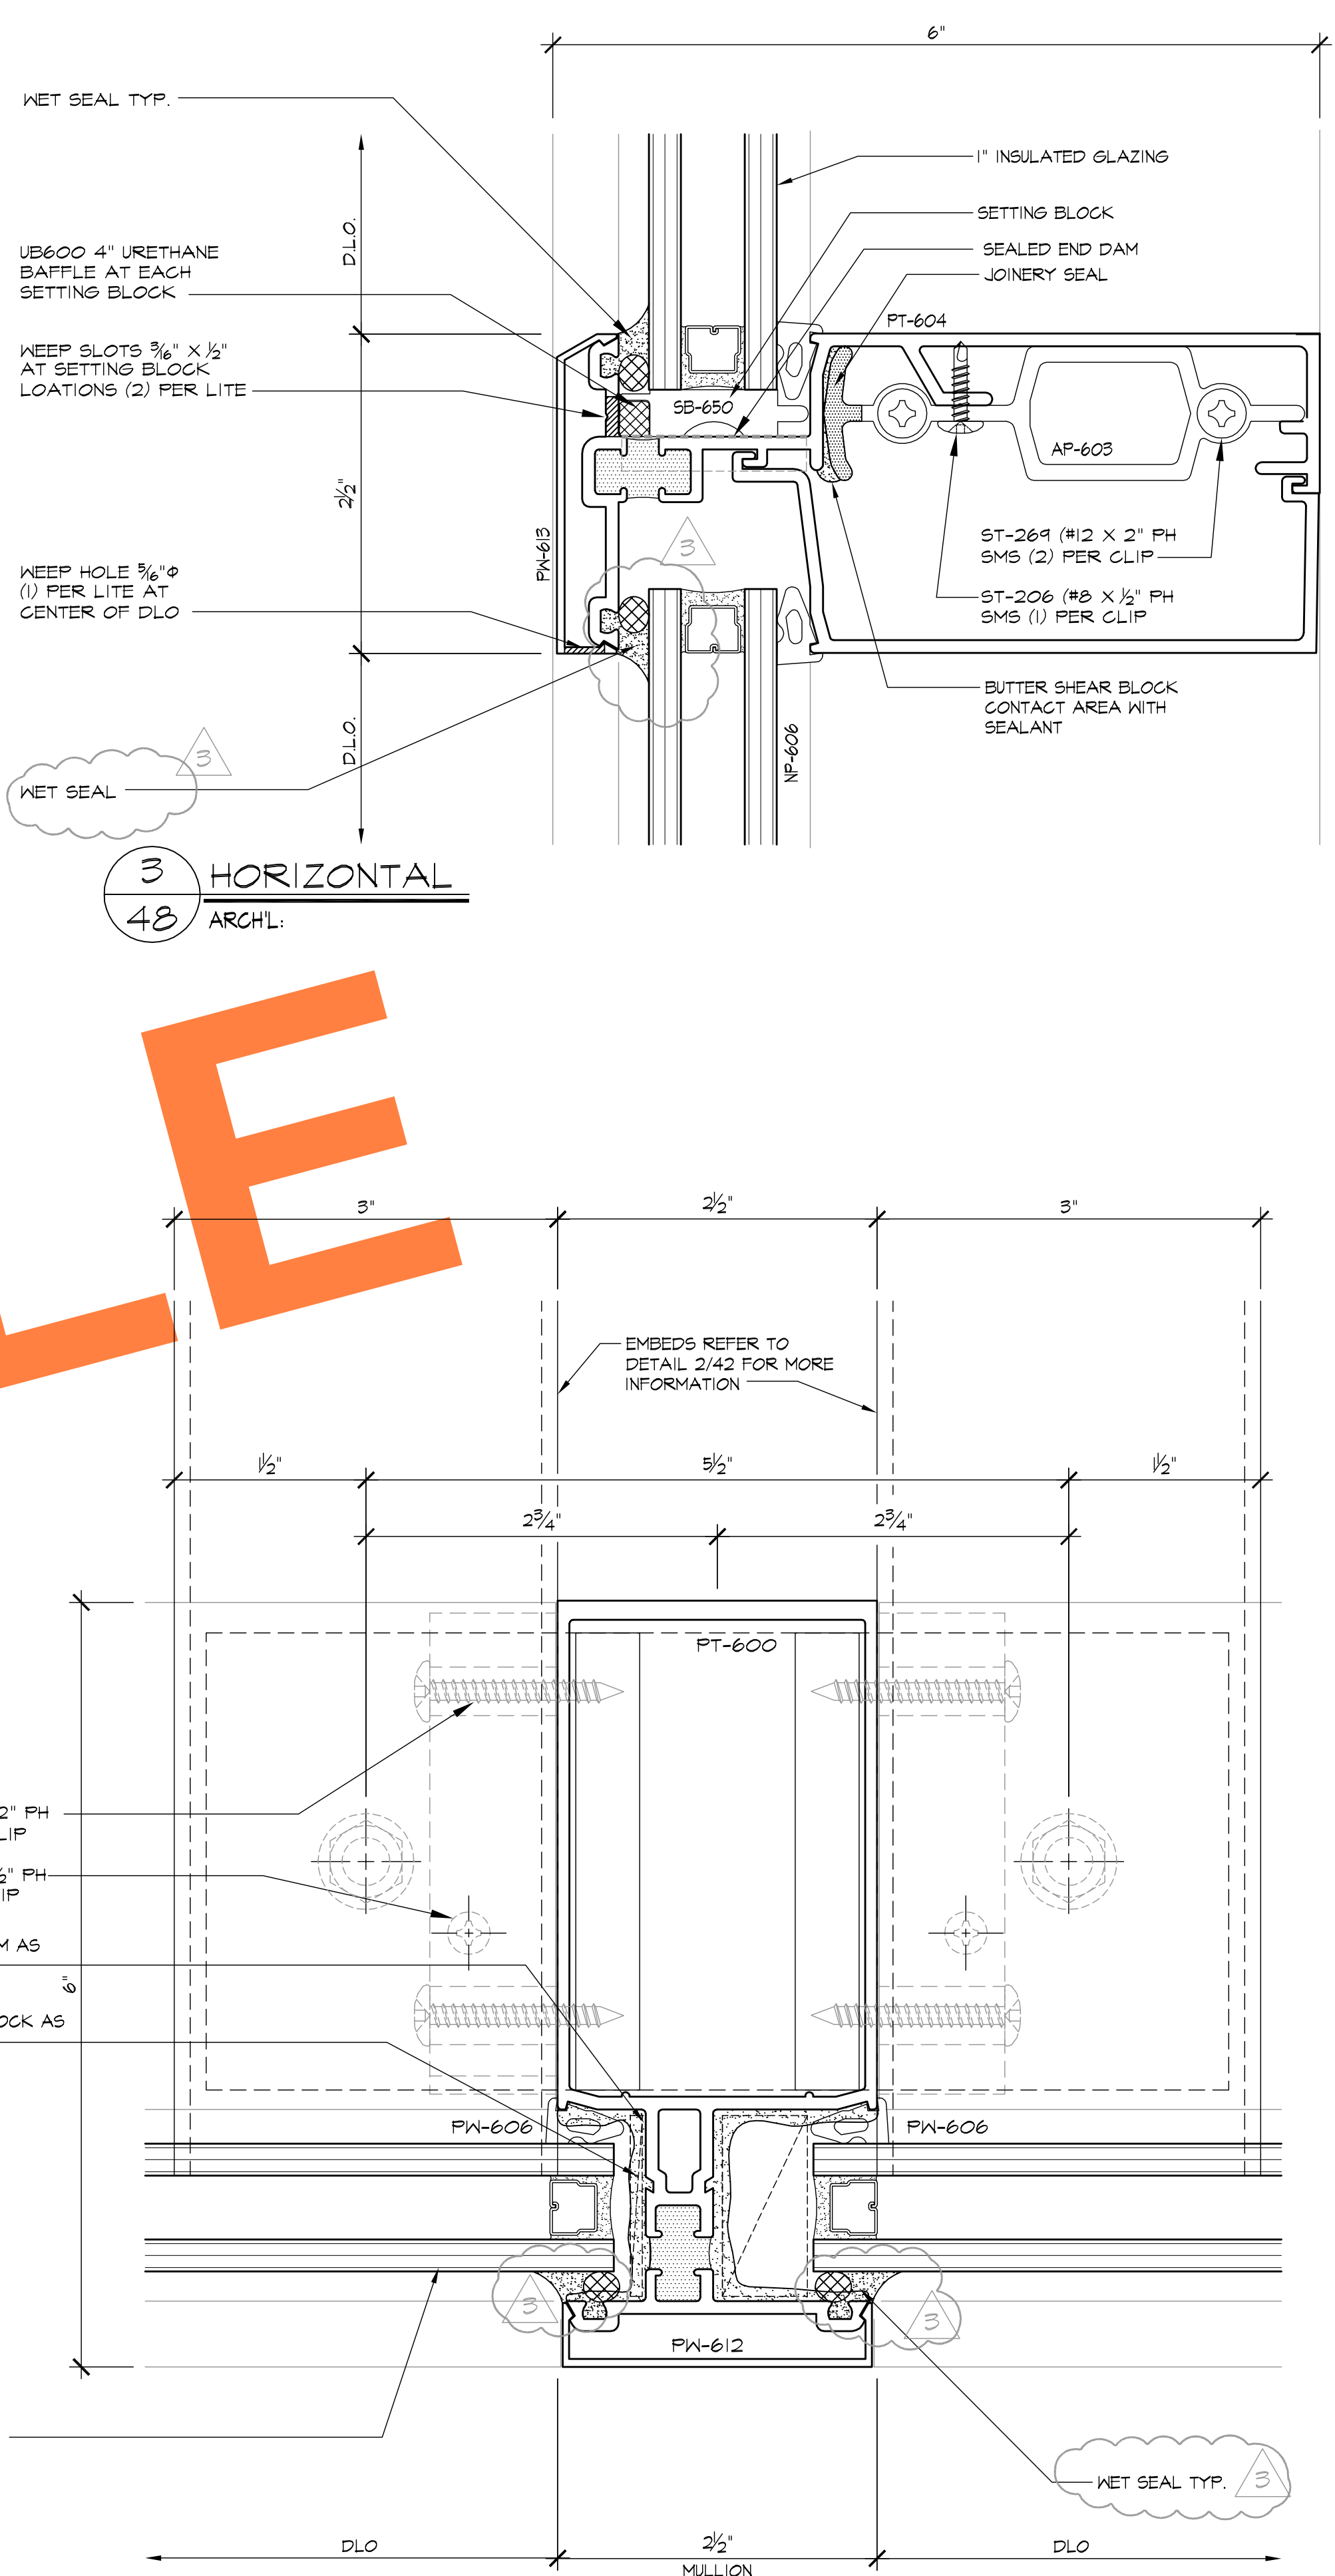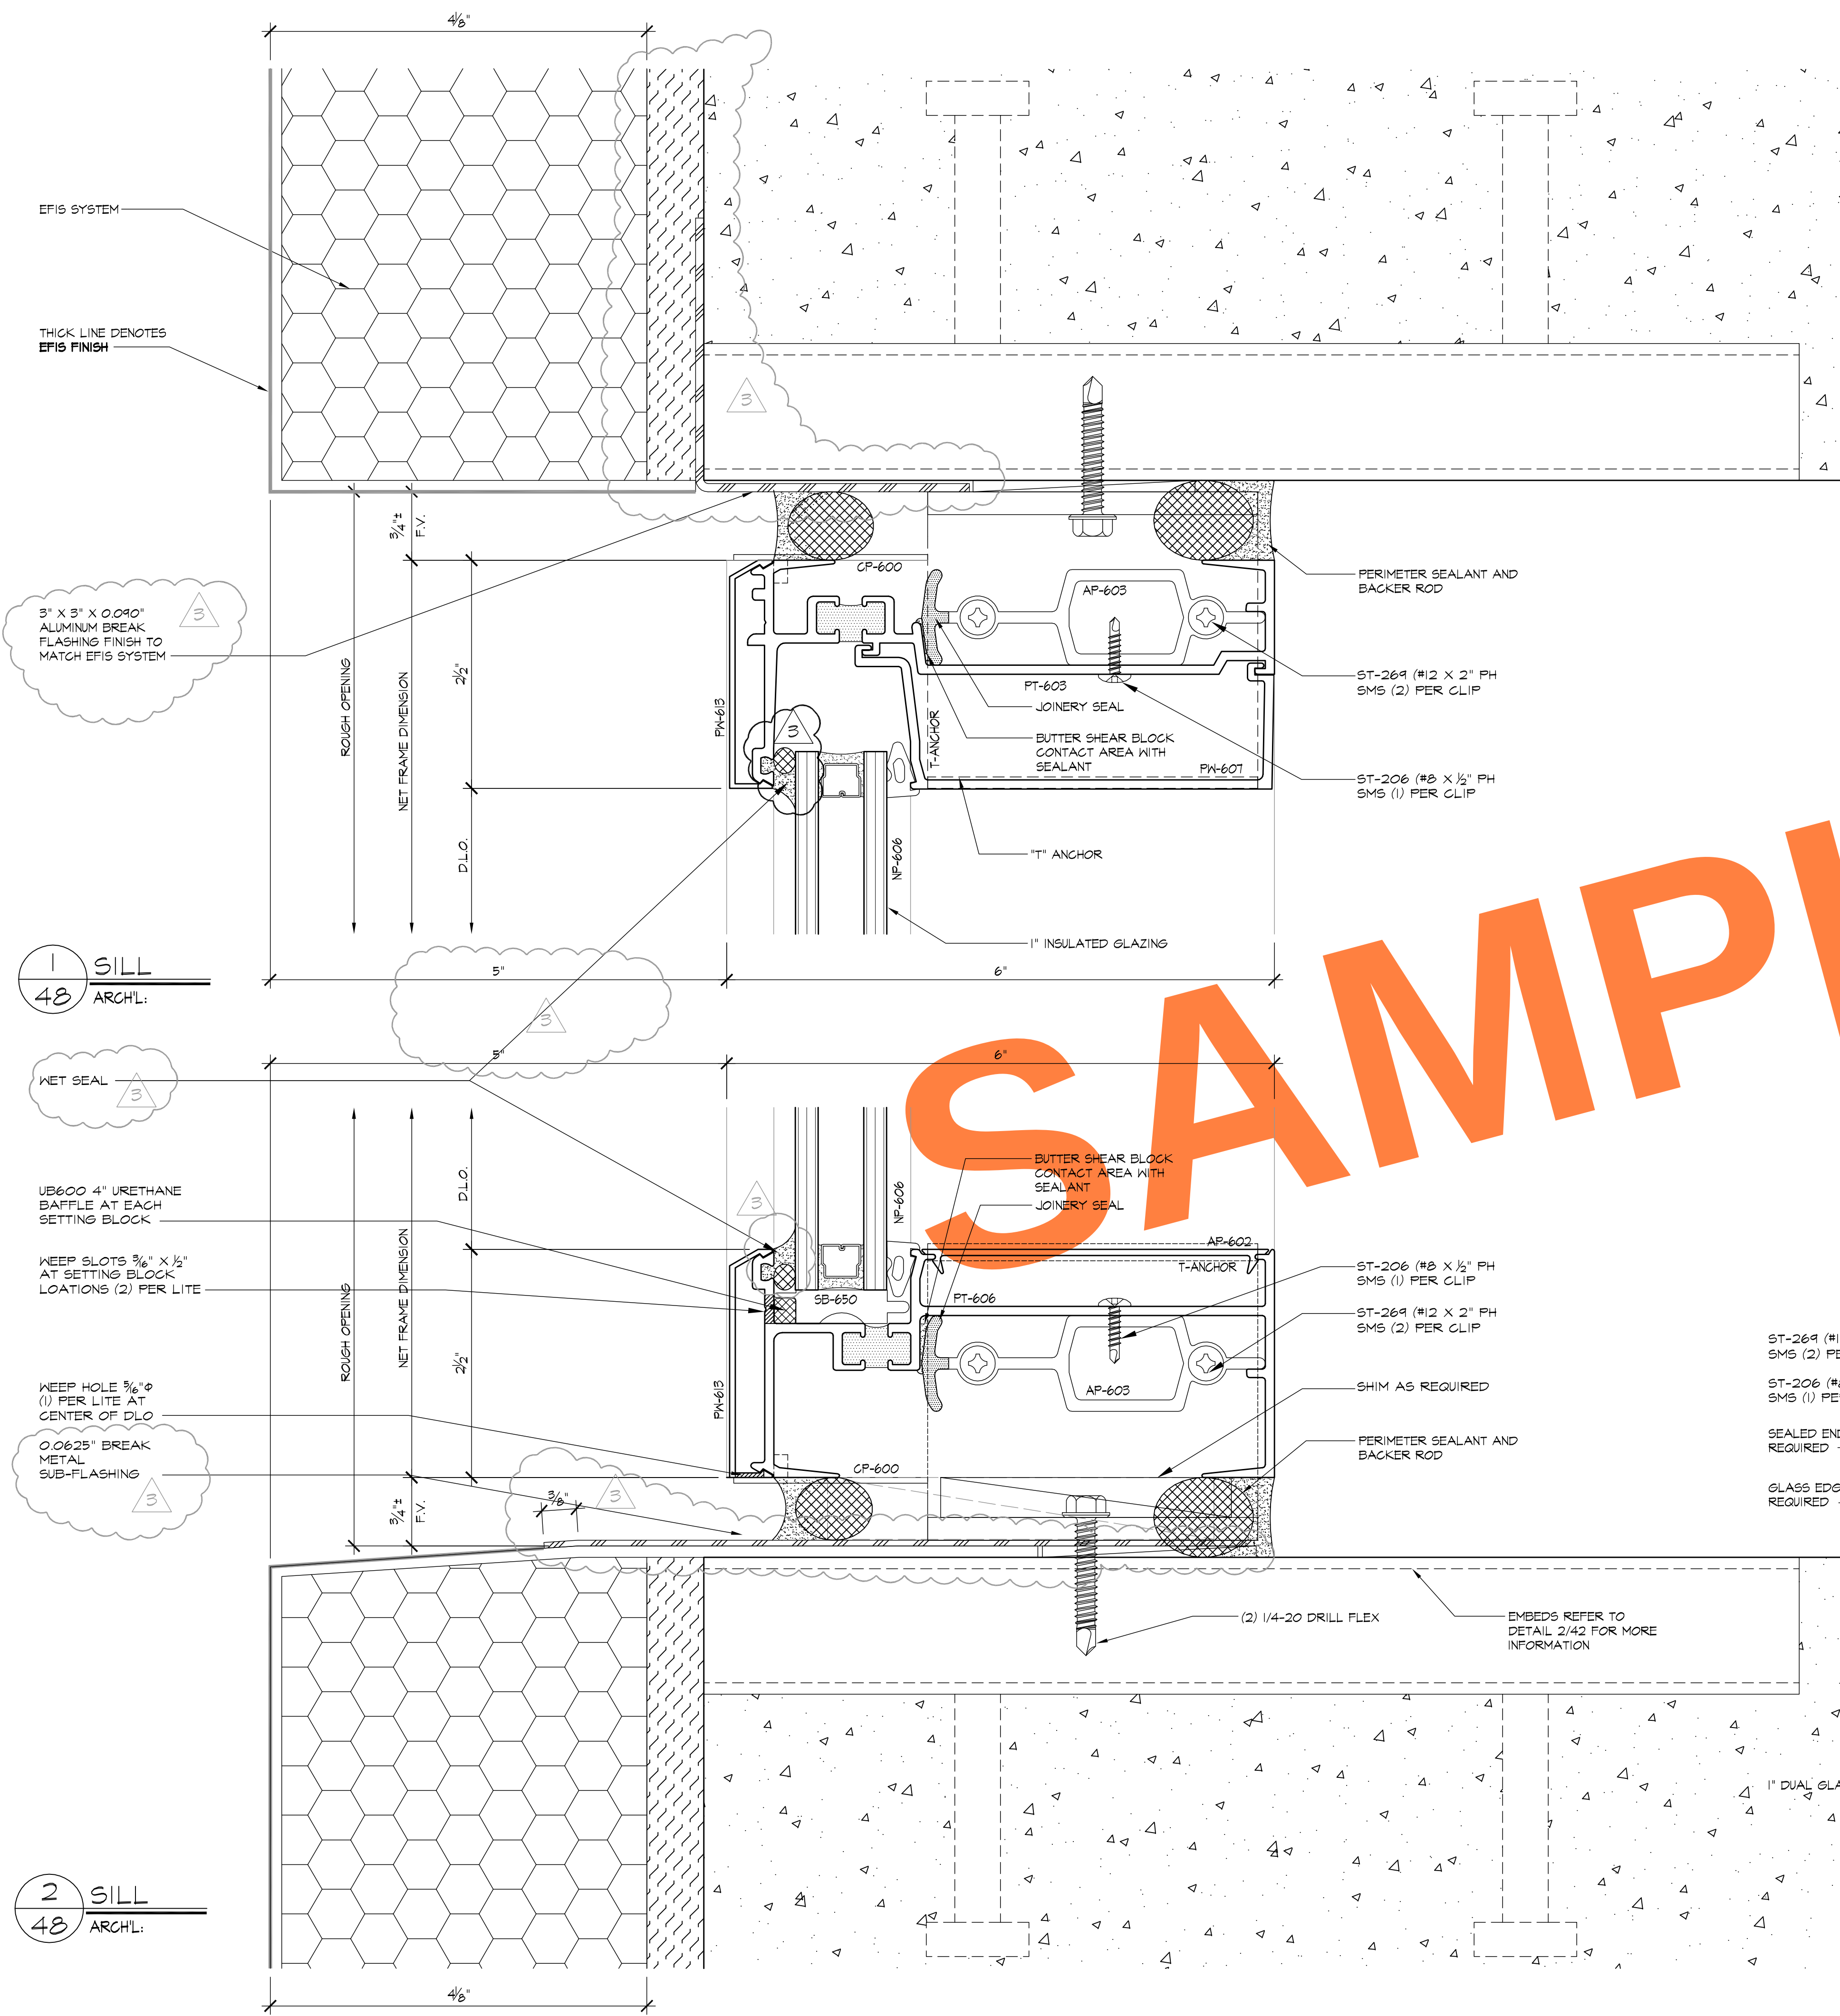


REVISIONS		BY
△	4-23-07	BMR
△	6-11-07	BMR
△	12-17-07	CTB
△	3/6/08	CTB
△		

BMR DRAFTING SERVICE SINCE 1988 23846 SUNNYMEAD BLVD. SUITE #9 MORENO VALLEY, CA 92553 B: (951) 243-7814 F: (951) 243-7873	
GLASS FACTORY 26383 BASE LINE HIGHLAND, CA 92346	
AS-BUILT DRAWINGS	




JOB NAME:	AGUA CALIENTE HOTEL ADDITION
ARCHITECT:	VOA
SHEET DESCRIPTION:	DETAILS
DATE:	6-11-07
SCALE:	FULL
DRAWN:	BMR
JOB NO:	100-06
SHEET NO:	48

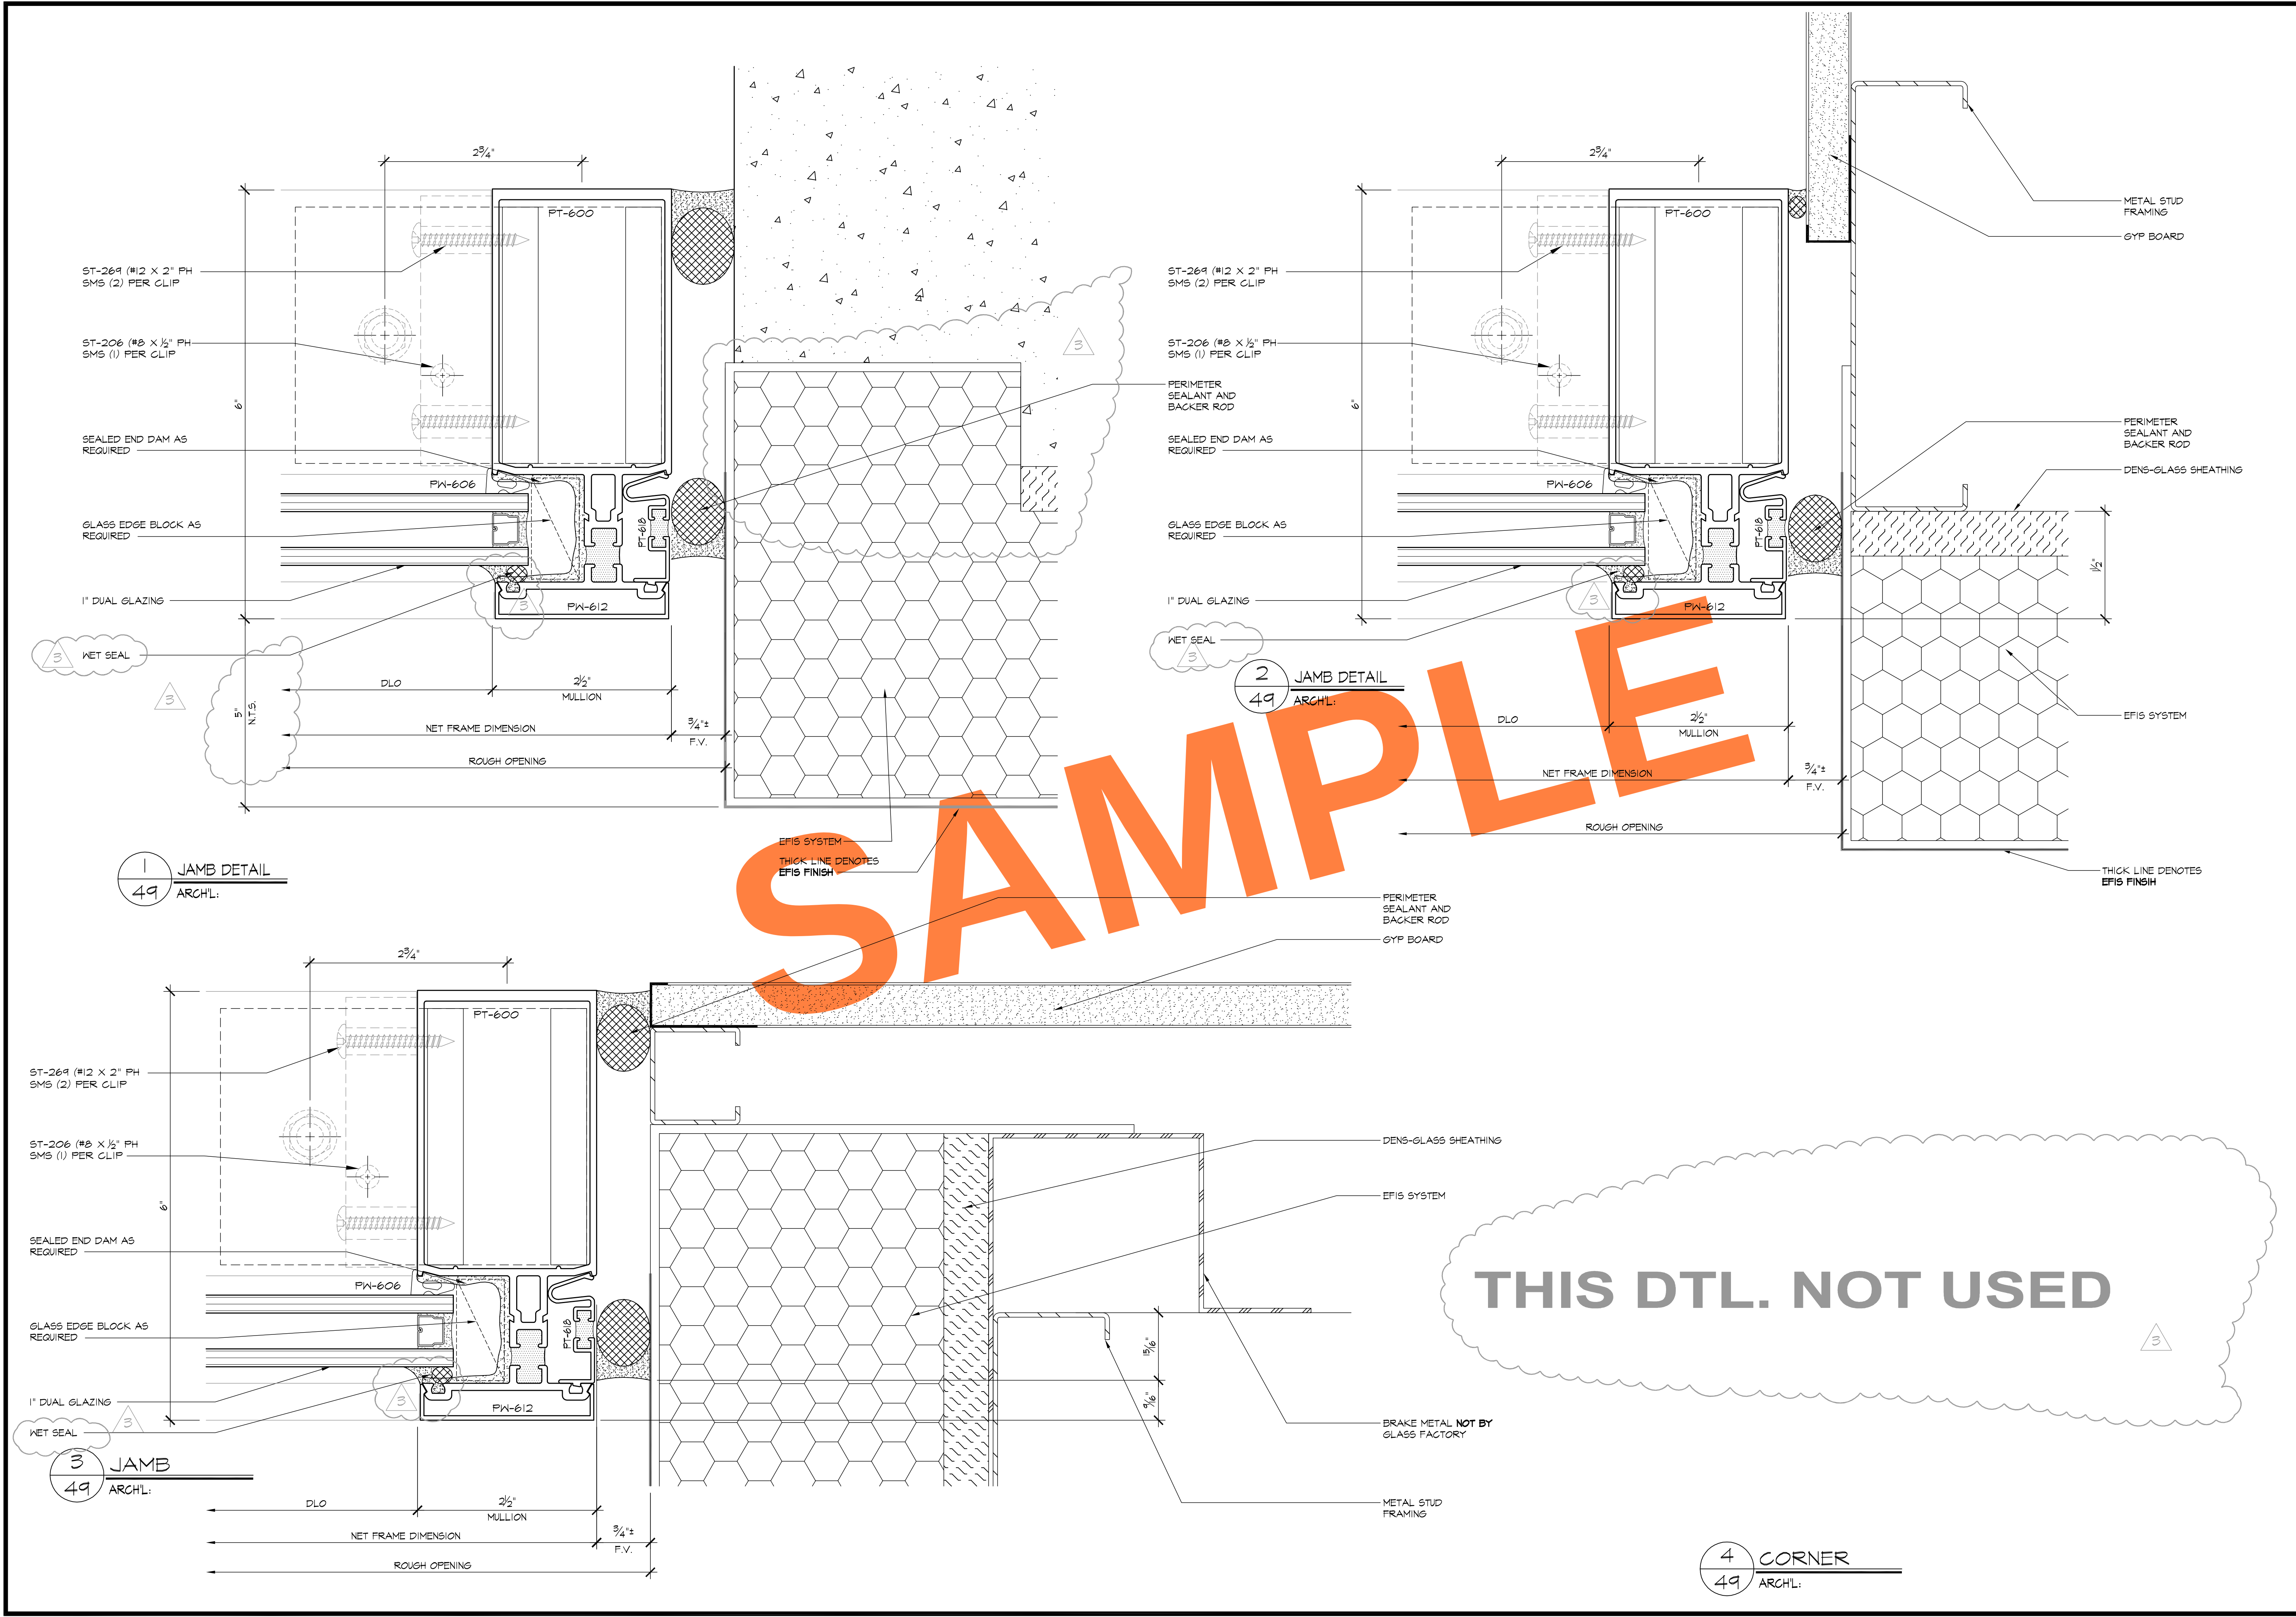

REVISIONS		BY
△	4-23-07	BMR
△	6-11-07	BMR
△	12-17-07	CTB
△	3/6/08	CTB
△		
BMR DRAFTING SERVICE SINCE 1988 23846 SUNNYMEAD BLVD. SUITE #9 MORENO VALLEY, CA 92553 P: (951) 243-7814 F: (951) 243-7873		
GLASS FACTORY 26383 BASE LINE HIGHLAND, CA 92346		
AS-BUILT DRAWINGS		
JOB NAME:	AGUA CALIENTE HOTEL ADDITION	
ARCHITECT:	VOA	
SHEET DESCRIPTION:	DETAILS	
DATE:	6-11-07	
SCALE:	FULL	
DRAWN:	BMR	
JOB NO:	100-06	
SHEET NO:	49	

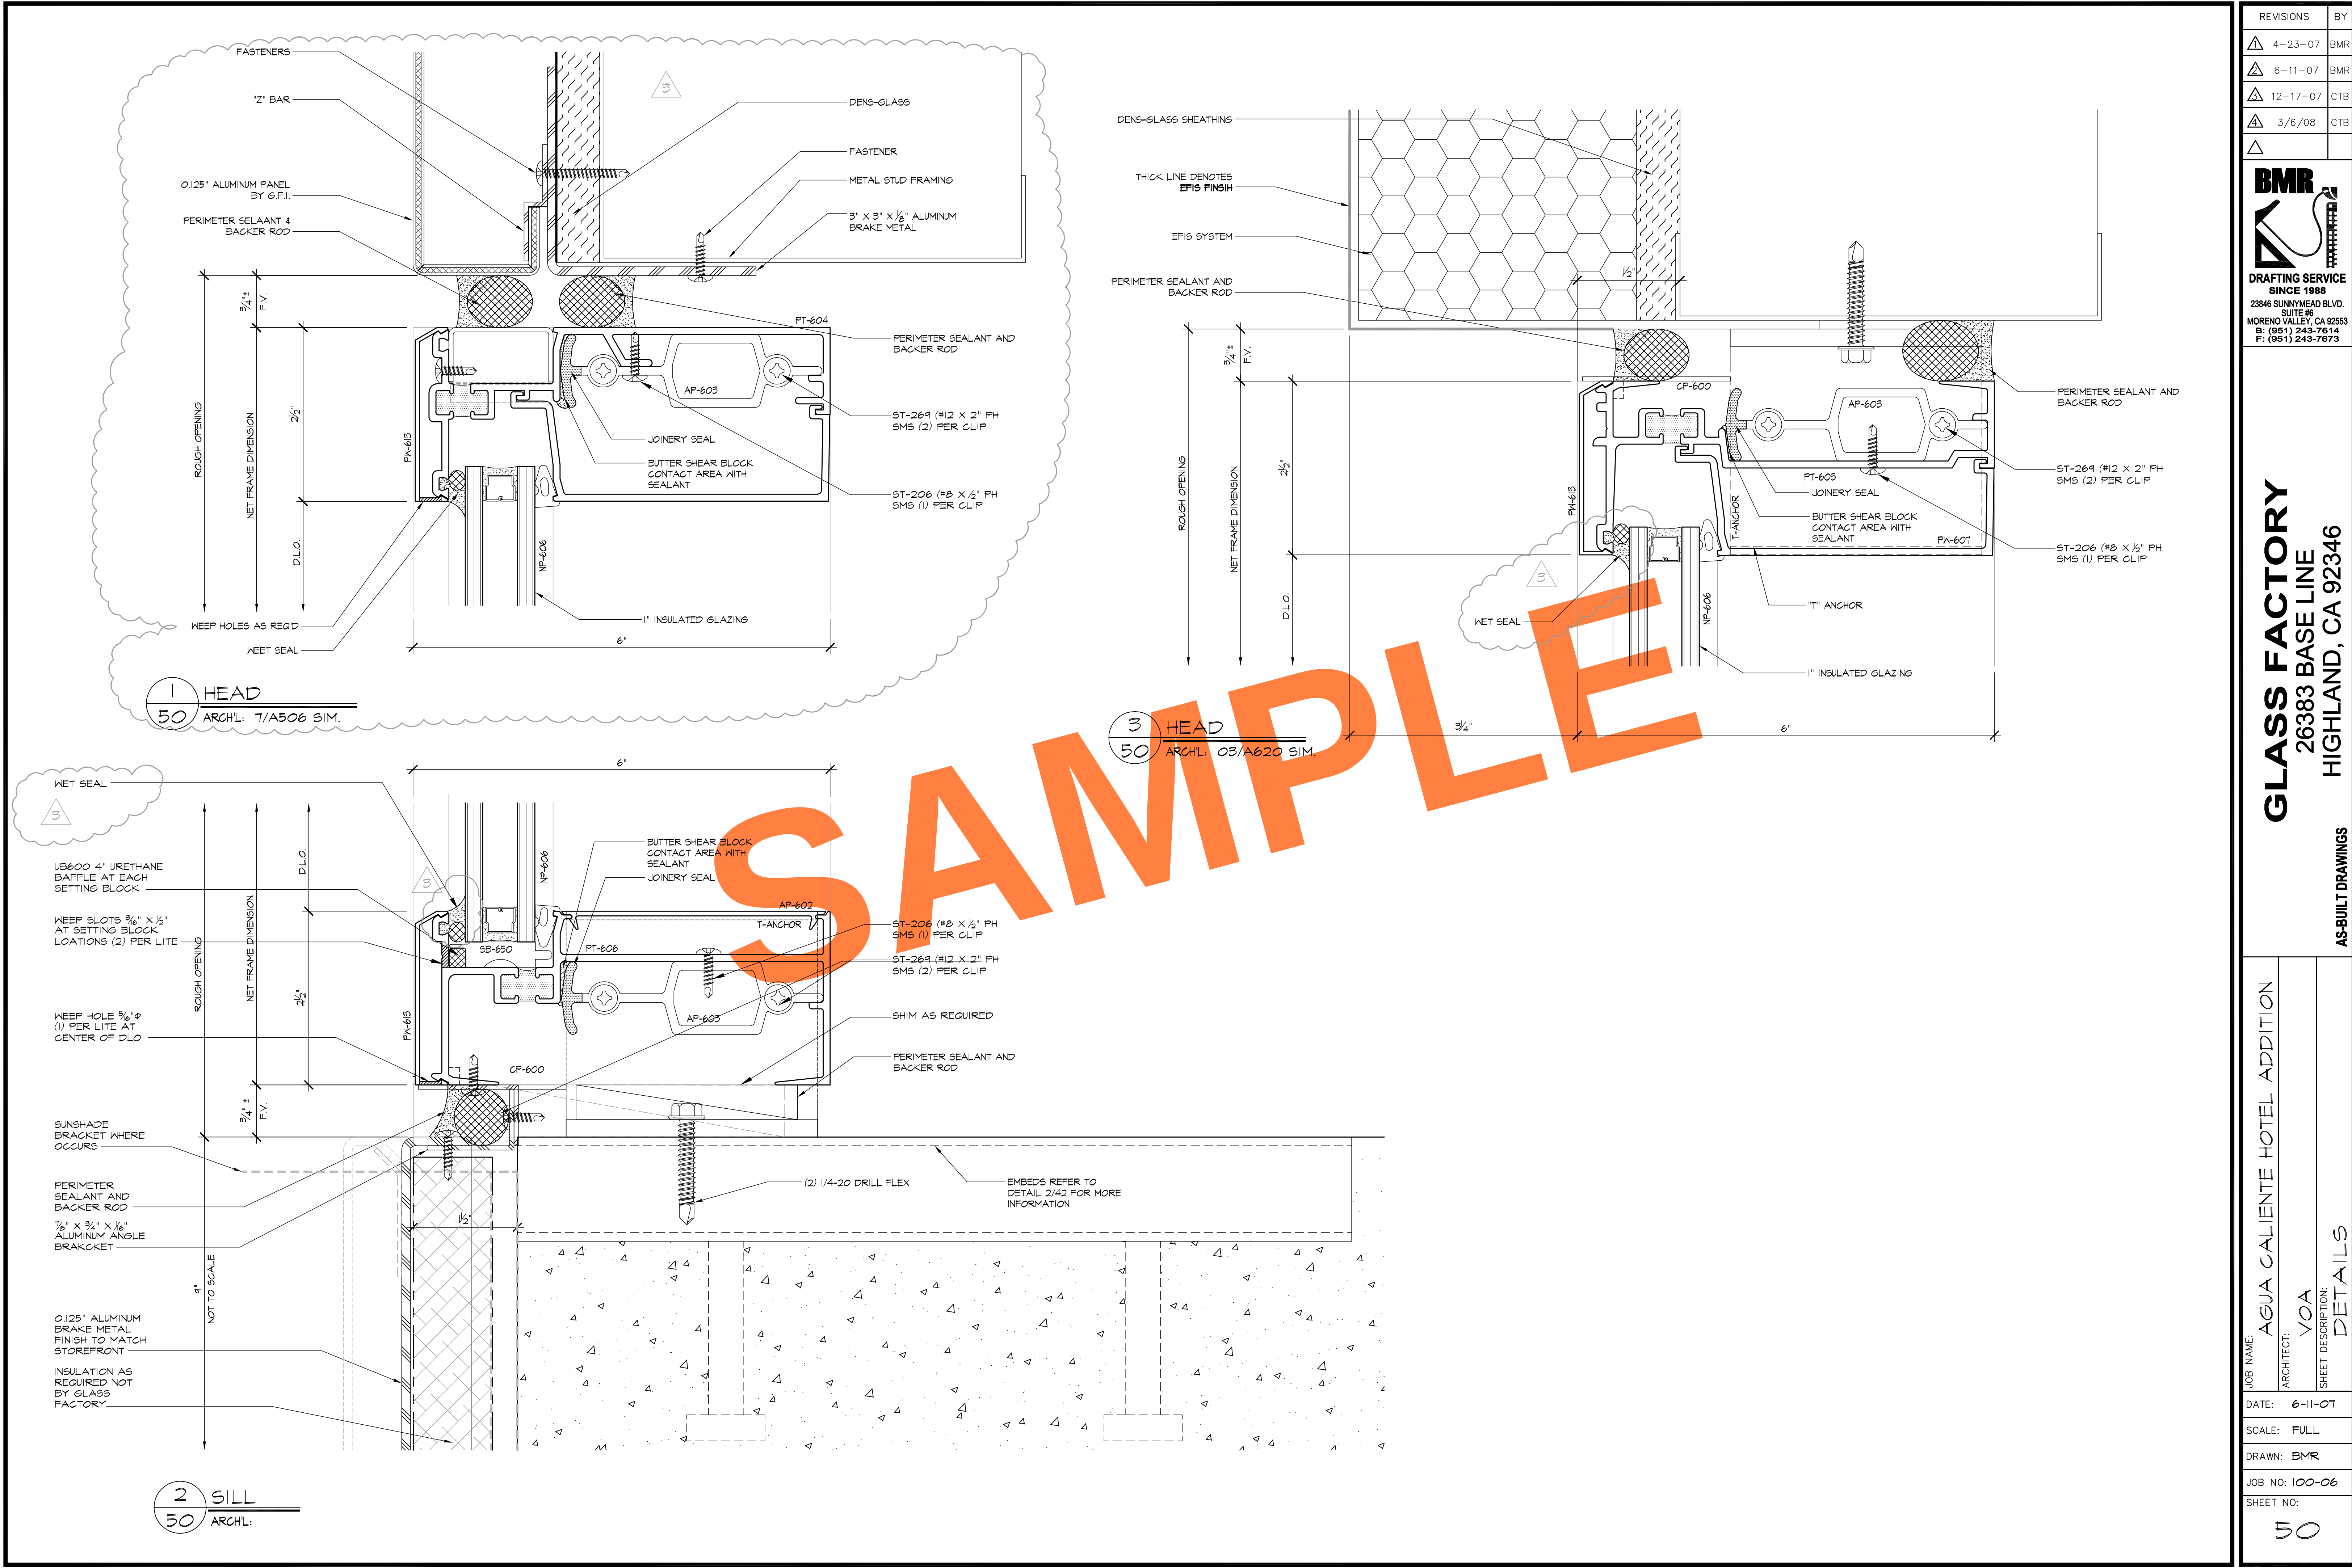

REVISIONS		BY
△	4-23-07	BMR
△	6-11-07	BMR
△	12-17-07	CTB
△	3/6/08	CTB
△		
BMR DRAFTING SERVICE SINCE 1988 23846 SUNNYMEAD BLVD. SUITE #9 MORENO VALLEY, CA 92553 P: (951) 243-7814 F: (951) 243-7873 GLASS FACTORY 26383 BASE LINE HIGHLAND, CA 92346 AS-BUILT DRAWINGS		
JOB NAME:	AGUA CALIENTE HOTEL ADDITION	
ARCHITECT:	VOA	
SHEET DESCRIPTION:	DETAILS	
DATE:	6-11-07	
SCALE:	FULL	
DRAWN:	BMR	
JOB NO:	100-06	
SHEET NO:	50	

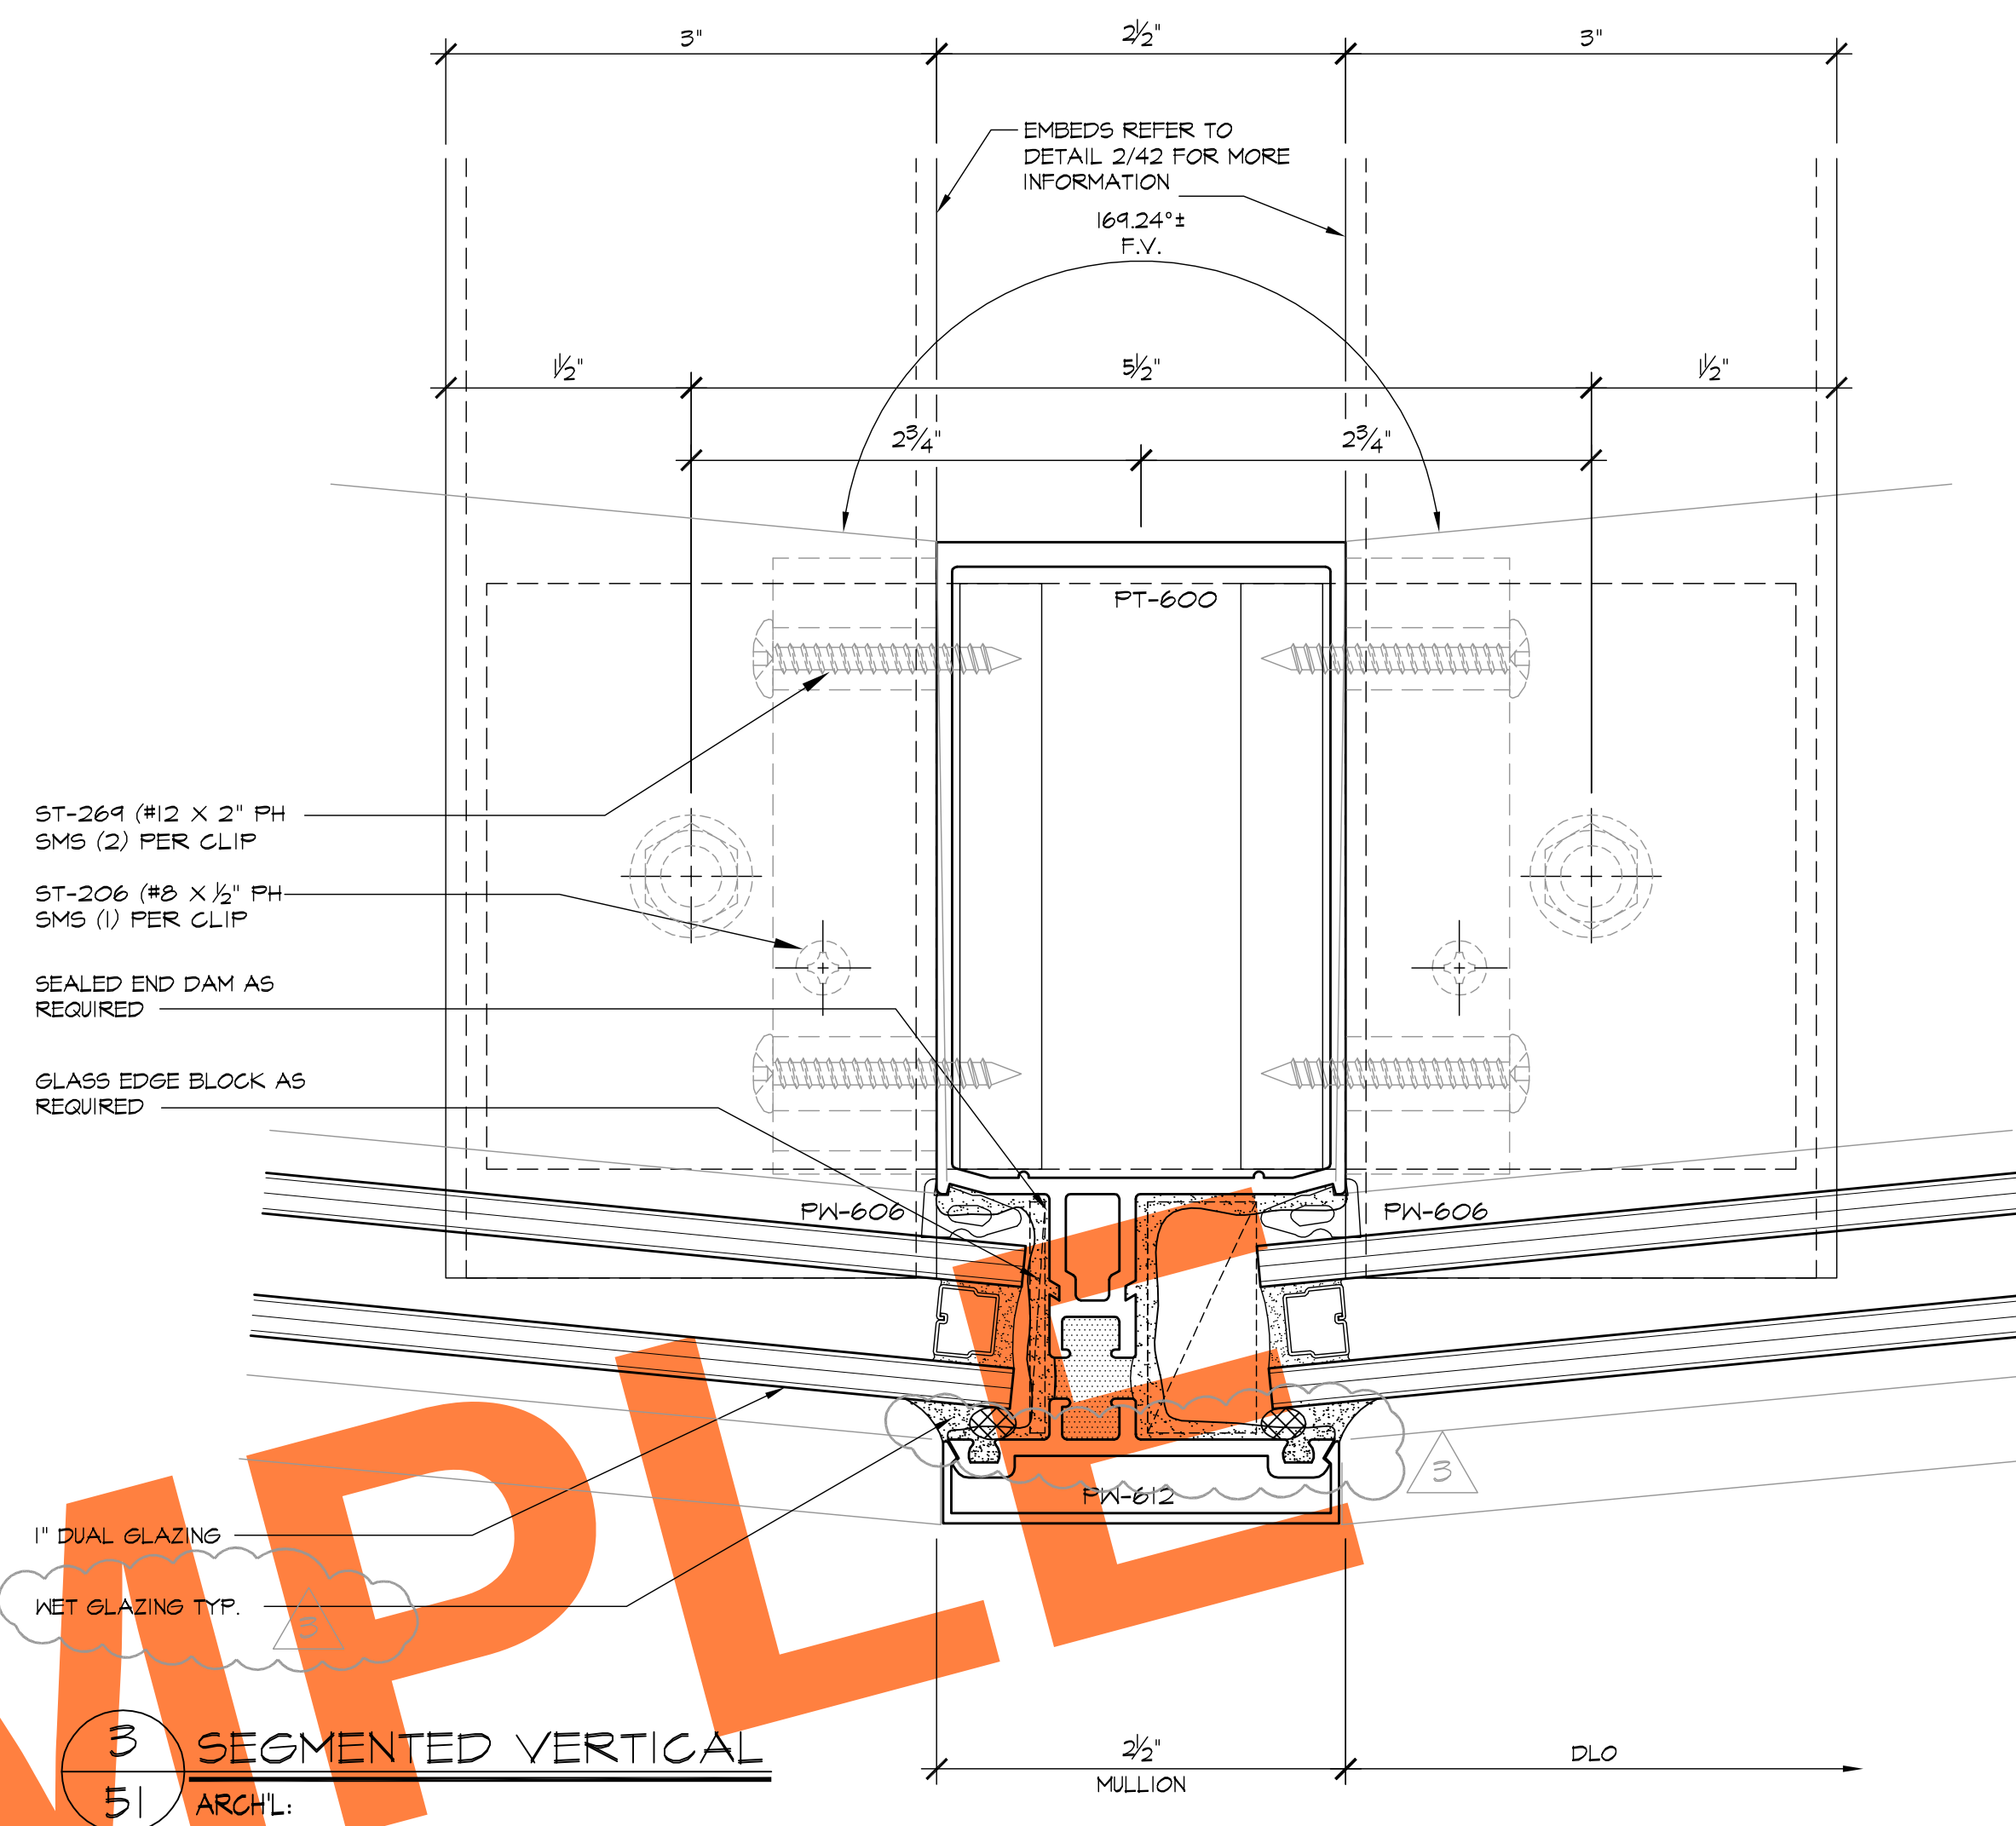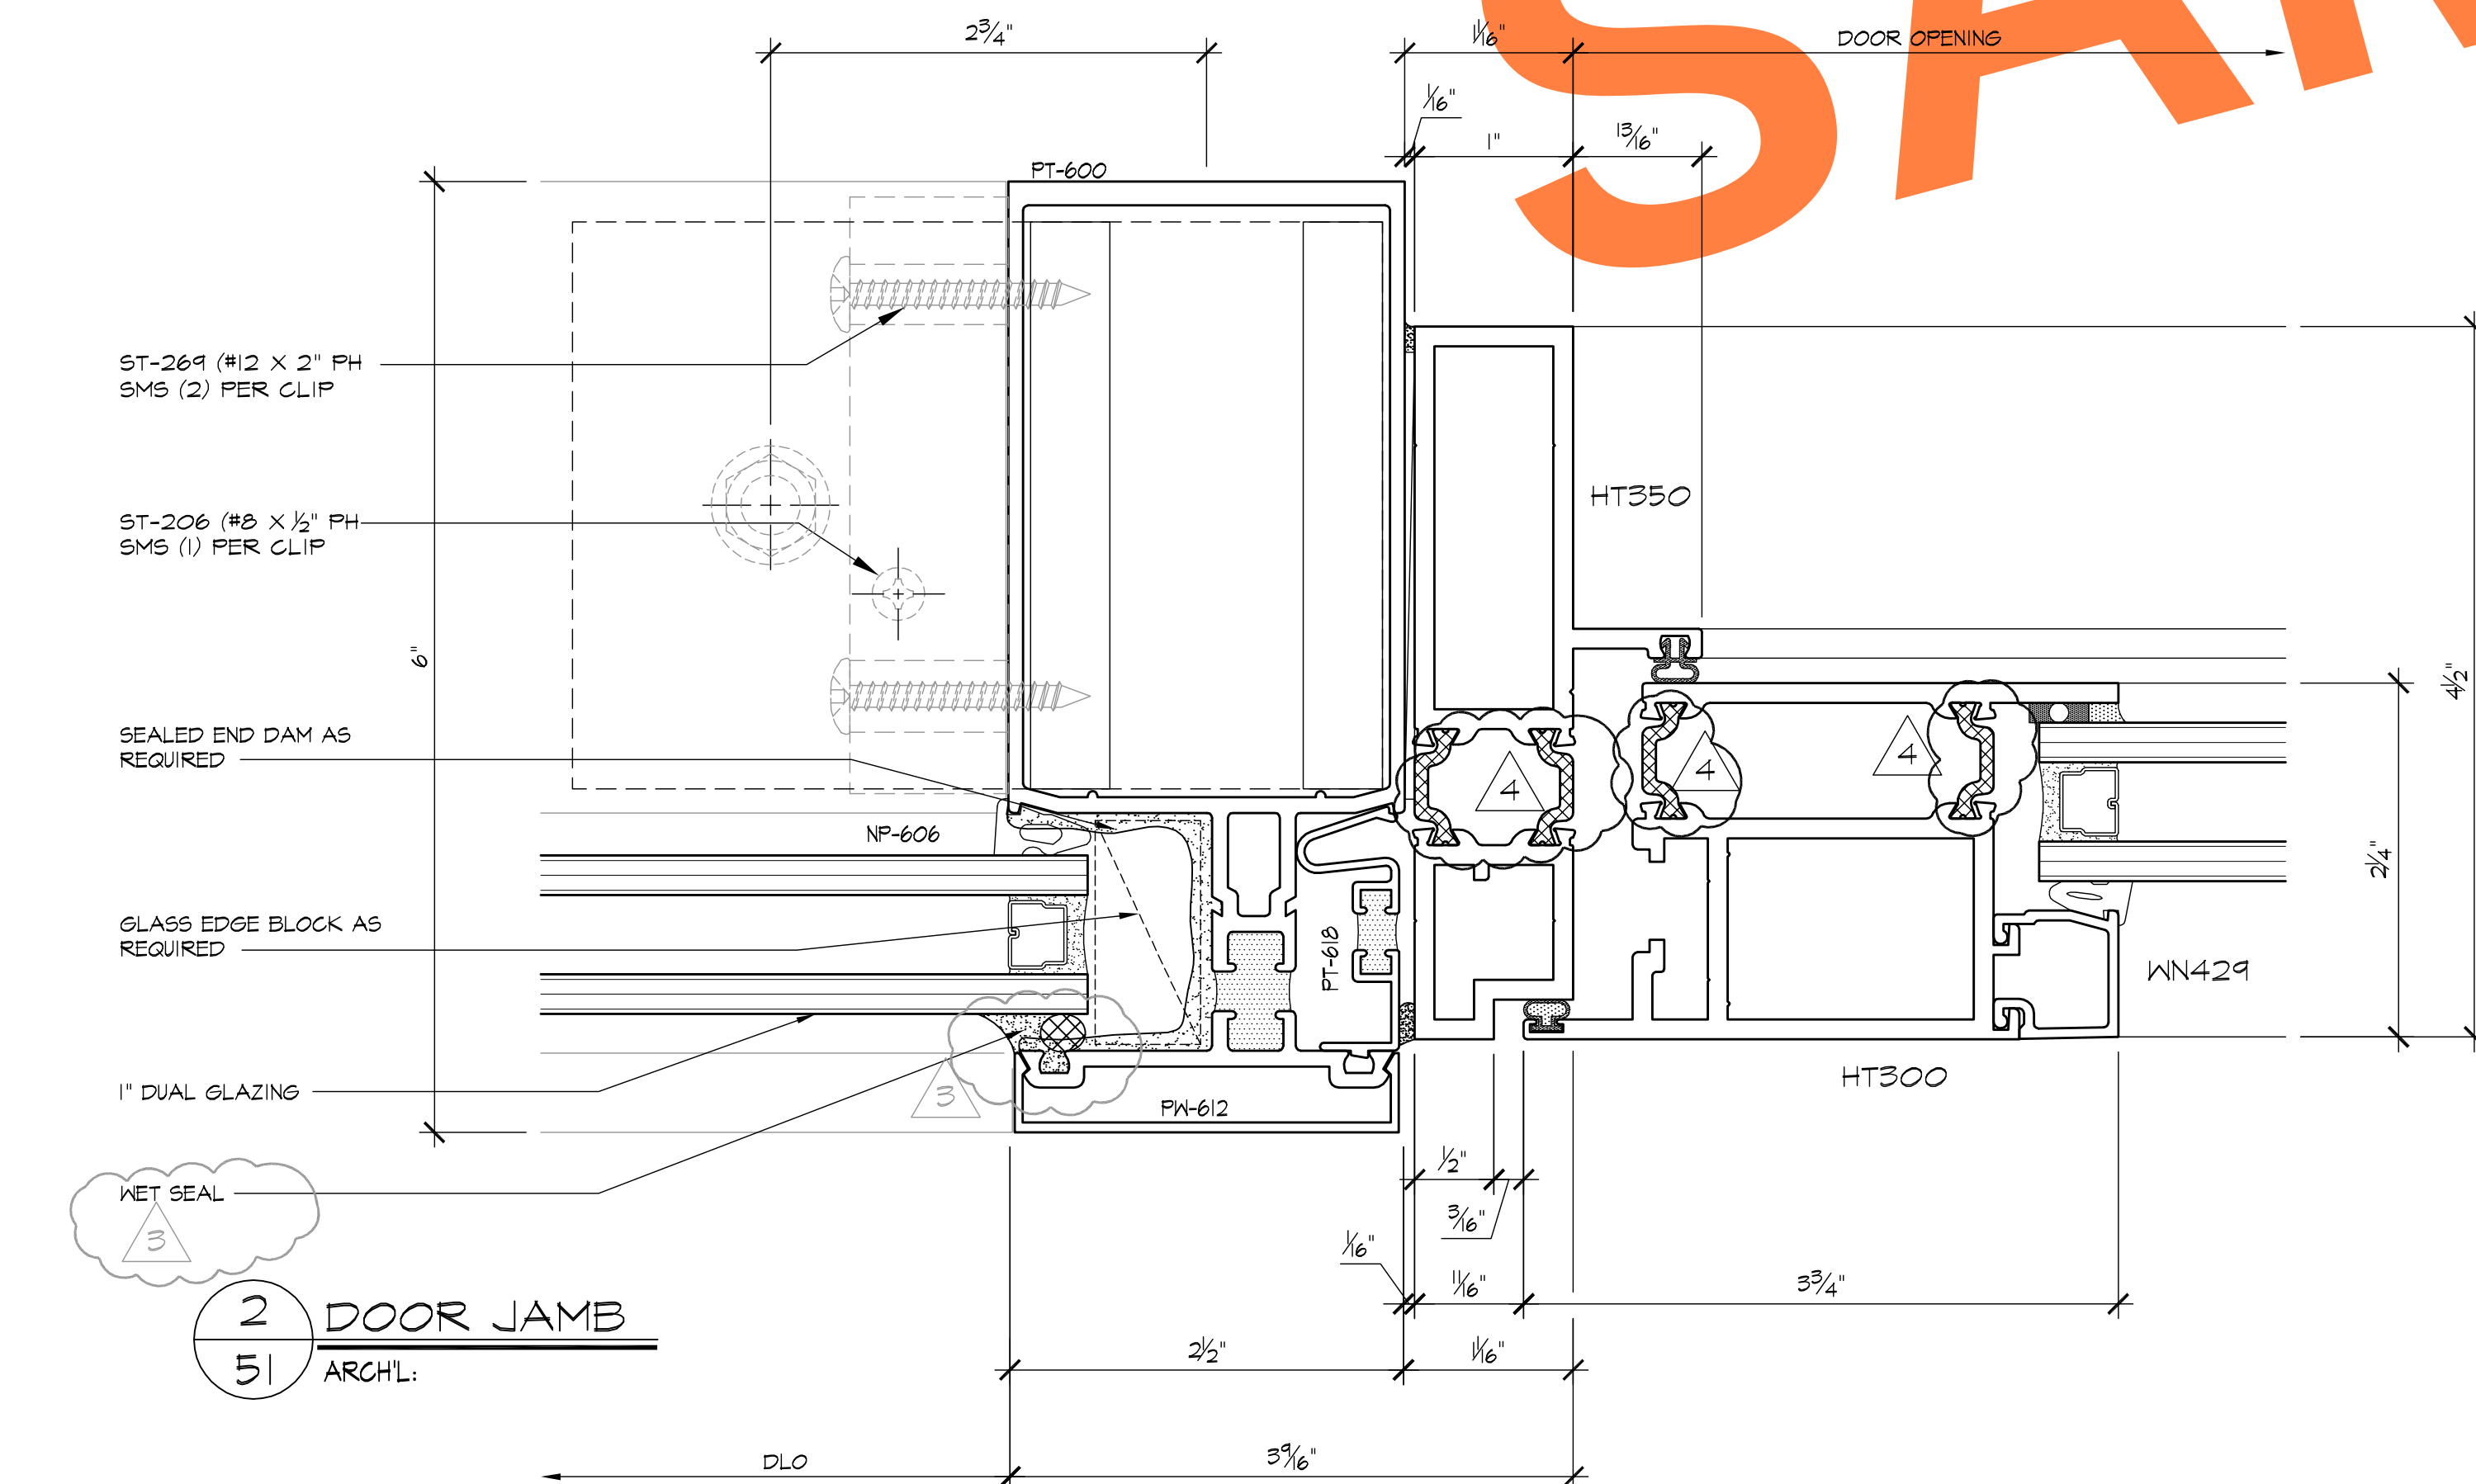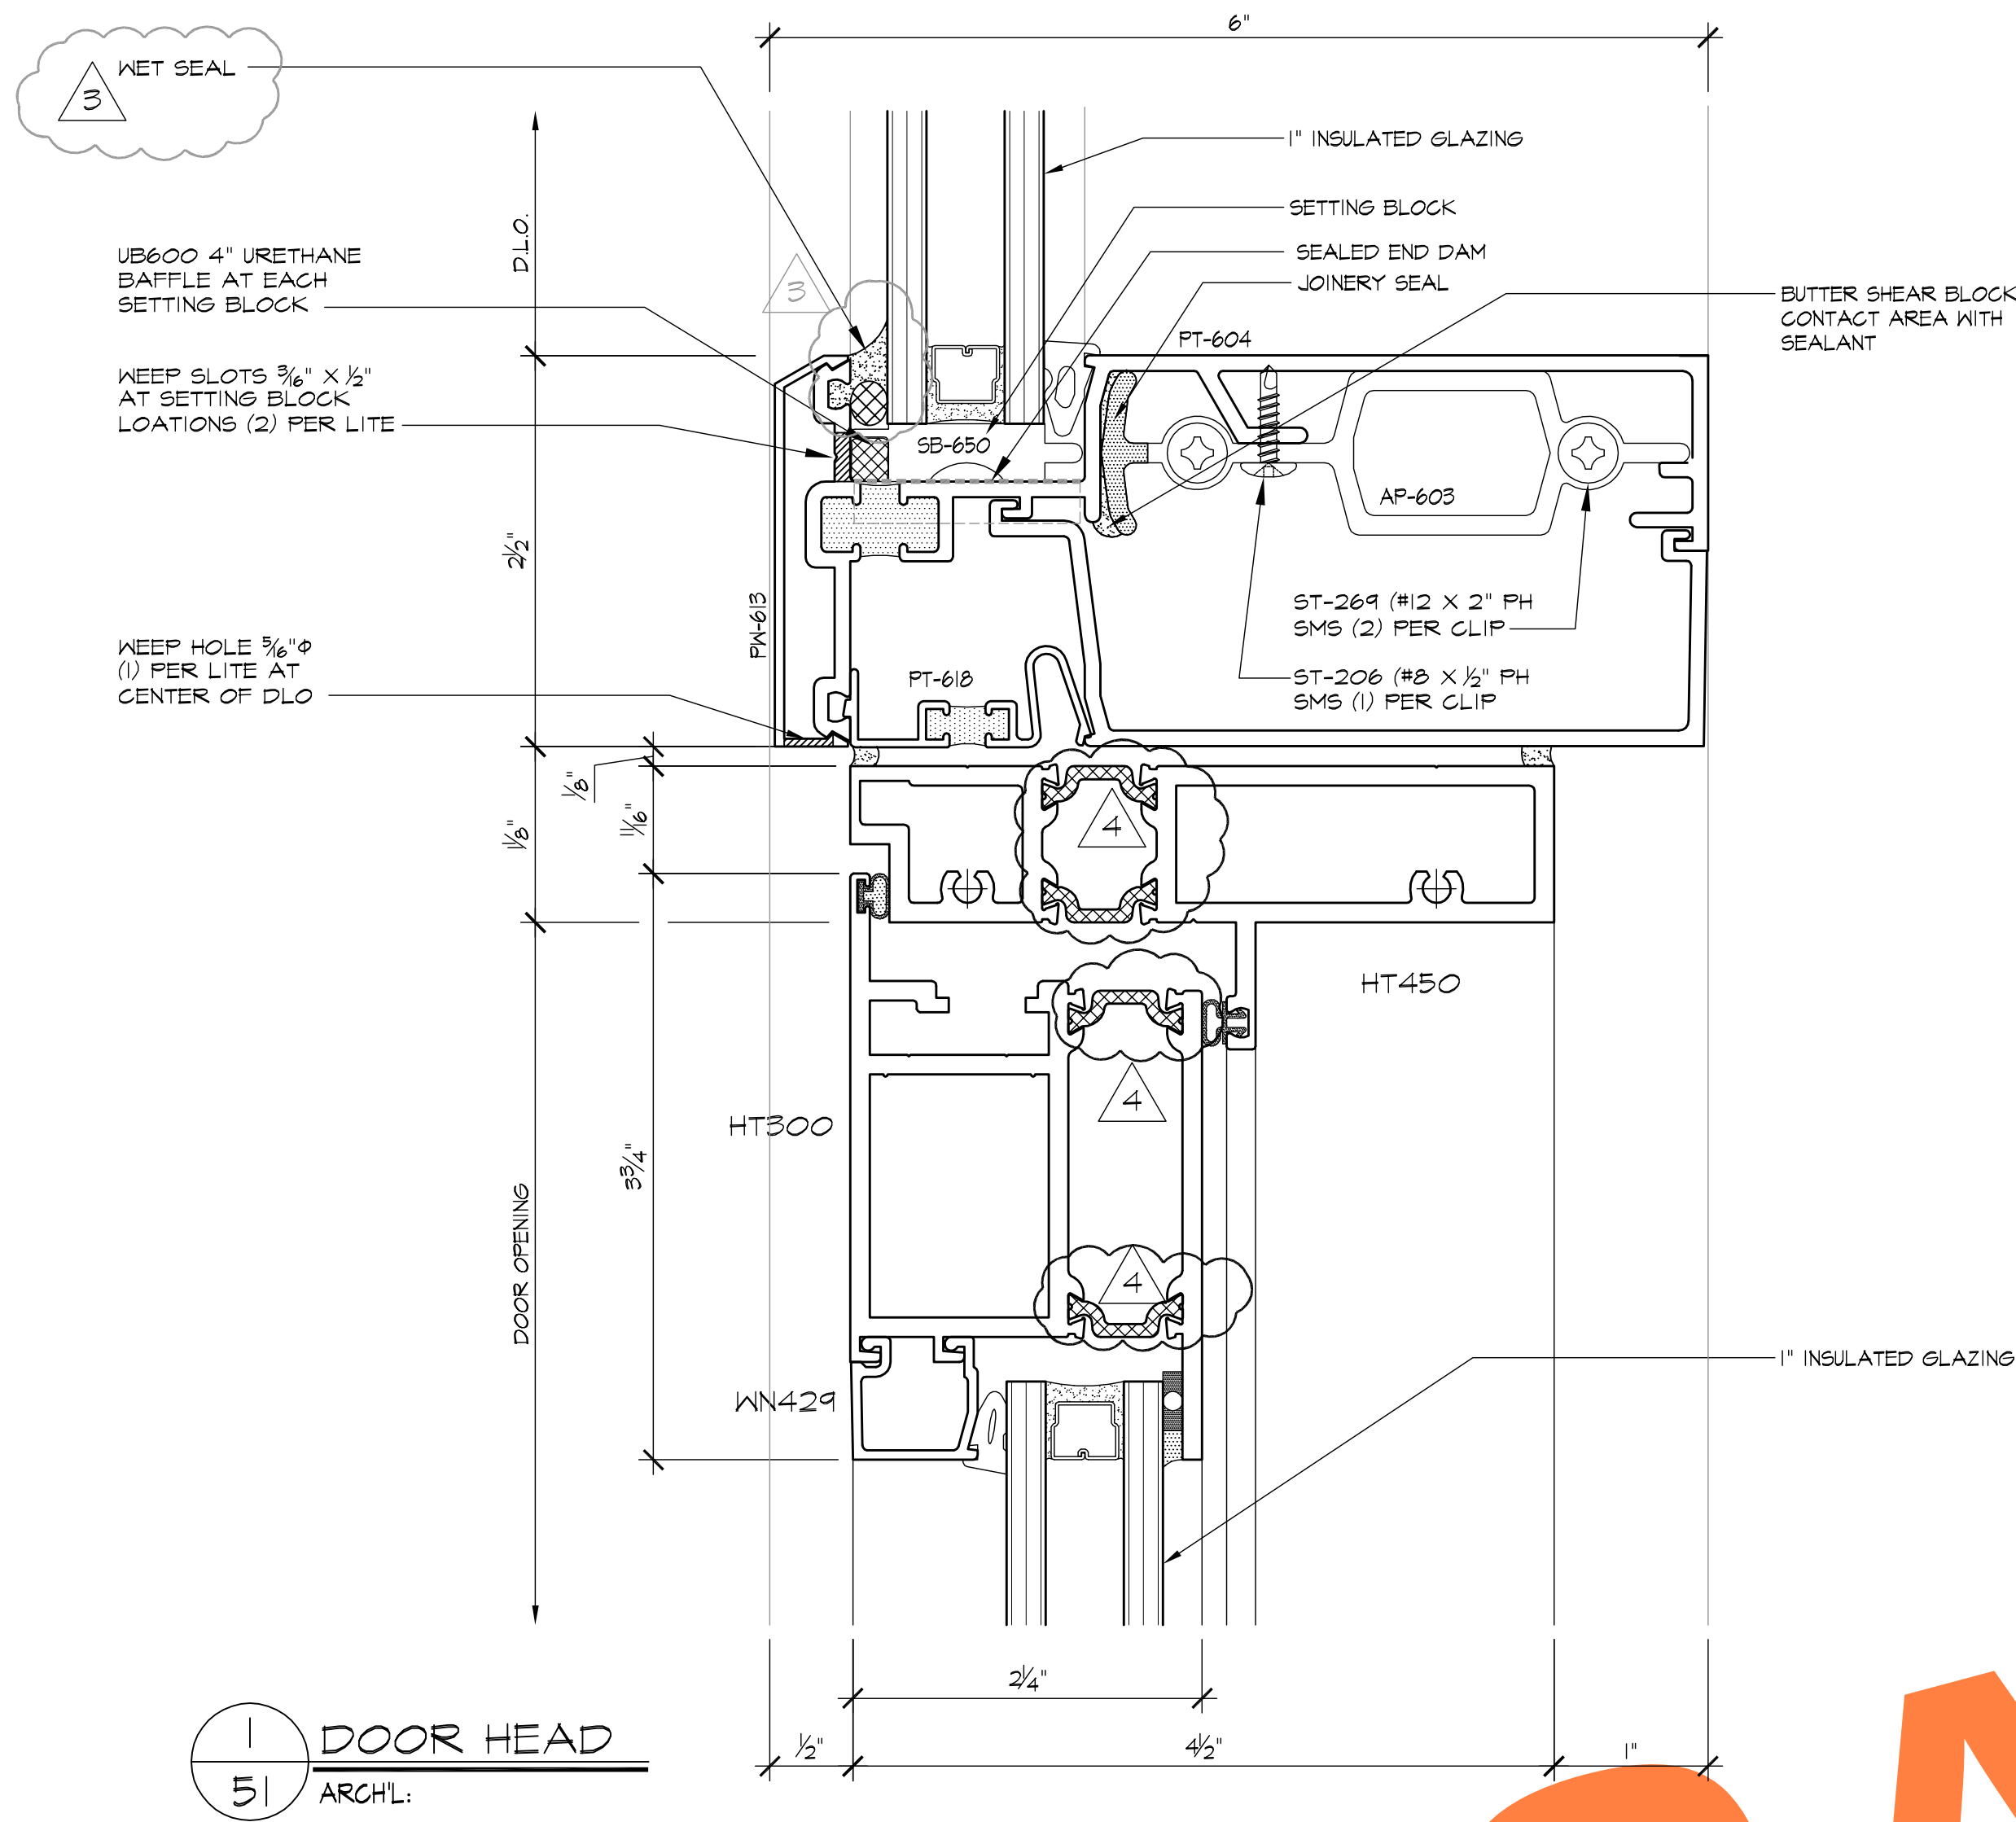

THIS DTL. NOT USED




REVISIONS	BY
4-23-07	BMR
6-11-07	BMR
12-17-07	CTB
3/6/08	CTB


BMR
DRAFTING SERVICE
SINCE 1988
23846 SUNNYMEAD BLVD.
SUITE #9
MORENO VALLEY, CA 92553
P: (951) 243-7814
F: (951) 243-7873

GLASS FACTORY
26383 BASE LINE
HIGHLAND, CA 92346
AS-BUILT DRAWINGS

JOB NAME:	AGUA CALIENTE HOTEL ADDITION
ARCHITECT:	VOA
SHEET DESCRIPTION:	DETAILS
DATE:	6-11-07
SCALE:	FULL
DRAWN:	BMR
JOB NO:	100-06
SHEET NO:	51

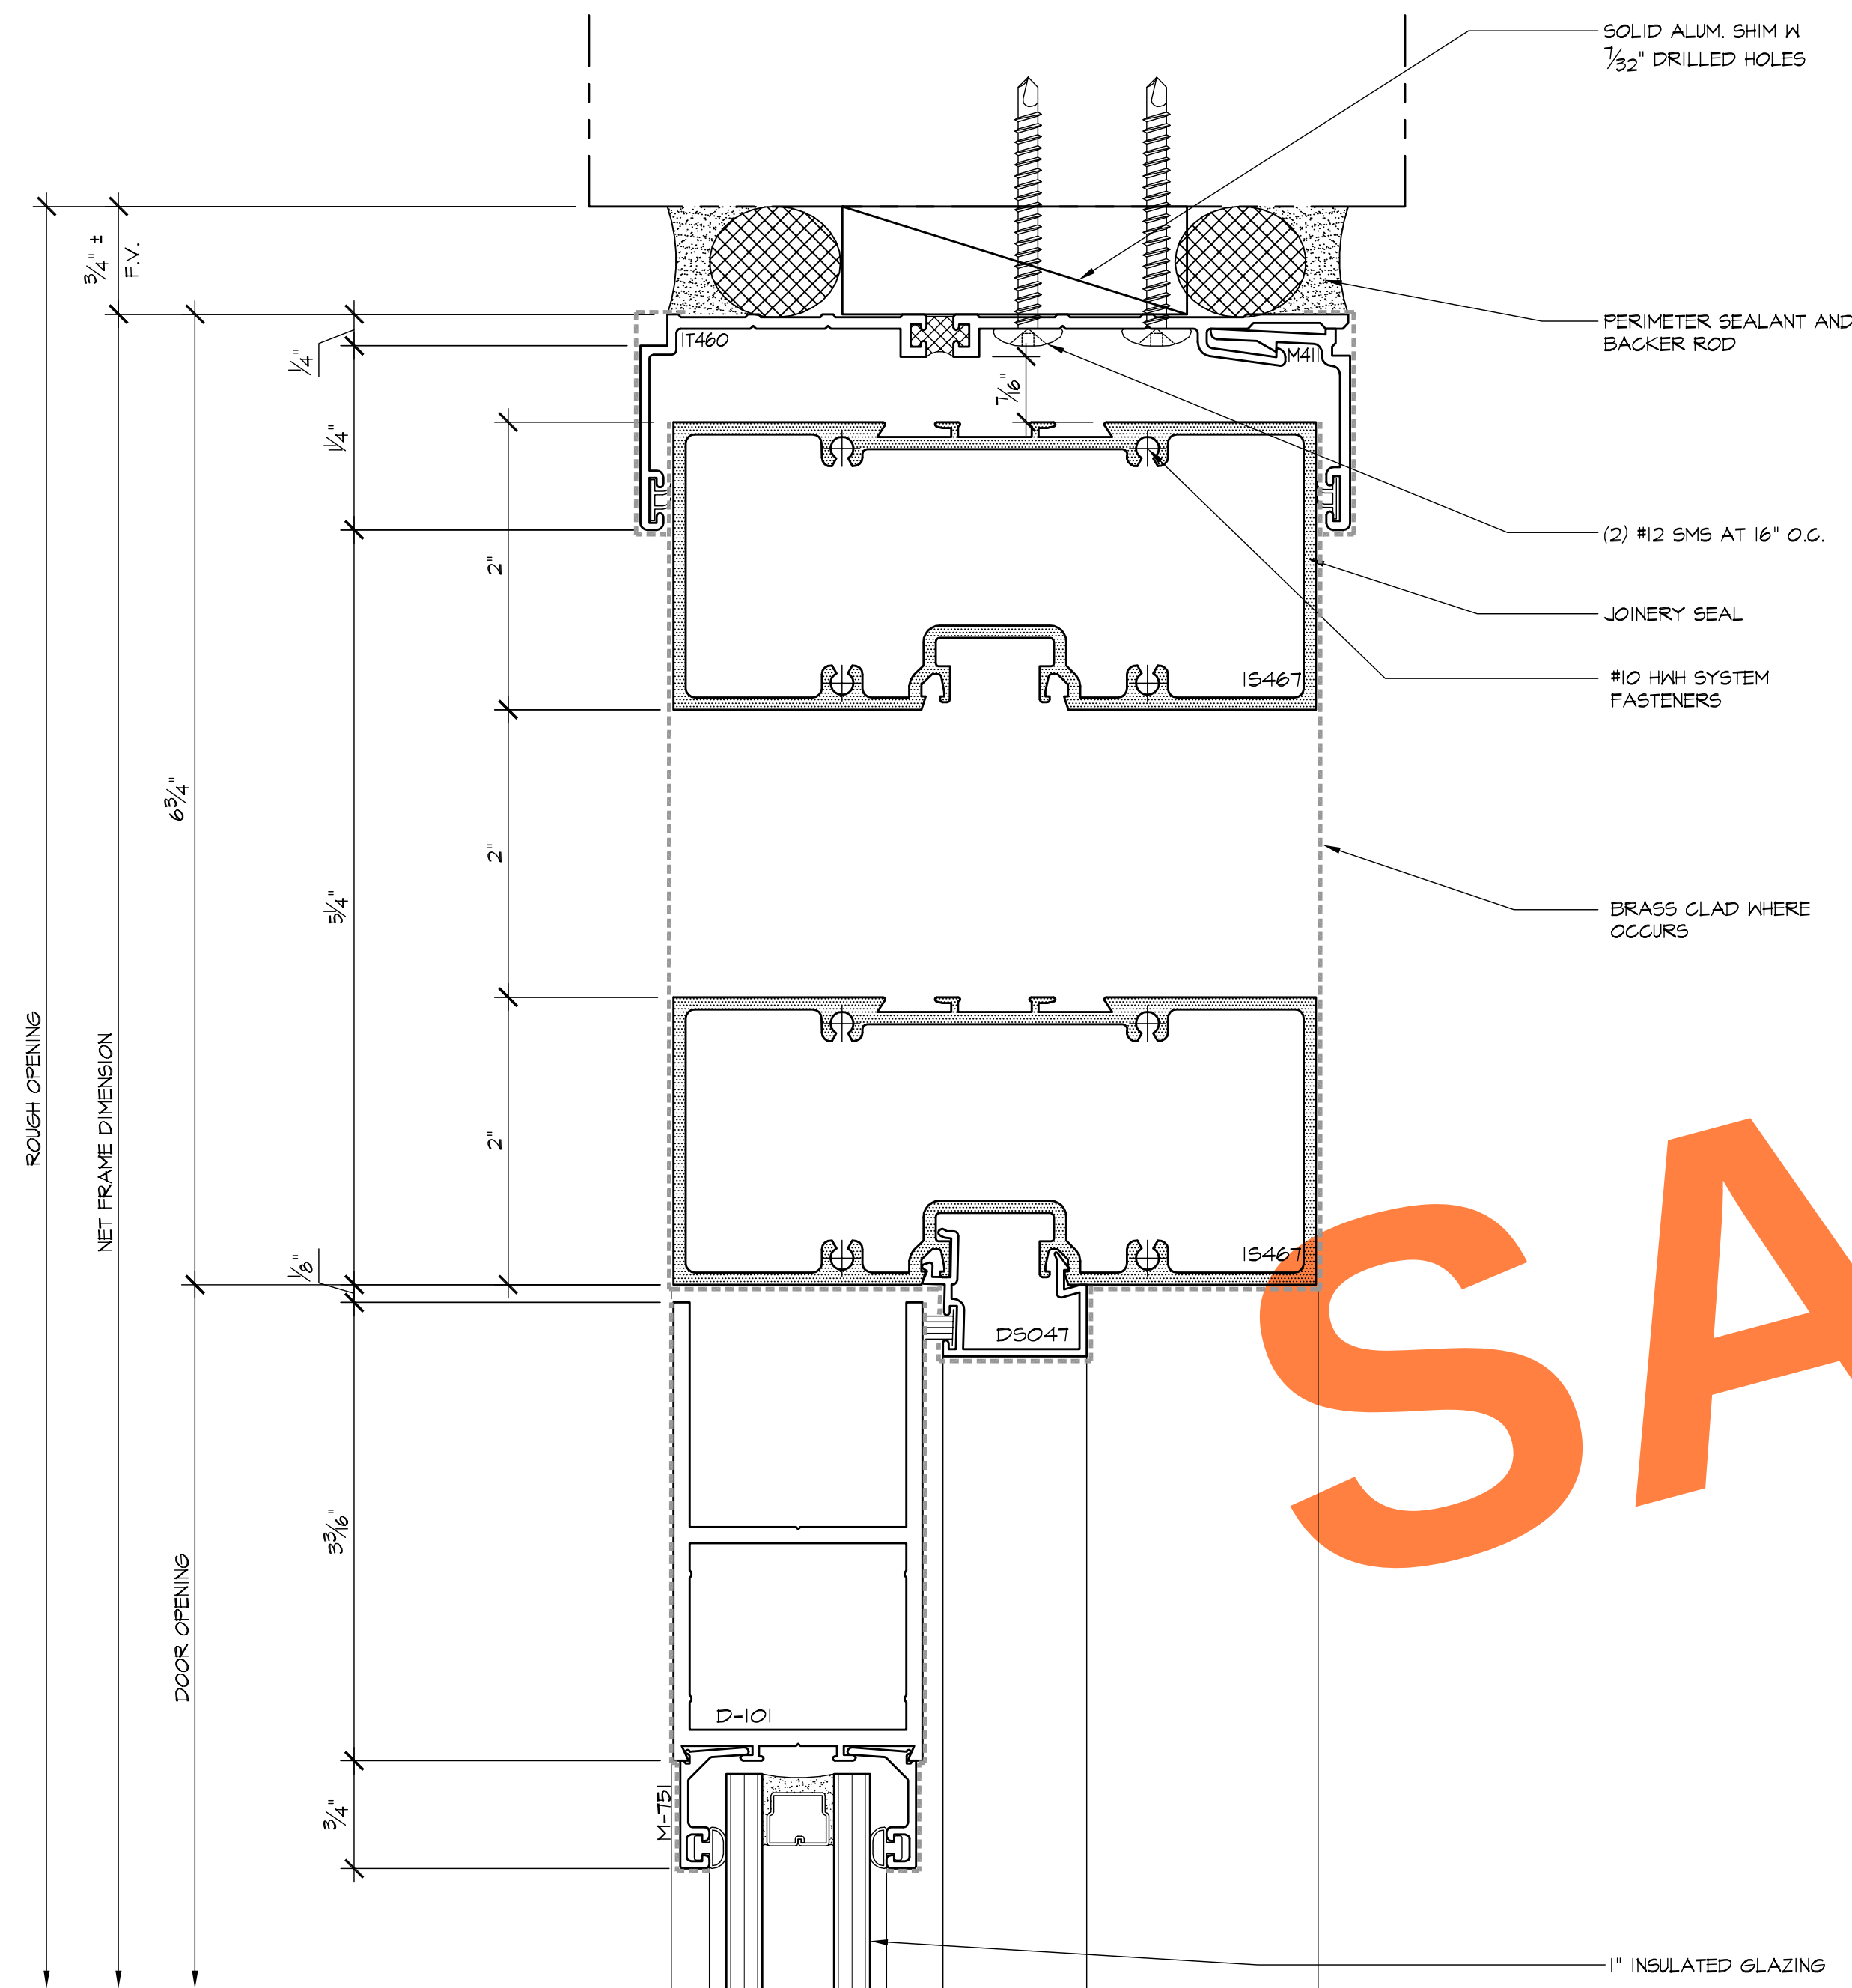

1 DOOR HEAD
52 ARCH'L:

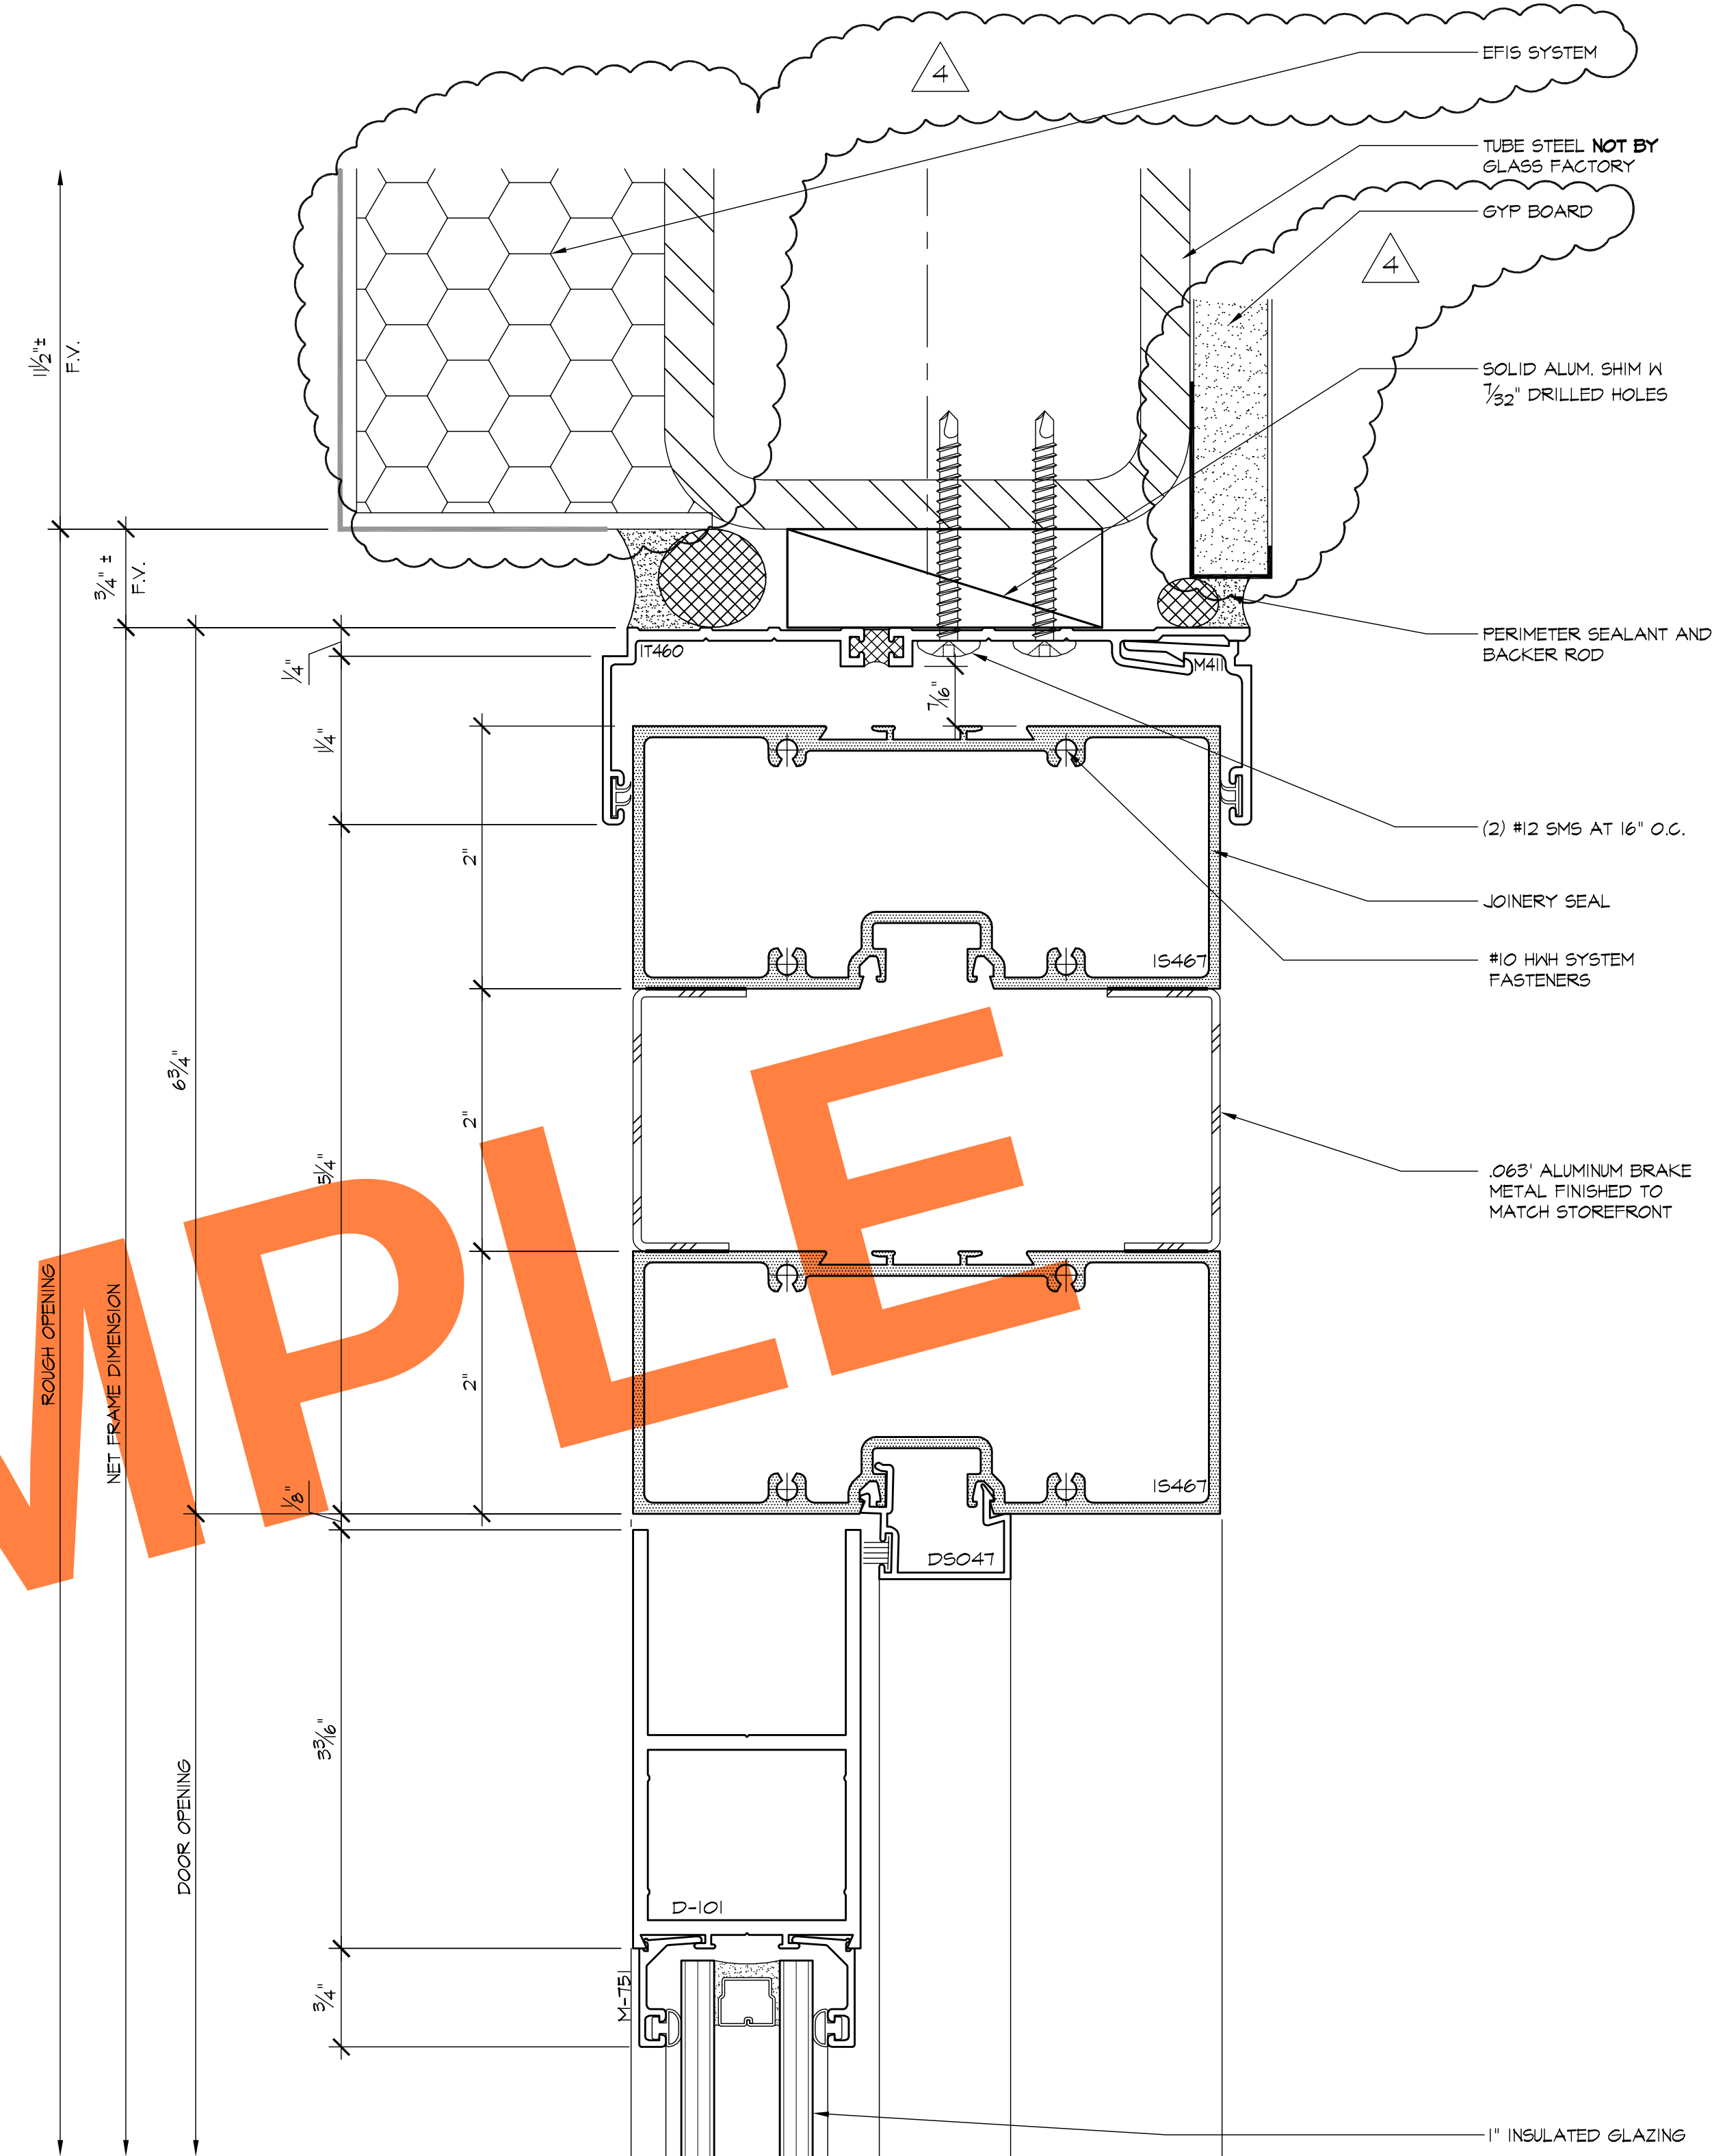

2 DOOR HEAD
52 ARCH'L:


REVISIONS	BY
4-23-07	BMR
6-11-07	BMR
12-17-07	CTB
3/6/08	CTB




GLASS FACTORY
26383 BASE LINE
HIGHLAND, CA 92346

AS-BUILT DRAWINGS


JOB NAME:	AGUA CALIENTE HOTEL ADDITION
ARCHITECT:	VOA
SHEET DESCRIPTION:	DETAILS
DATE:	6-11-07
SCALE:	FULL
DRAWN:	BMR
JOB NO:	100-06
SHEET NO:	

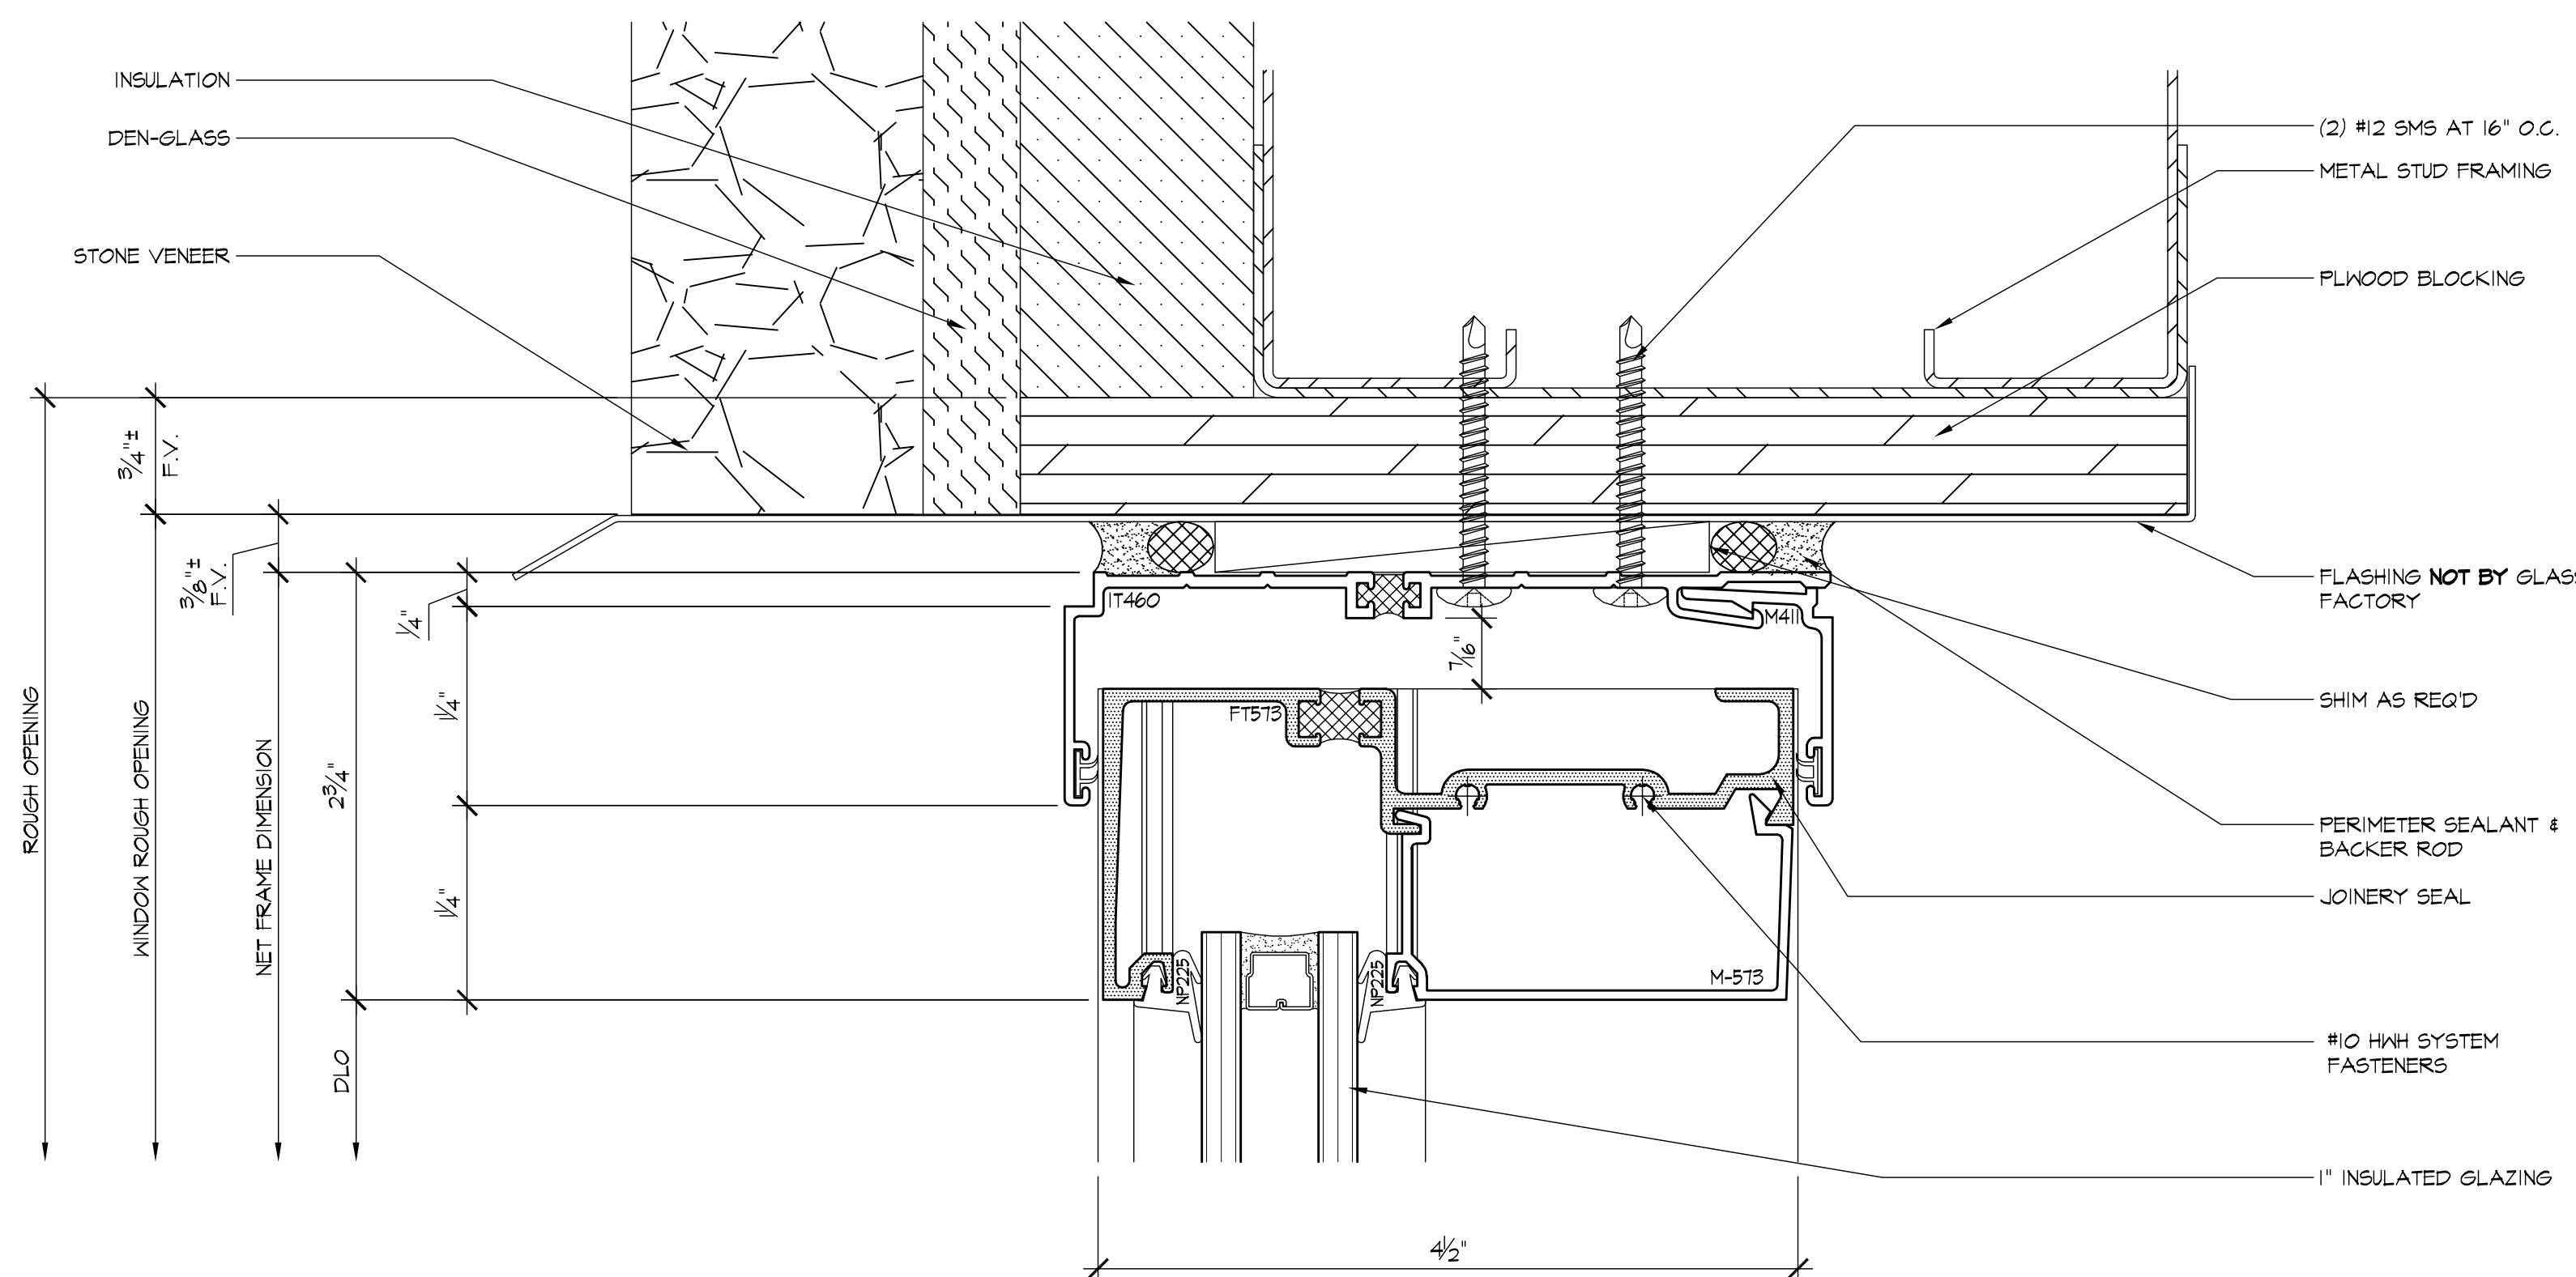


1 HEAD
53 ARCH'L:

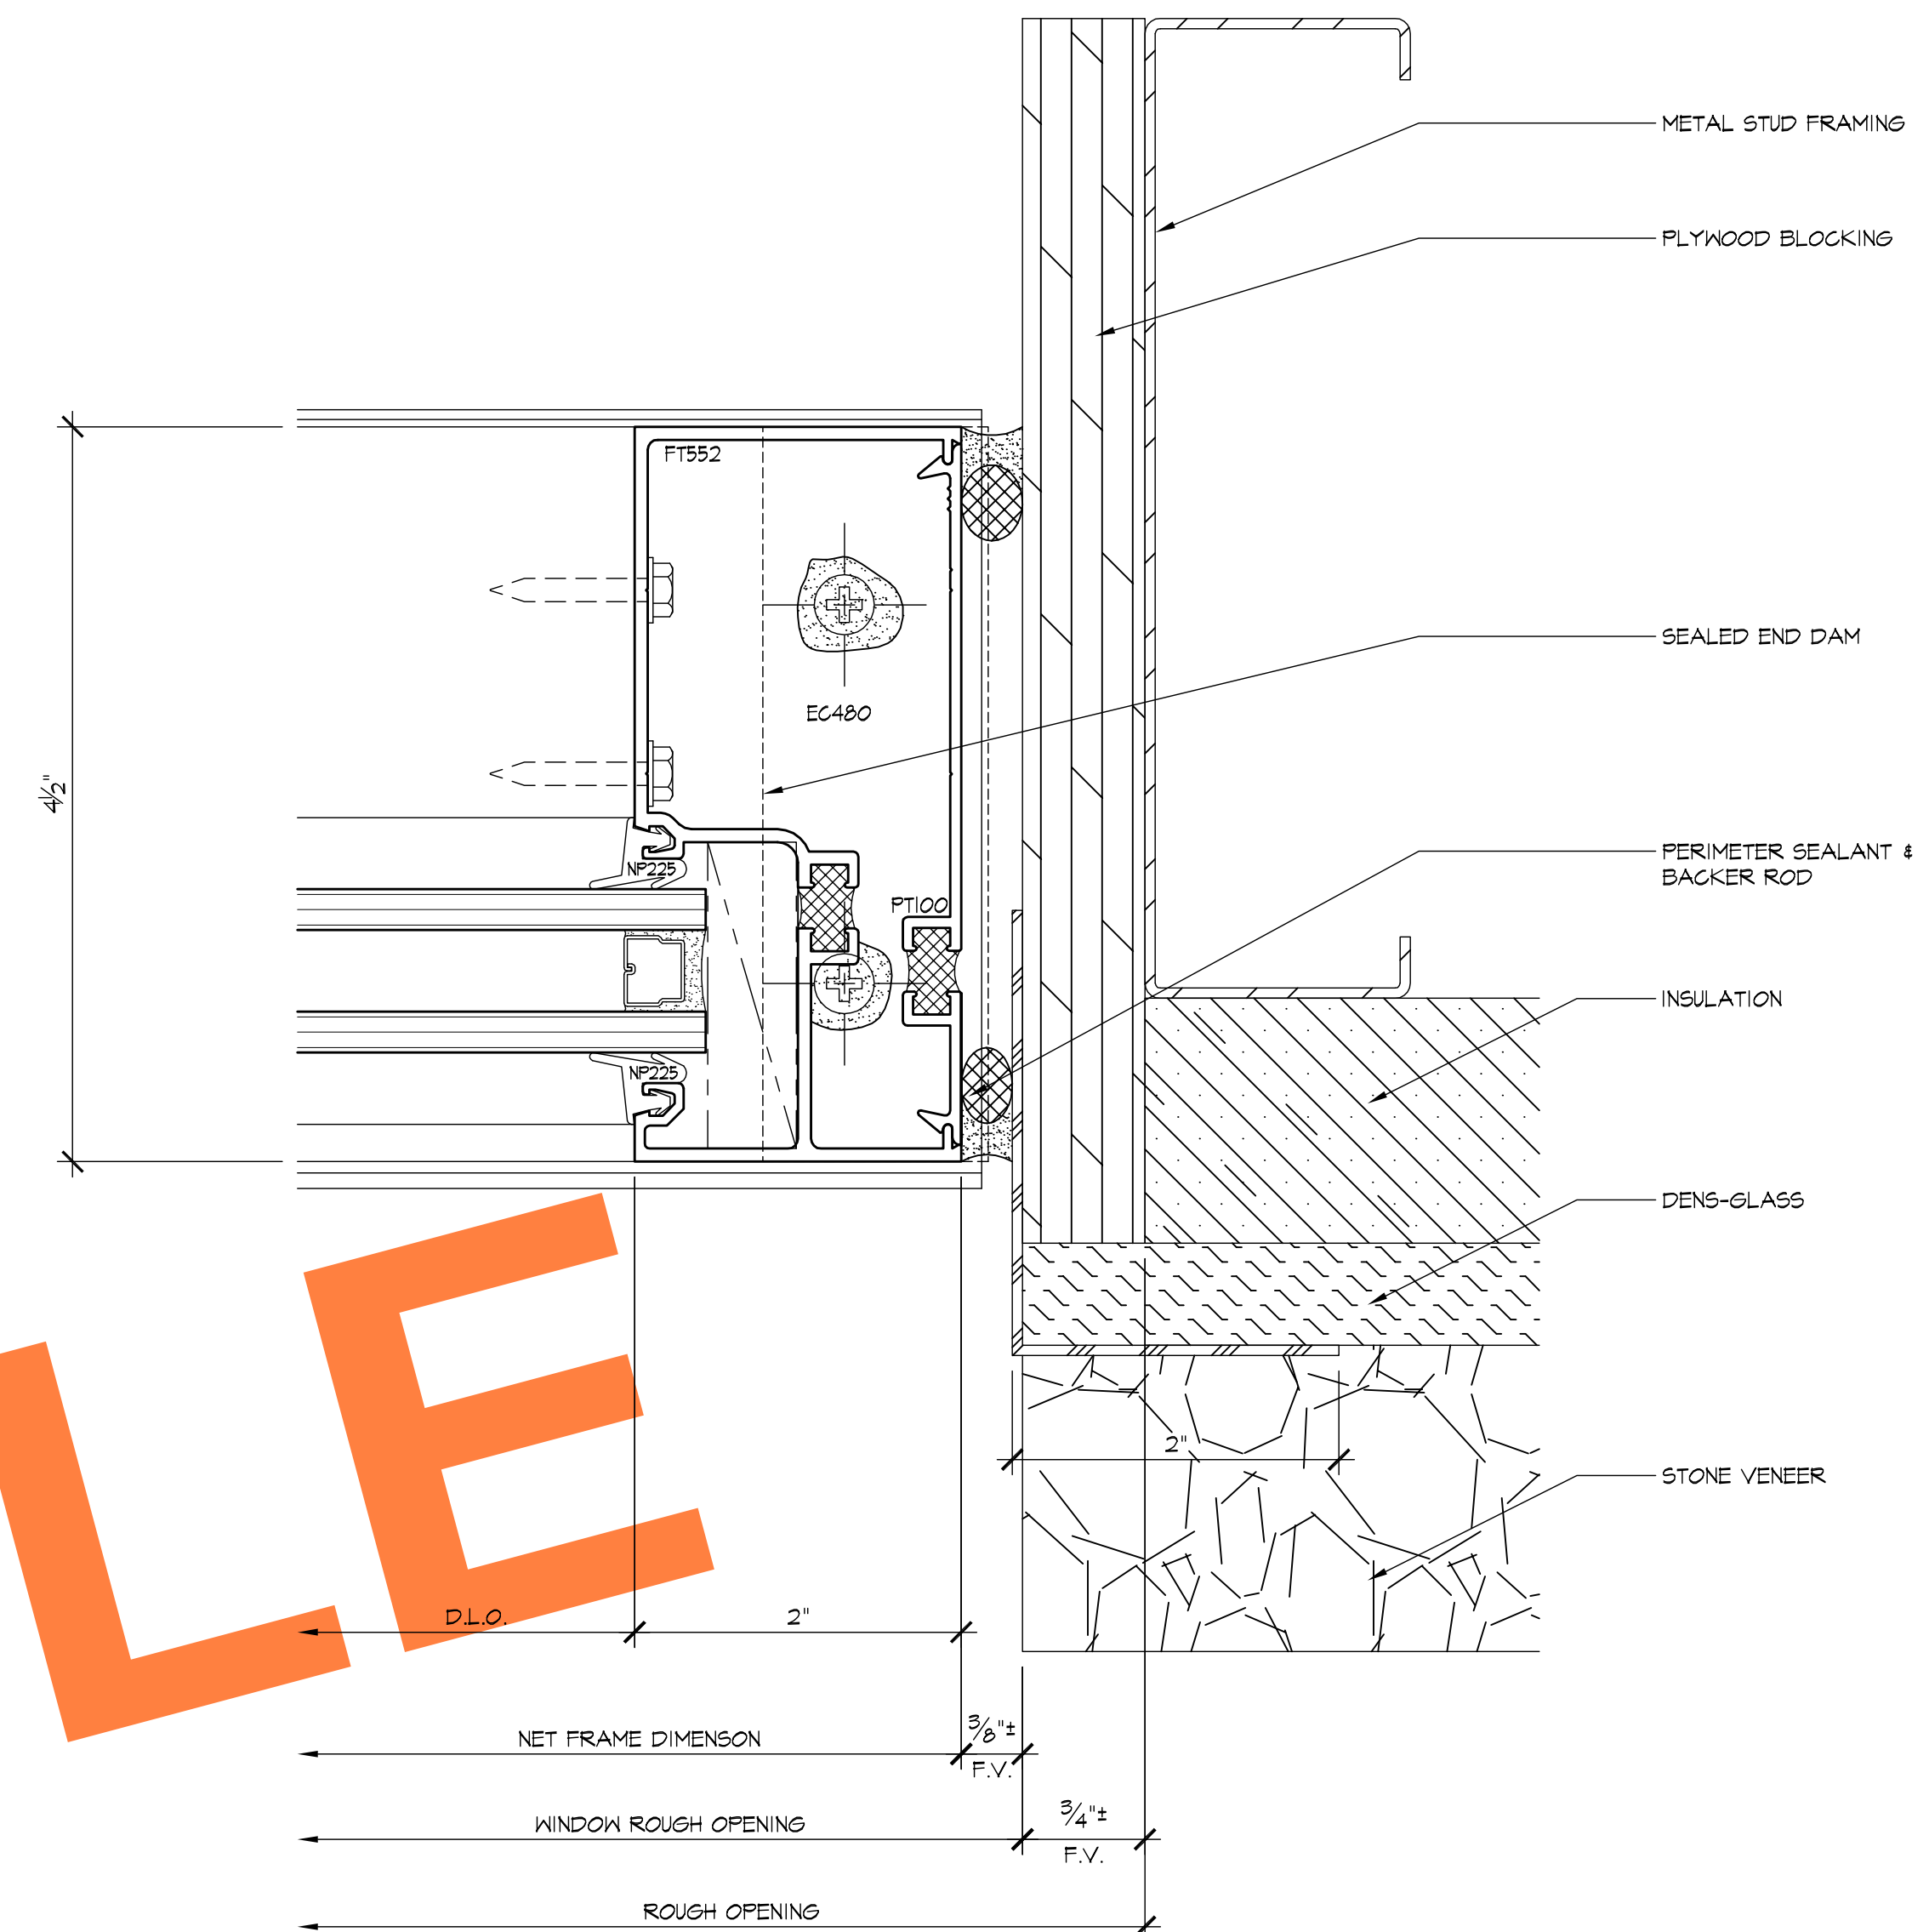

3 JAMB
53 ARCH'L:

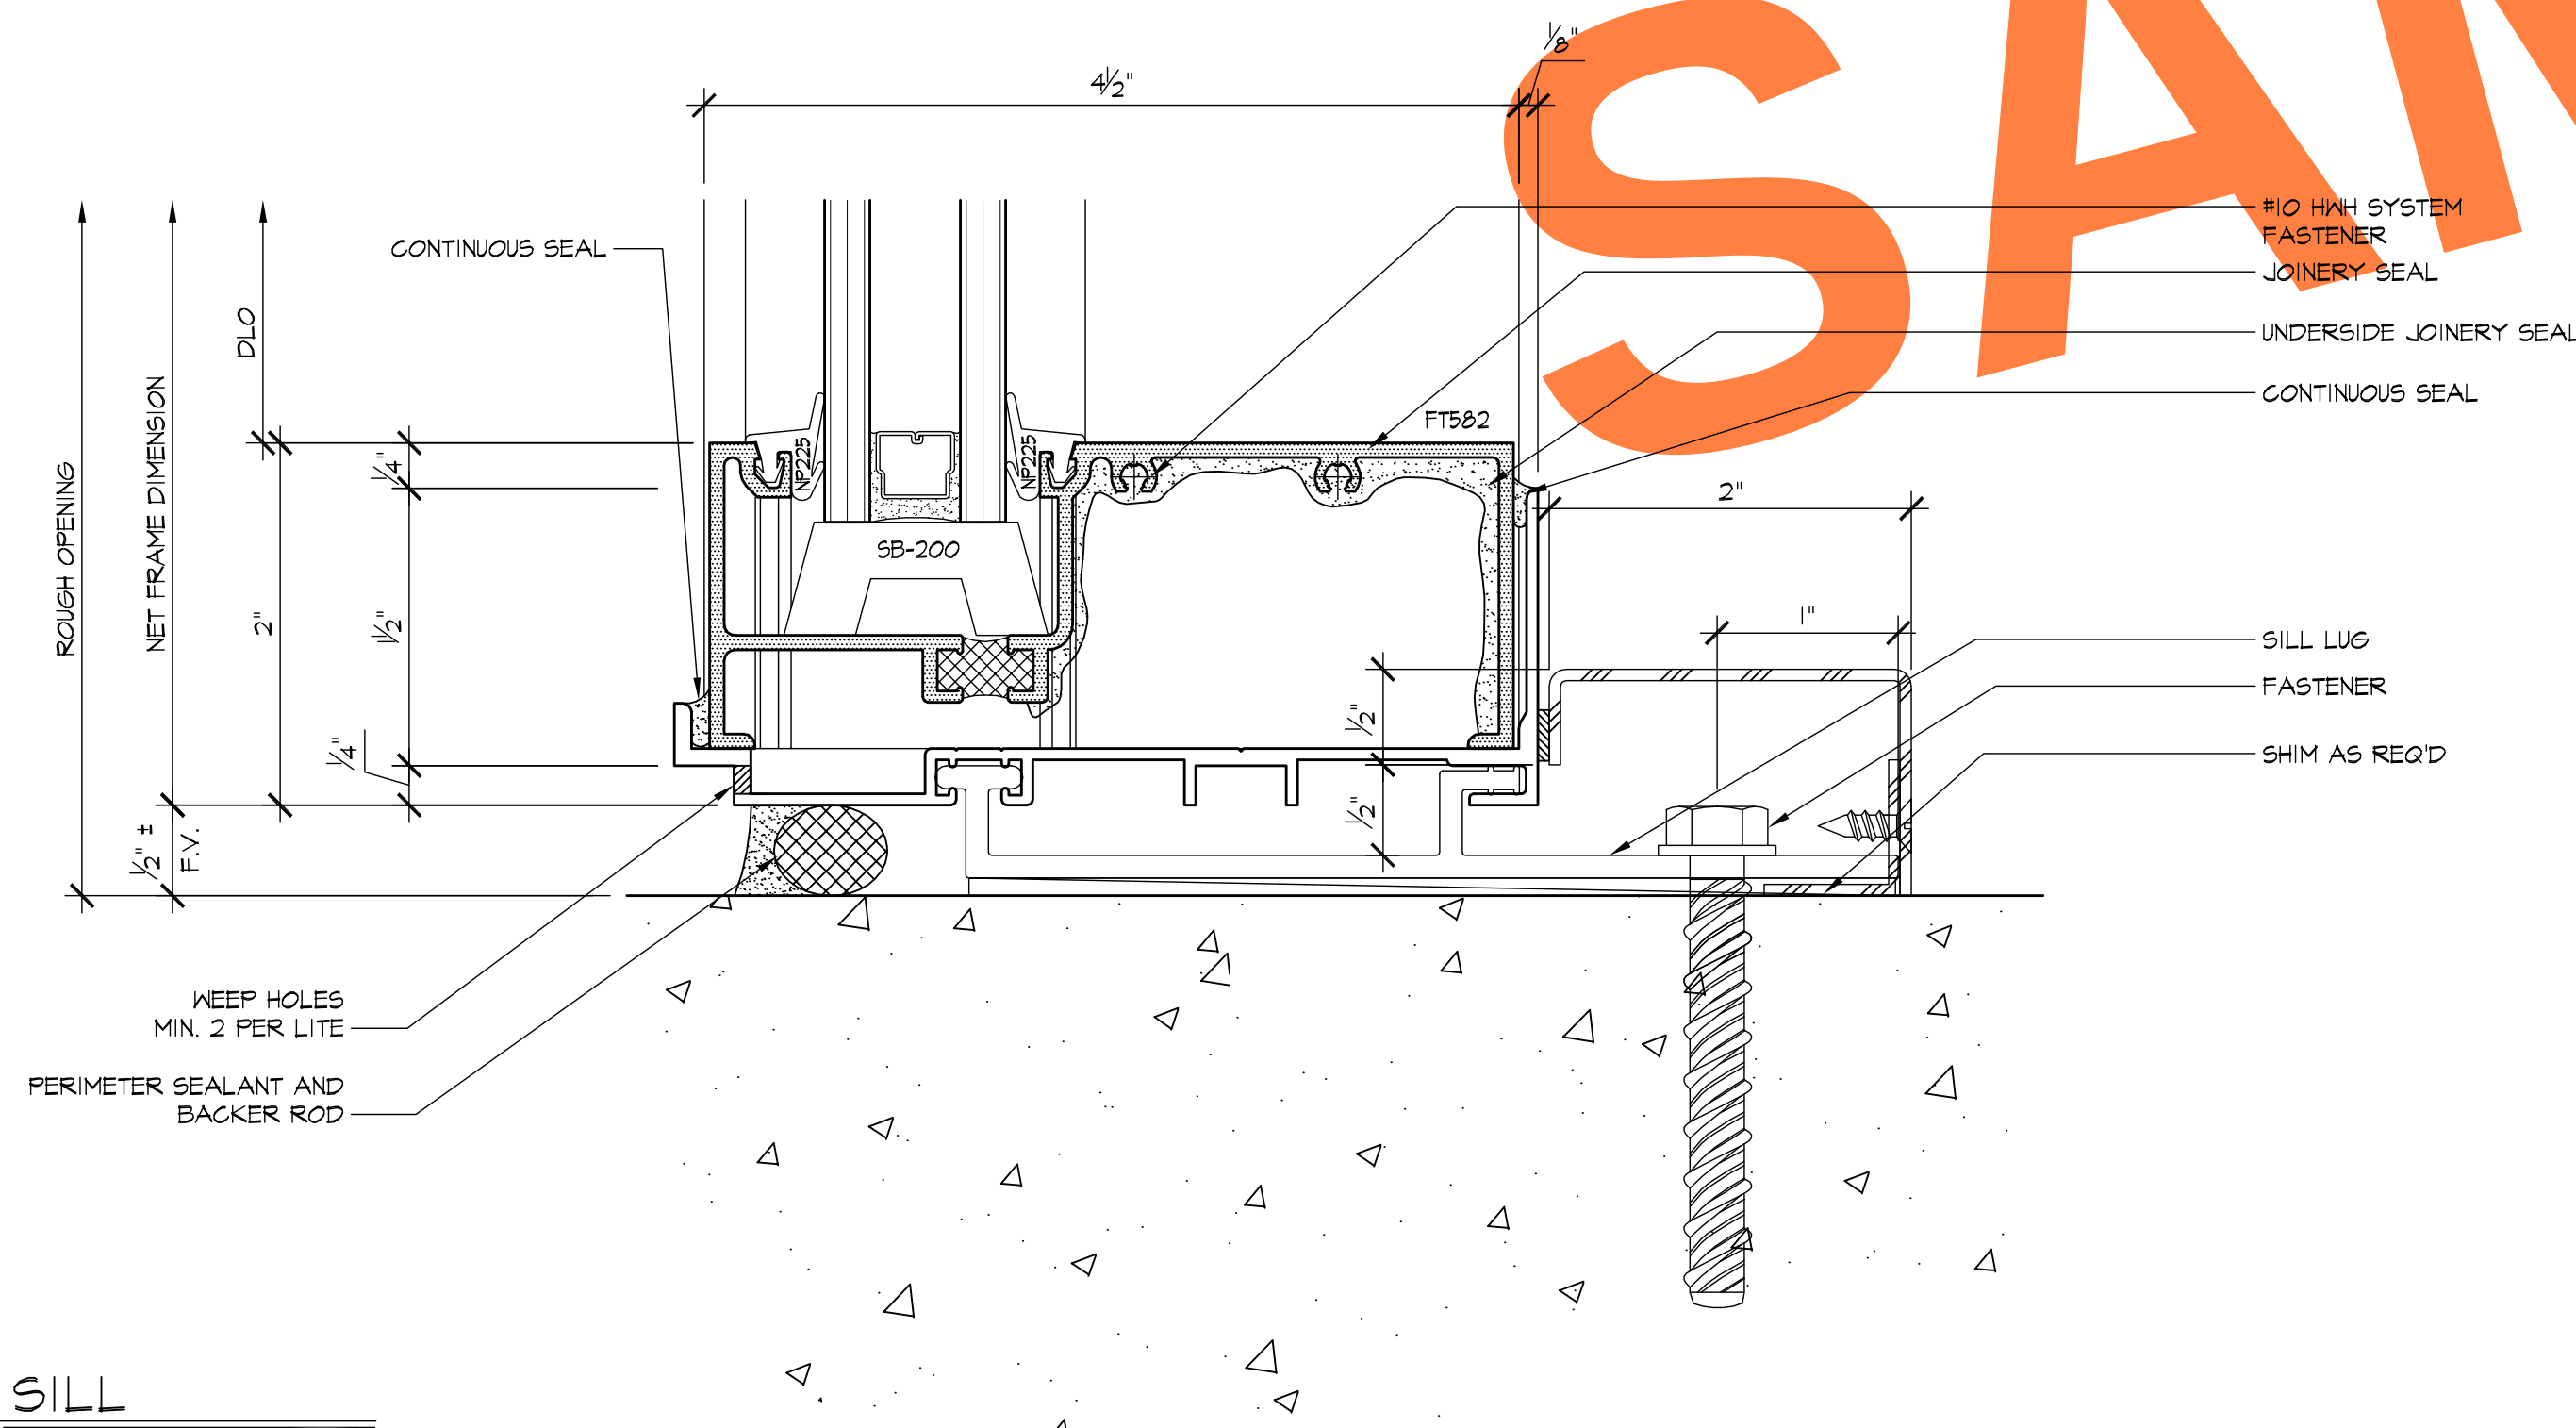

2 SILL
53 ARCH'L:

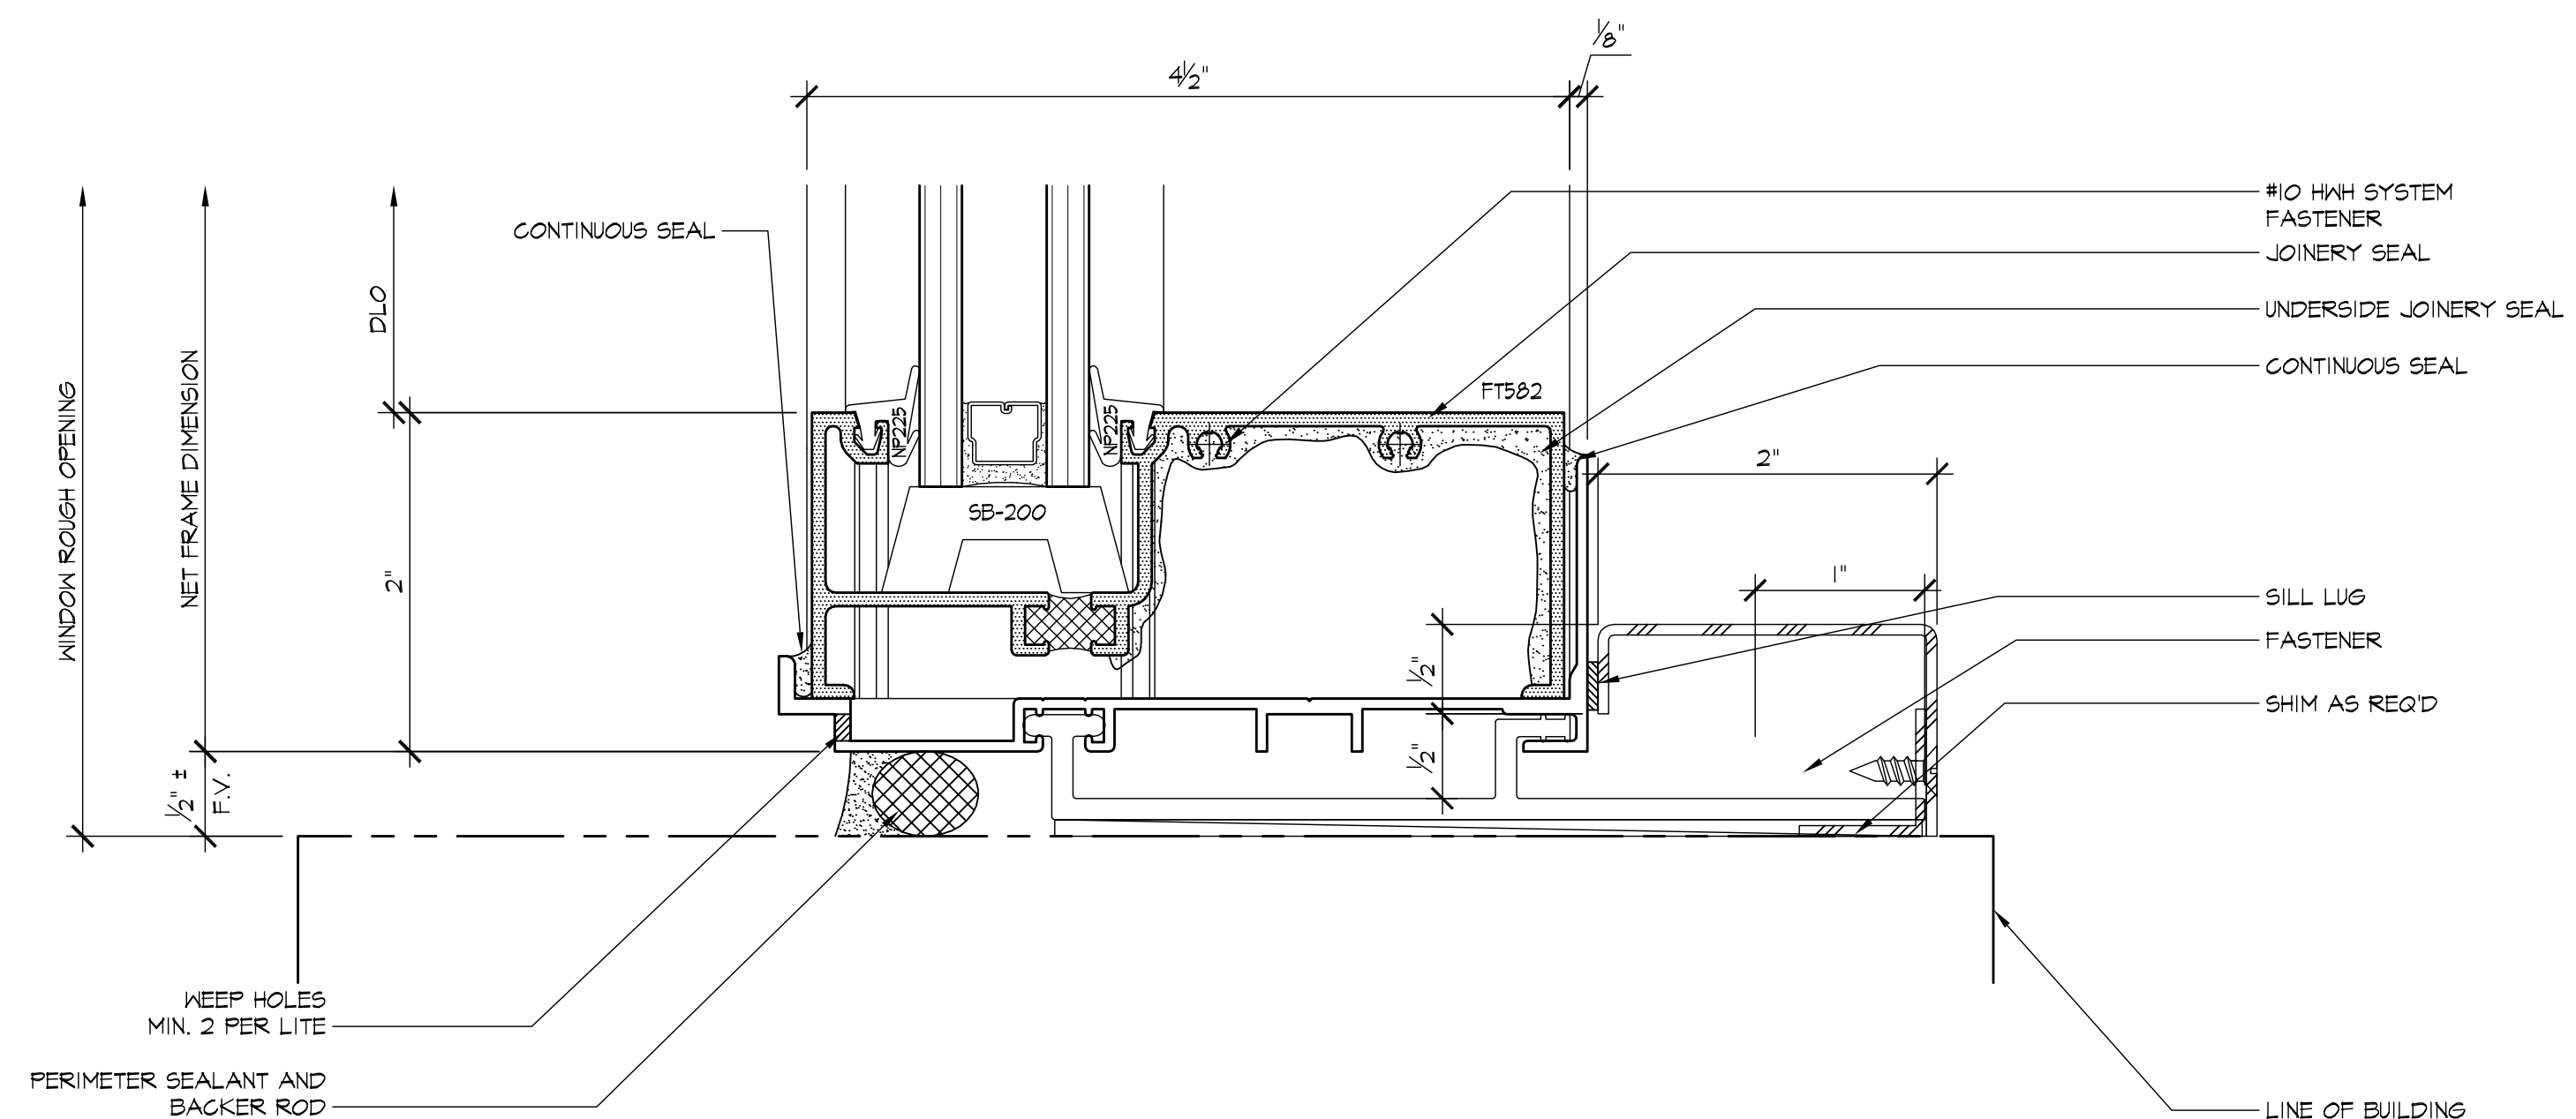

4 SILL
53 ARCH'L:

REVISIONS	BY
4-23-07	BMR
6-11-07	BMR
12-17-07	CTB
3/6/08	CTB



GLASS FACTORY
26383 BASE LINE
HIGHLAND, CA 92346

AS-BUILT DRAWINGS

JOB NAME:	AGUA CALIENTE HOTEL ADDITION
ARCHITECT:	VOA
SHEET DESCRIPTION:	DETAILS
DATE:	12-17-07
SCALE:	FULL
DRAWN:	CTB
JOB NO:	100-06
SHEET NO:	53

